



## Event # 155

**Name:** Swimming Pool Resurfacing Services

**Description:** The City of Fort Lauderdale, Florida (City) is seeking bids from qualified, experienced, and licensed firm(s), hereinafter referred to as the Contractor or Bidder, to provide swimming pool resurfacing services at two locations, Lauderdale Manors Park Pool and Riverland Park Pool, in accordance with the terms, conditions, and specifications contained in this Invitation for Bid (IFB).

**Buyer:** Torrenga, John

**Status:** Pending Award

**Event Type:** IFB

**Currency:** USD

**Sealed Bid:** Yes

**Respond To All Lines:** Yes

**Q & A Allowed:** Yes

**Number Of Amendments:** 0

**Open Date:** 07/28/2023 12:00:00 PM

**Q And A Open:** 07/28/2023 12:00:00 PM

**Close Date:** 08/11/2023 02:00:00 PM

**Q And A Close:** 08/07/2023 05:00:00 PM

## Questions

Question

Did you upload the required documents?

Did you upload the vendor questionnaire?

## Attachments

| Name  | Attachment                                      |
|---|---|
| Event 155 - Specifications and Requirements | Event 155 - Specifications and Requirements.pdf |
| Drawings - Riverland Park                   | Drawings - Riverland Park.pdf                   |
| Drawings - Lauderdale Manors Park           | Drawings - Lauderdale Manors Park.pdf           |
| General Conditions                          | 1. General Conditions - Rev 10-2022.pdf         |

## Line Details

# Event # 155: Swimming Pool Resurfacing Services

---

## Line 1: Mobilization - Riverland Pool

---

**Description:** Riverland Park Public Pool: Mobilization includes securing and cordoning off the work area and activation of contractor physical and manpower resources for the transfer to each construction site median as well as ensuring all utilities are available for use during the actual construction. THIS ITEM CANNOT EXCEED 5% OF THE BASE BID ONLY.

**Item:** MOBILIZATION Mobilization - Riverland Pool

**Commodity Code:** 961-18 Concrete Resurfacing Services (Swimming Pools, Driveways, Pa

**Quantity:** 1.0000

**Unit of Measure:** LS

**Requested Delivery Date:** 10/01/2023

**Require Response:** Yes

**Price Breaks Allowed:** No

**Allow Alternate Responses:** No

**Add On Charges Allowed:** No

## Line 2: Demolition - Riverland Pool

---

**Description:** Riverland Park Public Pool: Furnish all materials, labor and equipment to remove and properly dispose of all existing pool surfacing and all related activities as shown on the plans and per specifications. The base bid shall include overhead, profit, and all other fixed costs.

**Item:** DEMOLITION Demolition - Riverland Pool

**Commodity Code:** 961-18 Concrete Resurfacing Services (Swimming Pools, Driveways, Pa

**Quantity:** 1.0000

**Unit of Measure:** LS

**Requested Delivery Date:** 10/01/2023

**Require Response:** Yes

**Price Breaks Allowed:** No

**Allow Alternate Responses:** No

**Add On Charges Allowed:** No

## Line 3: Repair/Refurbishment - Riverland Pool

---

**Description:** Riverland Park Public Pool: Furnish all labor, material, and equipment to perform all work to be accomplished under this contract, which includes, but is not limited to, all repairs/refurbishment including but not limited to the resurfacing of the public park swimming pool. The base bid shall include overhead, profit, and all other

# Event # 155: Swimming Pool Resurfacing Services

---

fixed costs.

**Item:** REPAIR/REFURBISHMENT    Repair/Refurbishment - Riverland Pool

**Commodity Code:** 912-33    Construction, Swimming Pool

**Quantity:** 1.0000

**Unit of Measure:** LS

**Requested Delivery Date:** 10/01/2023

**Require Response:** Yes

**Price Breaks Allowed:** No

**Allow Alternate Responses:** No

**Add On Charges Allowed:** No

## Line 4: Mobilization - Lauderdale Manors Pool

---

**Description:** Lauderdale Manors Park Public Pool: Mobilization includes securing and cordoning off the work area and activation of contractor physical and manpower resources for the transfer to each construction site median as well as ensuring all utilities are available for use during the actual construction. THIS ITEM CANNOT EXCEED 5% OF THE BASE BID ONLY.

**Item:** MOBILIZATION    Mobilization - Lauderdale Manors Pool

**Commodity Code:** 961-18    Concrete Resurfacing Services (Swimming Pools, Driveways, Pa

**Quantity:** 1.0000

**Unit of Measure:** LS

**Requested Delivery Date:** 10/01/2023

**Require Response:** Yes

**Price Breaks Allowed:** No

**Allow Alternate Responses:** No

**Add On Charges Allowed:** No

## Line 5: Demolition - Lauderdale Manors Pool

---

**Description:** Lauderdale Manors Park Public Pool: Furnish all materials, labor and equipment to remove and properly dispose of all existing pool surfacing and all related activities as shown on the plans and per specifications. The base bid shall include overhead, profit, and all other fixed costs.

**Item:** DEMOLITION    Demolition - Lauderdale Manors Pool

**Commodity Code:** 961-18    Concrete Resurfacing Services (Swimming Pools, Driveways, Pa

**Quantity:** 1.0000

**Unit of Measure:** LS

**Requested Delivery Date:** 10/01/2023

**Require Response:** Yes

**Price Breaks Allowed:** No

**Allow Alternate Responses:** No

# Event # 155: Swimming Pool Resurfacing Services

---

**Allowed:**

**Responses:**

**Add On Charges** No  
**Allowed:**

## Line 6: Repair/Refurbishment - Lauderdale Manors Pool

---

**Description:** Lauderdale Manors Park Public Pool: Furnish all labor, material, and equipment to perform all work to be accomplished under this contract, which includes, but is not limited to, all repairs/refurbishment including but not limited to the resurfacing of the public park swimming pool. The base bid shall include overhead, profit, and all other fixed costs.

**Item:** REPAIR/REFURBISHMENT      Repair/Refurbishment - Lauderdale Manors Pool

**Commodity Code:** 912-33      Construction, Swimming Pool

**Quantity:** 1.0000

**Unit of Measure:** LS

**Requested Delivery Date:** 10/01/2023

**Require Response:** Yes

**Price Breaks** No  
**Allowed:**

**Allow Alternate** No  
**Responses:**

**Add On Charges** No  
**Allowed:**

## Line 7: Diamond Brite - Riverland Pool

---

**Description:** Lump sum price of SGM Commercial White Diamond Brite or City approved equivalent including all labor, equipment and material for transporting, storing, handling etc. for Riverland Pool.

**Item:** DIAMOND BRITE - RIVERLAND POOL      Diamond Brite - Riverland Pool

**Commodity Code:** 961-18      Concrete Resurfacing Services (Swimming Pools, Driveways, Pa

**Quantity:** 1.0000

**Unit of Measure:** LS

**Requested Delivery Date:** 10/01/2023

**Require Response:** Yes

**Price Breaks** No  
**Allowed:**

**Allow Alternate** No  
**Responses:**

**Add On Charges** No  
**Allowed:**

## Line 8: Diamond Brite - Lauderdale Manors Pool

---

# Event # 155: Swimming Pool Resurfacing Services

---

**Description:** Lump sum price of SGM Commercial White Diamond Brite or City approved equivalent including and all labor, equipment and material for transporting, storing, handling, etc. for Lauderdale Manors Pool.

**Item:** DIAMOND BRITE -LAUDERDALE MANORS     Diamond Brite - Lauderdale Manors Pool

**Commodity Code:** 961-18     Concrete Resurfacing Services (Swimming Pools, Driveways, Pa

**Quantity:** 1.0000

**Unit of Measure:** LS

**Requested Delivery Date:** 10/01/2023

**Require Response:** Yes

**Price Breaks Allowed:** No

**Allow Alternate Responses:** No

**Add On Charges Allowed:** No

## SECTION I – INTRODUCTION AND INFORMATION

### 1.1 Purpose

The City of Fort Lauderdale, Florida (City) is seeking bids from qualified, experienced, and licensed firm(s), hereinafter referred to as the Contractor or Bidder, to provide swimming pool resurfacing services for the City, in accordance with the terms, conditions, and specifications contained in this Invitation to Bid (ITB).

### 1.2 Point of Contact

For information concerning procedures for responding to this solicitation, contact Procurement Administrator, John Torrenga at (954) 828-5949 or email at [jtorrenga@fortlauderdale.gov](mailto:jtorrenga@fortlauderdale.gov). Such contact shall be for clarification purposes only.

For information concerning technical specifications, please utilize the question / answer feature provided by the City's on-line strategic sourcing platform. Questions of a material nature must be received prior to the cut-off date specified in the ITB schedule. Material changes, if any, to the scope of services or bidding procedures will only be transmitted by written addendum. Bidders please note: No part of your bid can be submitted via FAX. No variation in price or conditions shall be permitted based upon a claim of ignorance. Submission of a bid will be considered evidence that the Bidder has familiarized themselves with the nature and extent of the work, and the equipment, materials, and labor required. The entire bid response must be submitted in accordance with all specifications contained in this solicitation. The questions and answers submitted in the City's on-line strategic sourcing platform shall become part of any contract that is created from this ITB.

### 1.3 Pre-bid Conference and/or Site Visit

There will not be a pre-bid conference or site visit for this ITB. If the contractor wishes to make arrangements to visit each site, they may contact Abraham Gopaul at [AGopaul@fortlauderdale.gov](mailto:AGopaul@fortlauderdale.gov) or 954-828-6560 (office) 954-856-1733 (mobile) for scheduling purposes only.

It will be the sole responsibility of the Bidder to become familiar with the scope of the City's requirements and systems prior to submitting a bid. No variation in price or conditions shall be permitted based upon a claim of ignorance. Submission of a bid will be considered evidence that the Bidder has familiarized themselves with the nature and extent of the work, equipment, materials, and labor required.

### 1.4 CITY'S ON-LINE STRATEGIC SOURCING PLATFORM

The City of Fort Lauderdale uses its own on-line strategic sourcing platform to administer the competitive solicitation process, including but not limited to soliciting bids, issuing addenda, posting results, and issuing notification of an intended decision. There is no charge to register and download the ITB from the City's on-line strategic sourcing platform. Bidders are strongly encouraged to read the supplier tutorials available in the City's on-line strategic sourcing platform well in advance of their intention of submitting a bid to ensure familiarity with the use of the City's on-line strategic sourcing platform. The City shall not be responsible for a Bidder's inability to submit a Bid by the end date and time for any reason, including issues arising from the use of the City's on-line strategic sourcing platform.

It is the sole responsibility of the Bidder to ensure that their bid is submitted electronically through the City's on-line strategic sourcing platform no later than the time and date specified in

this solicitation. PAPER BID SUBMITTALS WILL NOT BE ACCEPTED. BIDS MUST BE SUBMITTED ELECTRONICALLY VIA the [City's on-line strategic sourcing platform](#).

IN THE EVENT OF ANY CONFLICT OR DISCREPANCY BETWEEN BID/PROPOSAL PRICE(S) SUBMITTED BY BIDDER/PROPOSER ELECTRONICALLY INTO THE CITY'S ON-LINE STRATEGIC SOURCING PLATFORM UNIT PRICE FIELD(S), ANY OTHER FORMS OR ATTACHMENTS (WHETHER PART OF THE CITY'S SOLICITATION DOCUMENTS OR DOCUMENTS CREATED AND UPLOADED BY THE BIDDER/PROPOSER), OR ANOTHER SECTION/FIELD OF THE SYSTEM, THE ONLINE UNIT PRICE(S) INPUTTED ELECTRONICALLY INTO THE SYSTEM BY BIDDER/PROPOSER SHALL GOVERN.

### **1.5 Electronic Bid Openings**

Please be advised that effective immediately, and until further notice, all Invitation to Bids, Request for Proposals, Request for Qualifications, and other solicitations led by the City of Fort Lauderdale will be opened electronically via the [City's on-line strategic sourcing platform](#) at the date and time indicated on the solicitation. All openings will be held on the City's on-line strategic sourcing platform.

Anyone requesting assistance or having further inquiry in this matter must contact the Procurement Specialist indicated on the solicitation, via the Question-and-Answer forum on the City's on-line strategic sourcing platform before the Last Day for Questions indicated in the Solicitation.

*END OF SECTION*

## SECTION II - SPECIAL TERMS AND CONDITIONS

### 2.1 General Conditions

ITB General Conditions (Form G-107, Rev. 09/22) are included and made a part of this ITB.

### 2.2 Addenda, Changes, and Interpretations

It is the sole responsibility of each firm to notify the Procurement Specialist utilizing the question / answer feature provided by the [City's on-line strategic sourcing platform](#) and request modification or clarification of any ambiguity, conflict, discrepancy, omission, or other error discovered in this competitive solicitation. Requests for clarification, modification, interpretation, or changes must be received prior to the Question and Answer (Q & A) Deadline. Requests received after this date may not be addressed. Questions and requests for information that would not materially affect the scope of services to be performed or the solicitation process will be answered within the question / answer feature provided by the City's on-line strategic sourcing platform and shall be for clarification purposes only. Material changes, if any, to the scope of services or the solicitation process will only be transmitted by official written addendum issued by the City and uploaded to the City's on-line strategic sourcing platform as a separate addendum to the ITB. Under no circumstances shall an oral explanation given by any City official, officer, staff, or agent be binding upon the City and should be disregarded. All addenda are a part of the competitive solicitation documents, and each firm will be bound by such addenda. It is the responsibility of each to read and comprehend all addenda issued.

### 2.3 Changes and Alterations

Bidder may change or withdraw a Bid at any time prior to Bid submission deadline; however, no oral modifications will be allowed. Modifications shall not be allowed following the Bid deadline.

### 2.4 Bidder's Costs

The City shall not be liable for any costs incurred by Bidders in responding to this ITB.

### 2.5 Pricing/Delivery

Bidder shall quote a firm, fixed price for all services stated in the ITB. All costs including travel shall be included in your cost. The City shall not accept any additional costs including any travel associated with coming to the City of Fort Lauderdale.

### 2.6 Price Validity

Prices provided in this Invitation to bid (ITB) shall be valid for at least One-Hundred and Twenty (120) days from time of ITB opening unless otherwise extended and agreed upon by the City and Bidder. The City shall award contract within this time period or shall request to the recommended awarded vendor an extension to hold pricing, until products/services have been awarded.

### 2.7 Invoices/Payment

The City will accept invoices no more frequently than once per month. Each invoice shall fully detail the related costs and shall specify the status of the particular task or project as of the date of the invoice with regard to the accepted schedule for that task or project. Payment will be made within forty-five (45) days after receipt of an invoice acceptable to the City, in accordance with the Florida Local Government Prompt Payment Act. If, at any time during the contract, the City shall not approve or accept the Contractor's work product, and agreement cannot be reached between the City and the Contractor to resolve the problem to the City's satisfaction, the City shall negotiate with the Contractor on a payment for the work completed and usable to the City.



A payment schedule based upon agreed upon deliverables may be developed with the awarded Contractor.

**2.8 Related Expenses/Travel Expenses**

All costs including travel are to be included in your bid. The City will not accept any additional costs.

**2.9 Payment Method**

The City of Fort Lauderdale has implemented a Procurement Card (P-Card) program which changes how payments are remitted to its vendors. The City has transitioned from traditional paper checks to payment by credit card via MasterCard or Visa. This allows you as a vendor of the City of Fort Lauderdale to receive your payment fast and safely. No more waiting for checks to be printed and mailed. Payments will be made utilizing the City's P-Card (MasterCard or Visa). Accordingly, firms must presently have the ability to accept credit card payment or take whatever steps necessary to implement acceptance of a credit card before the commencement of a contract. See Contract Payment Method form attached.

**2.10 Mistakes**

The Bidder shall examine this ITB carefully. The submission of a bid shall be prima facie evidence that the Bidder has full knowledge of the scope, nature, and quality of the work to be performed; the detailed requirements of the specifications; and the conditions under which the work is to be performed. Ignorance of the requirements will not relieve the Bidder from liability and obligations under the Contract.

**2.11 Acceptance of Bids / Minor Irregularities**

**2.11.1** The City reserves the right to accept or reject any or all bids, part of bids, and to waive minor irregularities or variances to specifications contained in bids which do not make the bid conditional in nature and minor irregularities in the solicitation process. A minor irregularity shall be a variation from the solicitation that does not affect the price of the contract or does not give a bidder an advantage or benefit not enjoyed by other bidders, does not adversely impact the interests of other firms, or does not affect the fundamental fairness of the solicitation process. The City also reserves the right to reissue an ITB.

**2.11.2** The City reserves the right to disqualify Bidder during any phase of the competitive solicitation process and terminate for cause any resulting contract upon evidence of collusion with intent to defraud or other illegal practices on the part of the Bidder.

**2.12 Modification of Services**

**2.12.1** While this contract is for services provided to the department referenced in this ITB, the City may require similar work for other City departments. Successful Bidder agrees to take on such work unless such work would not be considered reasonable or become an undue burden to the Successful Bidder.

**2.12.2** The City reserves the right to delete any portion of the work at any time without cause, and if such right is exercised by the City, the total fee shall be reduced in the same ratio as the estimated cost of the work deleted bears to the estimated cost of the work originally planned. If work has already been accomplished and approved by the City on any portion of a contract resulting from this ITB, the Successful Bidder shall be paid for the work completed on the basis of the estimated percentage of completion of such portion to the total project cost.

**2.12.3** The City may require additional items or services of a similar nature, but not specifically listed in the contract. The Successful Bidder agrees to provide such items or services and shall provide the City prices on such additional items or services. If the price(s) offered are not acceptable to the City, and the situation cannot be resolved to the satisfaction of the City, the City reserves the right to procure those items or services from other vendors, or to cancel the contract upon giving the Successful Bidder thirty (30) days written notice.

**2.12.4** If the Successful Bidder and the City agree on modifications or revisions to the task elements, after the City has approved work to begin on a particular task or project, and a budget has been established for that task or project, the Successful Bidder will submit a revised budget to the City for approval prior to proceeding with the work.

**2.13 Non-Exclusive Contract**

Bidder agrees and understands that the contract shall not be construed as an exclusive arrangement and further agrees that the City may, at any time, secure similar or identical services from another vendor at the City's sole option.

**2.14 Sample Contract Agreement**

A sample of the formal agreement template, which may be required to be executed by the awarded vendor can be found at our website:

<https://www.fortlauderdale.gov/home/showdocument?id=1212>

**2.15 Responsiveness**

In order to be considered responsive to the solicitation, the firm's bid shall fully conform in all material respects to the solicitation and all of its requirements, including all form and substance.

**2.16 Responsibility**

In order to be considered as a responsible firm, firm shall be fully capable to meet all of the requirements of the solicitation and subsequent contract, must possess the full capability, including financial and technical, to perform as contractually required, and must be able to fully document the ability to provide good faith performance.

**2.17 Minimum Qualifications**

To be eligible for award of a contract in response to this solicitation, the Bidder must demonstrate that they have successfully completed services, as specified in the Technical Specifications / Scope of Services section of this solicitation, are normally and routinely engaged in performing such services, and are properly and legally licensed to perform such work. In addition, the Bidder must have no conflict of interest with regard to any other work performed by the Bidder for the City of Fort Lauderdale.

To be eligible for award of a contract in response to this solicitation, the Bidder must possess at time of bid submittal a State of Florida Pool Contractors license or equivalent Broward County Contractor license, certificate of competency, or another license that meets or exceeds those specified herein.

**2.17.1** Firm or principals shall have no record of judgments, pending lawsuits against the City or criminal activities involving moral turpitude and not have any conflicts of interest that have not been waived by the City Commission.

**2.17.2** Neither firm nor any principal, officer, or stockholder shall be in arrears or in default of any debt or contract involving the City, (as a party to a contract, or otherwise); nor have failed to perform faithfully on any previous contract with the City.

**2.17.3** Refer to Section 3.4 for additional requirements.

**2.18 Lobbying Activities**

ALL CONTRACTORS PLEASE NOTE: Any contractor submitting a response to this solicitation must comply, if applicable, with City of Fort Lauderdale Ordinance No. C-11-42 & Resolution No. 07-101, Lobbying Activities. Copies of Ordinance No. C-11-42 and Resolution No. 07-101 may be obtained from the City Clerk's Office on the 7th Floor of City Hall, 100 N. Andrews Avenue, Fort Lauderdale, Florida. The ordinance may also be viewed on the City's website at <http://www.fortlauderdale.gov/home/showdocument?id=6036>.

**2.19 Local Business Preference**

**2.19.1** Section 2-186, Code of Ordinances of the City of Fort Lauderdale, provides for a local business preference. In order to be considered for a local business preference, a Bidder must include the Local Business Preference Certification Statement of this ITB, as applicable to the local business preference class claimed at the time of Bid submittal:

**2.19.2** Upon formal request of the City, based on the application of a Local Business Preference the Bidder shall within ten (10) calendar days submit the following documentation to the Local Business Preference Class claimed:

- a. Copy of City of Fort Lauderdale current year business tax receipt, or Broward County current year business tax receipt, and
- b. List of the names of all employees of the Bidder and evidence of employees' residence within the geographic bounds of the City of Fort Lauderdale or Broward County, as the case may be, such as current Florida driver license, residential utility bill (water, electric, telephone, cable television), or other type of similar documentation acceptable to the City.

**2.19.3** Failure to comply at time of Bid submittal shall result in the Bidder being found ineligible for the local business preference.

**2.19.4** The complete local business preference ordinance may be found on the City's web site at the following link:

[https://library.municode.com/fl/fort\\_lauderdale/codes/code\\_of\\_ordinances?nodeId=COOR\\_CH2AD\\_ARTVFI\\_DIV2PR\\_S2-186LOBUPR](https://library.municode.com/fl/fort_lauderdale/codes/code_of_ordinances?nodeId=COOR_CH2AD_ARTVFI_DIV2PR_S2-186LOBUPR)

**2.19.5 Definitions**

- a. The term "Class A business" shall mean any business that has established and agrees to maintain a permanent place of business located in a non-residential zone, staffed with full-time employees within the limits of the city, and shall maintain a staffing level for the proposed work of at least fifty percent (50%) who are residents of the City of Fort Lauderdale.
- b. The term "Class B business" shall mean any business that has established and agrees to maintain a permanent place of business located in a non-residential zone, staffed with full-time employees within the limits of the city, or shall maintain a staffing

level for the proposed work of at least fifty percent (50%) who are residents of the City of Fort Lauderdale.

- c. The term "Class C business" shall mean any business that has established and agrees to maintain a permanent place of business located in a non-residential zone, staffed with full-time employees within the limits of Broward County.
- d. The term "Class D business" shall mean any business that does not qualify as a Class A, Class B, or Class C business.

## **2.20 Disadvantaged Business Enterprise Preference**

**2.20.1** Section 2-185, Code of Ordinances of the City of Fort Lauderdale, provides for a disadvantaged business preference. In order to be considered for a disadvantaged business preference, a Bidder must include a certification from a government agency, as applicable to the disadvantaged business preference class claimed at the time of Bid/Proposal submittal:

**2.20.2** Upon formal request of the City, based on the application of a Disadvantaged Business Preference the Bidder shall within ten (10) calendar days submit the following documentation to the Disadvantaged Business Enterprise Preference Class claimed:

- a. Copy of City of Fort Lauderdale current year business tax receipt, or the Tri-County (Broward, Dade, West Palm Beach) current year business tax receipt, or proof of active Sunbiz status and
- b. List of the names of all employees of the Bidder and evidence of employees' residence within the geographic bounds of the City of Fort Lauderdale or the Tri- County, as the case may be, such as current Florida driver license, residential utility bill (water, electric, telephone, cable television), or other type of similar documentation acceptable to the City.

**2.20.3** Failure to comply at time of Bid/Proposal submittal shall result in the Bidder being found ineligible for the Disadvantaged Business Enterprise Preference business preference.

**2.20.4** The complete disadvantaged business preference ordinance may be found on the City's web site at the following link:

<https://www.fortlauderdale.gov/home/showpublisheddocument?id=56883>

### **2.20.5 Definitions**

- a. The term "Disadvantaged Class 1 Enterprise" shall mean any disadvantaged business enterprise that has established and agrees to maintain a permanent place of business located in a non-residential zone, staffed with full-time employees within the limits of the city, and provides supporting documentation of its City of Fort Lauderdale business tax and disadvantaged certification as established in the city's Procurement Manual.
- b. The term "Disadvantaged Class 2 Enterprise" shall mean any disadvantaged business enterprise that has established and agrees to maintain a permanent place of business within the limits of the city with full-time employees and provides supporting documentation of its City of Fort Lauderdale business tax and disadvantaged certification as established in the city's Procurement Manual.

- c. The term "Disadvantaged Class 3 Enterprise" shall mean any disadvantaged business enterprise that has established and agrees to maintain a permanent place of business located in a non-residential zone, staffed with full-time employees within the limits of the Tri-County area and provides supporting documentation of its City of Fort Lauderdale business tax and disadvantaged certification as established in the City's Procurement Manual.
- d. The term "Disadvantaged Class 4 Enterprise" shall mean any disadvantaged business enterprise that does not qualify as a Class A, Class B, or Class C business, but is located in the State of Florida and provides supporting documentation of its disadvantaged certification as established in the City's Procurement Manual.

## **2.21 Protest Procedure**

**2.21.1** Any Bidder who is not recommended for award of a contract and who alleges a failure by the city to follow the city's procurement ordinance or any applicable law, may follow the protest procedure as found in the city's procurement ordinance within five (5) days after a notice of intent to award is posted on the city's web site at the following link.

<https://www.fortlauderdale.gov/government/departments-a-h/finance/procurement-services/notices-of-intent-to-award>

**2.21.2** The complete protest ordinance may be found on the city's web site at the following link:  
[https://library.municode.com/fl/fort\\_lauderdale/codes/code\\_of\\_ordinances?nodeId=COOR\\_CH2AD\\_ARTVFI\\_DIV2PR\\_S2-182DIREPRAWINAW](https://library.municode.com/fl/fort_lauderdale/codes/code_of_ordinances?nodeId=COOR_CH2AD_ARTVFI_DIV2PR_S2-182DIREPRAWINAW)

## **2.22 Public Entity Crimes**

Bidder, by submitting a bid, certifies that neither the Bidder nor any of the Bidder's principals has been placed on the convicted vendor list as defined in Section 287.133, Florida Statutes (2018), as may be amended or revised. A person or affiliate who has been placed on the convicted vendor list following a conviction for a public entity crime may not submit a bid, proposal, or reply on a contract to provide any goods or services to a public entity; may not submit a bid, proposal, or reply on a contract with a public entity for the construction or repair of a public building or public work; may not submit bids, proposals, or replies on leases of real property to a public entity; may not be awarded or perform work as a contractor, supplier, subcontractor, or consultant under a contract with any public entity; and may not transact business with any public entity in excess of the threshold amount provided in s. 287.017 for CATEGORY TWO for a period of 36 months following the date of being placed on the convicted vendor list.

## **2.23 Subcontractors**

**2.23.1** If the Contractor proposes to use subcontractors in the course of providing these services to the City, this information shall be a part of the bid/proposal response. Such information shall be subject to review, acceptance, and approval of the City, prior to any contract award. The City reserves the right to approve or disapprove of any subcontractor candidate in its best interest and to require Contractor to replace subcontractor with one that meets City approval.

**2.23.2** Contractor shall ensure that all of Contractor's subcontractors perform in accordance with the terms and conditions of this Contract. Subcontractors shall possess and provide a Pool Contractor's certification and license or equivalent. Contractor shall be fully responsible for all of Contractor's subcontractors' performance, and liable for any of Contractor's subcontractors' non-performance and all of Contractor's subcontractors' acts and

omissions. Contractor shall defend, at Contractor's expense, counsel being subject to the City's approval or disapproval, and indemnify and hold harmless the City and the City's officers, employees, and agents from and against any claim, lawsuit, third-party action, or judgment, including any award of attorney fees and any award of costs, by or in favor of any Contractor's subcontractors for payment for work performed for the City.

**2.23.3** Contractor shall require all its subcontractors to provide the required insurance coverage as well as any other coverage that the contractor may consider necessary, and any deficiency in the coverage or policy limits of said subcontractors will be the sole responsibility of the contractor.

## **2.24 Bid Security**

**2.24.1** A bid security payable to the City of Fort Lauderdale shall be submitted with the bid response in the amount of five percent (5%) of the total bid amount. A bid security can be in the form of a bid bond or cashier's check. Bid security will be returned to the unsuccessful contractor as soon as practicable after opening of bids. Bid security will be returned to the successful Bidder after acceptance of the Payment and Performance Bond, if required; acceptance of insurance coverage, if required; and full execution of contract documents, if required; or other conditions as stated in Special Conditions or elsewhere in the ITB.

**2.24.2** The [City's on-line strategic sourcing platform](#) allows bidders to submit bid bonds electronically directly through the system using **Surety 2000**.

**2.24.3** The bidder may choose to mail their original executed bid bond or upload the bid bond on the [City's on-line strategic sourcing platform](#) to accompany their electronic bid and then deliver the original, signed, and sealed bid bond within five (5) business days from the solicitation end date or it will be determined as non-responsive. A bid security in the form of a cashier's check must be an original document and must be submitted at time of the bid due date. If choosing the cashier's check method, plan in advance to send via United States Postal Service or air freight carrier to ensure cashier's check arrives on or before bid opening deadline.

A. Deliver via United States Postal Service or air freight carrier to City of Fort Lauderdale City Hall, Procurement Services Division, 6<sup>th</sup> Floor, Suite 619, 100 N. Andrews Avenue, Fort Lauderdale, FL 33301.

B. Include company name, solicitation number and title clearly indicated outside of the envelope.

**2.24.4** Failure of the successful Bidder to execute a contract, provide a Performance Bond, and furnish evidence of appropriate insurance coverage, as provided herein, within thirty (30) days after written notice of award has been given, shall be just cause for the annulment of the award and the forfeiture of the bid security to the City, which forfeiture shall be considered, not as a penalty, but as liquidation of damages sustained.

## **2.25 Payment and Performance Bond**

**2.25.1** The Bidder shall within fifteen (15) working days after notification of award, furnish to the City a Payment and Performance Bond, in the amount of the proposed price as surety for faithful performance under the terms and conditions of the contract. If the bond is on an annual coverage basis, renewal for each succeeding year shall be submitted to the City thirty (30) days prior to the termination date of the existing Payment and Performance

Bond. The Performance Bond must be executed by a surety company or recognized standing to do business in the State of Florida and having a resident agent.

**2.25.2** The Bidder must have a Financial Size Categories (FSC) rating of no less than “A-” by the latest edition of Best’s Key Rating Guide, or acceptance of insurance company that holds a valid Florida Certificate of Authority issued by the State of Florida, Department of Insurance, and are members of the Florida Guarantee Fund.

**2.25.3** Acknowledgement and agreement is given by both parties that the amount herein set for the Payment and Performance Bond is not intended to be nor shall be deemed to be in the nature of liquidated damages nor is it intended to limit the liability of the Contractor to the City in the event of a material breach of this Agreement by the Contractor.

## **2.26 Insurance Requirements**

As a condition precedent to the effectiveness of this Agreement, during the term of this Agreement and during any renewal or extension term of this Agreement, Contractor, at its sole expense, shall provide insurance of such types and with such terms and limits as noted below. Providing proof of and maintaining adequate insurance coverage are material obligations of Contractor. Contractor shall provide the City a certificate of insurance evidencing such coverage. Contractor’s insurance coverage shall be primary insurance for all applicable policies, in respect to the City’s interests. The limits of coverage under each policy maintained by Contractor shall not be interpreted as limiting Contractor’s liability and obligations under this Agreement. All insurance policies shall be through insurers authorized or eligible to write policies in the State of Florida and possess an A.M. Best rating of A-, VII or better, subject to approval by the City’s Risk Manager.

The coverages, limits, and/or endorsements required herein protect the interests of the City, and these coverages, limits, and/or endorsements shall in no way be relied upon by Contractor for assessing the extent or determining appropriate types and limits of coverage to protect Contractor against any loss exposures, whether as a result of this Agreement or otherwise. The requirements contained herein, as well as the City’s review or acknowledgement, are not intended to and shall not in any manner limit or qualify the liabilities and obligations assumed by Contractor under this Agreement.

The following insurance policies and coverages are required:

### Commercial General Liability

Coverage must be afforded under a Commercial General Liability policy with limits not less than:

- \$1,000,000 each occurrence and \$2,000,000 aggregate for Bodily Injury, Property Damage, and Personal and Advertising Injury
- \$1,000,000 each occurrence and \$2,000,000 aggregate for Products and Completed Operations

Policy must include coverage for contractual liability and independent contractors.

The City, a Florida municipality, its officials, employees, and volunteers are to be covered as an additional insured with a CG 20 26 04 13 Additional Insured – Designated Person or Organization Endorsement or similar endorsement providing equal or broader Additional Insured Coverage with respect to liability arising out of activities performed by or on behalf of Contractor. The coverage shall contain no special limitation on the scope of protection afforded to the City, its officials, employees, and volunteers.

### Business Automobile Liability

Coverage must be afforded for all Owned, Hired, Scheduled, and Non-Owned vehicles for Bodily Injury and Property Damage in an amount not less than \$1,000,000 combined single limit each accident.

If Contractor does not own vehicles, Contractor shall maintain coverage for Hired and Non-Owned Auto Liability, which may be satisfied by way of endorsement to the Commercial General Liability policy or separate Business Auto Liability policy.

### Workers' Compensation and Employer's Liability

Coverage must be afforded per Chapter 440, Florida Statutes. Any person or entity performing work for or on behalf of the City must provide Workers' Compensation insurance. Exceptions and exemptions will be allowed by the City's Risk Manager, if they are in accordance with Florida Statute.

Contractor waives, and Contractor shall ensure that Contractor's insurance carrier waives, all subrogation rights against the City, its officials, employees, and volunteers for all losses or damages. The City requires the policy to be endorsed with WC 00 03 13 Waiver of our Right to Recover from Others or equivalent.

Contractor must be in compliance with all applicable State and Federal workers' compensation laws, including the U.S. Longshore and Harbor Workers' Compensation Act and the Jones Act, if applicable.

### Insurance Certificate Requirements

- a. Contractor shall provide the City with valid Certificates of Insurance (binders are unacceptable) no later than ten (10) days prior to the start of work contemplated in this Agreement.
- b. Contractor shall provide to the City a Certificate of Insurance having a thirty (30) day notice of cancellation; ten (10) days' notice if cancellation is for nonpayment of premium.
- c. In the event that the insurer is unable to accommodate the cancellation notice requirement, it shall be the responsibility of Contractor to provide the proper notice. Such notification will be in writing by registered mail, return receipt requested, and addressed to the certificate holder.
- d. In the event the Agreement term or any surviving obligation of Contractor following expiration or early termination of the Agreement goes beyond the expiration date of the insurance policy, Contractor shall provide the City with an updated Certificate of Insurance no later than ten (10) days prior to the expiration of the insurance currently in effect. The City reserves the right to suspend the Agreement until this requirement is met.
- e. The Certificate of Insurance shall indicate whether coverage is provided under a claims-made or occurrence form. If any coverage is provided on a claims-made form, the Certificate of Insurance must show a retroactive date, which shall be the effective date of the initial contract or prior.
- f. The City shall be covered as an Additional Insured on all liability policies, with the exception of Workers' Compensation.
- g. The City shall be granted a Waiver of Subrogation on Contractor's Workers' Compensation insurance policy.
- h. The title of the Agreement, Bid/Contract number, event dates, or other identifying reference must be listed on the Certificate of Insurance.



The Certificate Holder should read as follows:

City of Fort Lauderdale  
100 N. Andrews Avenue  
Fort Lauderdale, FL 33301

Contractor has the sole responsibility for all insurance premiums and shall be fully and solely responsible for any costs or expenses as a result of a coverage deductible, co-insurance penalty, or self-insured retention; including any loss not covered because of the application of such deductible, co-insurance penalty, self-insured retention, or coverage exclusion or limitation. Any costs for adding the City as an Additional Insured shall be at Contractor's expense.

If Contractor's primary insurance policy/policies do not meet the minimum requirements as set forth in this Agreement, Contractor may provide evidence of an Umbrella/Excess insurance policy to comply with this requirement.

Contractor's insurance coverage shall be primary insurance in respect to the City's interests, a Florida municipality, its officials, employees, and volunteers. Any insurance or self-insurance maintained by the City shall be non-contributory.

Any exclusion or provision in any insurance policy maintained by Contractor that excludes coverage required in this Agreement shall be deemed unacceptable and shall be considered breach of contract.

All required insurance policies must be maintained until the contract work has been accepted by the City, or until this Agreement is terminated, whichever is later. Any lapse in coverage may be considered breach of contract. In addition, Contractor must provide to the City confirmation of coverage renewal via an updated certificate of insurance should any policies expire prior to the expiration of this Agreement. The City reserves the right to review, at any time, coverage forms and limits of Contractor's insurance policies.

Contractor shall provide notice of any and all claims, accidents, and any other occurrences associated with this Agreement to Contractor's insurance company or companies and the City's Risk Management office as soon as practical.

It is Contractor's responsibility to ensure that any and all of Contractor's independent contractors and subcontractors comply with these insurance requirements. All coverages for independent contractors and subcontractors shall be subject to all of the applicable requirements stated herein. Any and all deficiencies are the responsibility of Contractor. The City reserves the right to adjust insurance limits from time to time at its discretion with notice to Contractor.

## **2.27 Insurance – Sub-Contractors**

Contractor shall require all its Sub-Contractors to provide the aforementioned coverage as well as any other coverage that the Contractor may consider necessary, and any deficiency in the coverage or policy limits of said Sub-Contractors will be the sole responsibility of the Contractor.

## **2.28 Insurance for Collection of Credit Card Payments – Not Applicable**

## **2.29 Award of Contract**

Contractor must bid on all items. Partial bids will not be considered.

The City also reserves the right to accept or reject any or all bids, part of bids, and to waive minor irregularities or variations to specifications contained in bids, and minor irregularities in the bidding process. The City also reserves the right to award the contract on a split order basis, lump sum basis, individual item basis, or such combination as shall best serve the interest of the City.

A Contract (the "Agreement") may be awarded by the City Commission. The City reserves the right to execute or not execute, as applicable, a contract with the Bidder(s) that is determined to be in the City's best interests. The City reserves the right to award a contract to more than one Bidder, at the sole and absolute discretion of the in the City.

## **2.30 Damage to Public or Private Property**

Extreme care shall be taken to safeguard all existing facilities, site amenities, irrigation systems, vehicles, etc. on or around the job site. Damage to public and/or private property shall be the responsibility of the Contractor and shall be repaired and/or replaced at no additional cost to the City.

## **2.31 Safety**

The Contractor(s) shall adhere to the Florida Department of Transportation's Uniform manual on Traffic Control for construction and maintenance work zones when working on or near a roadway. It will be the sole responsibility of the Contractor to make themselves and their employees fully aware of these provisions, especially those applicable to safety.

## **2.32 Uncontrollable Circumstances ("Force Majeure")**

The City and Contractor will be excused from the performance of their respective obligations under this agreement when and to the extent that their performance is delayed or prevented by any circumstances beyond their control including, fire, flood, explosion, strikes or other labor disputes, act of God or public emergency, war, riot, civil commotion, malicious damage, act or omission of any governmental authority, delay or failure or shortage of any type of transportation, equipment, or service from a public utility needed for their performance, provided that:

**2.32.1** The non-performing party gives the other party prompt written notice describing the particulars of the Force Majeure including, but not limited to, the nature of the occurrence and its expected duration, and continues to furnish timely reports with respect thereto during the period of the Force Majeure;

**2.32.2** The excuse of performance is of no greater scope and of no longer duration than is required by the Force Majeure;

**2.32.3** No obligations of either party that arose before the Force Majeure causing the excuse of performance are excused as a result of the Force Majeure; and

**2.32.4** The non-performing party uses its best efforts to remedy its inability to perform. Notwithstanding the above, performance shall not be excused under this Section for a period in excess of two (2) months, provided that in extenuating circumstances, the City may excuse performance for a longer term. Economic hardship of the Contractor will not

constitute Force Majeure. The term of the agreement shall be extended by a period equal to that during which either party's performance is suspended under this Section.

### **2.33 Canadian Companies**

In the event Contractor is a corporation organized under the laws of any province of Canada or is a Canadian federal corporation, the City may enforce in the United States of America or in Canada or in both countries a judgment entered against the Contractor. The Contractor waives any and all defenses to the City's enforcement in Canada, of a judgment entered by a court in the United States of America. All monetary amounts set forth in this Contract are in United States dollars.

### **2.34 News Releases/Publicity**

News releases, publicity releases, or advertisements relating to this contract, or the tasks or projects associated with the project shall not be made without prior City approval.

### **2.35 Approved Equal or Alternative Product Bids**

The Technical Specifications contained in this solicitation are to be used as a reference only and are not to be considered of a proprietary nature. These specifications represent a level of quality and features that are desired by the City of Fort Lauderdale. The City is receptive to any product that would be considered by qualified City personnel as an approved equal.

The Contractor must state clearly in their bid pages any variance to the specifications. If proposing an approved equal or alternate product, it will be the Contractor's responsibility to provide adequate information in their bid to enable the City to ensure that the Contractor meets the required criteria. If adequate information is not submitted with the bid, it may be rejected.

The City of Fort Lauderdale will be the sole judge in determining if the product proposed qualifies as approved equal. The City reserves the right to award to that Contractor which will best serve the interest of the City as determined by the City. The City further reserves the right to waive minor variations to specifications and in the bidding process.

### **2.36 Contract Period**

This is a one-time service. There will be no renewals.

### **2.37 Cost Adjustments**

Prices quoted shall be firm. No cost increases shall be accepted.

### **2.38 Service Test Period – Not Applicable**

### **2.39 Contract Coordinator**

The City may designate a Contract Coordinator whose principal duties shall be:

- Liaison with Contractor.
- Coordinate and approve all work under the contract.
- Resolve any disputes.
- Assure consistency and quality of Contractor's performance.
- Schedule and conduct Contractor performance evaluations and document findings.
- Review and approve for payment all invoices for work performed or items delivered.

**2.40 Contractor Performance Reviews and Ratings**

The City Contract Coordinator may develop a Contractor performance evaluation report. This report shall be used to periodically review and rate the Contractor's performance under the contract with performance rating as follows:

|                |  |
|----------------|--|
| Excellent      | Far exceeds requirements.  |
| Good           | Exceeds requirements   |
| Fair           | Just meets requirements.   |
| Poor           | Does not meet all requirements and contractor is subject to penalty provisions under the contact.  |
| Non-compliance | Either continued poor performance after notice or a performance level that does not meet a significant portion of the requirements.<br>This rating makes the Contractor subject to the default or cancellation for cause provisions of the contract. |

The report shall also list all discrepancies found during the review period. The Contractor shall be provided with a copy of the report and may respond in writing if he takes exception to the report or wishes to comment on the report. Contractor performance reviews and subsequent reports will be used in determining the suitability of contract extension.

**2.41 Substitution of Personnel**

It is the intention of the City that the Contractor's personnel proposed for the contract will be available for the contract term. In the event the Contractor wishes to substitute personnel, he shall propose personnel of equal or higher qualifications and all replacement personnel are subject to City approval. In the event substitute personnel are not satisfactory to the City and the matter cannot be resolved to the satisfaction of the City, the City reserves the right to cancel the Contract for cause. See Section 5.09 General Conditions.

**2.42 Ownership of Work**

The City shall have full ownership and the right to copyright, otherwise limit, reproduce, modify, sell, or use all of the work or product produced under this contract without payment of any royalties or fees to the Contractor above the agreed hourly rates and related costs.

**2.43 Condition of Trade-In Equipment – Not Applicable**

**2.44 Conditions of Trade-In Shipment and Purchase Payment – Not Applicable**

**2.45 Verification of Employment Status**

Any Contractor/Consultant assigned to perform responsibilities under its contract with a State agency is required to utilize the US Department of Homeland Security's E-Verify system (per Executive Order Number 11-02) to verify the employment eligibility of: (a) all persons employed during the contract term by the Contractor to perform employment duties within Florida; and (b) all persons (including subcontractors) assigned by the Contractor to perform work pursuant to the contract with the State agency.

E-VERIFY Affirmation Statement must be completed and submitted with Bidder's response to this ITB.

## **2.46 Service Organization Controls – Not Applicable**

## **2.47 Warranties of Usage**

Any estimated quantities listed are for information and tabulation purposes only. No warranty or guarantee of quantities needed is given or implied. It is understood that the Contractor will furnish the City's needs as they arise.

## **2.48 Rules and Submittals of Bids**

The signer of the bid must declare that the only person(s), company or parties interested in the bid as principals are named therein; that the bid is made without collusion with any other person(s), company or parties submitting a bid; that it is in all respects fair and in good faith, without collusion or fraud; and that the signer of the bid has full authority to bind the principal bidder.

## **2.49 Bid Tabulations/Intent to Award**

Notice of Intent to Award Contract/Bid, resulting from the City's Formal solicitation process may be found at: <https://www.fortlauderdale.gov/government/departments-a-h/finance/procurement-services/notices-of-intent-to-award>. Tabulations of receipt of those parties responding to a formal solicitation may be found at: <https://www.fortlauderdale.gov/government/departments-a-h/finance/procurement-services/bid-results>, or any interested party may call the Procurement Services Division at 954-828-5933.

## **2.50 Public Records**

All bids will become the property of the City. The Bidder's response to the ITB is a public record pursuant to Florida law, which is subject to disclosure by the City under the State of Florida Public Records Law, Florida Statutes Chapter 119.07 ("Public Records Law"). The City shall permit public access to all documents, papers, letters, or other material submitted in connection with this ITB and any resulting Contract to be executed for this ITB, subject to the provisions of Chapter 119.07 of the Florida Statutes. Any language contained in the Bidder's response to the ITB purporting to require confidentiality of any portion of the Bidder's response to the ITB, except to the extent that certain information is in the City's opinion a Trade Secret pursuant to Florida law, shall be void. If a Bidder submits any documents or other information to the City which the Bidder claims is Trade Secret information and exempt from Florida Statutes Chapter 119.07 ("Public Records Laws"), the Bidder shall clearly designate that it is a Trade Secret and that it is asserting that the document or information is exempt. The Bidder must specifically identify the exemption being claimed under Florida Statutes 119.07. The City shall be the final arbiter of whether any information contained in the Bidder's response to the ITB constitutes a Trade Secret. The city's determination of whether an exemption applies shall be final, and the Bidder agrees to defend, indemnify, and hold harmless the city and the city's officers, employees, and agent, against any loss or damages incurred by any person or entity as a result of the city's treatment of records as public records. In the event of Contract award, all documentation produced as part of the Contract shall become the exclusive property of the City.

**IF THE CONTRACTOR HAS QUESTIONS REGARDING THE APPLICATION OF CHAPTER 119, FLORIDA STATUTES, TO THE CONTRACTOR'S DUTY TO PROVIDE PUBLIC RECORDS RELATING TO THIS CONTRACT, CONTACT THE CUSTODIAN OF PUBLIC RECORDS AT [PRRCONTRACT@FORTLAUDERDALE.GOV](mailto:PRRCONTRACT@FORTLAUDERDALE.GOV), 954-828-5002, CITY CLERK'S OFFICE, 100 N. ANDREWS AVENUE, FORT LAUDERDALE, FLORIDA 33301.**

Contractor shall:

1. Keep and maintain public records required by the City in order to perform the service.
2. Upon request from the City's custodian of public records, provide the City with a copy of the requested records or allow the records to be inspected or copied within a reasonable time at a cost that does not exceed the cost provided in Chapter 119, Florida Statutes (2022), as may be amended or revised, or as otherwise provided by law.
3. Ensure that public records that are exempt or confidential and exempt from public records disclosure requirements are not disclosed except as authorized by law for the duration of the contract term and following completion of this contract if the Contractor does not transfer the records to the City.
4. Upon completion of the Contract, transfer, at no cost, to the City all public records in possession of the Contractor or keep and maintain public records required by the City to perform the service. If the Contractor transfers all public records to the City upon completion of this Contract, the Contractor shall destroy any duplicate public records that are exempt or confidential and exempt from public records disclosure requirements. If the Contractor keeps and maintains public records upon completion of this Contract, the Contractor shall meet all applicable requirements for retaining public records. All records stored electronically must be provided to the City, upon request from the City's custodian of public records, in a format that is compatible with the information technology systems of the City.

**2.51 PCI (Payment Card Industry) Compliance**

Contractor agrees to comply with all applicable state, federal and international laws, as well as industry best practices, governing the collection, access, use, disclosure, safeguarding and destruction of protected information.

Contractor and/or any subcontractor that handles credit card data must be, and remain, PCI compliant under the current standards and will provide documentation confirming compliance upon request by the City of Fort Lauderdale, failure to produce documentation could result in termination of the contract.

*END OF SECTION*

## SECTION III - TECHNICAL SPECIFICATIONS/SCOPE OF SERVICES

### LAUDERDALE MANORS POOL

#### 3.1 INTRODUCTION

The City of Fort Lauderdale (City), in accordance with the following technical specifications and drawings is seeking bids from qualified firms to resurface of the lap pool at Fort Lauderdale Manor Pool, located at 1340 Chateau Park Drive, Fort Lauderdale, Florida 33311.

To make arrangements for on-site inspection of the Pool, please contact:

Abraham Gopaul | Project Manager II  
City of Fort Lauderdale | Parks and Recreation Department  
220 SW 14th Ave, Building 7, Fort Lauderdale, FL 33312  
P: 954-828-6560 | M: 954-856-1755  
E: [agopaul@fortlauderdale.gov](mailto:agopaul@fortlauderdale.gov)

#### 3.2 INSTRUCTION TO BIDDERS

The contractor shall adhere to the following requirements when preparing his bid:

A list of all subcontractors must be supplied with the bid response.

Bidder shall provide a schedule to execute the pool-resurfacing project in the ITB response. **It is important to note that the actual pool resurfacing work commencement date is subjected to the event/programming schedule of Lauderdale Manors Pool and shall be determined by City/Facility Management.** The contractor shall commit to the start and finish date for completion of this project as defined by the **City/Facility Management**.

#### 3.3 SCOPE

The following documents are related to this project and are attached to the bid: Drawings: Project #84184 SP-2, SP-3, SP-4, SP-4, and SP-6 and these technical specifications – Fort Lauderdale Manors Pool.

The contractor shall furnish all labor, material, equipment, licenses, bonds, permits, and incidentals for the resurfacing of the lap pool at the Manor Park in accordance with the following specifications:

#### 3.4 SPECIFICATIONS

##### **Material Specifications:**

The pool is to be resurfaced utilizing a color approved Portland cement-based quartz aggregate, such as Diamond Brite or approved equivalent.

##### **Contractor's Qualifications:**

The contractor must be a currently approved/qualified applicator of material specified herein and must furnish proof of such qualification to the City from the manufacturer.

The contractor should be normally engaged in the work of competitive swimming pool resurfacing at the time of bid submission.

**Pool Specifications: The Contractor shall be responsible for verifying all dimensions and quantities.**

- Approximate surface area: 2,275 square feet,
- Approximate Water volume: 77,400 gallons
- Shape: rectangular

### 3.5 EXECUTION

The following are the minimum specifications for the resurfacing of the pool, **and in no way represent a complete list**:

All work is to be performed in accordance with the Florida Building Code by legally licensed and insured contractors capable of pulling all necessary permits to successfully complete the project.

The pool resurfacing shall be in compliance with all applicable State and local codes and regulations.

#### 3.5.1 Custody Transfer

Once a final project commencement date has been determined by the City/Facility Management for the pool resurfacing project, as mandated by the event/programming schedule of Lauderdale Manors, the pool will be drained down to the point the pool pumps will allow. At this point the pool will be handed over to the contractor for the execution of the pool resurfacing.

#### 3.5.2 Finish Draining

The remainder of the pool water is to be drained by the Contractor by other appropriate means. Excess water would be discharged into the city drainage system.

The contractor is responsible to determine if dewatering is necessary and if required provide appropriate equipment and dewater as required.

#### 3.5.3 Surface Preparation

During the preparatory phase of this project, the contractor shall protect all existing pool fixtures and tiles for the next phases of the project. Note: any damaged fixtures and tiles will be replaced at the contractor's expense.

The pool surface preparation shall include, but not be limited:

**Demolish the existing pool surface:** - Method for removing the existing pool surface material may include, but not be limited to sandblasting, grinding, chipping via electrical, or pneumatic tools, so long as complete removal of the existing surface, down to the previous pool surface (Gunitite) is achieved on the floor and walls of the pool.

All the existing Diamond Brite surfaces shall be mechanically chipped or gauged in order to allow for proper bonding between the new surface material.

Undercut around all return fittings, tiles, and gutters: 2 inches away and at least 3/8 inches deep.

**Remove existing recessed plastic pool steps.** Method for removing the existing pool step inserts may include, but not be limited to cutting, grinding, chipping via electrical, or pneumatic tools, so long as complete removal of the existing plastic step inserts is achieved.

**Inspection:** After the demolishing of the original surface the contractor shall inspect the pool walls and floor for loose, hollow, delamination, and loose tiles. Probing/sounding by appropriate means (bound test or industrial acceptable equivalent) shall be done to determine where or if hollow areas are present.

**Repair defects:** Any defects shall be removed by chipping using electrical, or pneumatic tools. After removal of the defected areas, the pool walls and floor shall be restored for the acceptance of the new surface material. Areas where the existing marcite or pool finish was removed for hollow spots or



delaminating, must be built up using a sand topping mix or a Vinyl patching compound. The final finish of repaired areas shall be in the same vertical plane or levelness. Repairs shall be approved by the City's designated inspector.

Finally, any damaged lane tiles, wall targets, and tile breaks shall be removed, and retiled (color determined by City), as originally accurate within one quarter inch in each direction, as dictated by the Florida State Department of Health or as dictated by owner. Any damage incurred would be replaced at the contractor's cost.

**Exposed rebar:** All exposed, and/or bleeding rebar must be exposed and coated with an epoxy-based material to prevent any future staining of the newly applied surface material.

**Acid Wash:** After removal of the existing pool finish, the entire pool surface that is to be resurfaced shall be acid wash with at least 50% acid solution.

**Neutralization:** Neutralization of the acid solution shall be completed with a solution of soda ash and water. The contractor shall ensure that the neutralization process is complete to the acceptance of the City designated inspector.

#### **3.5.4 Application / Installation**

**New stainless steel wall step inserts, installation includes:** 6 sets of 3 steps for a total of 18 step inserts. Paragon KDI-32104 steps are preferred. Each step must electrically bond to the pool structure steel using a #6 ground wire. Steps are cemented in using a concrete hydraulic mixture to secure the steps in place leaving enough clearance for ½ thickness of new aggregate finish to be installed flush with the new steps.

**Bonding agent:** Apply one coat of multi-coat scratch coat bonding agent such as Bond Kote or equivalent to entire surface of the pool.

**Application of New Surface:** Apply Portland cement-based quartz aggregate, such as Diamond Brite or approved equivalent as approved by City/Facility Management as follows:

- Surface thickness for floor: 3/8 inch to 1/2 inch in thickness to the floor.
- Surface thickness for walls: 3/8 inch to 1/2 inch in thickness to the pool.

Daily application of the new surface must be finished against new or existing ceramic tile. Cold joints are **not** acceptable.

After the new surface has had time to cure or harden, the aggregate shall be exposed by using water & scrub brushes so that the color in the finished surface is even and continuous. In some cases, muriatic acid might be necessary to expose the aggregate.

After the aggregate has been exposed, the pool fixtures that were removed during the preparation stage shall be replaced with new eyeball returns, new vacuum covers, static wall covers and two (2) VGBA approved main drain covers.

Successful application and finishing of the new surface will be affected by the weather conditions during the application stage. Conditions that could affect the application quality include but are not limited to accelerated drying time due to exposure to direct sunlight, rain, air movement, humidity, and temperature. The Contractor shall take these factors into consideration and choose the most favorable time of day to apply the new surface material so as to minimize any harmful effects associated with the above-

mentioned conditions.

**ANY ADDITIONAL COST ASSOCIATED WITH THE REDUCTION OF DAMAGE, INCLUDING BUT NOT LIMITED TO FAST DRYING TIME DUE TO EXPOSURE TO DIRECT SUNLIGHT, RAIN, AIR, TEMPERATURE TO THE DIAMOND BRITE COATING SHALL BE INCLUDED IN THE PRICE OF THE CONTRACTOR'S BID.**

### **3.5.5 Pool Refill**

The Contractor will be responsible for the refilling pool. The contractor shall filter the water using appropriate filters. Sequestering agent should be added at the time the pool is being filled to reduce staining.

The contractor shall also be responsible for re-balancing of the pool chemicals to Florida State Department of Health standards.

### **3.5.6 Materials & Storage**

All materials shall be new and shall be delivered to the project site in unopened containers from the manufacturer. The containers shall clearly indicate color, designated name, date of manufacture, and name of manufacturer. Materials will be stored as recommended by the manufacturer in a suitable protected area. The storage parameters shall include but are not limited to temperature and moisture.

The contractor must maintain the job site in a clean, and orderly manner on a daily basis throughout the course of the project until satisfactory completion of the project.

The contractor shall be responsible for the proper removal and disposal off –site of all materials removed, and utilized throughout the course of the project, until satisfactorily completing the project.

### **3.5.7 Certification**

The contractor shall provide the required documentation for the Department of Health for certification.

## **3.6 WARRANTY**

The Contractor along with the Manufacture of the Portland cement-based quartz aggregate, such as Diamond Brite or approved equivalent for a minimum period of 5 years for labor & materials. This warranty shall be for against material failure & delamination, which includes labor to make any repairs, needed.

## **RIVERLAND POOL LAP POOL AND SURGE PIT**

### **3.7 INTRODUCTION**

The City of Fort Lauderdale (City), in accordance with the following technical specifications and drawings is seeking bids from qualified firms to resurface of the lap pool at Fort Lauderdale Riverland Pool, located at 950 SW 27<sup>th</sup> Ave, Fort Lauderdale, Florida 33312.

To make arrangements for on-site inspection of the Pool, please contact:

Abraham Gopaul | Project Manager II  
City of Fort Lauderdale | Parks and Recreation Department  
220 SW 14th Ave, Building 7, Fort Lauderdale, FL 33312  
P: 954-828-6560 | M: 954-856-1755

E: [agopaul@fortlauderdale.gov](mailto:agopaul@fortlauderdale.gov)

### 3.8 INSTRUCTION TO BIDDERS

The contractor shall adhere to the following requirements when preparing his bid:

Provide a list of all subcontractors who must be supplied with the bid response.

Bidder shall provide a schedule to execute the pool-resurfacing project in the ITB response. **It is important to note that the actual pool resurfacing work commencement date is subjected to the event/programming schedule of Riverland Pool and shall be determined by City/Facility Management.** The contractor shall commit to the start and finish date for completion of this project as defined by the **City/Facility Management**.

### 3.9 SCOPE

The following documents are related to this project and are attached to the bid: Drawings: Project #P15245 C-17, C-18, and these technical specifications - Riverland Pool Lap Pool and Surge Pit.

The contractor shall furnish all labor, material, equipment, licenses, bonds, permits, and incidentals for the resurfacing of the lap pool and surge pit (wet well) at the Riverland Pool Park in accordance with the following specifications:

### 3.10 SPECIFICATIONS

#### **Material Specifications:**

The pool is to be resurfaced utilizing a color approved Portland cement-based quartz aggregate, such as Diamond Brite or approved equivalent.

#### **Contractor's Qualifications:**

The contractor must be a currently approved/qualified applicator of material specified herein and must furnish proof of such qualification to the City from the manufacturer.

The contractor should be normally engaged in the work of competitive swimming pool resurfacing at the time of bid submission.

**Pool Specifications: The Contractor shall be responsible for verifying all dimensions and quantities.**

- Approximate surface area: 4,863 square feet
- Approximate Water volume: 153,814 gallons
- Shape: L shaped with ADA access ramp
- Approximate Surge tank dimensions: 6' x 6' x 6'
- Approximate Surge tank water volume: 1,350 gal

### 3.11 EXECUTION

The following are the minimum specifications for the resurfacing of the pool, **and in no way represent a complete list:**

All work is to be performed in accordance with the Florida Building Code by legally licensed and insured contractors capable of pulling all necessary permits to successfully complete the project.

The pool resurfacing shall be in compliance with all applicable State and local codes and regulations.

### **3.11.1 Custody Transfer**

Once a final project commencement date has been determined by the City/Facility Management for the pool resurfacing project, as mandated by the event/programming schedule of Riverland Pool, the pool will be drained down to the point the pool pumps will allow. At this point the pool will be handed over to the contractor for the execution of the pool resurfacing.

### **3.11.2 Finish Draining**

The remainder of the pool water is to be drained by the Contractor by other appropriate means. Excess water would be discharged into the city drainage system.

Contractor is responsible to determine if dewatering is necessary and if required provide appropriate equipment and dewater as required.

### **3.11.3 Surface Preparation**

During the preparatory phase of this project, the contractor shall protect all existing pool fixtures for the next phases of the project. Note: any damaged fixtures will be replaced by the contractor's expense.

The pool surface preparation shall include, but not be limited:

**Demolish the existing pool surface:** - Method for removing the existing pool surface material may include, but not be limited to sandblasting, grinding, chipping via electrical, or pneumatic tools, so long as complete removal of the existing surface, down to the previous pool surface (Gunitite) is achieved on the floor and walls of the pool.

All of the existing Diamond Brite surfaces shall be mechanically chipped or gauged in order to allow for proper bonding between the new surface material.

Undercut around all floor and wall return fittings and tile: 2 inches away and at least 3/8 inches deep.

**Inspection:** After the demolishing of the original surface the contractor shall inspect the pool walls and floor for loose, hollow, delamination, and loose tiles. Probing/sounding by appropriate means (bound test or industrial acceptable equivalent) shall be done to determine where or if hollow areas are present.

**Repair defects:** Any defects shall be removed by chipping using electrical, or pneumatic tools. After removal the defected areas, the pool walls and floor shall be restored for the acceptance of the new surface material. Areas where the existing marcite or pool finish was removed for hollow spots or delaminating, must be built up using a sand topping mix or a Vinyl patching compound. The final finish of repaired areas shall be in the same vertical plane or levelness. Repairs shall be approved by the City's designated inspector.

Finally, any damaged lane tiles, wall targets, and tile breaks shall be removed, and retiled (color determined by City), as originally accurate within one quarter inch in each direction, as dictated by the Florida State Department of Health or as dictated by owner. Any damage incurred would be replaced at the contractor's cost.

**Exposed rebar:** All exposed, and/or bleeding rebar must be exposed and coated with an epoxy-based material to prevent any future staining of the newly applied surface material.

**Acid Wash:** After removal of the existing pool finish, the entire pool surface that is to be resurfaced shall be acid wash with at least 50% acid solution.

**Neutralization:** Neutralization of the acid solution shall be completed with a solution of soda ash and water. The contractor shall ensure that the neutralization process is complete to the acceptance of the City designated inspector.

#### **3.11.4 Application**

**Bonding agent:** Apply one coat of multi-coat scratch coat bonding agent such as Bond Kote or equivalent to entire surface of the pool.

**Application of New Surface:** Apply Portland cement-based quartz aggregate, such as Diamond Brite or approved equivalent as approved by City/Facility Management as follows:

- Surface thickness for floor: 3/8 inch to 1/2 inch in thickness to the floor.
- Surface thickness for walls: 3/8 inch to 1/2 inch in thickness to the pool.

Daily application of the new surface must be finished against new or existing ceramic tile. Cold joints are **not** acceptable.

After the new surface has had time to cure or harden, the aggregate shall be exposed by using water & scrub brushes so that the color in the finished surface is even and continuous. In some cases, muriatic acid might be necessary to expose the aggregate.

After the aggregate has been exposed, the pool fixtures that were removed during the preparation stage shall be reinstalled (main drain grate, pool return assemblies etc.).

Successful application and finishing of the new surface will be affected by the weather conditions during the application stage. Conditions that could affect the application quality includes but is not limited to: accelerated drying time due to exposure to direct sunlight, rain, air movement, humidity, and temperature. The Contractor shall take these factors into consideration and choose the most favorable time of day to apply the new surface material so as to minimize any harmful effects associated with the above-mentioned conditions.

**ANY ADDITIONAL COST ASSOCIATED WITH THE REDUCTION OF DAMAGE, INCLUDING BUT NOT LIMITED TO FAST DRYING TIME DUE TO EXPOSURE TO DIRECT SUNLIGHT, RAIN, AIR, TEMPERATURE TO THE DIAMOND BRITE COATING SHALL BE INCLUDED IN THE PRICE OF THE CONTRACTOR'S BID.**

#### **3.11.5 Pool Refill**

The Contractor will be responsible for the refilling pool. The contractor shall filter the water using appropriate filters. Sequestering agent should be added at the time the pool is being filled to reduce staining.

The contractor shall also be responsible for re-balancing of the pool chemicals to Florida State Department of Health standards.

#### **3.11.6 Materials & Storage**

All materials shall be new and shall be delivered to the project site in unopened containers from the manufacturer. The containers shall clearly indicate: color, designated name, date of manufacture, and name of manufacturer. Materials will be stored as recommended by the manufacturer in a suitable

protected area. The storage parameters shall include but is not limited to: temperature and moisture.


The contractor must maintain job site in a clean, and orderly manner on a daily basis throughout the course of the project until satisfactory completion of project.

The contractor shall be responsible for the proper removal and disposal off –site of all materials removed, and utilized throughout the course of the project, until satisfactorily completing the project.


### **3.12 WARRANTY**

The Contractor along with the Manufacture of the Portland cement-based quartz aggregate, such as Diamond Brite or approved equivalent for a minimum period of 5 years for labor & materials. This warranty shall be for against material failure & delamination, which includes labor to make any repairs, needed.


*END OF SECTION*

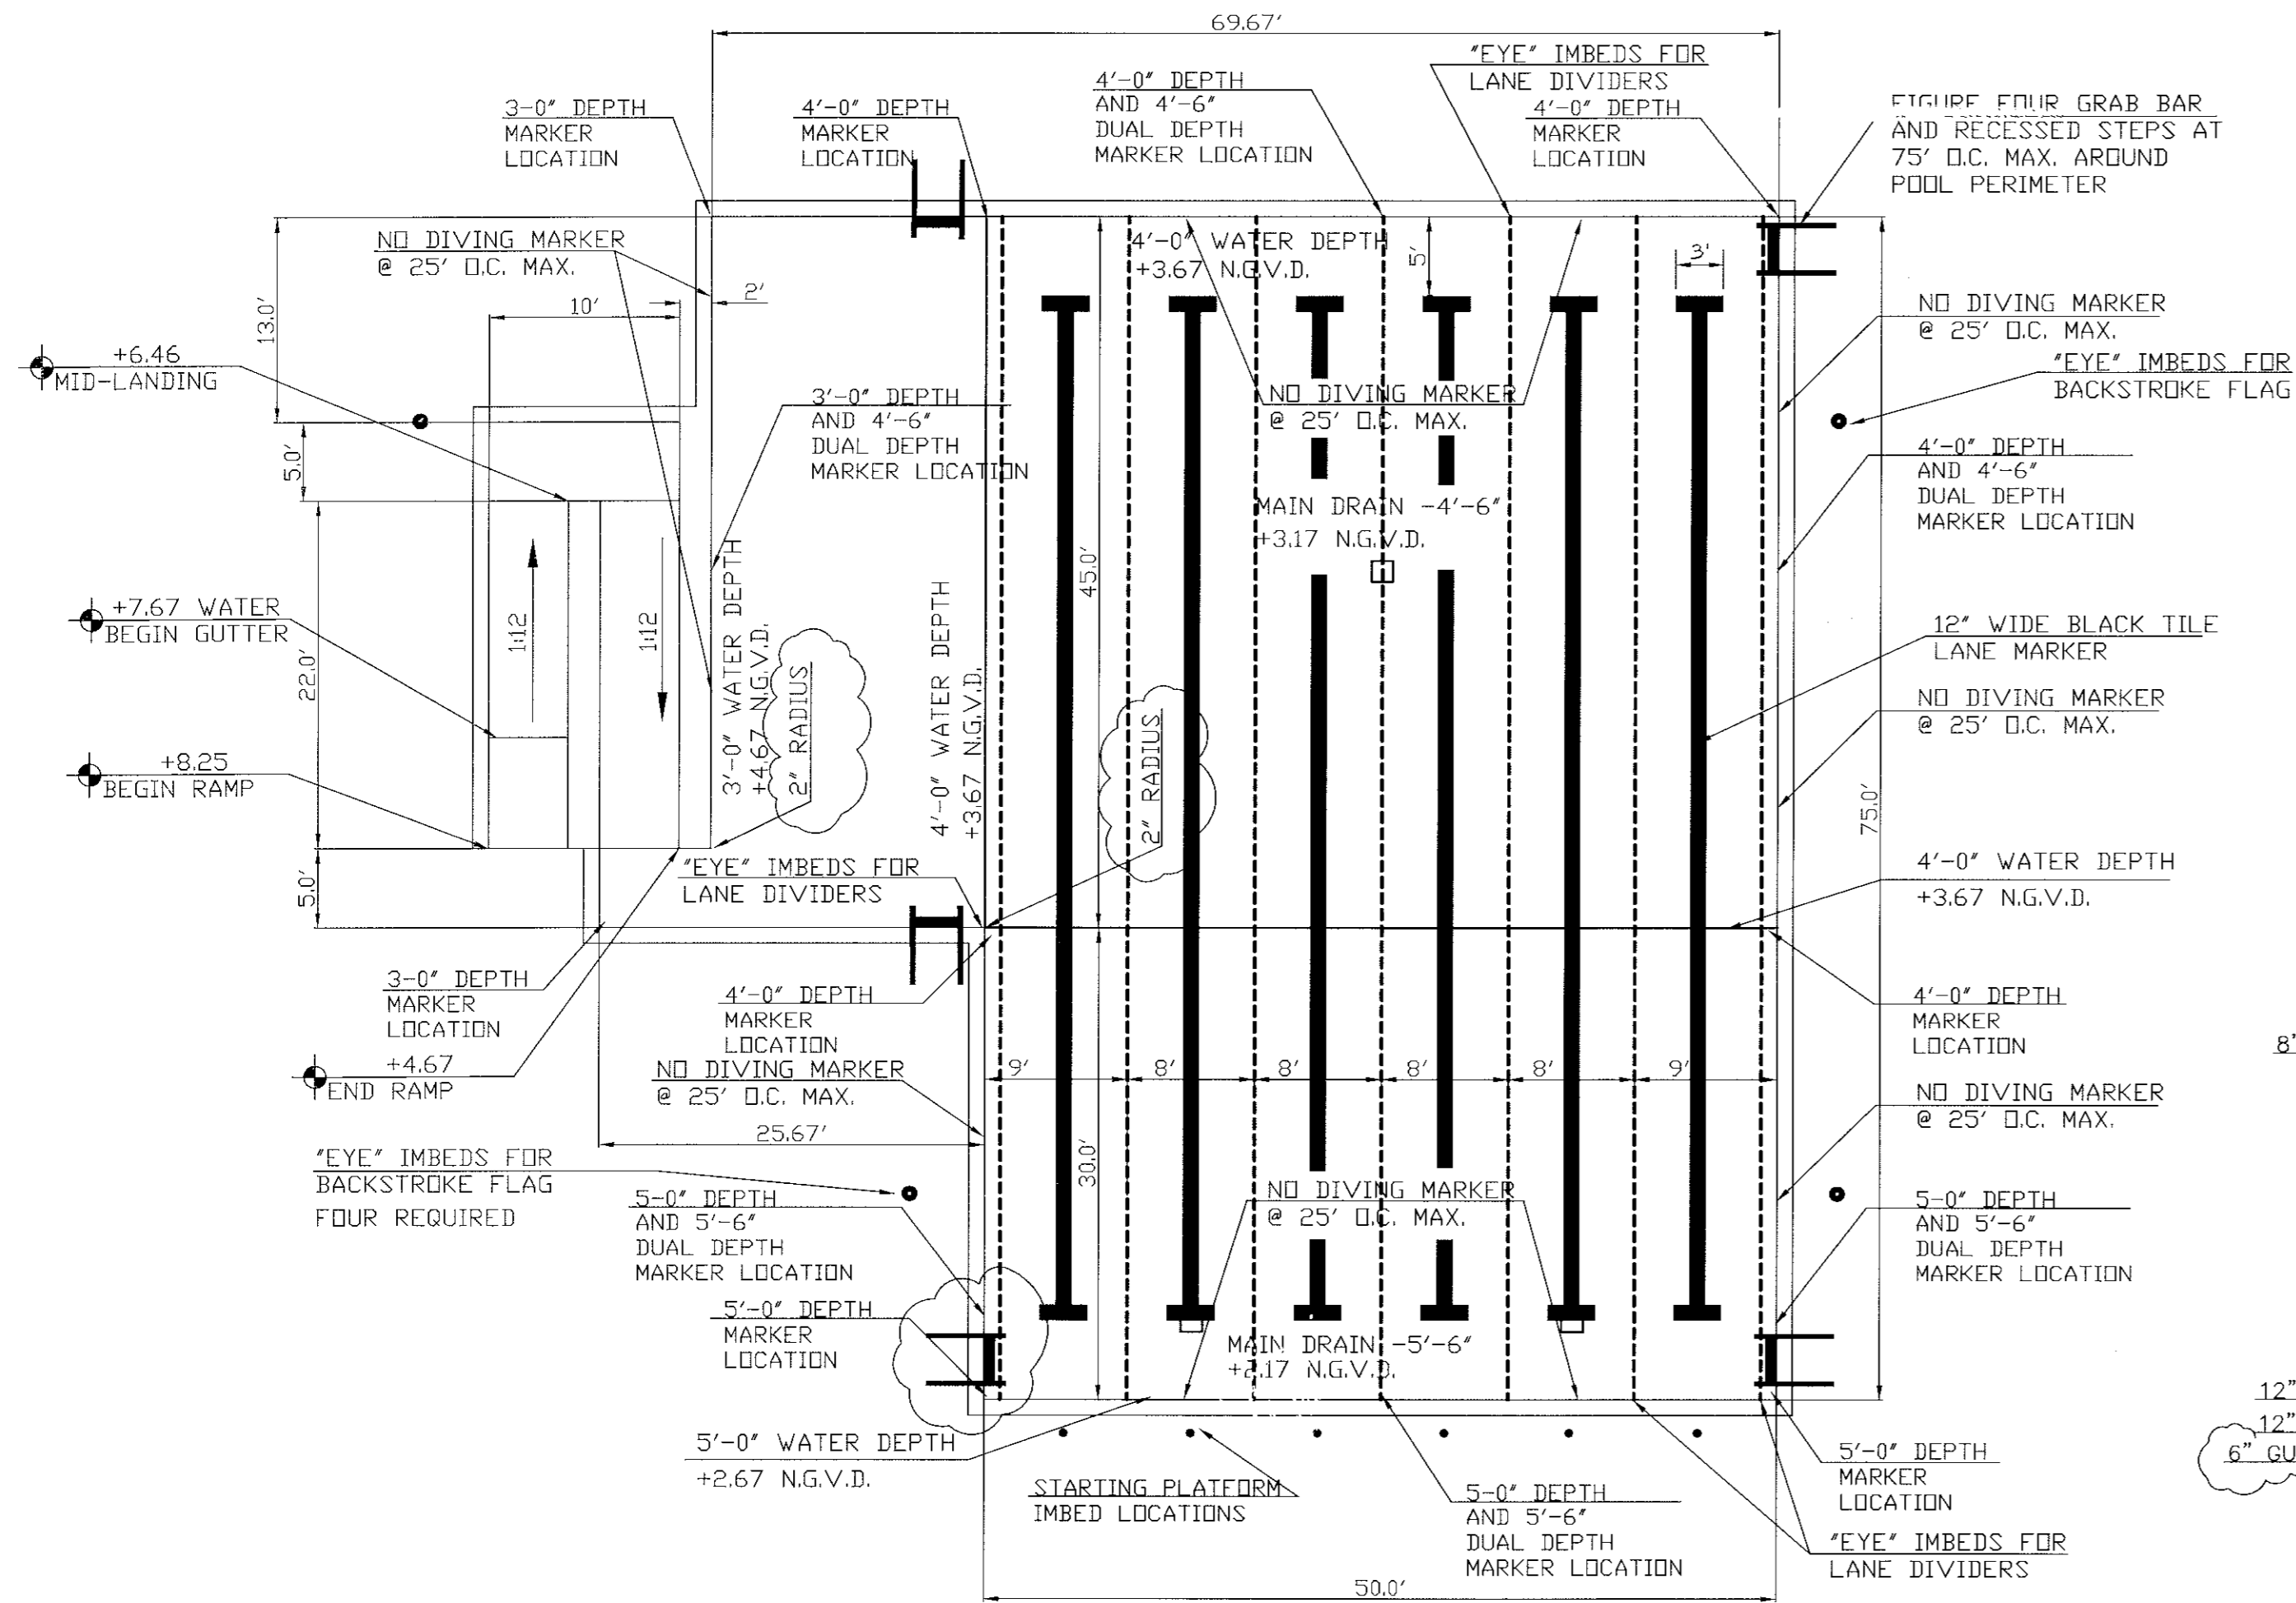


**POOL LAYOUT PLAN**  
SCALE 1"=10'

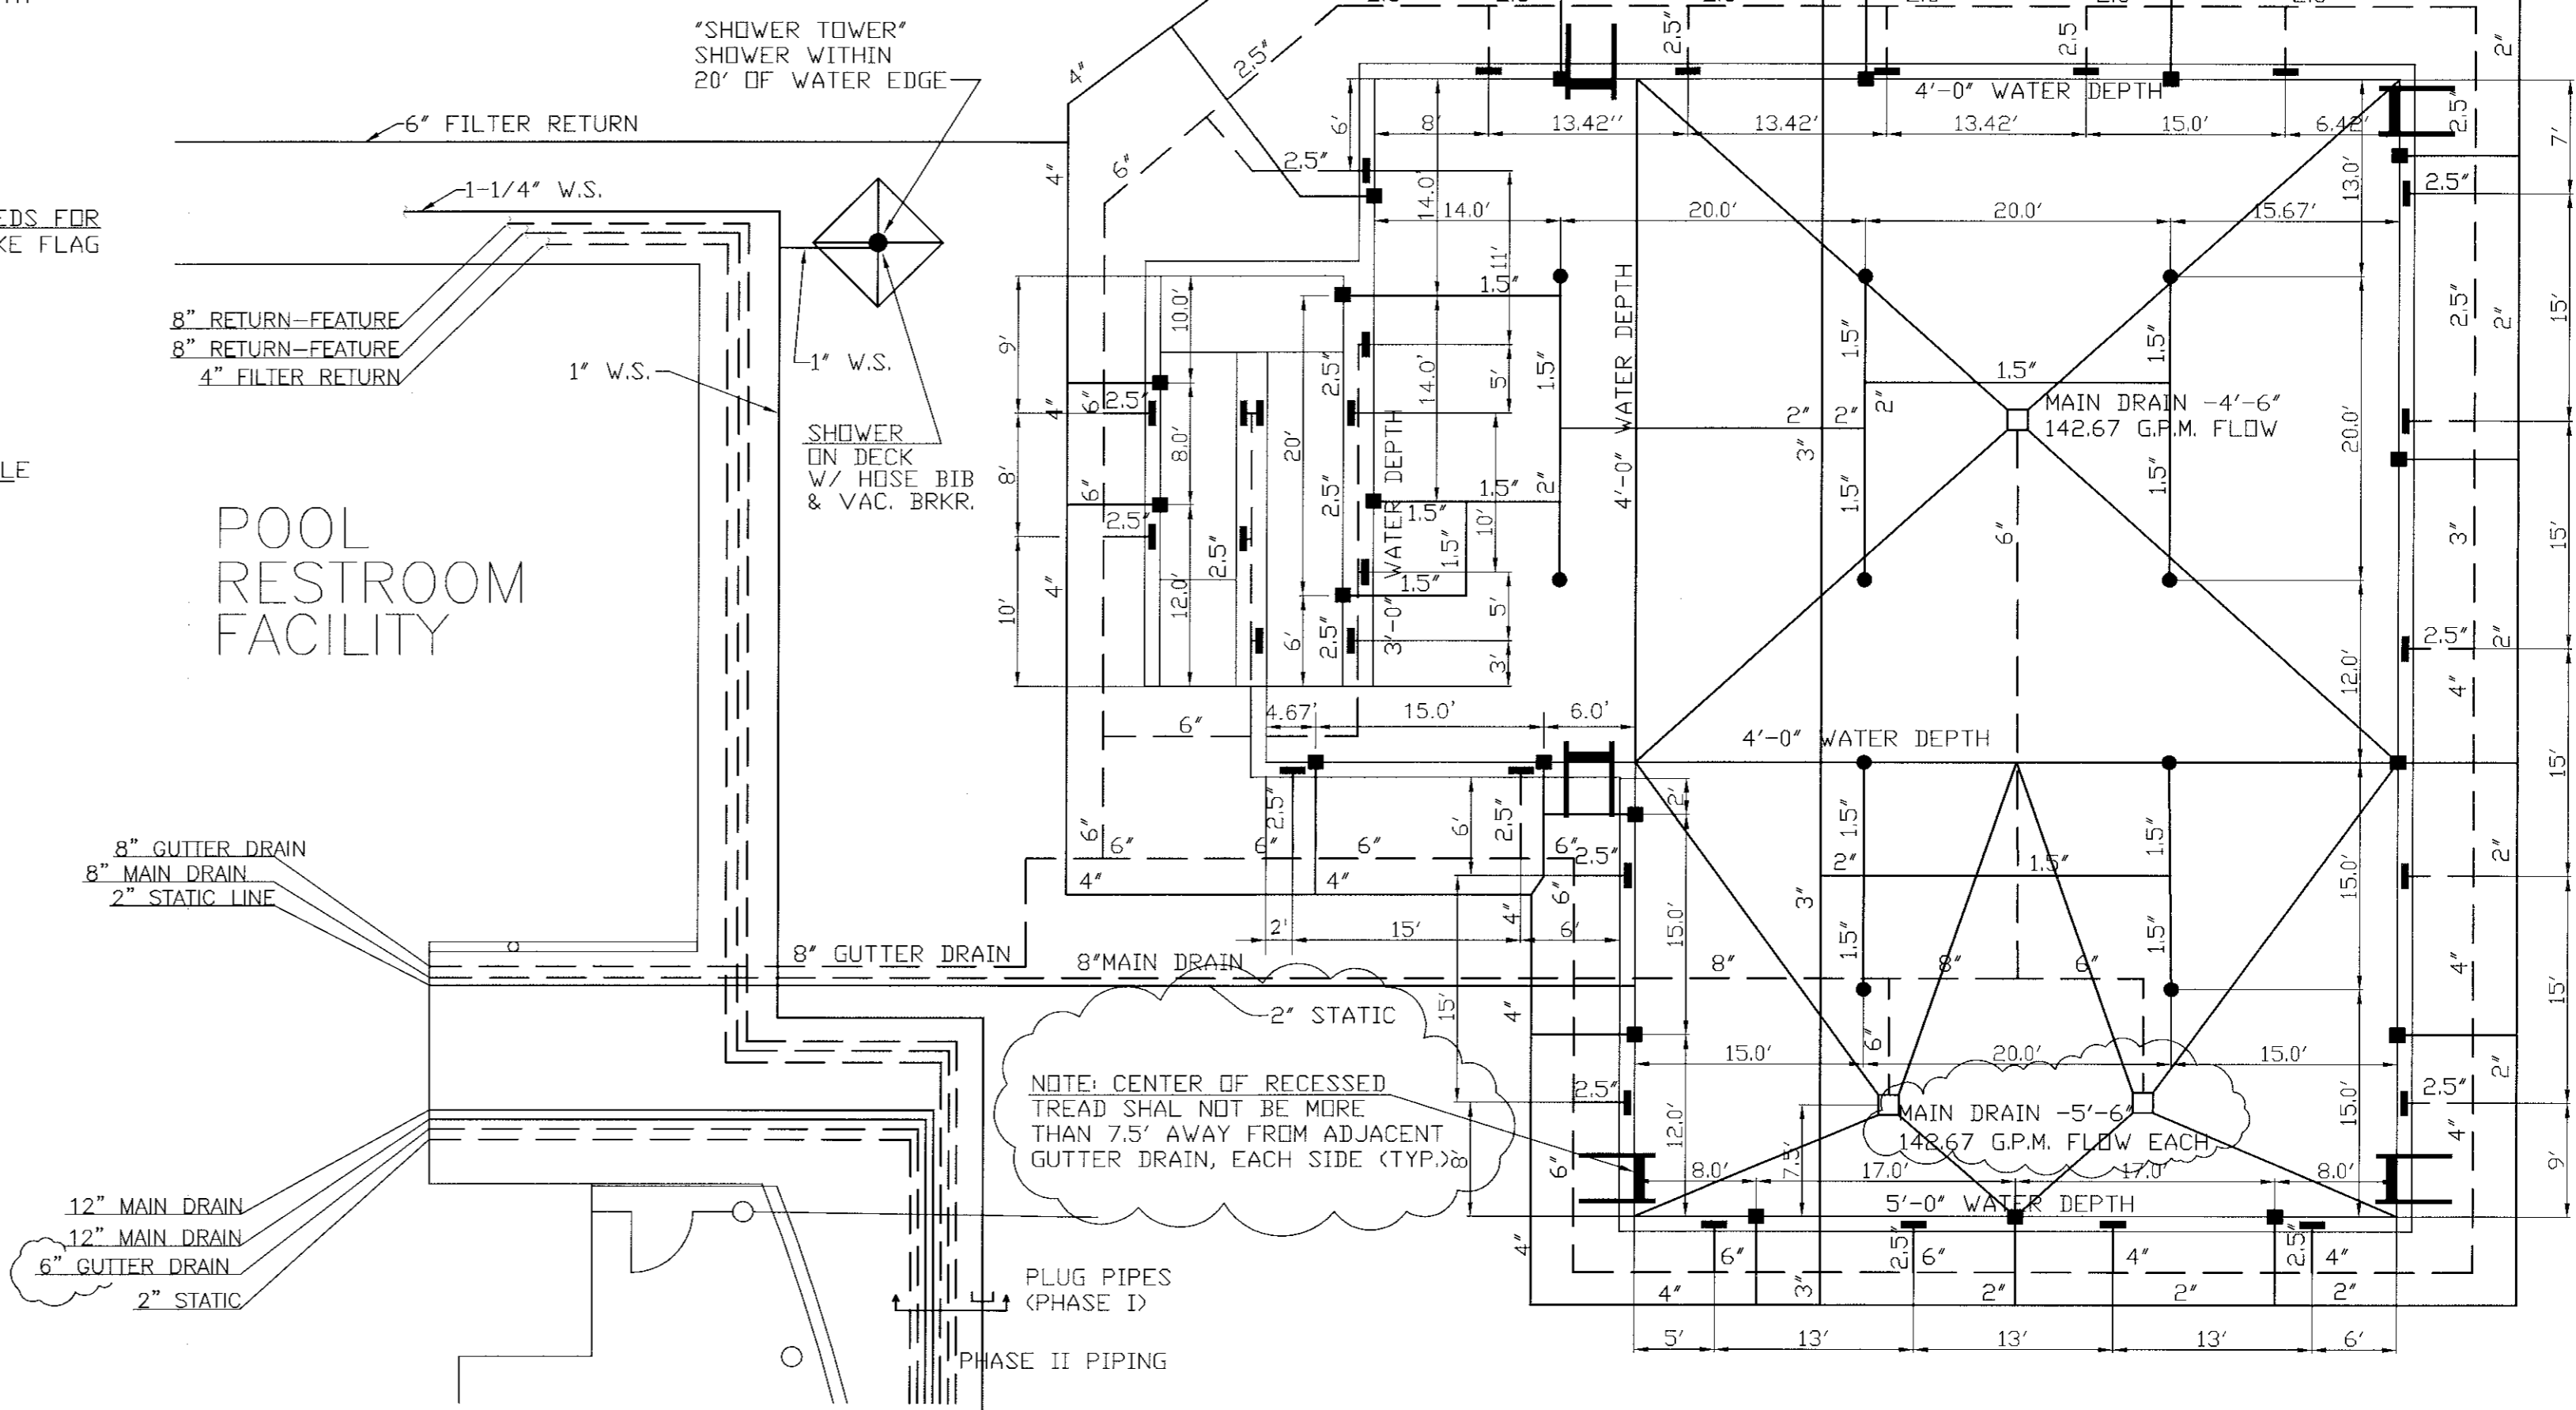


**POOL PIPING PLAN**  
SCALE 1"=10'

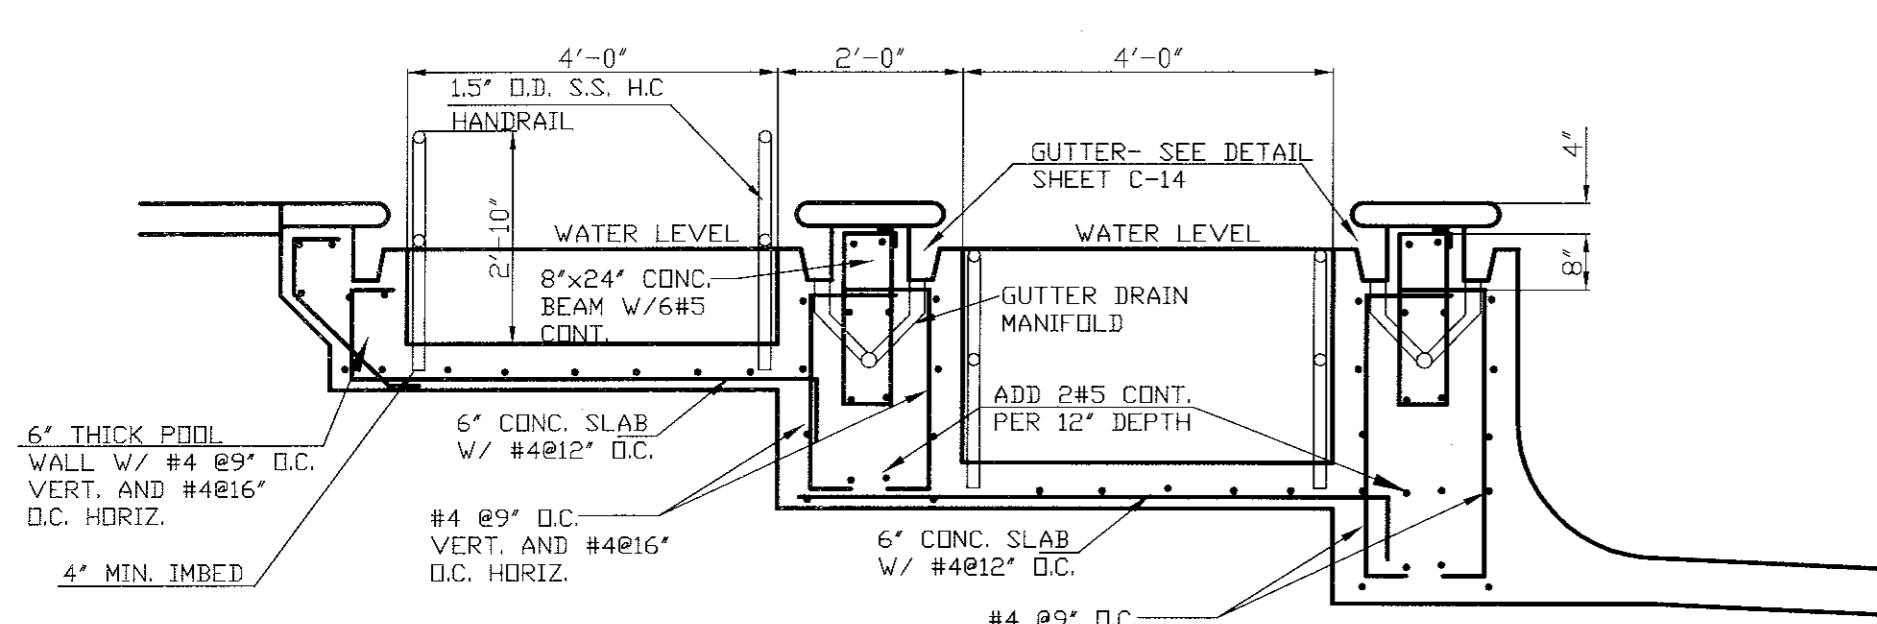

**RAMP SECTION**  
N.T.S.

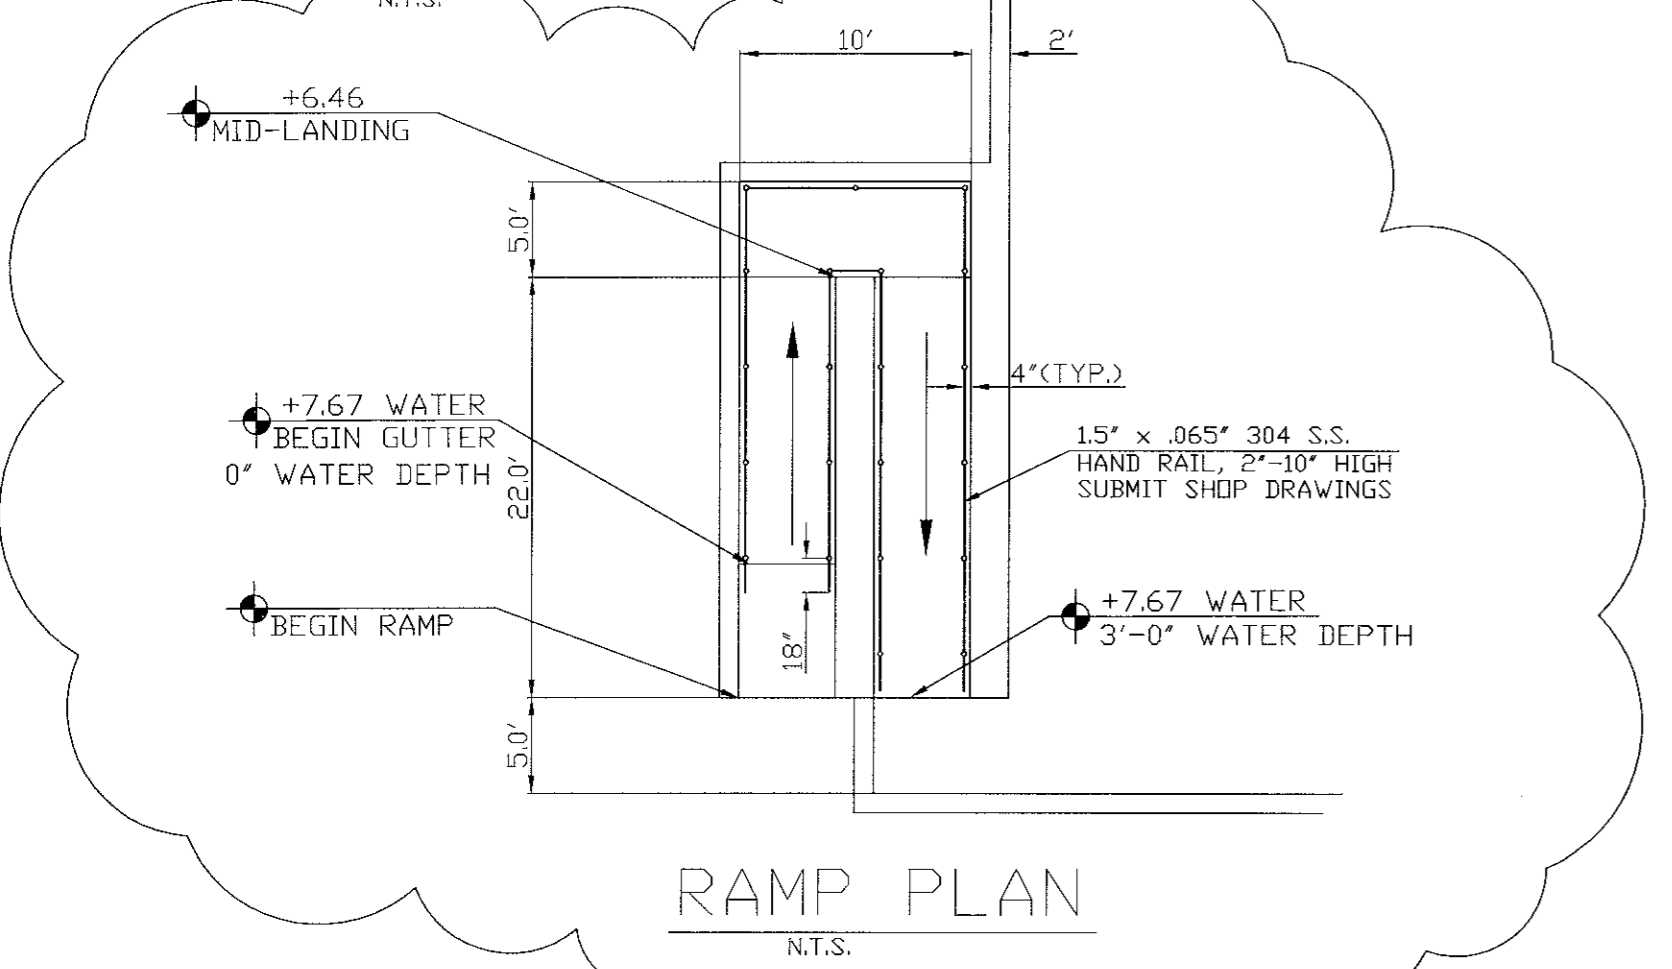


**RAMP PLAN**  
N.T.S.

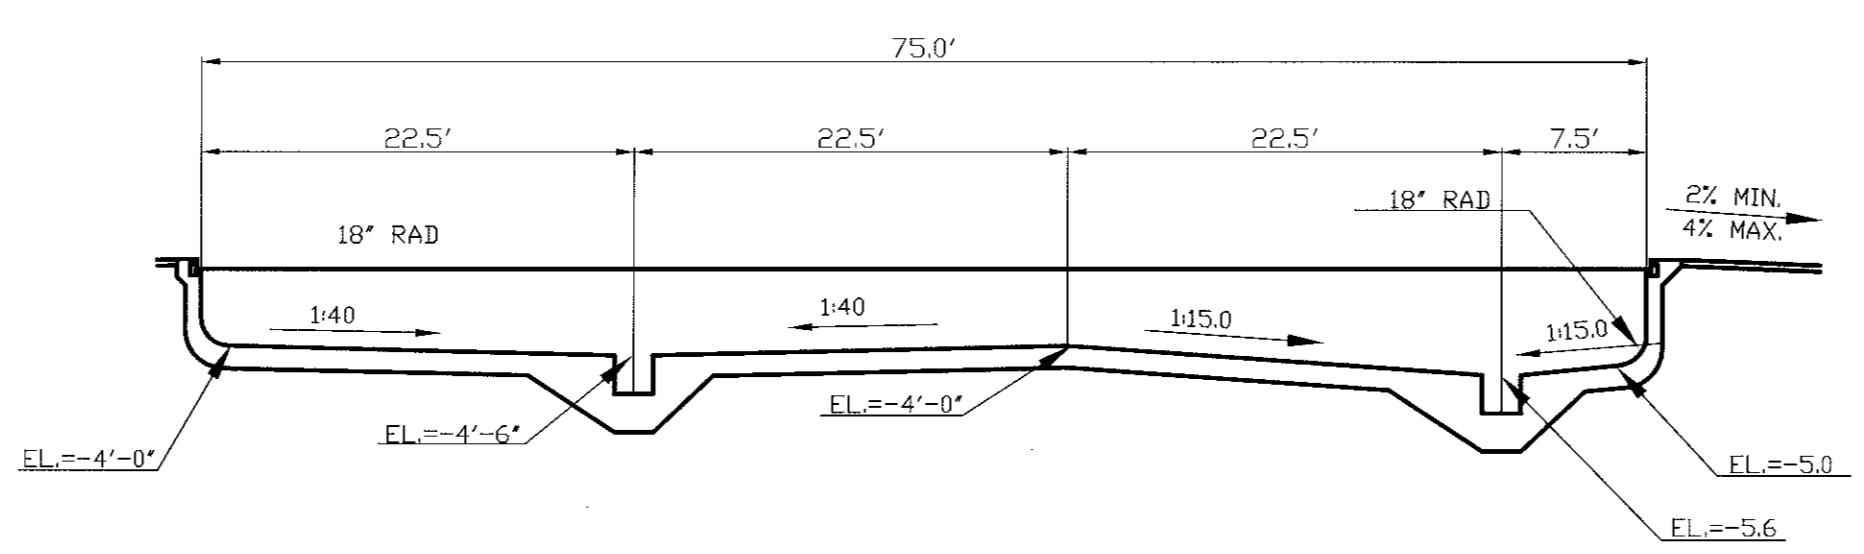

**POOL CROSS SECTION**  
N.T.S.

**TYPICAL POOL REINFORCING**

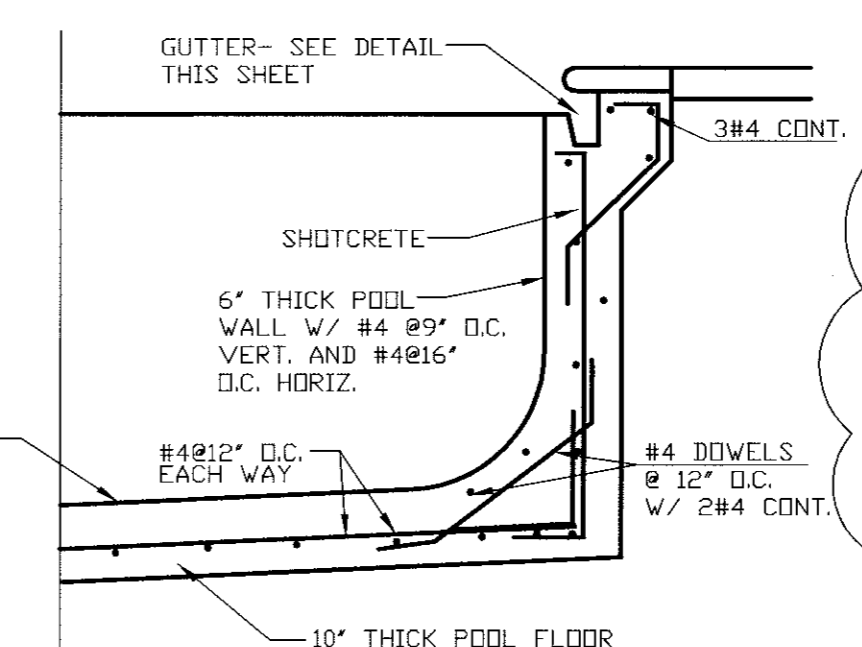

**POOL**  
N.T.S.

POOL FOUNDATION HAS BEEN DESIGNED FOR A SAFE SOIL BEARING CAPACITY OF 1500 P.S.F.

- FILTRATION NOTES**
1. POOL TURNOVER FLOW RATE 428 G.P.M.
  2. 30 2- 1/2" SCUM-GUTTER DRAINS @ 15' MAX. SPACING 14.0 G.P.M. 1.55 F.P.S.
  3. 30 1- 1/2" RETURN INLETS @ 20' MAX. SPACING 15.0 G.P.M. 2.36 F.P.S.
- WALL INLETS SHALL BE SPACED @ 20' MAX. D.C. FOR TOTAL POOL PERIMETER. FLOOR INLETS SHALL BE SPACED 15' MAX. PERPENDICULAR DISTANCE FROM POOL WALLS AND NOT GREATER THAN 20' DN CENTER AND SHALL PROTRUDE NO MORE THAN 5/8" ABOVE THE POOL FLOOR AND CONTAIN NO SHARP EDGES OR OTHER PROTRUSIONS HAZARDOUS TO BATHERS.

**SEAWOOD BUILDERS INC.**  
565 EAST HILLSBORO BOULEVARD  
DEERFIELD BEACH, FL 33441

**SCHARF & ASSOCIATES INCORPORATED**  
ARCHITECTS-PLANNERS  
3407 N.W. 9th Avenue  
Suite 200  
Ft. Lauderdale, Florida 33309  
954-566-2700  
AA-C001427  
PROJECT NO. 2210

**LAWRENCE DeROSE, P.E.**  
LICENSED ENGINEER NO. 20189  
STATE OF FLORIDA  
BY: \_\_\_\_\_  
DATE: \_\_\_\_\_

**DeRose & Slopey**  
CORPORATE ENGINEERS, INC.  
LAND SURVEYING • CIVIL • MECHANICAL  
ENVIRONMENT • ELECTRICAL • MECHANICAL  
410 S. ANDERSON AVENUE  
POMPANO BEACH, FLORIDA 33068  
(954) 962-7070

"AS BUILT SET" 11/10/05  
POOL PEOPLE COMMERCIAL INC


**CITY OF FORT LAUDERDALE**  
PUBLIC SERVICES DEPARTMENT  
**ARCHITECTURAL DIVISION**  
Architecture • Landscape Architecture • Project Management  
100 North Andrews Avenue, 5th Floor, Fort Lauderdale, Florida 33301

REVISIONS:

|                 |                 |          |
|-----------------|-----------------|----------|
| DATE:           | D/B CONTRACT:   | 9/10/03  |
| 09/30/03        | D/B COMMENTS:   | 9/15/03  |
| DRAWN BY:       | D/B 100% C.D.:  | 9/20/03  |
| JRL. / L.J.M.C. | D/B 100% C.D.:  | 10/21/03 |
| CHECKED BY:     | PERMITS:        | 12/03/03 |
| T.K.M.C.        | PER H.R.S.:     | 1/06/04  |
| CAD FILE:       | PER CONTRACTOR: | 9/16/04  |
| B548-CT-621POOL | S.O.L. NOTE:    | 10/10/04 |



**PROJECT #P15245**  
**RIVERLAND PARK COMMUNITY CENTER**  
**FORT LAUDERDALE, FLORIDA**  
**POOL DETAILS**  
950 SW 27 AVENUE, FORT LAUDERDALE, BROWARD COUNTY, FL 33312

SHEET NO.  
**C-17**  
OF 21  
DRAWING FILE NO.  
4-126-25  
CAM #23-086

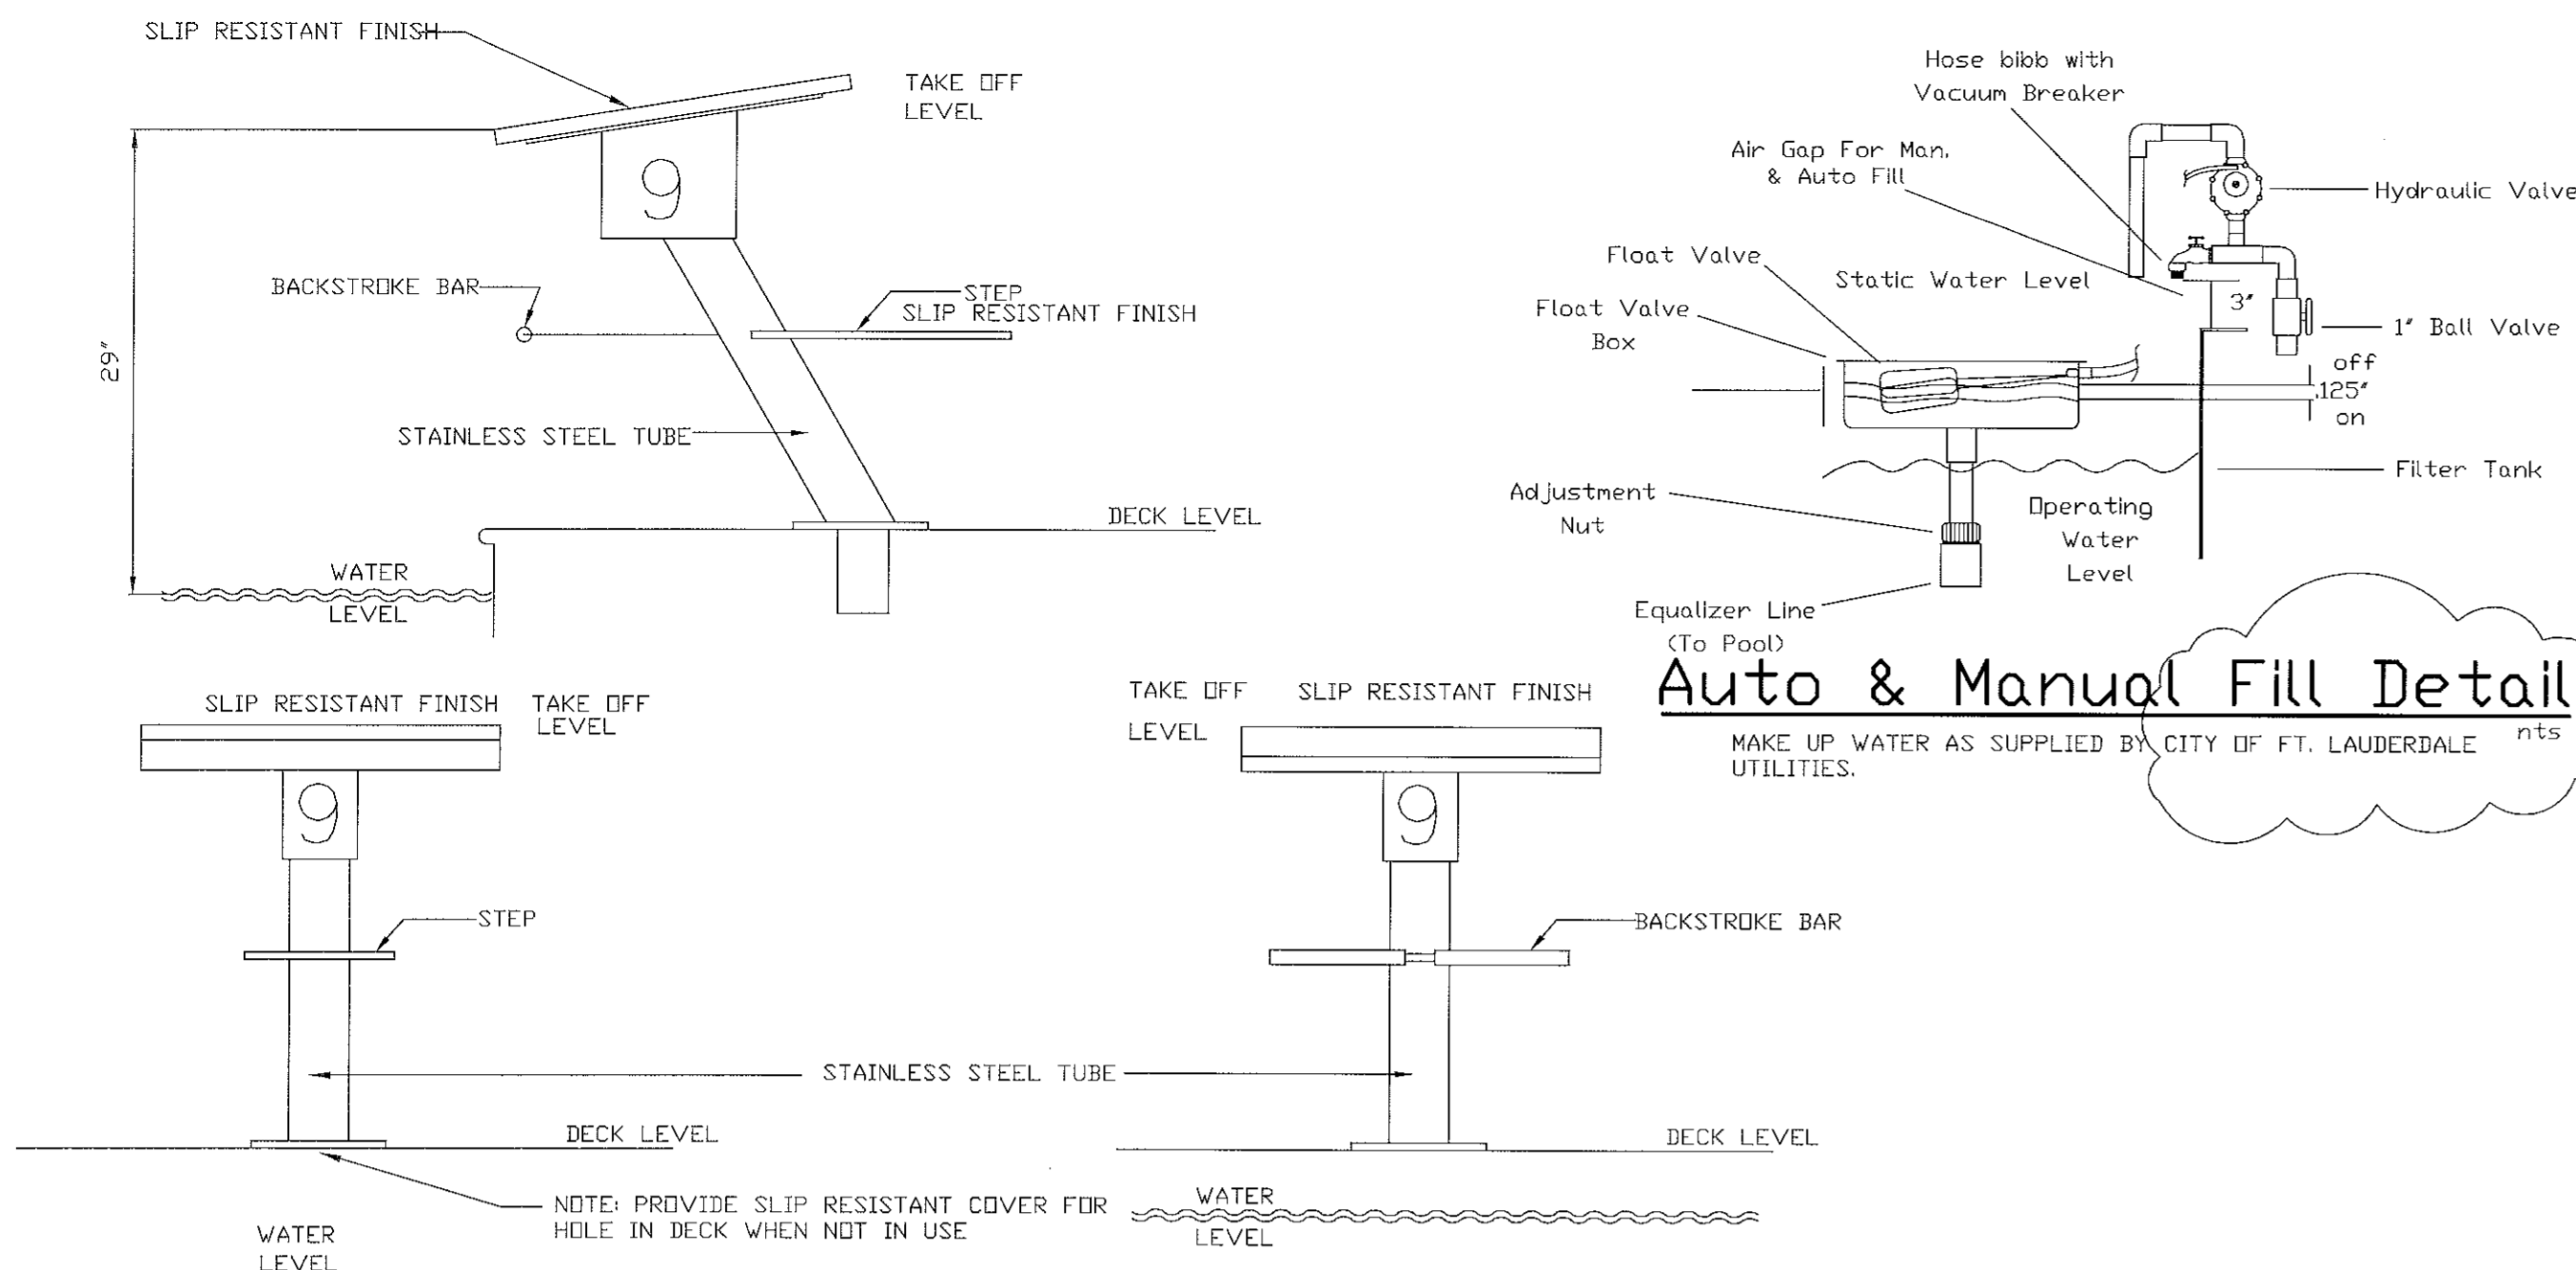

**TYPICAL STARTING PLATFORMS**


PLATFORMS SHALL BE AS MANUFACTURED BY KDI PARAGON MODEL # 23214 (OR APPROVED EQUAL).

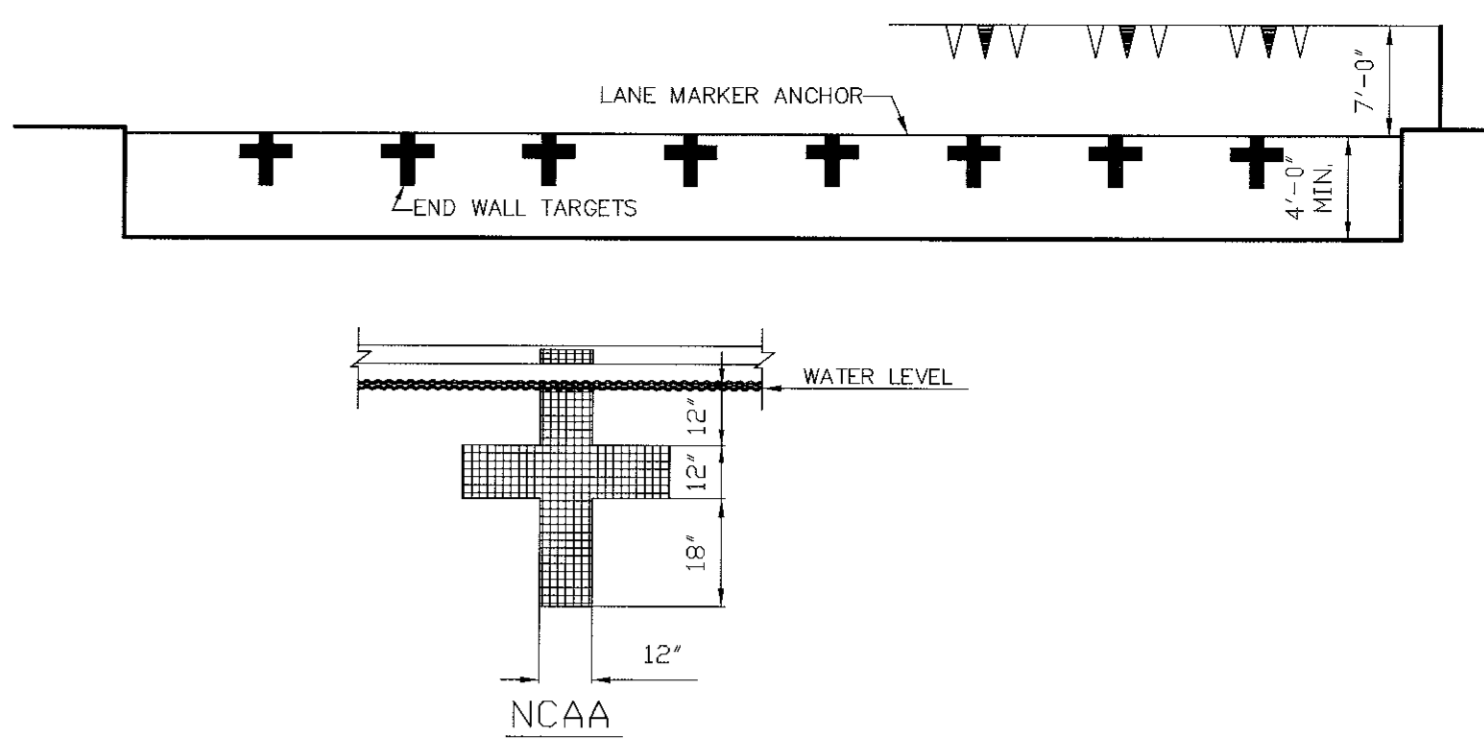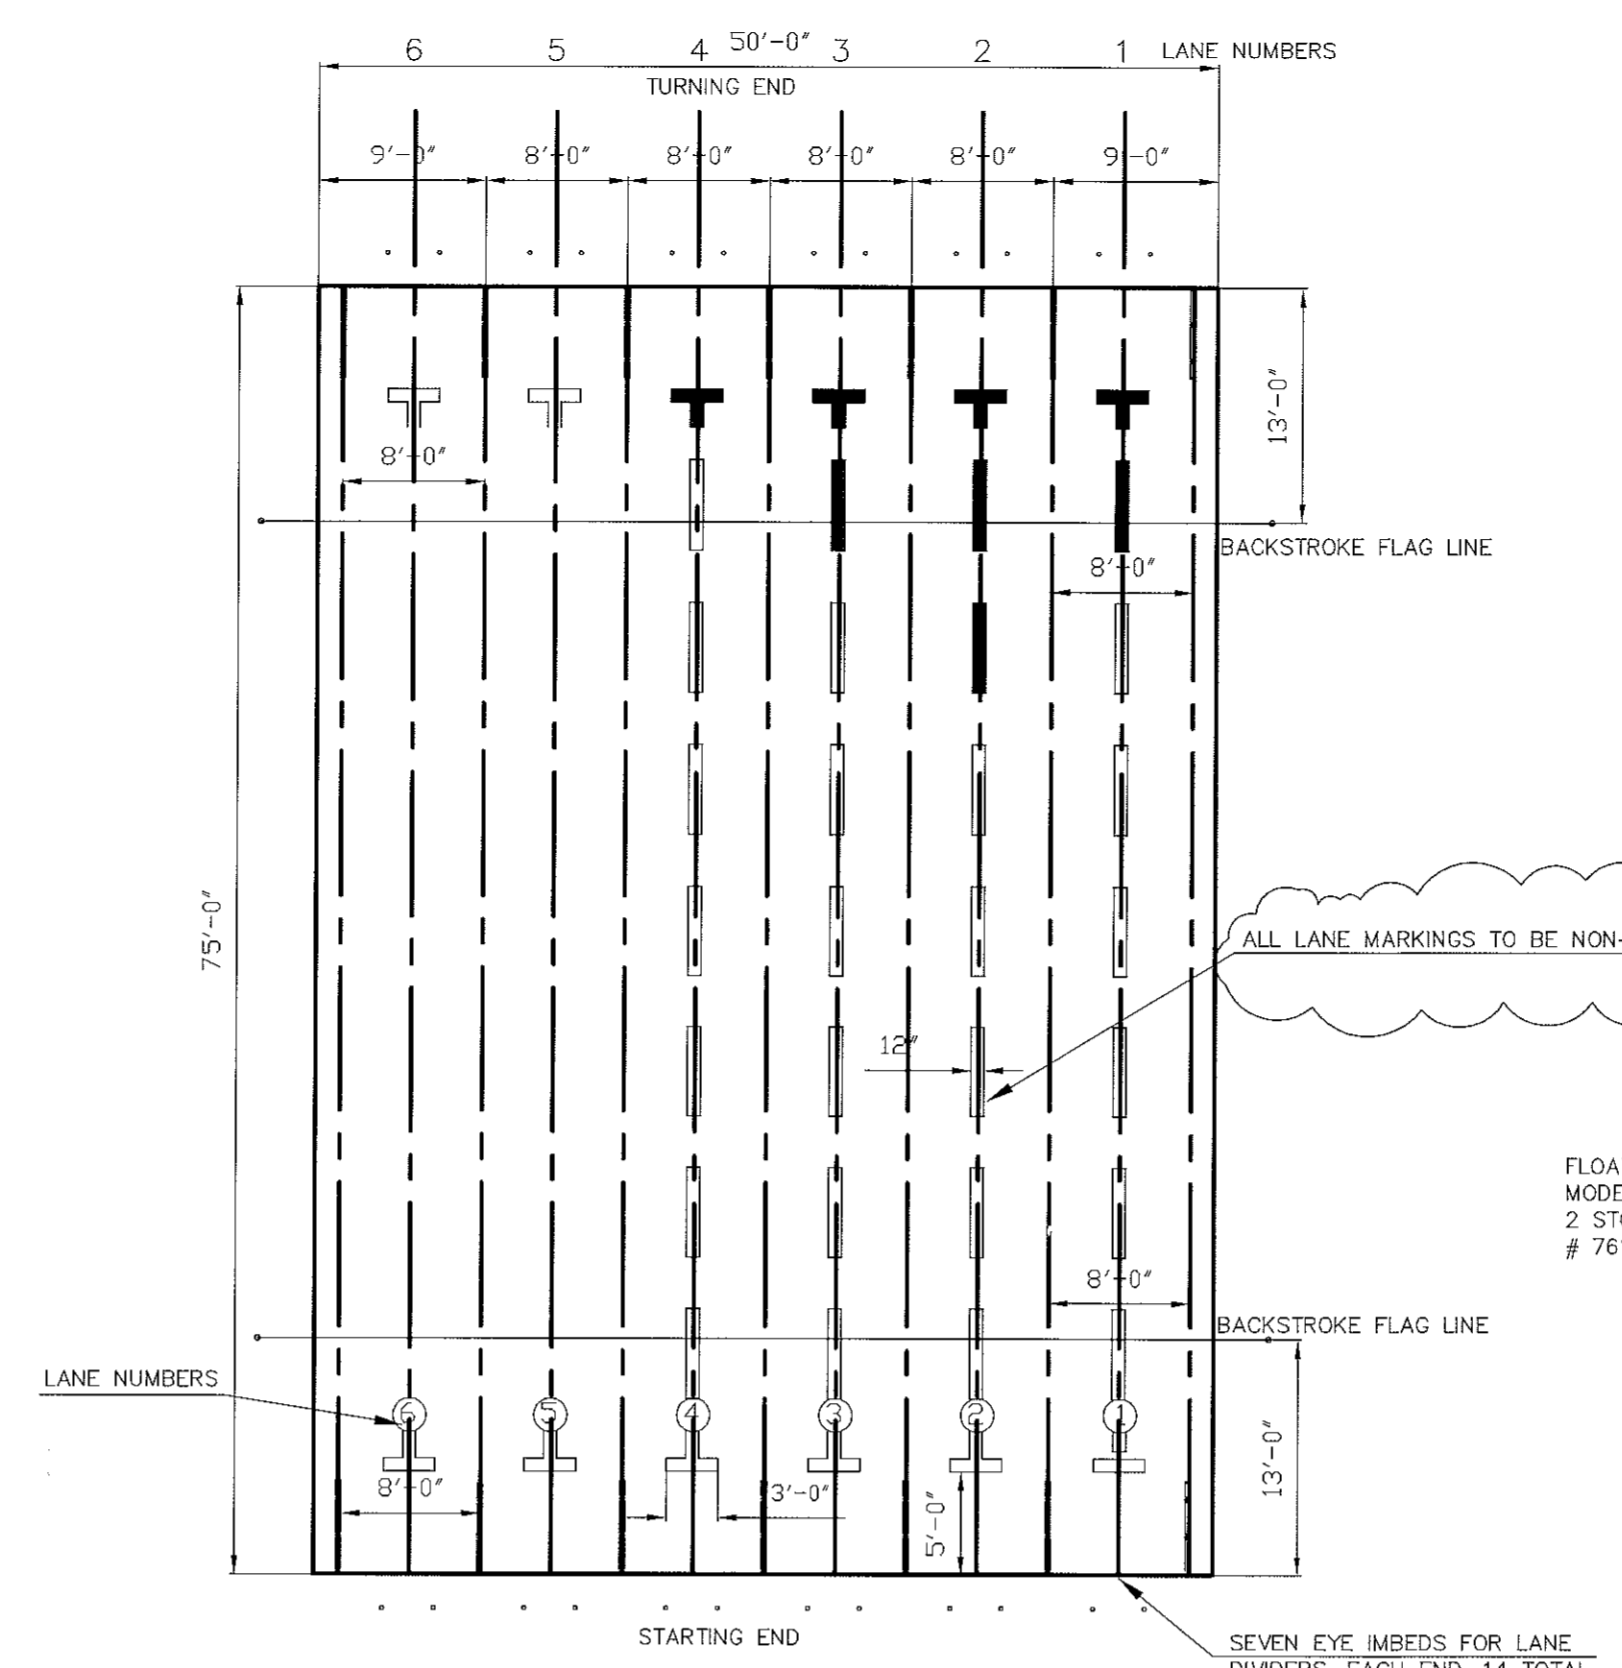

ALL TARGETS TO BE NON-SLIP TILE.

ALL LANE MARKINGS TO BE NON-SLIP TILE.

FLOATING LANE MARKERS PER KDI PARAGON MODEL # 76107-1, COLOR BY OWNER, 2 STORAGE REELS, KDI PARAGON MODEL # 76107-1.


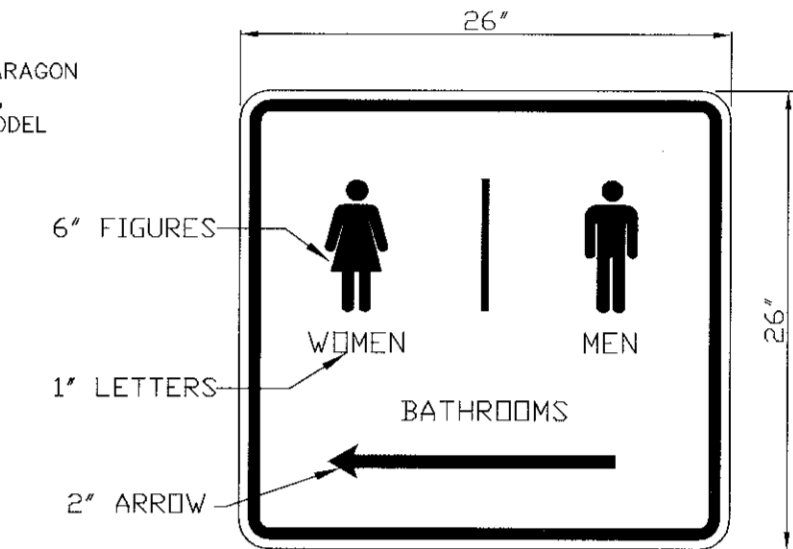


**POOL RULES**




1. NO ANIMALS ALLOWED IN POOL OR ON DECK.
2. NO FOOD, DRINK OR GLASS ALLOWED IN POOL OR ON POOL DECK.
3. SHOWER BEFORE ENTERING POOL.
4. BATHING LOAD IS 85 PERSONS.
5. POOL IS OPEN FROM DAWN TO DUSK.
6. MAXIMUM POOL WATER TEMPERATURE SHALL NOT EXCEED 104 DEGREES (F).
7. NO DIVING

- GENERAL SPECIFICATIONS**
1. POST SIGN WITHIN CONFINES OF POOL AREA.
  2. SIGN LETTERING SHALL CONTRAST WITH BACKGROUND COLOR.
  3. SIGN LETTERS SHALL BE AT LEAST 1" HIGH.
  4. LETTERS SPECIFYING NO DIVING SHALL BE AT LEAST 4" HIGH.

**POOL RULES SIGN DETAIL**

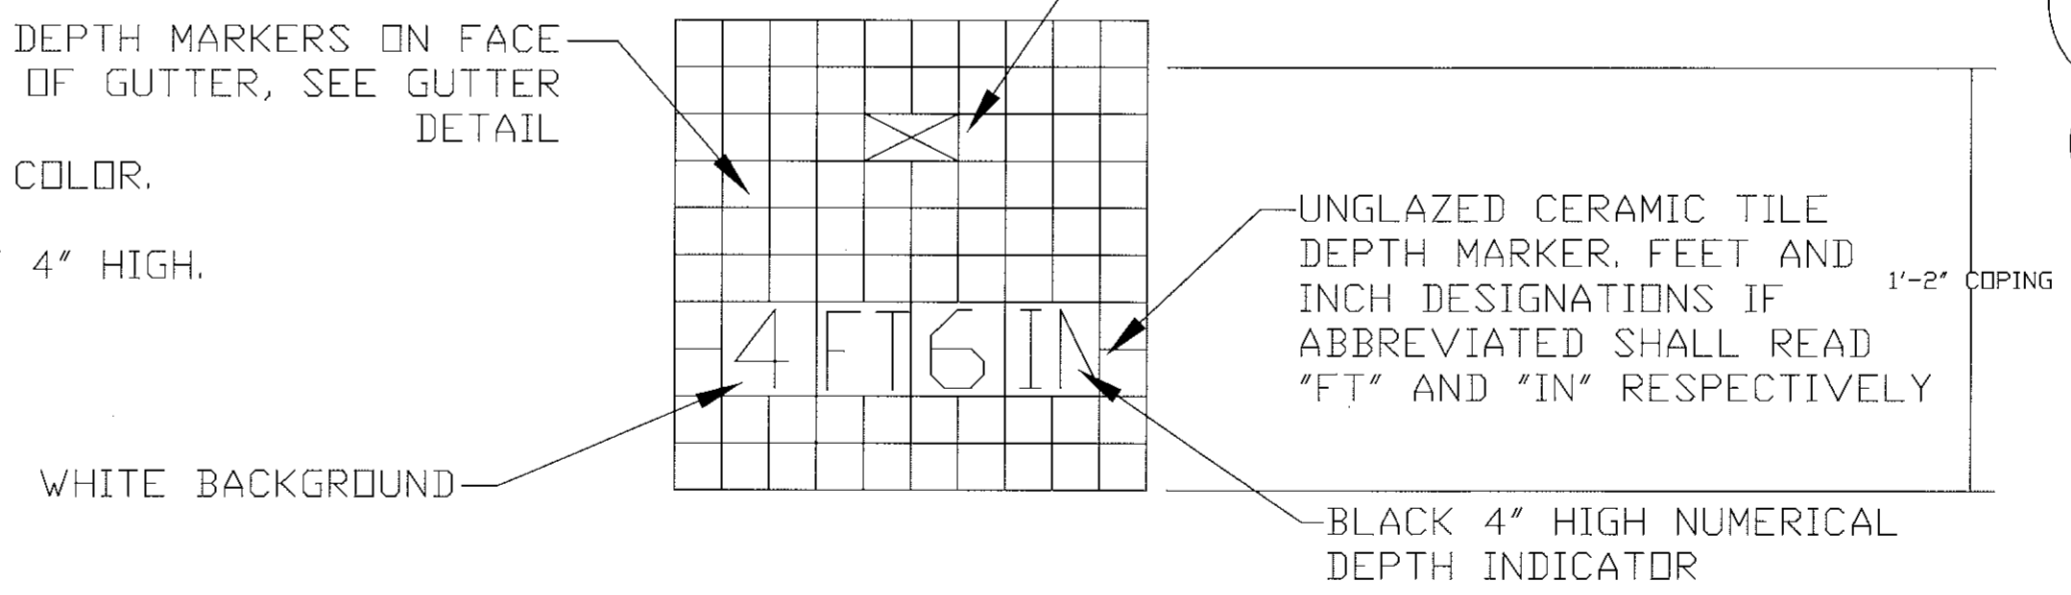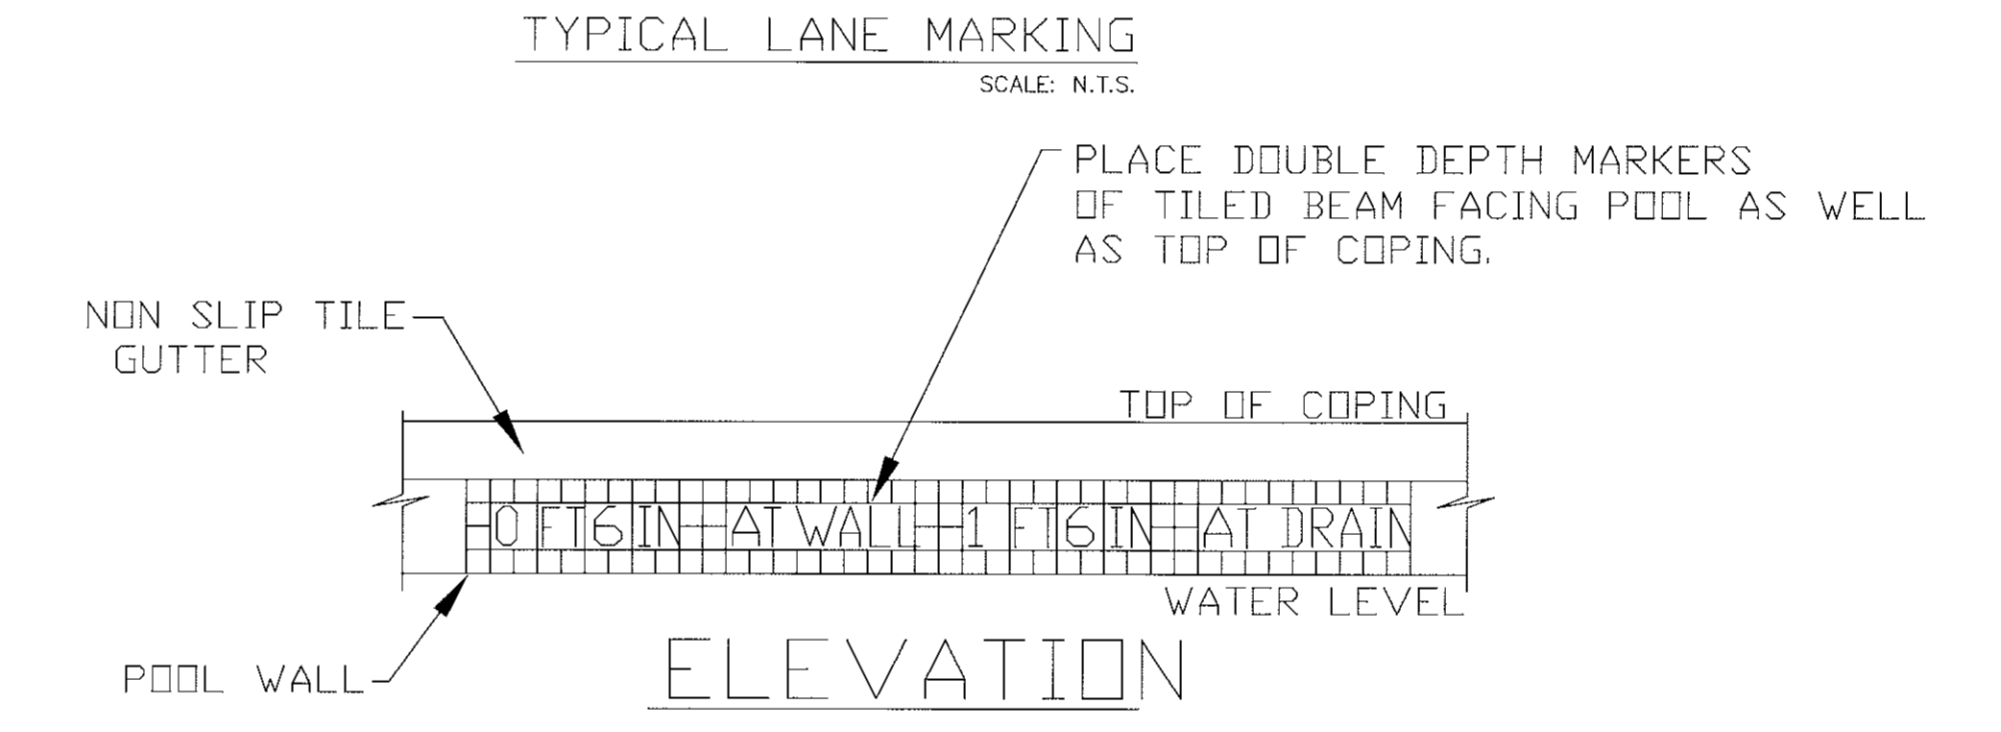

NOTE: MAXIMUM SPACING BETWEEN ADJACENT DEPTH MARKERS SHALL NOT EXCEED 25'-0" ALL MARKERS SHALL BE ABOVE WATER LEVEL.

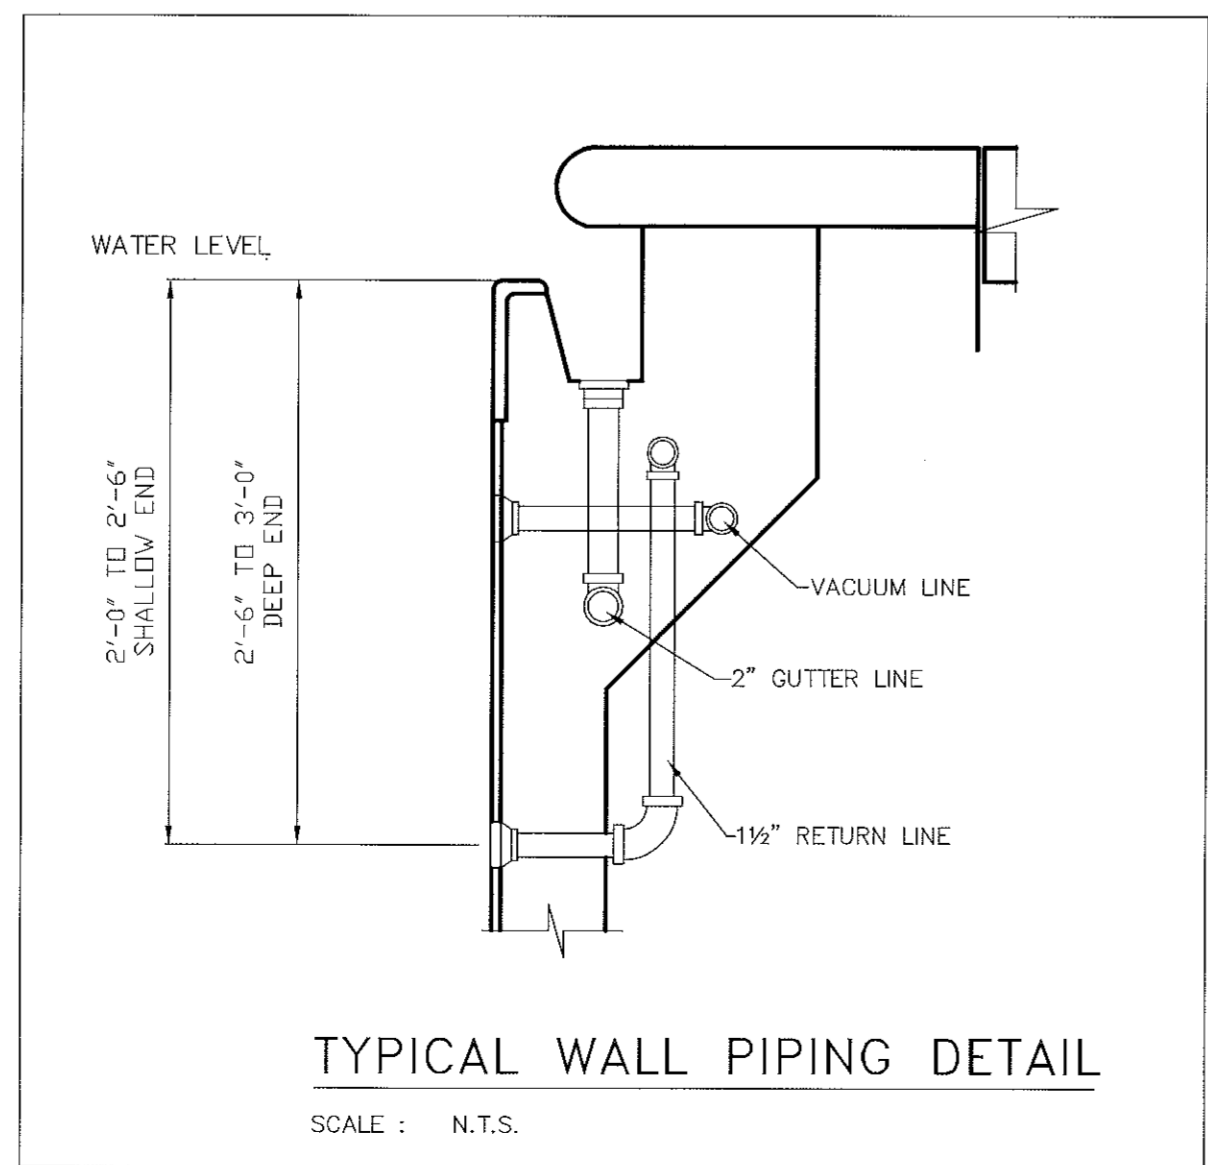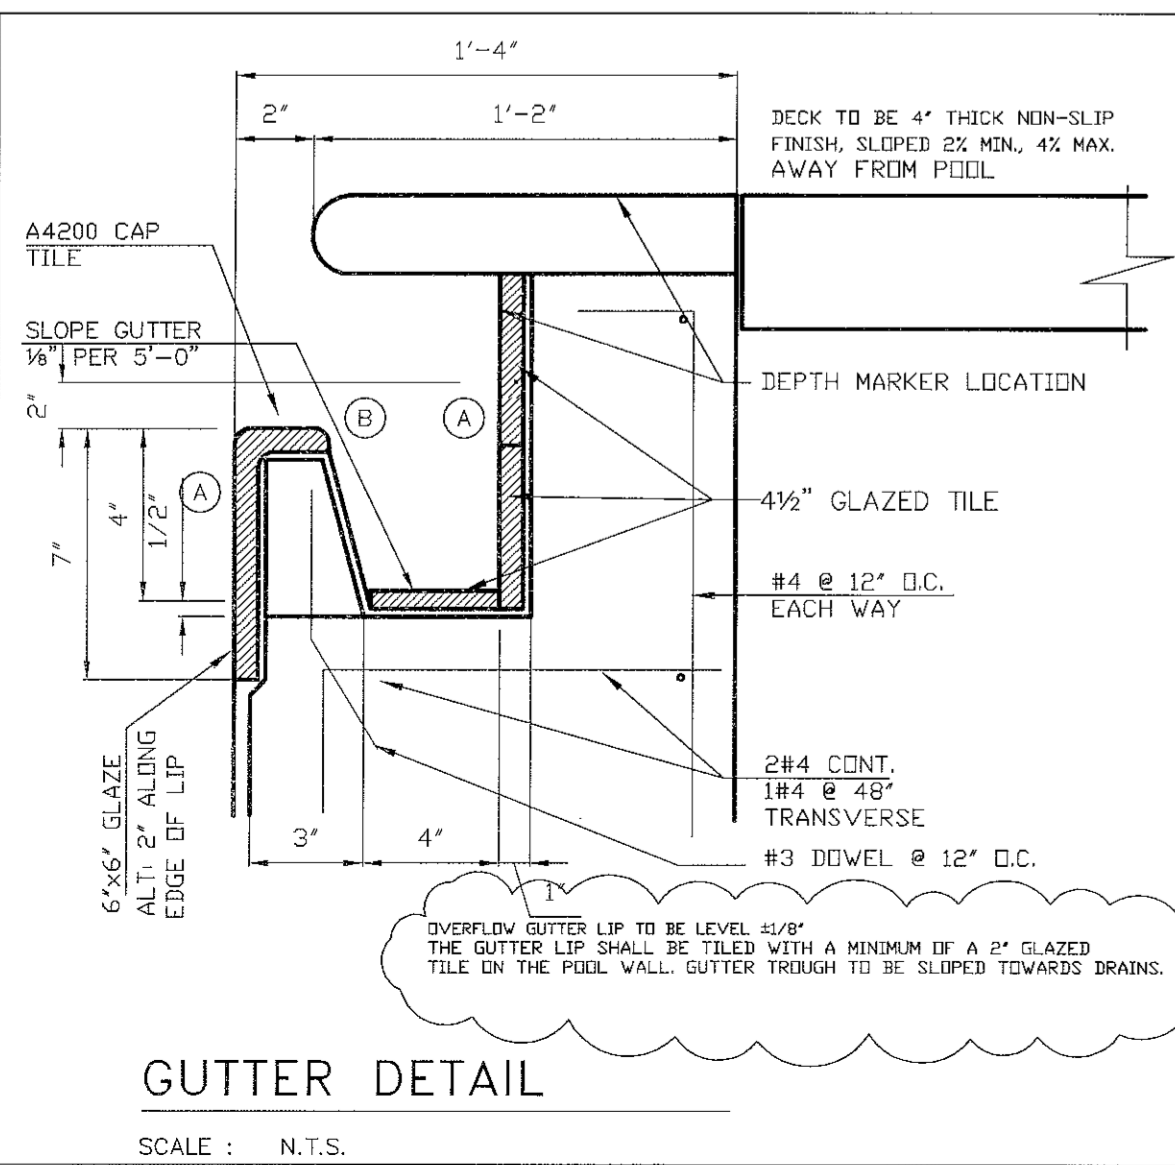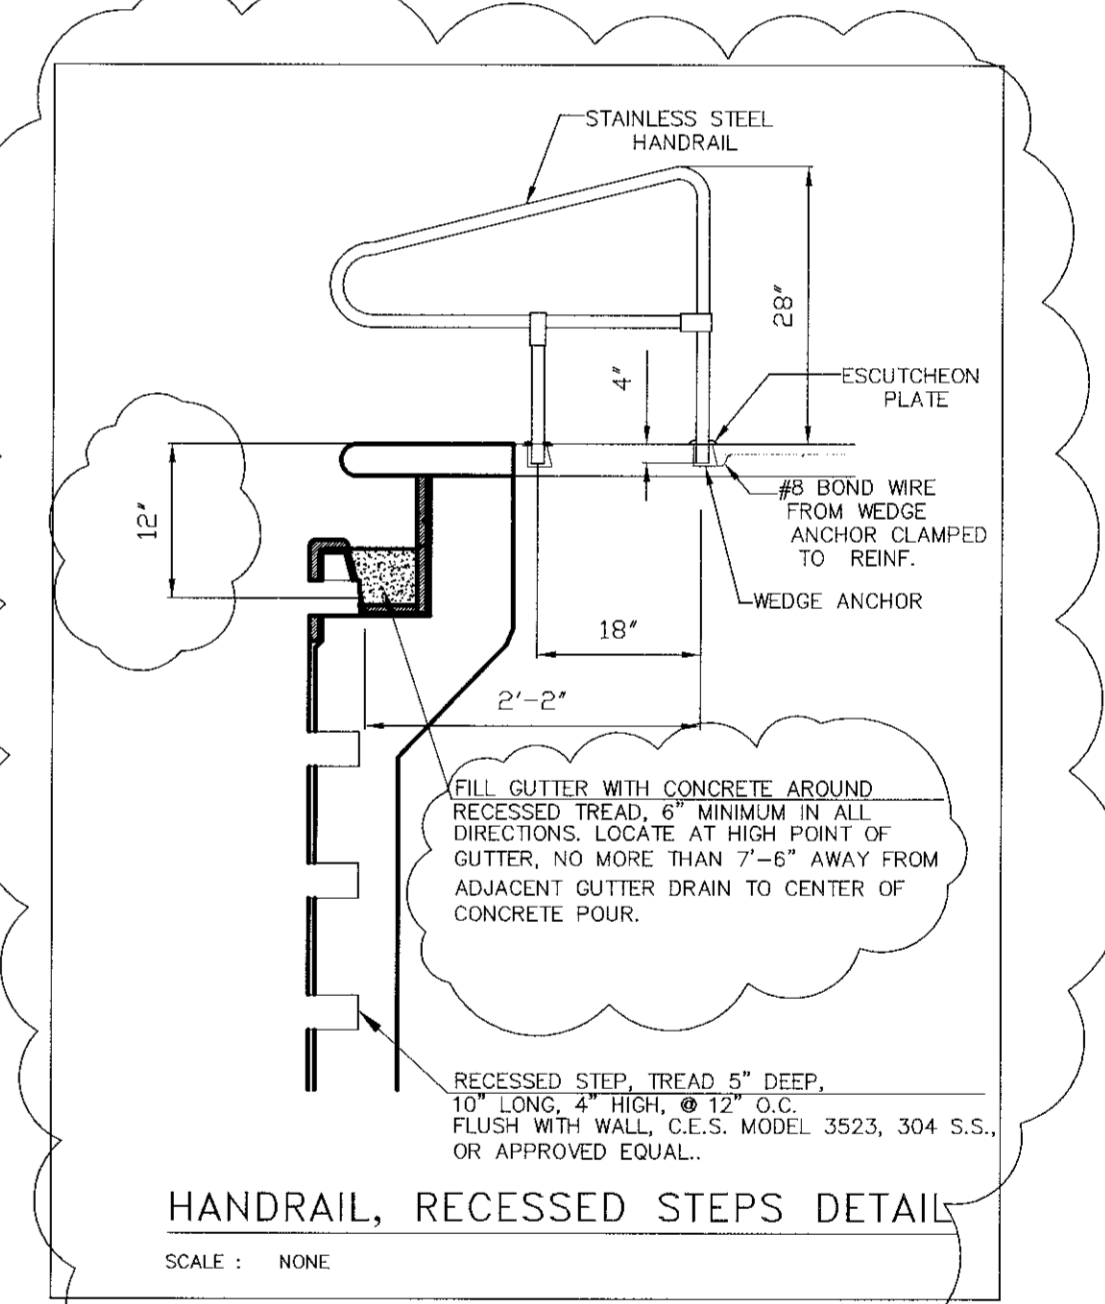

**SEAWOOD BUILDERS INC.**  
 565 EAST HILLSBORO BOULEVARD  
 DEERFIELD BEACH, FL 33441

**SCHARF & ASSOCIATES INC.**  
 ARCHITECTS-PLANNERS  
 3107 N.W. 9th Avenue  
 Suite 200  
 Ft. Lauderdale, Florida 33309  
 954-566-2700  
 AA-000427  
 PROJECT NO. 2210

**LAWRENCE DeROSE, P.E.**  
 LICENSED ENGINEER NO. 20169  
 STATE OF FLORIDA  
 BY: \_\_\_\_\_  
 DATE: \_\_\_\_\_

**DeRose & Slopey**  
 CONSULTING ENGINEERS, INC.  
 LAND PLANNING • CIVIL • STRUCTURAL  
 ENVIRONMENTAL & ELECTRICAL • MECHANICAL  
 470 B. ANDREWS AVENUE  
 FORT LAUDERDALE, FLORIDA 33309  
 954-545-9763

**CITY OF FORT LAUDERDALE**  
 PUBLIC SERVICES DEPARTMENT  
 ARCHITECTURAL DIVISION  
 Architecture • Landscape Architecture • Project Management  
 100 North Andrews Avenue, 5th Floor, Fort Lauderdale, Florida 33301

|             |                  |                       |              |         |
|-------------|------------------|-----------------------|--------------|---------|
| DATE:       | 09/20/03         | REVISIONS:            | D/B CONTRACT | 8/10/03 |
| DRAWN BY:   | JRL / LJM/C      | D/B COMMENTS          | 9/15/03      |         |
| CHECKED BY: | TKM/C            | D/B 100% C.D.         | 10/24/03     |         |
| CAD FILE:   | 18248-CB-201POOL | D/B 100% C.D. PERMITS | 12/03/03     |         |
|             |                  | D/B 100% C.D. PERMITS | 1/06/04      |         |
|             |                  | PER CONTRACTOR        | 9/16/04      |         |


**PROJECT #P15245**  
**RIVERLAND PARK COMMUNITY CENTER**  
**FORT LAUDERDALE, FLORIDA**  
**POOL DETAILS**  
 950 SW 27 AVENUE, FORT LAUDERDALE, BROWARD COUNTY, FL 33312

SHEET NO.  
**C-18**  
 OF 21  
 DRAWING FILE #23-086  
 4-126-25 Exhibit  
 Page 32 of 5


"AS BUILT SET" 11/10/05  
 POOL PEOPLE COMMERCIAL INC.






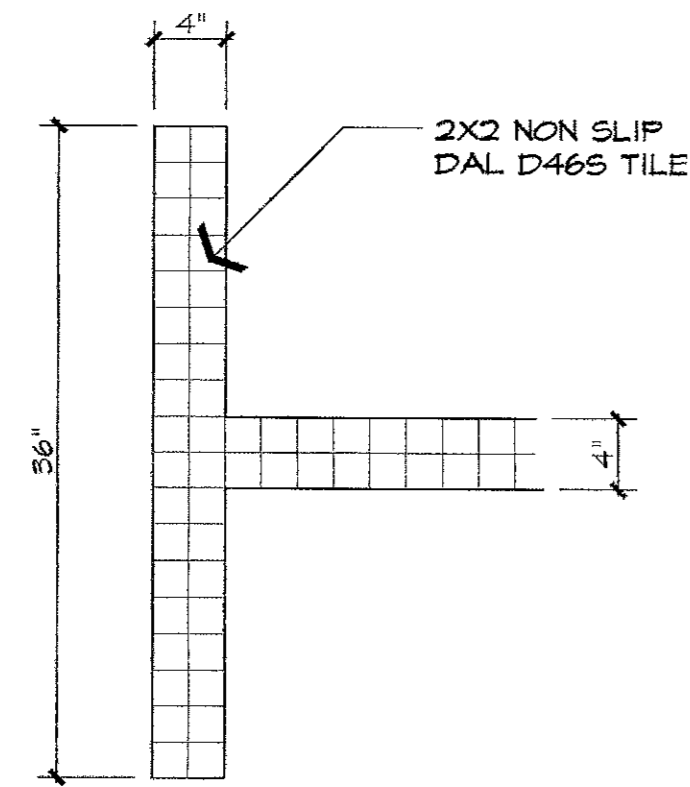

1 SP-3 LANE TERMINATOR DETAIL NTS

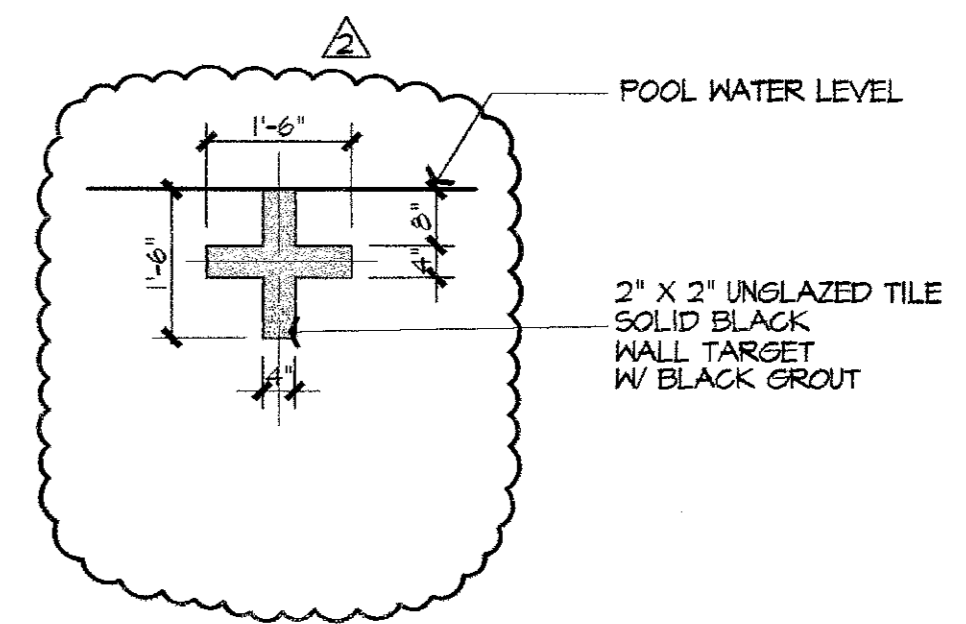

2 SP-3 WALL TARGET DETAIL SCALE 1/2" = 1'-0"

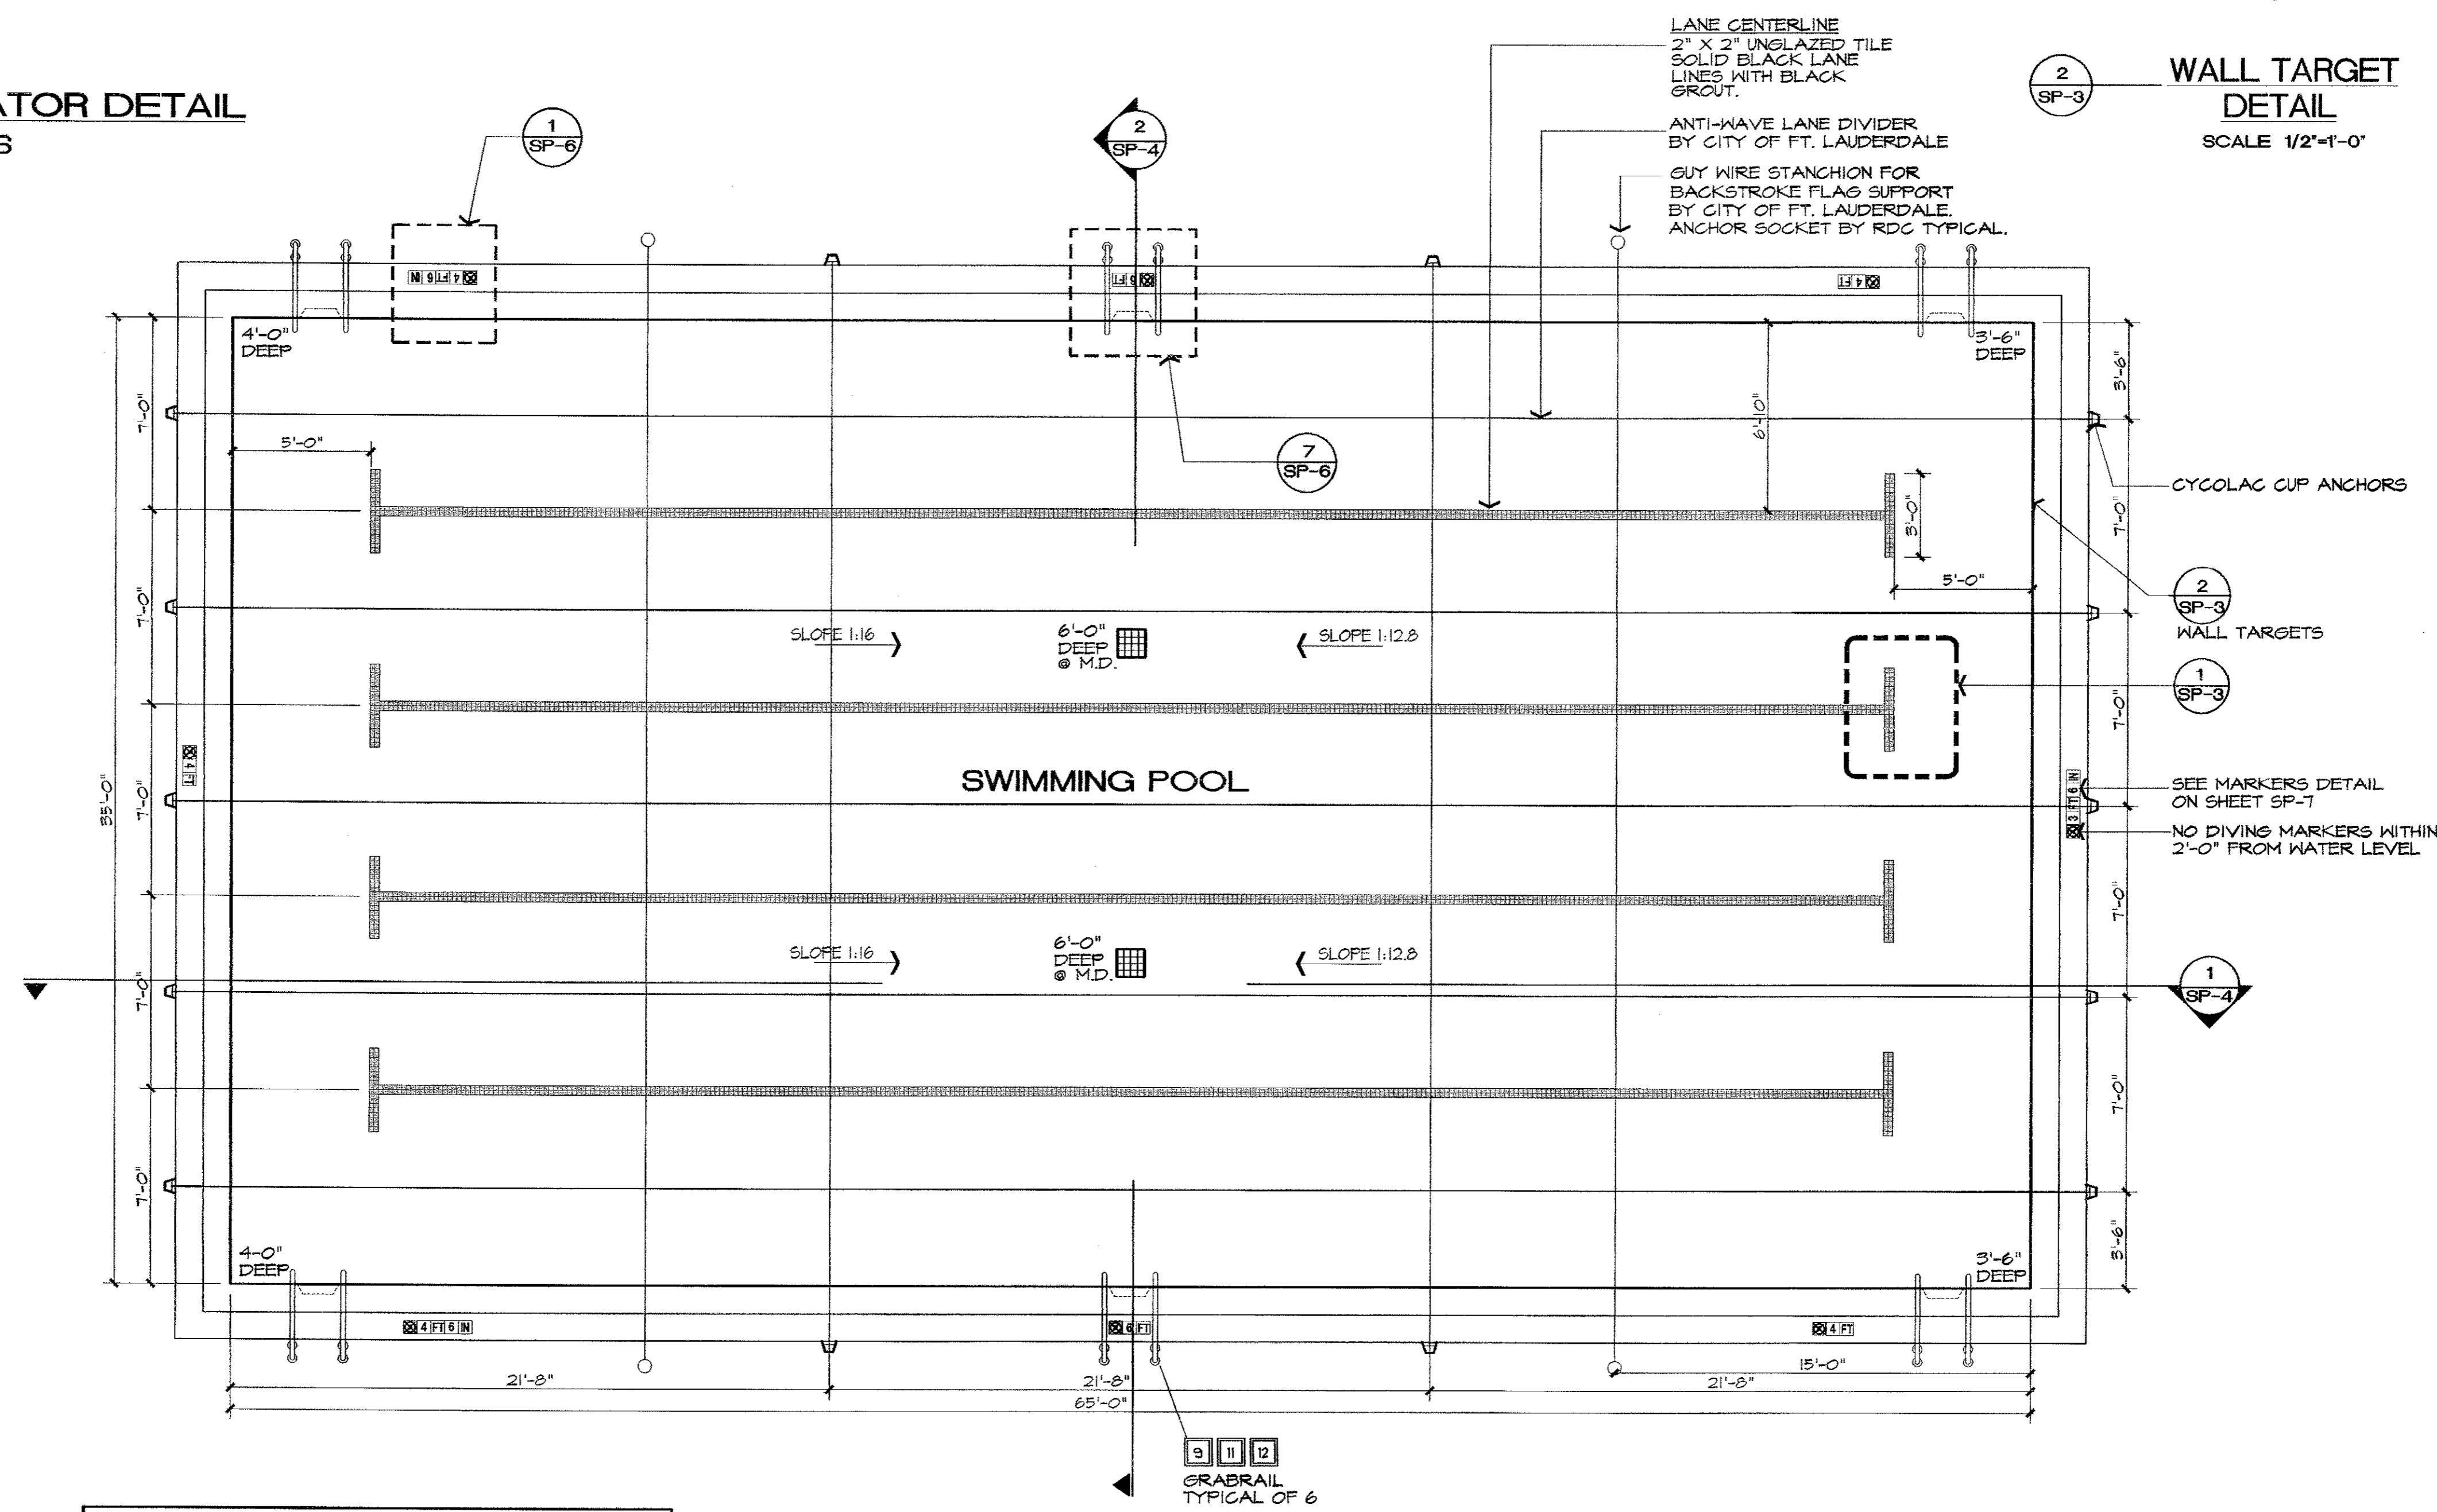

| POOL DATA CHART |                      |
|-----------------|----------------------|
| POOL AREA       | = 2,275 S.F.         |
| POOL PERIMETER  | = 200 L.F.           |
| POOL VOLUME     | = 77,400 GALS.       |
| FILTER RATE     | = 215 GPM IN 6 HOURS |
| BATHING LOAD    | = 43 PERSONS         |

SWIMMING POOL LAYOUT PLAN SCALE: 1/4" = 1'-0"

|                 |                          |
|-----------------|--------------------------|
| FINAL APPROVAL  |                          |
| SCALE: AS SHOWN | FLA. REG. ENG. NO. 15544 |
| DRAWN BY: OT    | DESIGNED BY: OT          |
|                 | DATE: 1-31-01            |
|                 | CHECKED BY: B. SAUVE     |
|                 | FIELD BOOK:              |

CITY OF FORT LAUDERDALE  
 PUBLIC SERVICES DEPARTMENT  
 ENGINEERING DIVISION  
 FORT LAUDERDALE, FLORIDA

| REVISIONS |          | DESCRIPTION         |
|-----------|----------|---------------------|
| NO.       | DATE     | CHK'D               |
| 1         | 12.11.00 | DRC FINAL REVIEW    |
| 2         | 01.05.01 | PER DOH REVIEW      |
| 3         | 01.31.01 | BUILDING DEPARTMENT |

PROJECT #84184  
 POOL AND COMMUNITY  
 CENTER/LAUDERDALE MANORS  
 FT LAUDERDALE, FLORIDA


|                |      |
|----------------|------|
| NO. OF SHEETS: | 19   |
| SHEET NO.:     | 3    |
| CAD FILE NO.:  |      |
| FILE NO.:      | SP-3 |

**AQUADYNAMICS  
 DESIGN GROUP, INC.**  
 AQUATIC ENGINEERING CONSULTANTS  
 6913 S.W. 72ND AVENUE  
 MIAMI, FLORIDA 33155  
 (305) 887-8875 TELEFAX (305) 888-1008

THE UPPER PART OF POOL WALLS IN AREAS FIVE FEET DEEP OR LESS SHALL BE WITHIN FIVE DEGREES OF VERTICAL FOR A MINIMUM DEPTH OF TWO AND ONE-HALF FEET FROM WHICH POINT THE WALL MAY JOIN THE FLOOR WITH A MAXIMUM RADIUS EQUAL TO THE DIFFERENCE BETWEEN THE POOL DEPTH AND TWO AND ONE-HALF FEET. THE UPPER PART OF POOL WALLS IN AREAS OVER FIVE FEET DEEP SHALL BE WITHIN FIVE DEGREES OF VERTICAL FOR A MINIMUM DEPTH EQUAL TO THE POOL WATER DEPTH MINUS TWO AND ONE-HALF FEET FROM WHICH POINT THE WALL MAY JOIN THE FLOOR WITH A MAXIMUM RADIUS OF TWO AND ONE-HALF FEET.

FOR MORE DETAIL SEE GUTTER BEAM DETAIL ON SP-6


6" SHOTCRETE WALL REINFORCED WITH #3 @ 8" EACH WAY, CENTER STEEL IN WALL U.O.N.

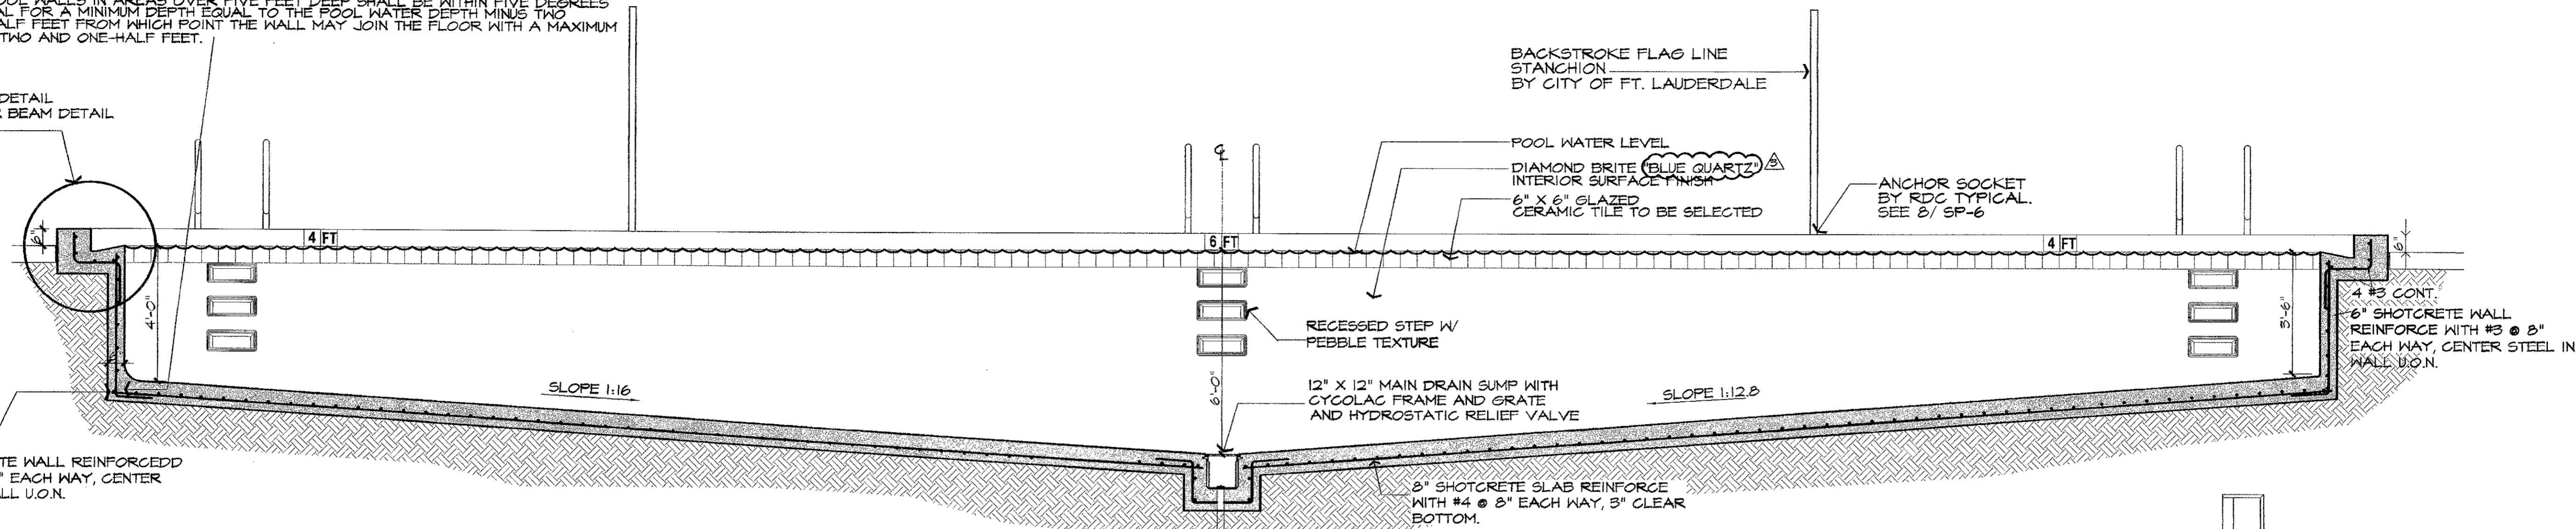

**SWIMMING POOL SECTION**  
SCALE: 3/8" = 1'-0"

- GENERAL REQUIREMENTS:**
- 1) INTERIOR POOL FINISH SHALL BE DIAMOND BRITE "BLUE QUARTZ"
  - 2) INTERIOR POOL FINISH IS IMPERVIOUS AND NON-SLIP.
  - 3) THE MAXIMUM VELOCITY THROUGH THE MAIN DRAIN GRATE DOES NOT EXCEED 1.5 F.P.S.
  - 4) SECURE THE MAIN DRAIN GRATE WITH TAMPERPROOF SCREWS. (THE MAIN DRAIN GRATE IS NOT READILY REMOVABLE.)
  - 5) THE ACTUAL DEPTH AT OPERATING WATER LEVEL SHALL NOT DEVIATE MORE THAN 3 INCHES FROM THE DEPTH SPECIFIED BY THE MARKER WHEN MEASURED 3 FEET FROM THE POOL WALL.
  - 6) THE DEPTH AT THE SHALLOW END SHALL NOT BE LESS THAN 3'-6"

NOTE: CUSTOMIZED DIMENSIONS MUST BE PROVIDED TO SPECTRUM BEFORE FABRICATION OF LIFT

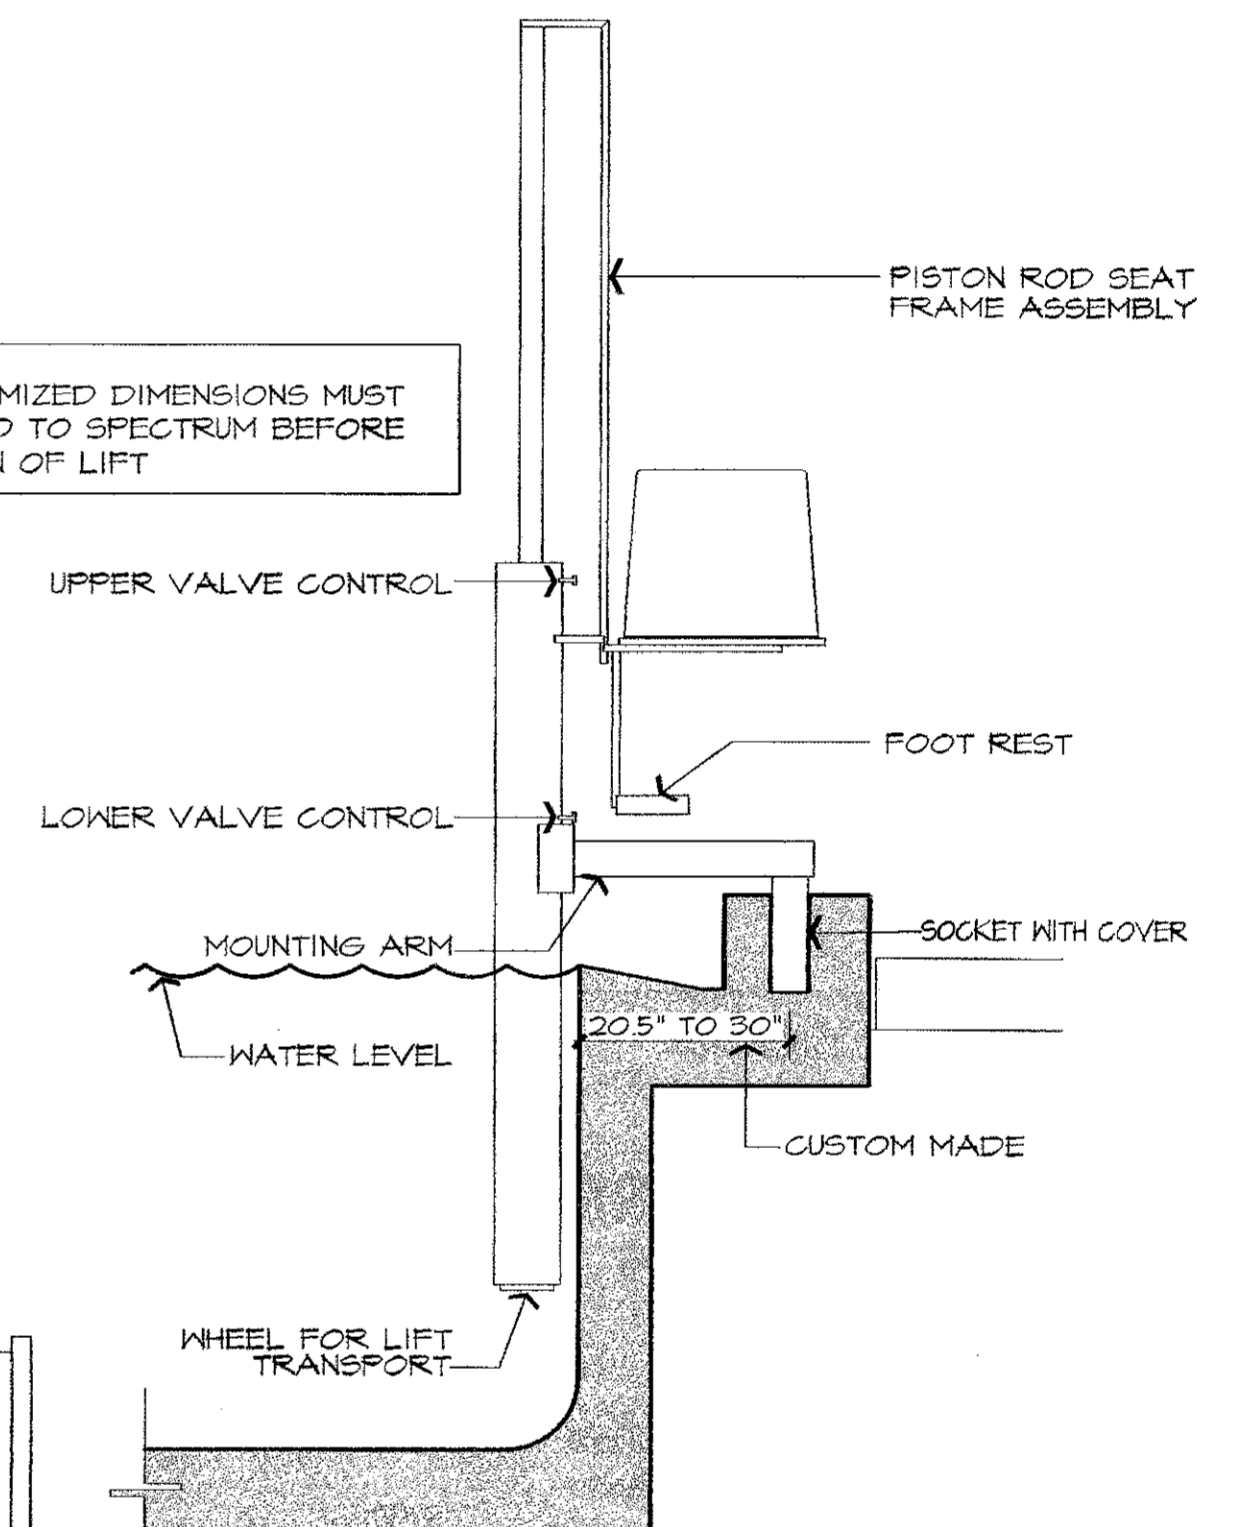


**SPECTRUM SL-325 POOL PRODUCTS, INC.**  
SCALE: 3/4" = 1'-0"

POST SIGN AT POOL AS FOLLOWS:  
FOR ASSISTANCE WITH PORTABLE CHAIR LIFT  
PLEASE SEE THE LIFEGUARD STAFF

POOL DECK IMPERVIOUS SLIP RESISTANT DECK FINISH REQUIRED. SLOPE 2% TO 4%

RECESSED CYCLOAC STEP TREADS WITH A NON-SLIP HORIZONTAL SURFACE FINISH. FOR MORE INFORMATION SEE DETAIL #4 ON SP-6


6" SHOTCRETE WALL REINFORCED WITH #3 @ 8" EACH WAY, CENTER STEEL IN WALL U.O.N.

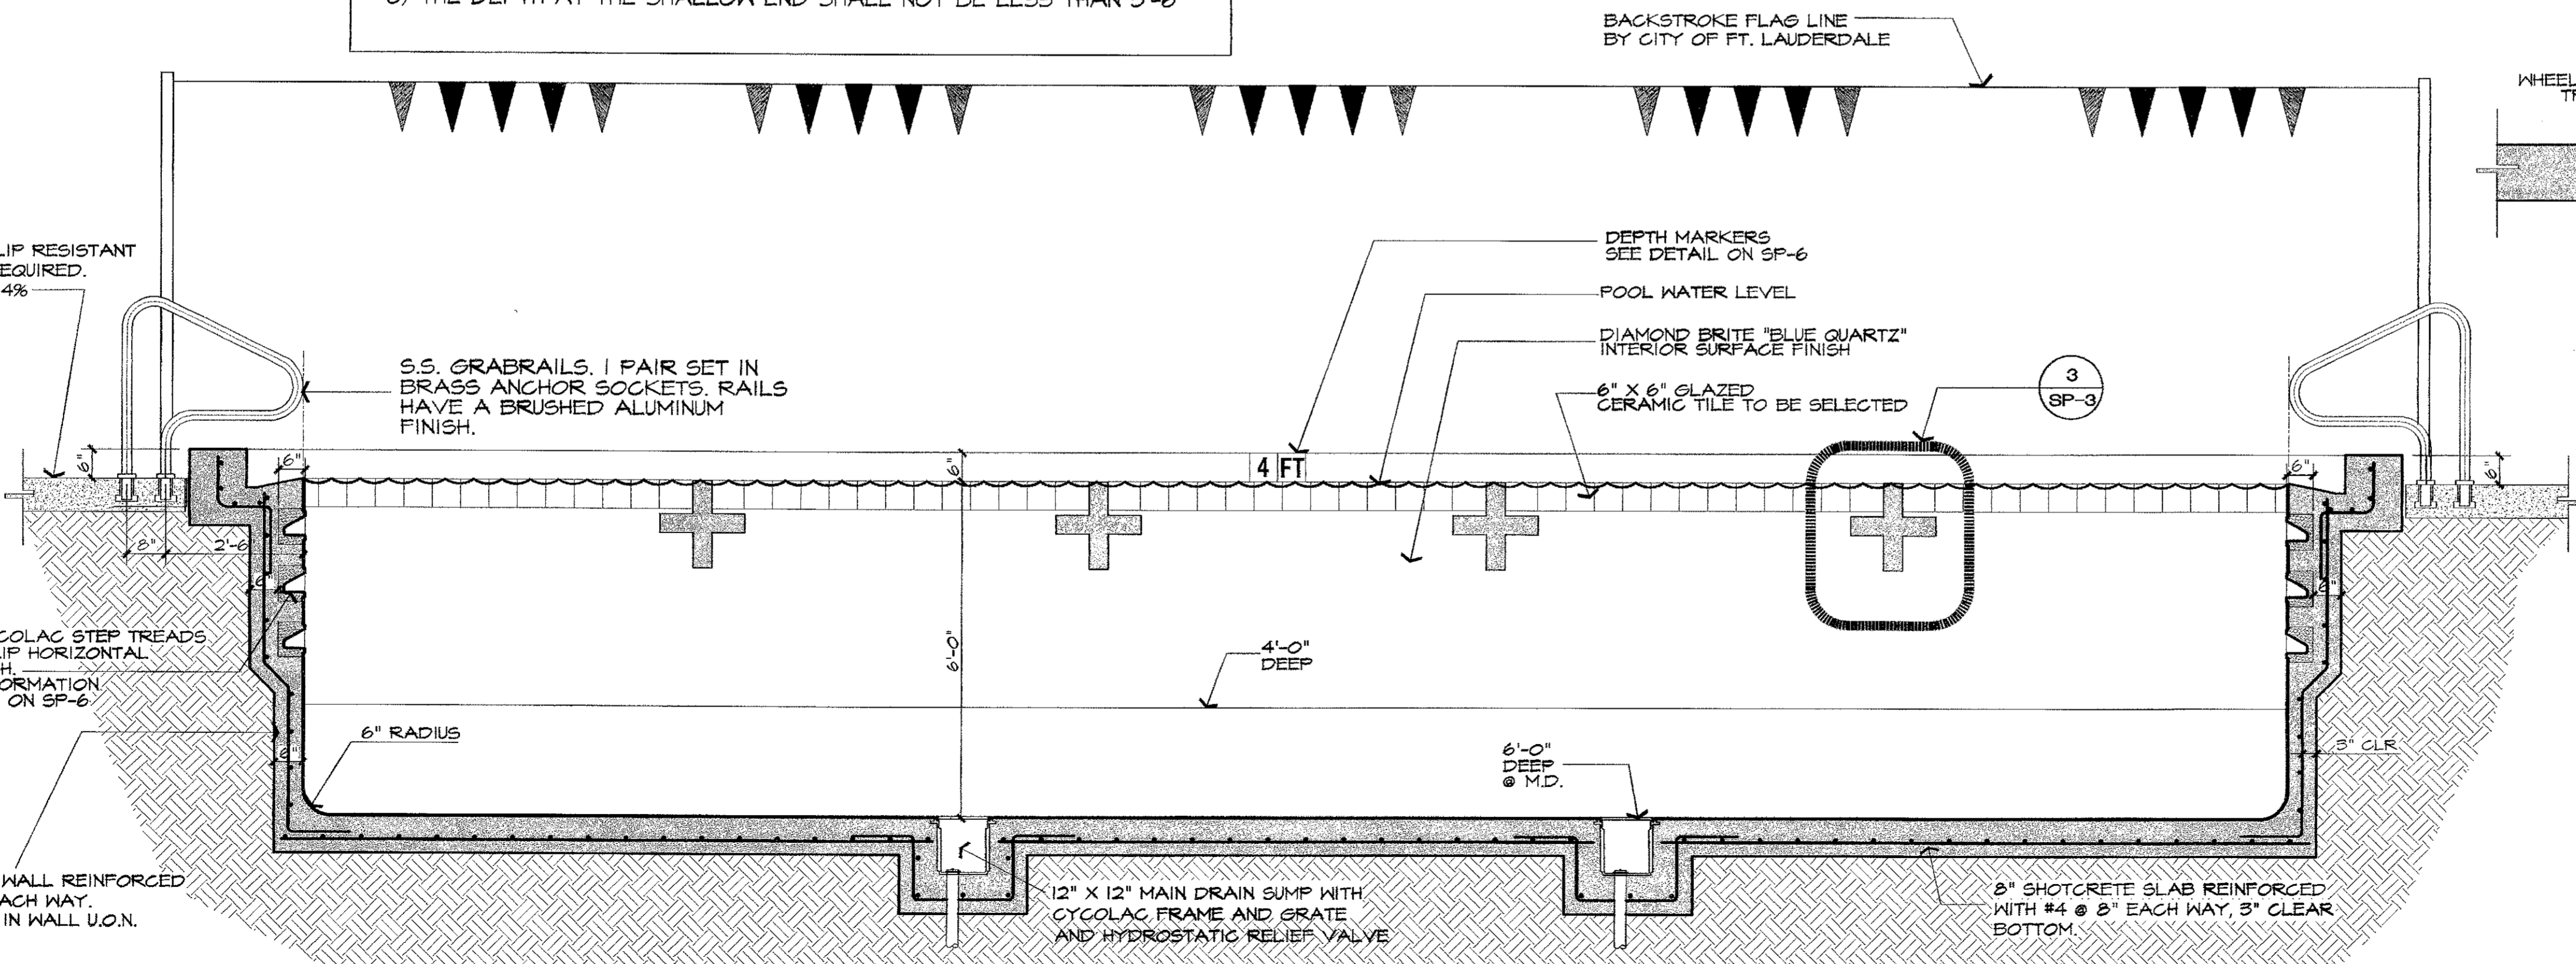

**SWIMMING POOL SECTION #2**  
SCALE: 1/2" = 1'-0"

**AQUADYNAMICS DESIGN GROUP, INC.**  
AQUATIC ENGINEERING CONSULTANTS  
4810 S.W. 7680 AVENUE  
MIAMI, FLORIDA 33155  
ORDER 887-8878 TEL 887-8878 FAX 887-1008

|   |                 |                          |                  |
|---|-----------------|--------------------------|------------------|
| FINAL APPROVAL  |                 | FLA. REG. ENG. NO. 15544 |                  |
| SCALE: AS SHOWN   | DATE: 1-31-01   | FIELD BOOK:              |                  |
| DRAWN BY: OT  | DESIGNED BY: OT | CHECKED BY: B. SAUVE     |                  |
| <b>CITY OF FORT LAUDERDALE</b><br><b>PUBLIC SERVICES DEPARTMENT</b><br><b>ENGINEERING DIVISION</b><br><b>FORT LAUDERDALE, FLORIDA</b> |                 |                          |                  |
| REVISIONS   |                 | BUILDING DEPARTMENT:     |                  |
| NO.   | DATE            | CHK'D                    | DESCRIPTION      |
| 1   | 12.11.00        |                          | DRC FINAL REVIEW |
| 2   | 01.05.01        |                          | PER DOH REVIEW   |
| 3   | 01.31.01        |                          |                  |
| PROJECT #84184<br>POOL AND COMMUNITY CENTER/LAUDERDALE MANORS<br>FT LAUDERDALE, FLORIDA   |                 |                          |                  |
| NO. OF SHEETS: 19   |                 | SHEET NO.: 4             |                  |
| CAD FILE NO.  |                 | FILE NO. SP-4            |                  |

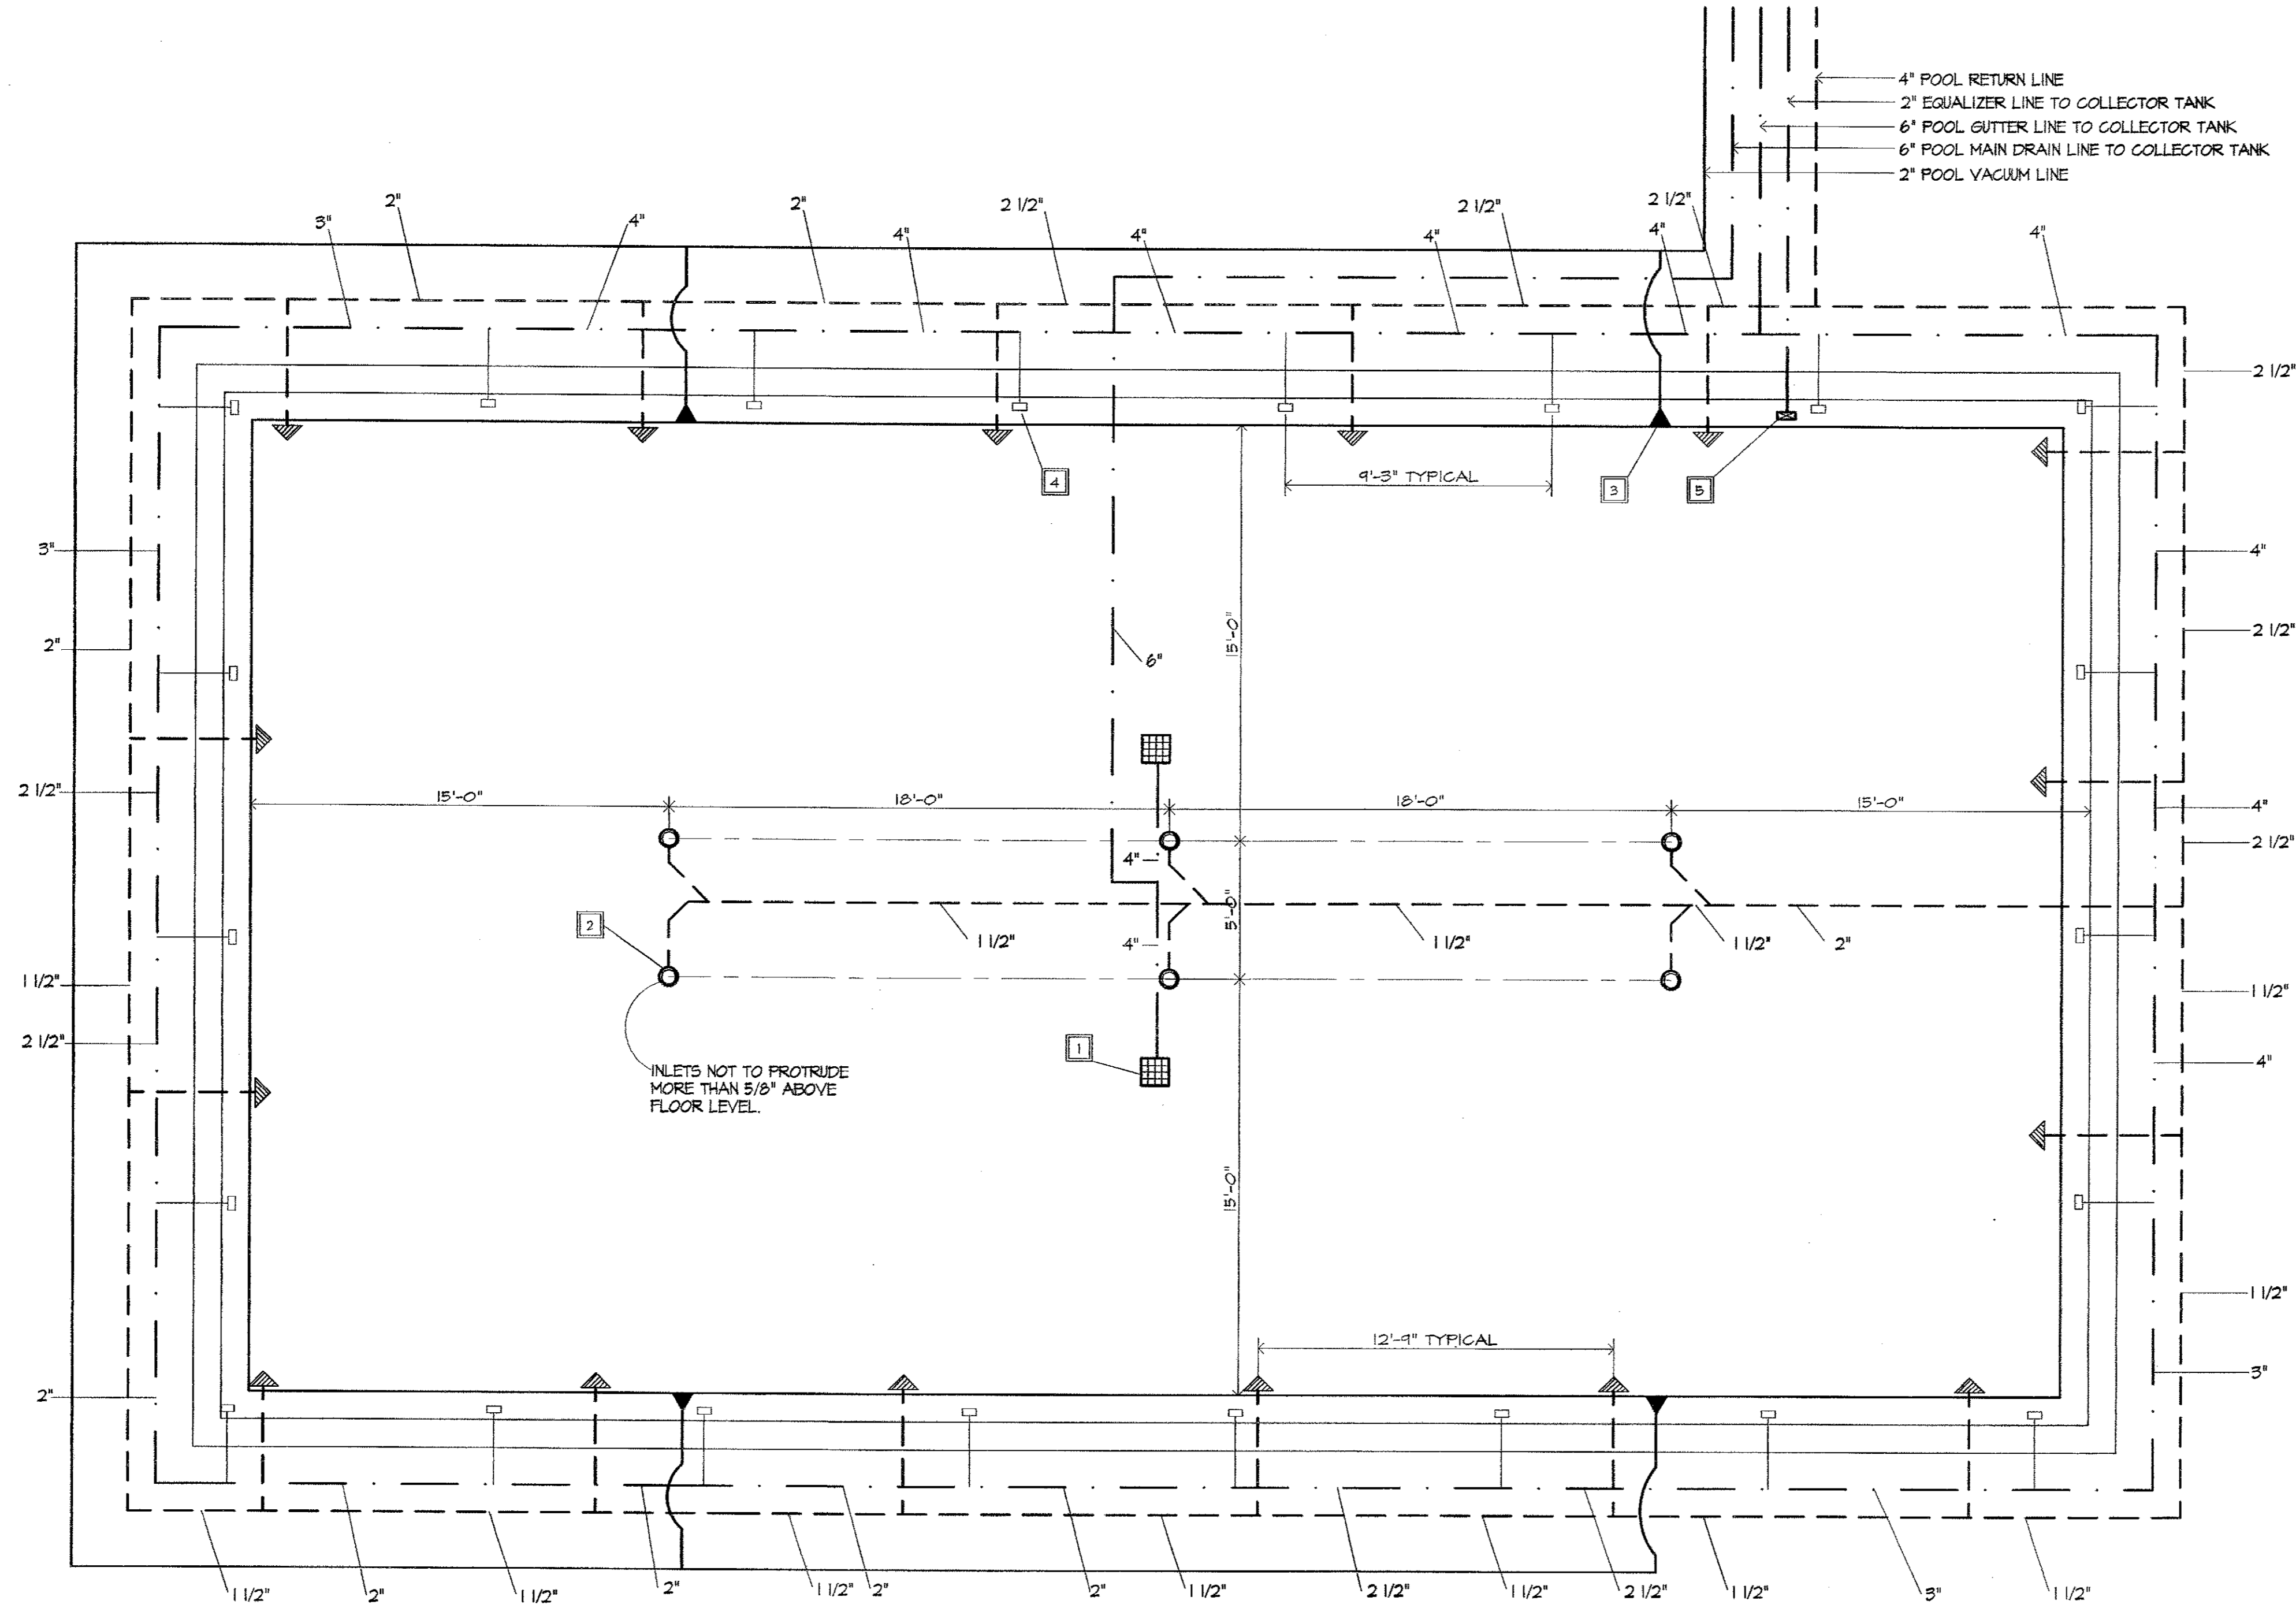

NOTE: THE PIPING SHOWN IS A GRAPHIC REPRESENTATION OF PIPE ROUTE. ACTUAL ROUTING OF PIPING AROUND POOL MAY DIFFER FROM THIS PLAN.

**SWIMMING POOL PIPING PLAN**  
SCALE 1/4"=1'-0"

**DESIGN VELOCITIES**  
GRAVITY LINES = 3 FPS  
SUCTION LINES = 6 FPS  
PRESSURE LINES = 8 FPS

**PLAN LEGEND**  
--- PVC SCHEDULE 40 NSF APPVD. PIPE (PRESSURE LINE)  
— PVC SCHEDULE 40 NSF APPVD. PIPE (SUCTION LINE)  
- - - PVC SCHEDULE 40 NSF APPVD. PIPE (GRAVITY FLOW LINE)

FINAL APPROVAL  
FLA. REG. ENG. NO. 15544

SCALE: AS SHOWN  
DRAWN BY: OT  
DESIGNED BY: OT  
CHECKED BY: B. SAUVE

CITY OF FORT LAUDERDALE  
PUBLIC SERVICES DEPARTMENT  
ENGINEERING DIVISION  
FORT LAUDERDALE, FLORIDA

| NO. | DATE     | BY | CHK'D | DESCRIPTION         |
|-----|----------|----|-------|---------------------|
| 1   | 12.11.00 |    |       | DRC FINAL REVIEW    |
| 2   | 01.05.01 |    |       | PER DOH REVIEW      |
| 3   | 01.31.01 |    |       | BUILDING DEPARTMENT |

PROJECT #84184  
POOL AND COMMUNITY  
CENTER/LAUDERDALE MANORS  
FT LAUDERDALE, FLORIDA

NO. OF SHEETS: 19  
SHEET NO.: 5  
CAD FILE NO.  
FILE NO. SP-5

**AQUADYNAMICS  
DESIGN GROUP, INC.**  
AQUATIC ENGINEERING CONSULTANTS  
4910 S.W. 72ND AVENUE  
MIAMI, FLORIDA 33155  
(305) 667-8976 TELEFAX (305) 668-1008

**SWIMMING POOL  
SCHEDULE OF EQUIPMENT**

| MARK | QTY. | ITEM                   | MFR        | CAT. No.   | DESCRIPTION  |
|------|------|------------------------|------------|------------|--|
| 1    | 2    | MAIN DRAIN ASSEMBLY    | HAYWARD    |            | HAYWARD 12" X 12" CYCLOG MAIN DRAIN GRATE ASSEMBLY, 78 SQ.IN. OPEN AREA, MODEL SF-1032   |
| 2    | 16/6 | RETURN FITTINGS        | HAYWARD    | SP1419     | DIR. ADJ. WALL INLET/ FLOW ADJ. FLR RET FITG.  |
| 3    | 4    | VACUUM FITTINGS        | HAYWARD    | SP-1022B   | 1 1/2" X 2" SLIP SOCKET, WITH FLUG.  |
| 4    | 22   | GUTTER DRAINS          | HAYWARD    | SP-1019    | SCUM GUTTER DRAIN FITG AND GRATE, 2" SKT X 2" FIP, WHITE ABS PLASTIC.  |
| 5    | 1    | STATIC FITTING         | HAYWARD    | SP-1019    | GRATE END FITTING FOR EQUALIZER/ MAKE-UP WATER LINE. FITG TO BE INSTALLED 12" BELOW POOL WATER LEVEL.  |
| 6    | 0    | POOL LIGHTS            |            |            | AMERICAN PRODUCTS POOL UNDERWATER LIGHT WITH STAINLESS STEEL FACE RING MODEL 178-1251, 300W 12V, 25 FT CORD INCLUDE AMERICAN PRODUCTS #121025 STAINLESS STEEL NICHE WITH 1" HUB, OR EQUAL.   |
| 7    | 0    | TRANSFORMER BOX        |            |            | TRANSFORMER BOX IN WEATHER PROOF ENCLOSURE. A.J. GIAMANCO SAF-T-VOLT DUAL WINDING TYPE.  |
| 8    | 0    | JUNCTION BOX           |            |            | JUNCTION BOX IN WEATHER PROOF NON-CORROSIVE ENCLOSURE. REFER TO LIGHT DETAIL ON THESE DRAWINGS FOR MOUNTING REQUIREMENTS. INSTALL IN ACCORDANCE WITH ALL LOCAL BUILDING DEPARTMENT REQUIREMENTS IN ADDITION ARTICLE 680 OF THE NATIONAL ELECTRICAL CODE. |
| 9    | 6    | GRABRAIL               | SPECTRUM   | 23525-00   | 1.90" X .065" CUSTOM PRETREL GRABRAIL PAIR 1.90" X 1.90" FASTENED TO DECK WITH SOLID BRASS WEDGE ANCHOR SOCKETS.   |
| 10   | 18   |                        |            | 23452-00   | RECESSED STAINLESS STEEL STEP  |
| 11   | 0    | HANDRAIL               |            |            | 3 BEND STAINLESS STEEL HANDRAIL HAVING AN OUTSIDE DIAMETER OF 1.50 INCHES AND A WALL THICKNESS OF 0.065 INCHES. THE RAIL SHALL BE ANCHORED IN THE DECK AND THE BOTTOM TREAD.   |
| 12   | 24   | ANCHOR SOCKET          | SPECTRUM   | 24010-00   | BRONZE 4" WEDGE ANCHOR EA. EACH SOCKET SHALL BE PROPERLY GROUNDED IN ACCORDANCE WITH NATIONAL ELECTRICAL CODE STANDARDS.   |
| 13   | 24   | ESCUTCHEON PLATE       | SPECTRUM   | 24110-00   | ESCUTCHEON PLATE STAINLESS STEEL - KEYHOLE.  |
| 14   | 2    | LIFE RING              | SPECTRUM   | 72305-00   | 20 INCH DIAMETER ORANGE RING BUOY  |
| 15   | 2    | LIFE HOOK              | SPECTRUM   | 72350-00   | 30 FT THROW ROPE.  |
| 16   | 2    | LIFE RING HOLDER       | SPECTRUM   | 70040-00   | KIT-SHEPHERD'S CROCK W/ 16' POLE   |
| 17   | 2    | LIFE RING HOLDER       | SPECTRUM   | 72370-00   | SS RING BUOY HOLDER  |
| 18   | 1    | VACUUM CLEANER         | SPECTRUM   | 12160-00   | COMMERCIAL DUTY VAC HEAD 18"   |
| 19   | 1    | TEST KIT               | SPECTRUM   | 12450-00   | HEAVY DUTY VAC HOSE 1 1/2" X 35'   |
| 20   | 1    | TEST KIT               | SPECTRUM   | 13690-00   | HEAVY DUTY ALUMINUM 8" X 16' TELEPOLE  |
| 21   | 1    | TEST KIT               | SPECTRUM   | 16090-00   | TAYLOR 2000-5 DUPLEX CAPABLE OF MEETING ALL CHEMICAL TESTS SPECIFIED BY THE FLORIDA ADMINISTRATIVE CODE IN CHAPTER 10D-5.  |
| 22   | 2    | PRESSURE GAUGES        | EPD        |            | 4" FACE 0-60 PSI PRESSURE #235425  |
| 23   | 1    | FILTER PUMP            | ITT MARLOW | 9B82EC-C2  | ITT MARLOW 9B82EC-C2, 1 1/2 HP, WITH INTEGRAL SUCTION STRAINER 28 GPM AT 10 FT. THREE PHASE 240VOLT 1750 RPM, SELF PRIMING PUMP.   |
| 24   | 1    | FILTER UNIT            | EPD        | 150        | EPD FULLY AUTO. GARNETT MEDIA. POLYMER FEED TURBIDIMETER. MODEL 150. 13.5 SF. FILTER AREA.   |
| 25   | 1    | FLOWMETER              | SPECTRUM   | 4999-0     | SIGNET ANALOG FLOWMETER. 5499-500. SIGNET 4" SADDLE 5411-040 (MAX RANGE 375 GPM) SIGNET FLOW SENSOR 5431-51  |
| 26   | 1    | STORAGE CONTAINER      |            |            | 55 GALLON CAPACITY CHEMICAL CONTAINER WITH LID & LABEL ON FRONT INDICATING CONTENTS  |
| 27   | 1    | CL2 FEEDER             | OLIN       | FULSAR III | FULSAR III CALHYPO EROSION FEEDER, 120 PPD   |
| 28   | 1    | CHEMICAL CONTROLLER    |            |            | STRANITROL SYSTEM 4 WITH DVT 1/0 PORT & REMOTE ANNUNCIATOR INSTALLED IN POOL MANAGERS OFFICE. PROVIDE AND INSTALL ALL CABLE CONDUIT FITTINGS AND HARDWARE FOR INSTALLATION PER MFRS. DETAILS (C.E.S. INC. JUPITER, FLORIDA)                              |
| 29   | 1    | WATER LEVEL CONTROLLER |            |            | TORO AUTOMATIC WATER LEVELING DEVICE, AND FLOAT VALVE ASSEMBLY. THE VALVE IS ALSO EQUIPPED WITH A 3/4" PVC FILL LINE AND MANUALLY OPERATED BALL VALVE  |
| 30   | 1    | COLLECTOR TANK         | COMPAC     | F200       | 200 GALLON CAPACITY. ALL FIBERGLASS CONSTRUCTION AS MANUFACTURED BY COMPAC FILTRATION, INC. 1-904-256-4003   |
| 31   | 1    | SIGHT GLASS            | SPECTRUM   | 4999-0     | 5 R. SMITH 1 1/2" MIP WITH SIGHT GLASS COMPLETE A41192-0   |
| 32   | 1    | ACID FEEDER            | STENNER    | 45M5       | STENNER 45M5 ACID FEEDER 50 GPD CAPACITY. INTERLOCK ELECTRICALLY WITH FILTER PUMP.   |
| 33   | 1    | HANDICAP LIFT CHAIR    | SPECTRUM   | 27326-00   | 5L-525 SHIM LIFT - NO ANCHOR   |
| 34   | 1    | ANCHOR                 | SPECTRUM   | 24600-00   | CUSTOM BASE STAN UPGRADE 30" SETBACK 6" DROP.  |
| 35   | 4    | STANCHION ANCHOR       | SPECTRUM   | 27450-00   | SL DECK ANCHOR PRESET  |
| 36   | 4    | STANCHION LID          | SPECTRUM   | 23626-00   | BRONZE STANCHION ANCHOR  |
| 37   | 4    | STANCHION KEY          | SPECTRUM   | 23628-00   | BRONZE STANCHION LID   |
| 38   | 2    | STANCHION KEY          | SPECTRUM   | 23630-00   | STANCHION KEY  |
| 39   | 8    | CUP ANCHOR             | SPECTRUM   | 58310-00   | CFB CUP ANCHOR 4" SQUARE   |

**RESTROOM FACILITIES REQUIREMENTS**

1. THE FLOORS SHALL BE CONSTRUCTED OF AN IMPERVIOUS MATERIAL AND SHALL HAVE A NON SLIP SURFACE FINISH.
2. THE FLOORS SHALL SLOPE TO A FLOOR DRAIN AT LEAST 3 INCHES IN DIAMETER.
3. FIXTURE SETS SHALL INCLUDE THE FOLLOWING: MEN: 1 WATER CLOSET, 2 URINALS, 2 LAVATORIES, AND ONE 3/4 INCH HOSE BIBB WITH VACUUM BREAKER. WOMEN: 3 WATER CLOSETS, 2 LAVATORIES, AND ONE 3/4 INCH HOSE BIBB WITH VACUUM BREAKER.
4. EACH SEX SHALL BE LABELED ON THEIR RESPECTIVE DOORS.
5. DIRECT ACCESS FROM THE POOL OR THE SPA DECK TO THE RESTROOM FACILITIES IS REQUIRED.
6. WALLS IN RESTROOM FACILITIES SHALL BE COVERED.

**EQUIPMENT ROOM REQUIREMENTS**

































1. THE FLOOR IN THE ROOM SHALL BE CONSTRUCTED OF CONCRETE HAVING A SMOOTH LIKE NON-SLIP SURFACE FINISH.
2. THE FLOOR SHALL BE POSITIVELY DRAINED TO A FLOOR DRAIN.
3. A 1 INCH HOSE BIBB WITH VACUUM BREAKER SHALL BE LOCATED INSIDE THE ROOM.
4. THE OVERHEAD LIGHT SHALL EMIT AT LEAST 50 FOOT CANDLES OF ILLUMINATION AT THE FLOOR LEVEL.
5. CLEARANCES TO PUMPS AND FILTERS FROM WALLS SHALL BE AS SPECIFIED BY THE MANUFACTURER.

**FILTER PIPING REQUIREMENTS**

1. TAG ALL VALVES AND POST OPERATING INSTRUCTION INSIDE THE ROOM.
2. ALL FACE PIPING SHALL BE PVC SCHEDULE 40 NSF-FM. ALL JOINT SHALL BE NON-THEADED SOLVENT WELD TYPE.
3. GATE VALVES SHALL NOT BE USED AS A MEANS FOR CONTROLLING THE FLOW OF WATER. ALL PROPORTIONAL FLOW TYPE VALVES ARE INDICATED ON THE DRAWING.
4. ELECTRICALLY OPERATED CHEMICAL FEEDERS SHALL BE INTERLOCKED WITH THE FILTER PUMP MOTOR.
5. THE CHEMICAL SOLUTION TANK SHALL BE LABELED ACCORDING TO THE SOLUTION OF WHICH IT CONTAINS.

**DEPARTMENT OF HEALTH NOTES**

1. ALL DECKS SHALL SLOPE AWAY FROM THE POOL 2%-4%.
2. ALL FACE SURFACES SHALL HAVE A SMOOTH SLIP RESISTANT FINISH.
3. HOSE BIBBS SHALL BE LOCATED AROUND THE POOL DECK FOR CLEANING.
4. A RINSE SHOWER SHALL BE LOCATED WITHIN 20 FEET OF THE POOL & SPA.
5. A DRINKING FOUNTAIN SHALL BE LOCATED IN THE POOL AREA.
6. ALL WALKWAYS BETWEEN THE POOL AND SANITARY FACILITIES SHALL BE CONSTRUCTED OF CONCRETE OR OTHER NON-ABSORBENT MATERIAL FOR THE FIRST FIFTEEN FEET AND SHALL HAVE A NON-SLIP SURFACE FINISH.
7. IF SANITARY FACILITIES ARE NOT VISIBLE FROM THE DECK, A SIGN OR SIGNS INDICATING THE DIRECTION TO THE RESTROOMS SHALL BE POSTED ON THE POOL DECK.
8. POOL NET DECKS LIGHTING PROVIDES FOR USE DURING DAYLIGHT HOURS ONLY. FOR NIGHT USE, PLANS MUST BE SUBMITTED TO THE LOCAL BOARD OF HEALTH ENGINEERING DEPARTMENT, WITH ALL REQUIREMENTS PER CHAPTER 64E-4 FLORIDA ADMINISTRATIVE CODE FOR NIGHT SWIMMING.
9. FOR NIGHT SWIMMING, OVERHEAD LIGHTING SHALL PROVIDE FOR A MINIMUM OF 15 FOOT CANDLES OF ILLUMINATION AT THE WATER AND DECK LEVEL. UNLESS SPECIFICALLY MENTIONED ON THESE PLANS ALONG WITH LIGHTING REQUIREMENTS, NO NIGHT SWIMMING WILL BE ALLOWED.
10. DISTRIBUTION OF FOOD OR DRINK WITHIN 12 FEET OF THE POOL WATERS EDGE IS PROHIBITED.
11. STORAGE OF CHEMICALS SHALL BE MADE IN AN ENCLOSED LOCKABLE AREA TO PREVENT UNAUTHORIZED ACCESS.
12. ALL POOL SURFACES SHALL HAVE A SMOOTH LIKE NON-SLIP FINISH.
13. NO OVERHEAD WIRING SHALL BE LOCATED WITHIN 10 FEET OF THE POOL.
14. ALL ELECTRICAL WORK SHALL BE DONE BY QUALIFIED LICENSED CONTRACTORS AND IN STRICT ACCORDANCE WITH THE NATIONAL ELECTRICAL CODE ARTICLE 680, 1994 EDITION.
15. ALL POOL PIPING SHALL BE PVC FM SCHEDULE 40 NON-THEADED NSF APPROVED. ALL PIPE SHALL DISPLAY THE NSF-FM LOGO.
16. THE DEPTH MARKERS SHALL INDICATE THE DEPTH AT NORMAL OPERATING WATER LEVEL, WITHIN 3 INCHES, WHEN MEASURED 3 FEET FROM THE WALL OF THE POOL. SYMMETRICAL POOL DESIGNS WITH THE DEEP POINT AT THE CENTER, MAY BE ALLOWED TO DISPLAY A DUAL MARKING SYSTEM WHICH INDICATES THE DEPTH AT THE WALL AND THE DEEP POINT. DEPTH MARKERS SHALL BE LOCATED ON BOTH SIDES OF THE POOL.
17. THE MINIMUM DEPTH SHALL BE 3'-6" AT THE SHALLOW END.
18. ALL POOL DEPTHS SHALL BE AS SPECIFIED ON THE PLANS.
19. POOL RESTROOM FACILITIES SHALL BE LOCATED WITHIN A 200 FOOT RADIUS OF THE POOL.
20. ALL STEEL SHALL BE ASTM A615 GRADE 60 HAVING A YIELD STRENGTH 60,000 PSI.
21. ALL CONCRETE SHALL HAVE A COMPRESSIVE STRENGTH OF 3000 PSI IN 28 DAYS.
22. ALL STEEL COMING IN CONTACT WITH SOIL SHALL HAVE 3 INCH COVER. STEEL CLOSE TO THE WATER SURFACE SHALL HAVE 1/2 INCH COVER. VERTICAL STEEL IN THE POOL WALLS SHALL BE CENTERED IN THE WALL UNLESS OTHERWISE NOTED.
23. ALL POOL WALLS SHALL BE SHOTCRETE OR GUNITE (PNEUMATICALLY PLACED).
24. POOL FLOORS OF POURED CONCRETE SHALL HAVE A MINIMUM THICKNESS OF 6 INCHES WITH MINIMUM REINFORCEMENT OF # 3 BARS SPACED 10 IN. CENTER TO CENTER IN EACH DIRECTION.
25. REFER TO STRUCTURAL DRAWINGS FOR ALL CONCRETE AND REINFORCING DETAILS WHEN THE POOL IS PILING SUPPORTED.
26. MINIMUM DECK WIDTH SHALL NOT BE LESS THAN 4 FEET WIDE. WHEN THE COPING IS RAISED ABOVE THE DECK, THE CLEARANCE SHALL BE MEASURED FROM THE BACK OF THE COPING, HANDRAIL, OR LADDER, TO THE NEAREST OBSTRUCTION.

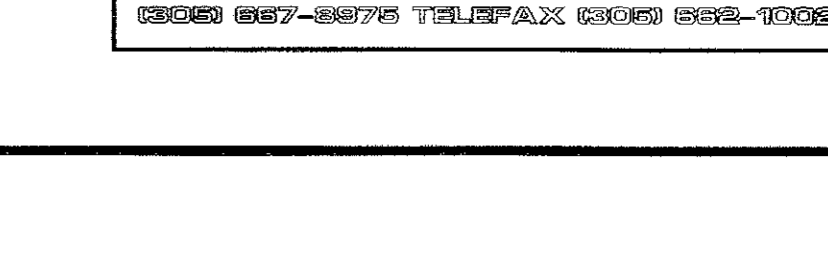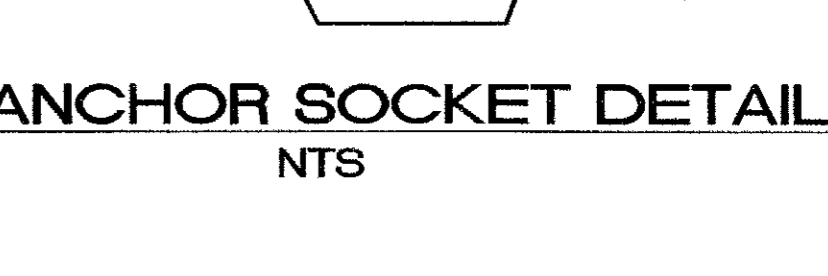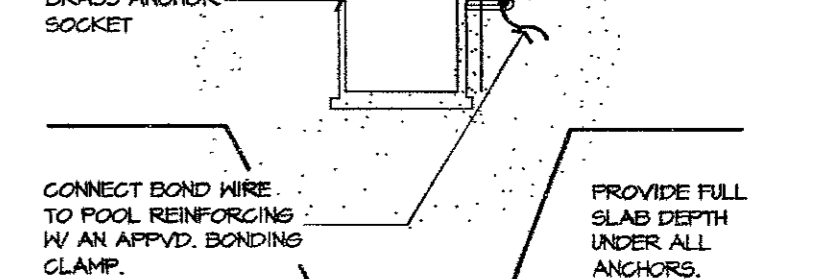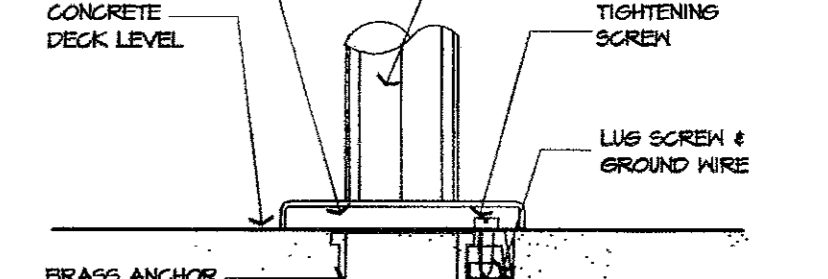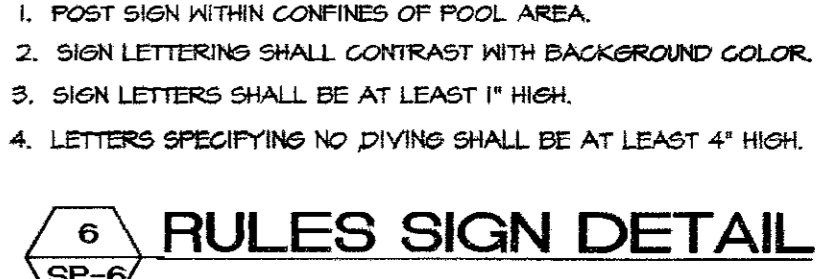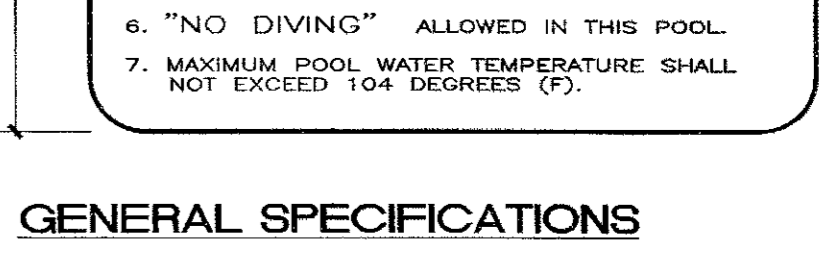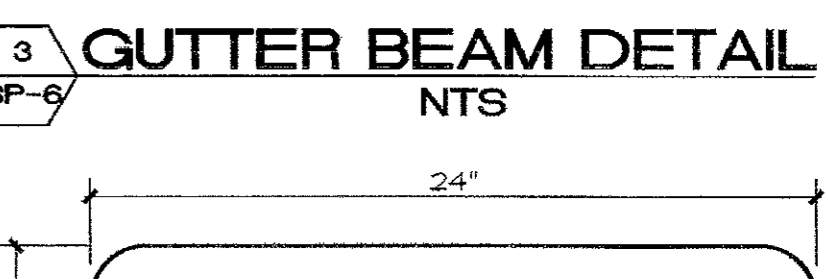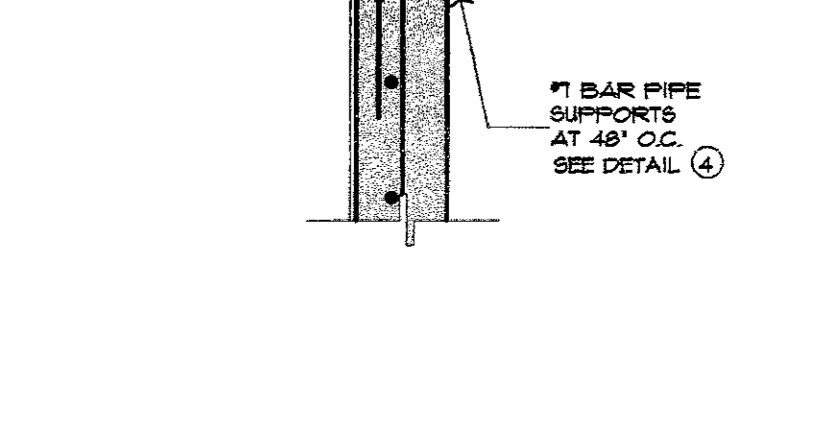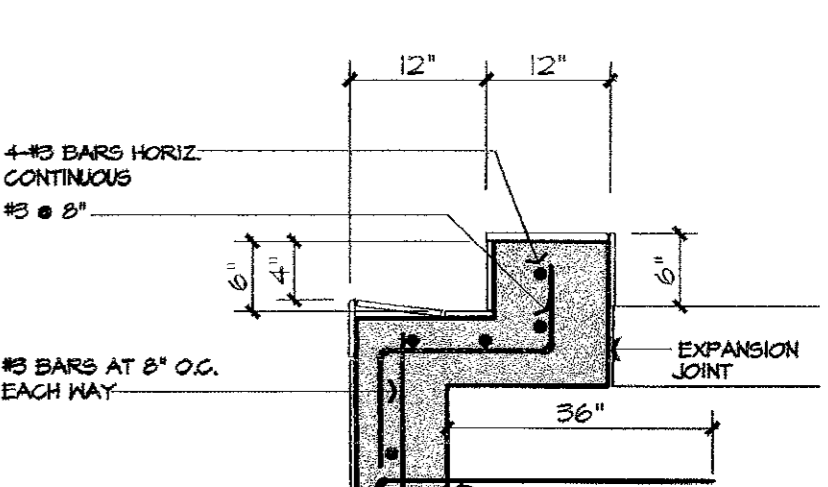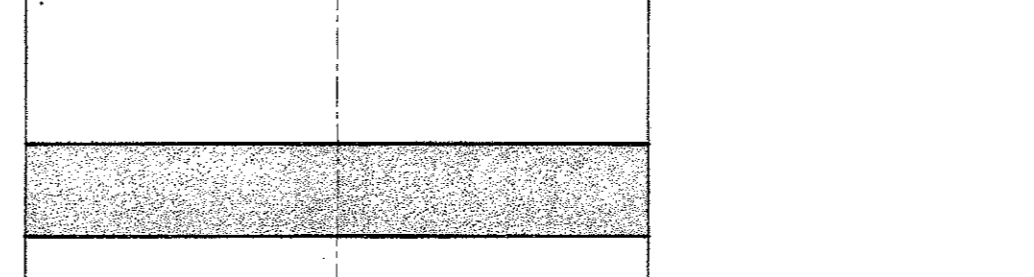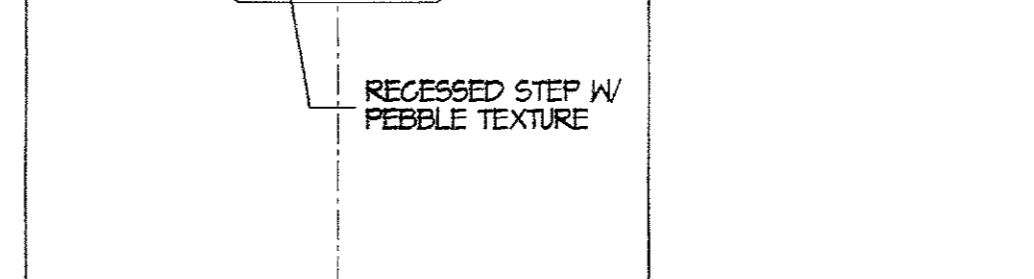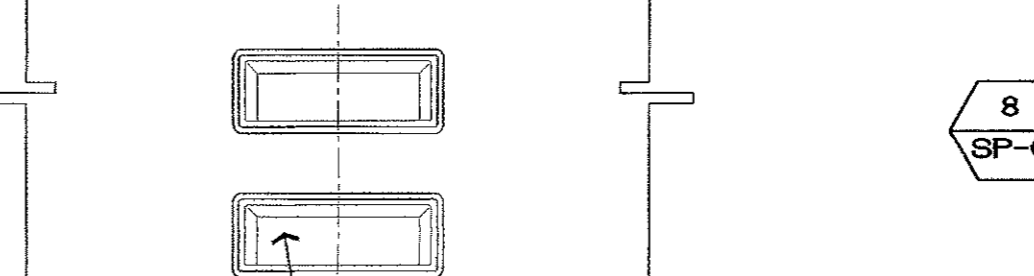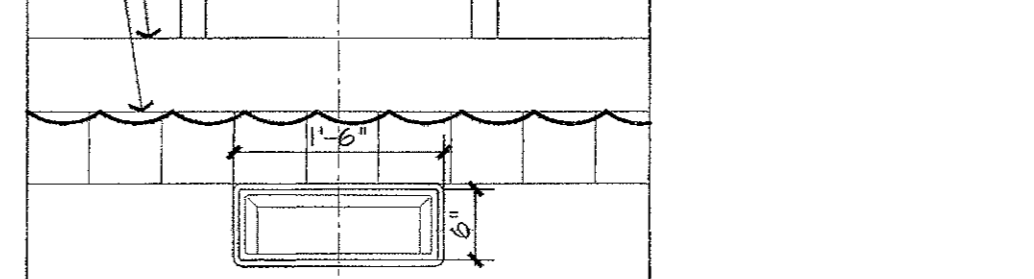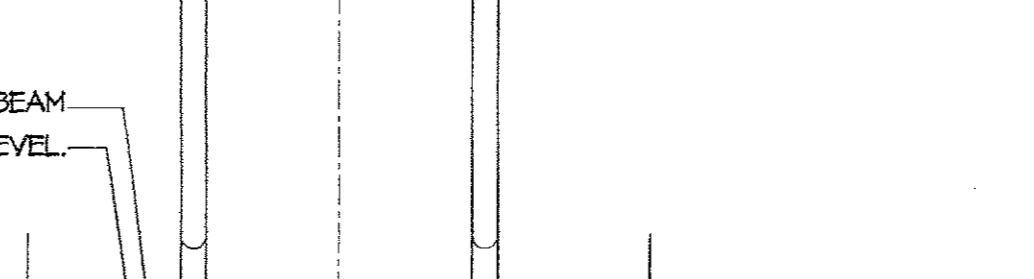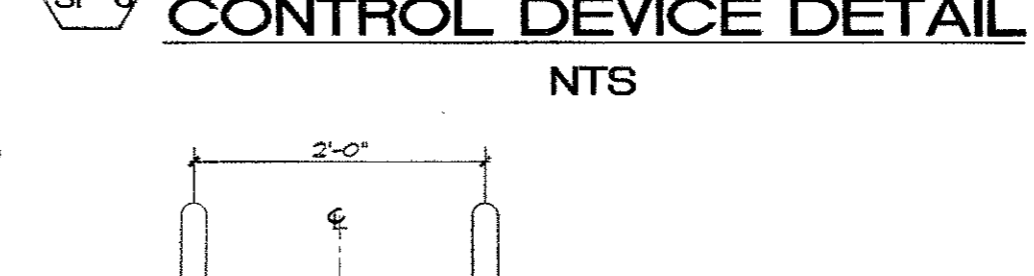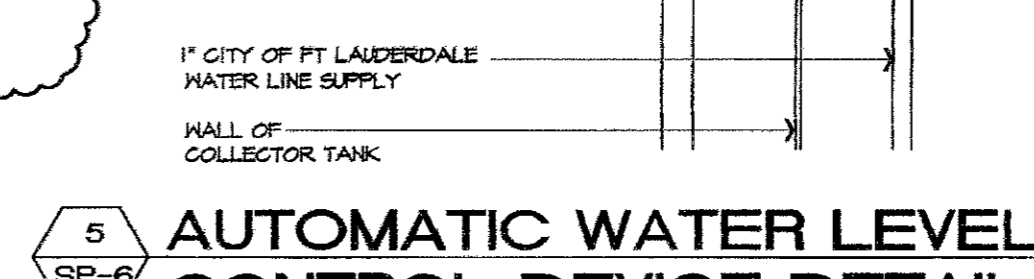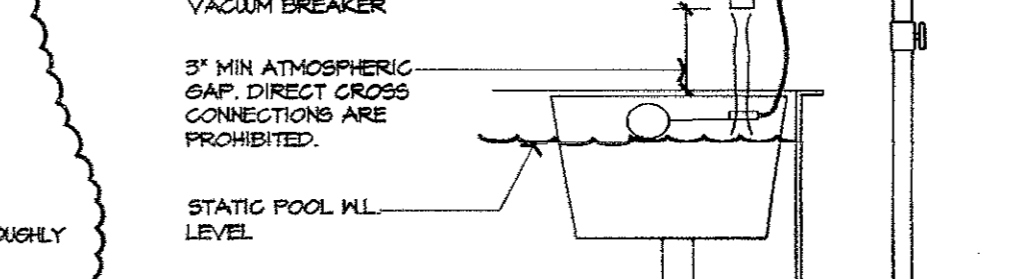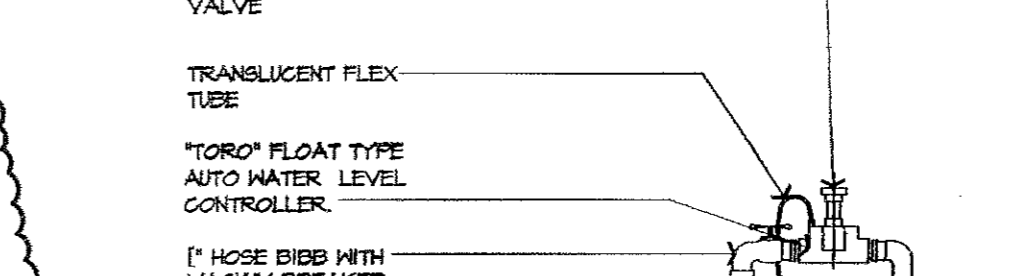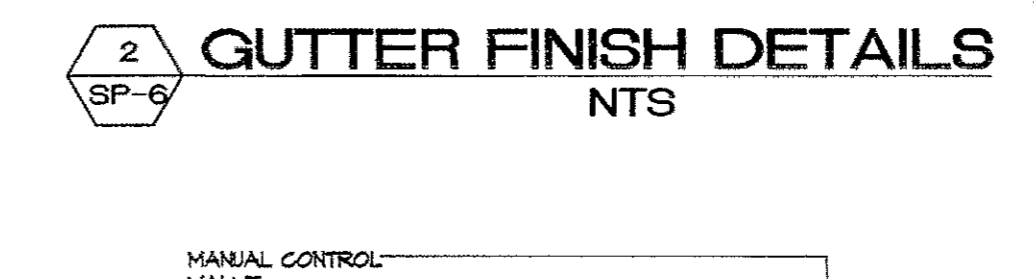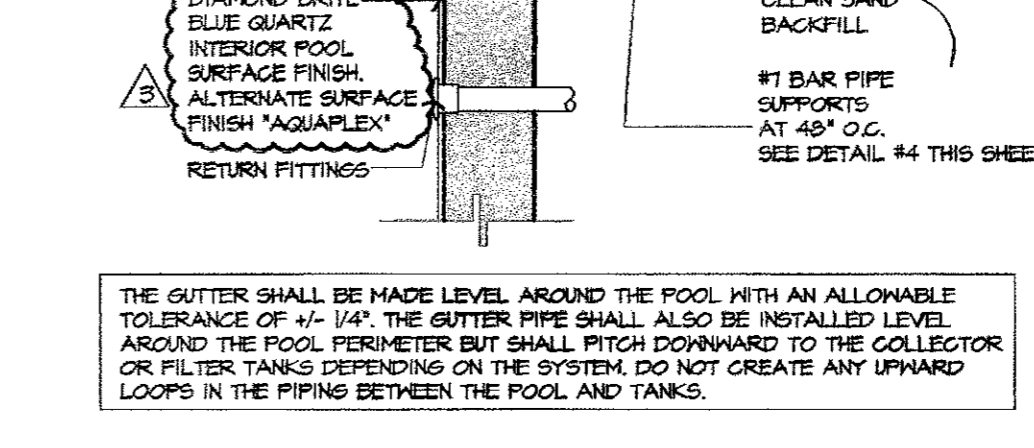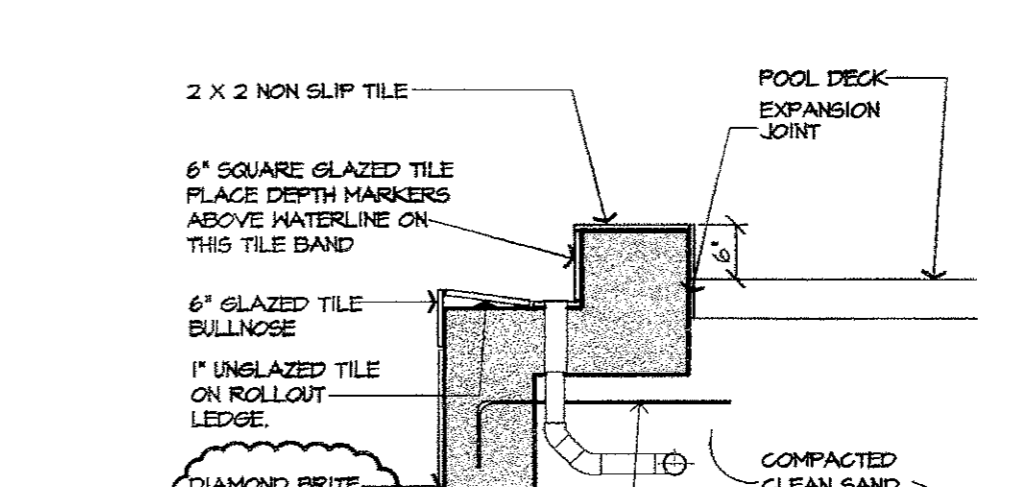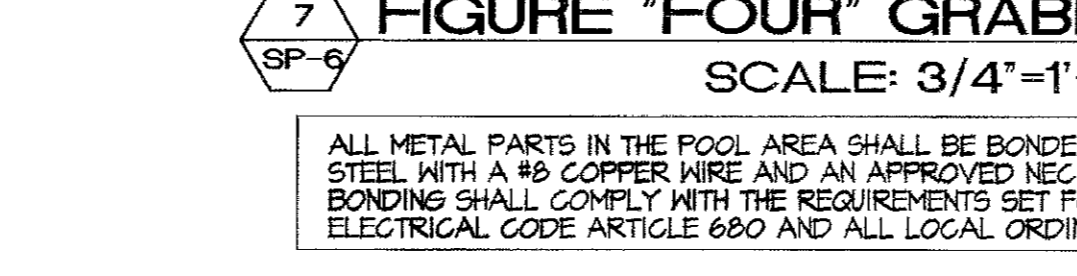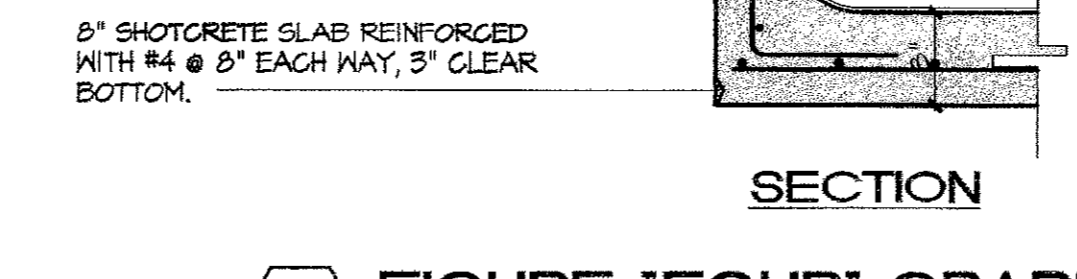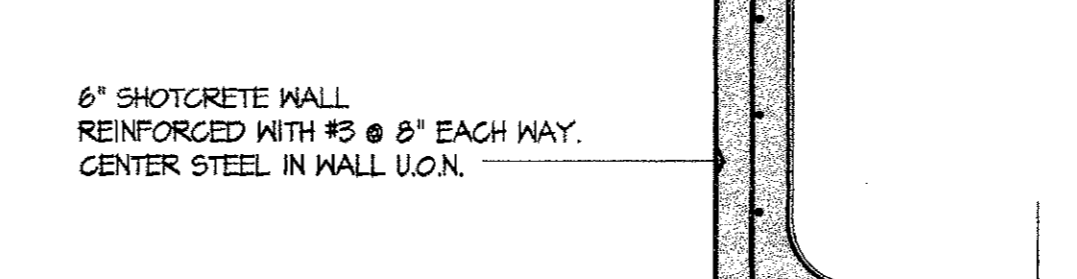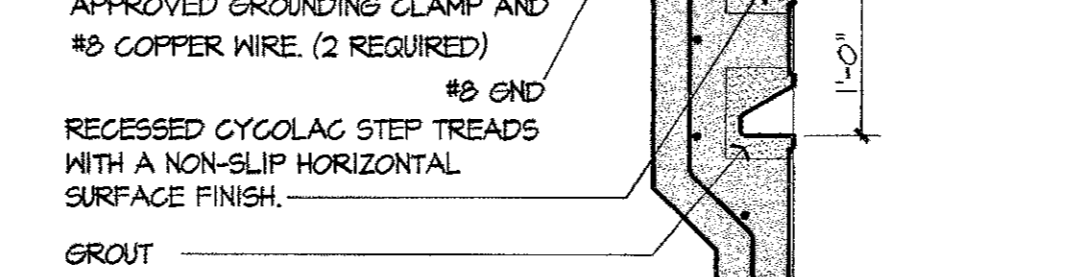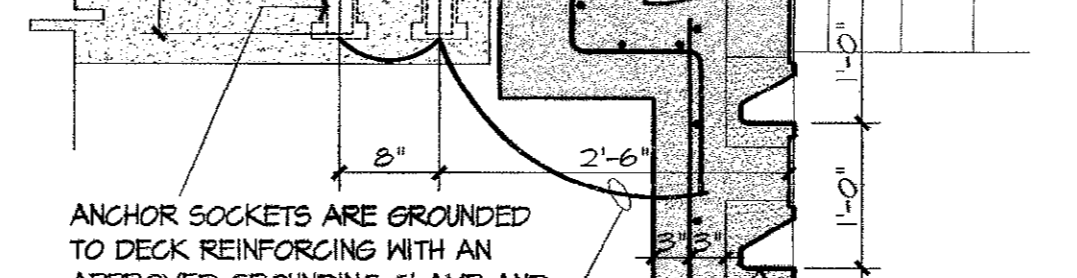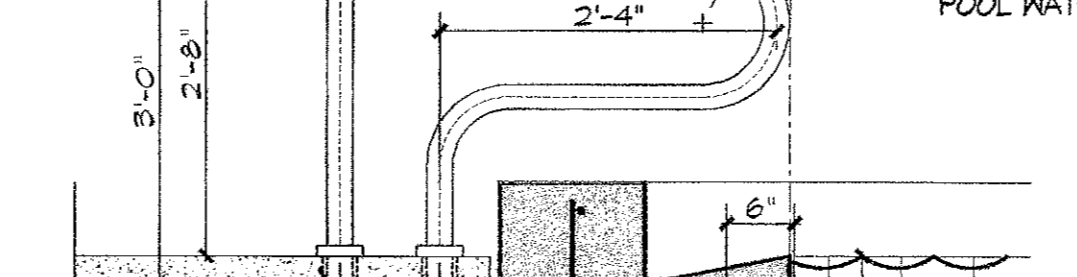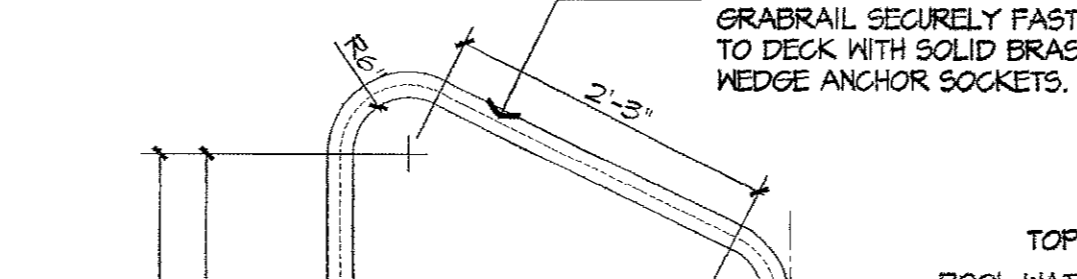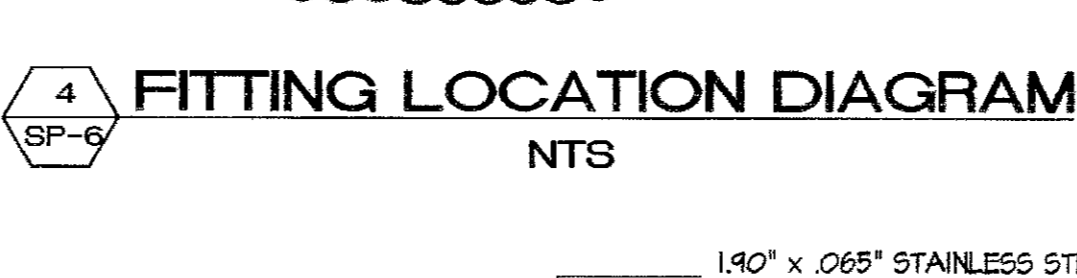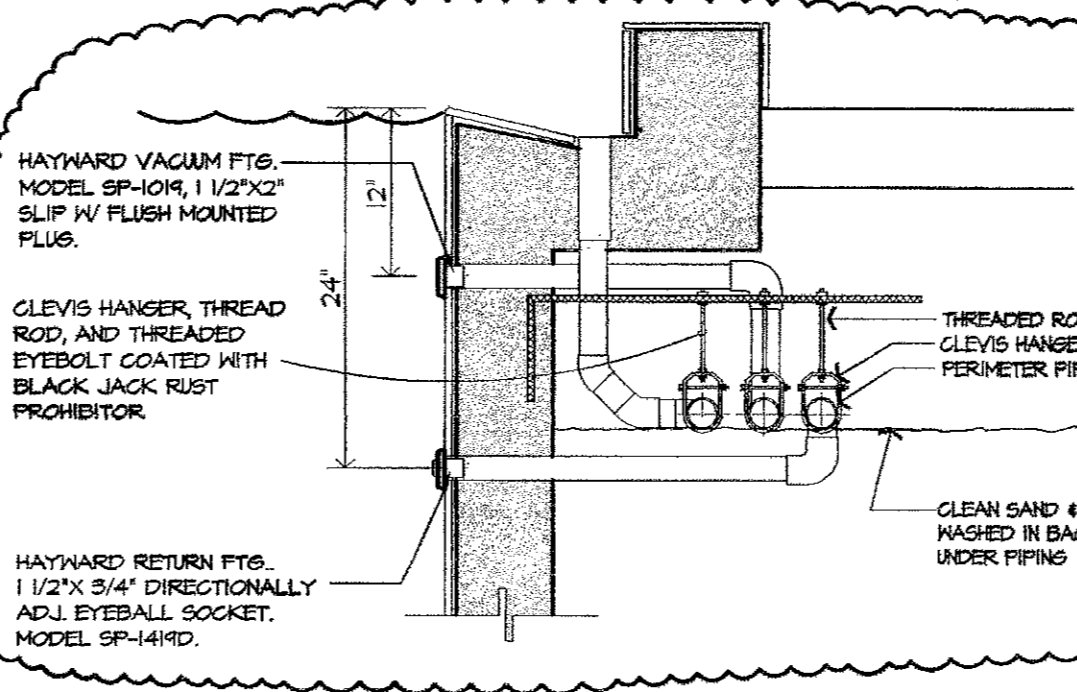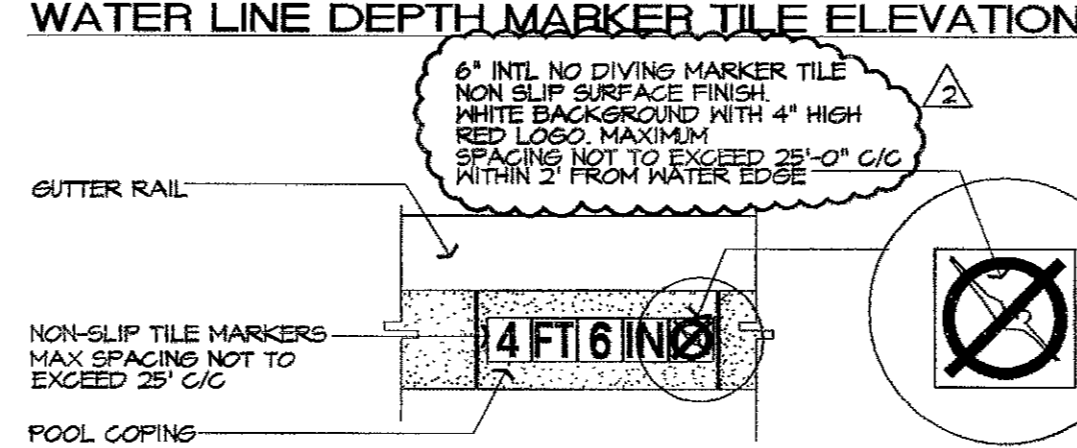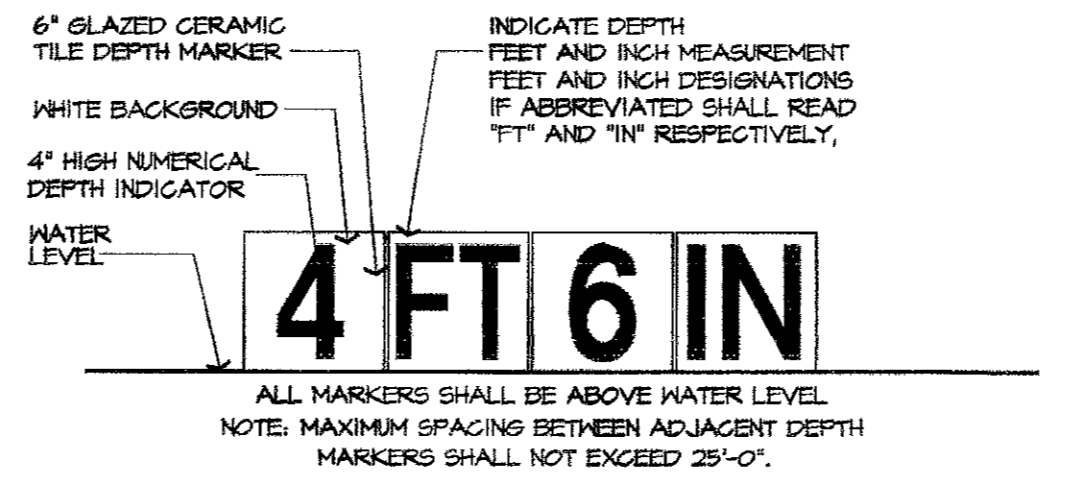

FINAL APPROVAL  
SCALE: AS SHOWN  
DRAWN BY: OT  
DESIGNED BY: OT  
CHECKED BY: B. SAUVE

CITY OF FORT LAUDERDALE  
PUBLIC SERVICES DEPARTMENT  
ENGINEERING DIVISION  
FORT LAUDERDALE, FLORIDA

PROJECT #84184  
POOL AND COMMUNITY  
CENTER/LAUDERDALE MANORS  
FT LAUDERDALE, FLORIDA

NO. OF SHEETS: 19  
SHEET NO.: 6  
CAD FILE NO.  
FILE NO. SP-6

AQUADYNAMICS  
DESIGN GROUP, INC.  
AQUATIC ENGINEERING CONSULTANTS  
4470 N.W. 72ND AVENUE  
MIAMI, FLORIDA 33155  
(305) 667-8875 TELEFAX (305) 668-1006

REVISIONS  
NO. DATE BY CHK'D DESCRIPTION  
1 12/1/00 PER DOH REVIEW  
2 01/05/01 BUILDING DEPARTMENT.  
3 01/31/01





**CITY OF FORT LAUDERDALE  
GENERAL CONDITIONS**

These instructions and conditions are standard for all contracts for commodities or services issued through the City of Fort Lauderdale Procurement Services Division. The City may delete, supersede, or modify any of these standard instructions for a particular contract by indicating such change in the Invitation to Bid (ITB) Special Conditions, Technical Specifications, Instructions, Proposal Pages, Addenda, and Legal Advertisement. In this general conditions document, Invitation to Bid (ITB), Request for Qualifications (RFQ), and Request for Proposal (RFP) are interchangeable.

**PART I BIDDER PROPOSAL PAGE(S) CONDITIONS:**

- 1.01 BIDDER ADDRESS:** The City maintains automated vendor address lists that have been generated for each specific Commodity Class item through our bid issuing service, BidSync. Notices of Invitations to Bid (ITB'S) are sent by e-mail to the selection of bidders who have fully registered with BidSync or faxed (if applicable) to every vendor on those lists, who may then view the bid documents online. Bidders who have been informed of a bid's availability in any other manner are responsible for registering with BidSync in order to view the bid documents. There is no fee for doing so. If you wish bid notifications be provided to another e-mail address or fax, please contact BidSync. If you wish purchase orders sent to a different address, please so indicate in your bid response. If you wish payments sent to a different address, please so indicate on your invoice.
- 1.02 DELIVERY:** Time will be of the essence for any orders placed as a result of this ITB. The City reserves the right to cancel any orders, or part thereof, without obligation if delivery is not made in accordance with the schedule specified by the Bidder and accepted by the City.
- 1.03 PACKING SLIPS:** It will be the responsibility of the awarded Contractor, to attach all packing slips to the OUTSIDE of each shipment. Packing slips must provide a detailed description of what is to be received and reference the City of Fort Lauderdale purchase order number that is associated with the shipment. Failure to provide a detailed packing slip attached to the outside of shipment may result in refusal of shipment at Contractor's expense.
- 1.04 PAYMENT TERMS AND CASH DISCOUNTS:** Payment terms, unless otherwise stated in this ITB, will be considered to be net 45 days after the date of satisfactory delivery at the place of acceptance and receipt of correct invoice at the office specified, whichever occurs last. Bidder may offer cash discounts for prompt payment but they will not be considered in determination of award. If a Bidder offers a discount, it is understood that the discount time will be computed from the date of satisfactory delivery, at the place of acceptance, and receipt of correct invoice, at the office specified, whichever occurs last.
- 1.05 TOTAL BID DISCOUNT:** If Bidder offers a discount for award of all items listed in the bid, such discount shall be deducted from the total of the firm net unit prices bid and shall be considered in tabulation and award of bid.
- 1.06 BIDS FIRM FOR ACCEPTANCE:** Bidder warrants, by virtue of bidding, that the bid and the prices quoted in the bid will be firm for acceptance by the City for a period of one hundred twenty (120) days from the date of bid opening unless otherwise stated in the ITB.
- 1.07 VARIANCES:** For purposes of bid evaluation, Bidder's must indicate any variances, no matter how slight, from ITB General Conditions, Special Conditions, Specifications or Addenda in the space provided in the ITB. No variations or exceptions by a Bidder will be considered or deemed a part of the bid submitted unless such variances or exceptions are listed in the bid and referenced in the space provided on the bidder proposal pages. If variances are not stated, or referenced as required, it will be assumed that the product or service fully complies with the City's terms, conditions, and specifications.
- 1.08 NO BIDS:** If you do not intend to bid please indicate the reason, such as insufficient time to respond, do not offer product or service, unable to meet specifications, schedule would not permit, or any other reason, in the space provided in this ITB. Failure to bid or return no bid comments prior to the bid due and opening date and time, indicated in this ITB, may result in your firm being deleted from our Bidder's registration list for the Commodity Class Item requested in this ITB.
- 1.09 MINORITY AND WOMEN BUSINESS ENTERPRISE PARTICIPATION AND BUSINESS DEFINITIONS:** The City of Fort Lauderdale wants to increase the participation of Minority Business Enterprises (MBE), Women Business Enterprises (WBE), and Small Business Enterprises (SBE) in its procurement activities. If your firm qualifies in accordance with the below definitions please indicate in the space provided in this ITB.

By receiving a bid, City does not necessarily accept any variances contained in the bid. All variances submitted are subject to review and approval by the City. If any bid contains material variances that, in the City's sole opinion, make that bid conditional in nature, the City reserves the right to reject the bid or part of the bid that is declared by the City as conditional.

Minority Business Enterprise (MBE) "A Minority Business" is a business enterprise that is owned or controlled by one or more socially or economically disadvantaged persons. Such disadvantage may arise from cultural, racial, chronic economic circumstances or background or other similar cause. Such persons include, but are not limited to: Blacks, Hispanics, Asian Americans, and Native Americans.

The term "Minority Business Enterprise" means a business at least 51 percent of which is owned by minority group members or, in the case of a publicly owned business, at least 51 percent of the stock of which is owned by minority group members. For the purpose of the preceding sentence, minority group members are citizens of the United States who include, but are not limited to: Blacks, Hispanics, Asian Americans, and Native Americans.

Women Business Enterprise (WBE) a "Women Owned or Controlled Business" is a business enterprise at least 51 percent of which is owned by females or, in the case of a publicly owned business, at least 51 percent of the stock of which is owned by females.

Small Business Enterprise (SBE) "Small Business" means a corporation, partnership, sole proprietorship, or other legal entity formed for the purpose of making a profit, which is independently owned and operated, has either fewer than 100 employees or less than \$1,000,000 in annual gross receipts.

BLACK, which includes persons having origins in any of the Black racial groups of Africa.

WHITE, which includes persons whose origins are Anglo-Saxon and Europeans and persons of Indo-European decent including Pakistani and East Indian.

HISPANIC, which includes persons of Mexican, Puerto Rican, Cuban, Central and South American, or other Spanish culture or origin, regardless of race.

NATIVE AMERICAN, which includes persons whose origins are American Indians, Eskimos, Aleuts, or Native Hawaiians.

ASIAN AMERICAN, which includes persons having origin in any of the original peoples of the Far East, Southeast Asia, the Indian subcontinent, or the Pacific Islands.

- 1.10 MINORITY-WOMEN BUSINESS ENTERPRISE PARTICIPATION:** It is the desire of the City of Fort Lauderdale to increase the participation of minority (MBE) and women-owned (WBE) businesses in its contracting and procurement programs. While the City does not have any preference or set

aside programs in place, it is committed to a policy of equitable participation for these firms. Proposers are requested to include in their proposals a narrative describing their past accomplishments and intended actions in this area. If proposers are considering minority or women owned enterprise participation in their proposal, those firms, and their specific duties have to be identified in the proposal. If a proposer is considered for award, he or she will be asked to meet with City staff so that the intended MBE/WBE participation can be formalized and included in the subsequent contract.

**1.11 SCRUTINIZED COMPANIES:** As a condition precedent to the effectiveness of this Agreement, subject to *Odebrecht Construction, Inc., v. Prasad*, 876 F.Supp.2d 1305 (S.D. Fla. 2012), *affirmed*, *Odebrecht Construction, Inc., v. Secretary, Florida Department of Transportation*, 715 F.3d 1268 (11th Cir. 2013), with regard to the "Cuba Amendment," the Contractor certifies that it is not on the Scrutinized Companies with Activities in the Iran Petroleum Energy Sector List, and that it does not have business operations in Cuba or Syria, as provided in section 287.135, Florida Statutes (2022), as may be amended or revised. As a condition precedent to any contract for goods or services of any amount and as a condition precedent to the renewal of any contract for goods or services of any amount, the Contractor certifies that it is not on the Scrutinized Companies that Boycott Israel List created pursuant to Section 215.4725, Florida Statutes (2022), and that it is not engaged in a boycott of Israel. The City may terminate this Agreement at the City's option if the Contractor is found to have submitted a false certification as provided under subsection (5) of section 287.135, Florida Statutes (2022), as may be amended or revised, or been placed on the Scrutinized Companies with Activities in Sudan List or the Scrutinized Companies with Activities in the Iran Petroleum Energy Sector List or the Scrutinized Companies that Boycott Israel List created pursuant to Section 215.4725, Florida Statutes (2022), as may be amended or revised, or is engaged in a boycott of Israel, or has been engaged in business operations in Cuba or Syria, as defined in Section 287.135, Florida Statutes (2022), as may be amended or revised.

**1.12 DEBARRED OR SUSPENDED BIDDERS OR PROPOSERS**  
The bidder or proposer certifies, by submission of a response to this solicitation, that neither it nor its principals and subcontractors are presently debarred or suspended by any Federal department or agency.

## **Part II DEFINITIONS/ORDER OF PRECEDENCE:**

**2.01 BIDDING DEFINITIONS** The City will use the following definitions in its general conditions, special conditions, technical specifications, instructions to bidders, addenda and any other document used in the bidding process:

INVITATION TO BID (ITB) The solicitation document used for soliciting competitive sealed bids for goods or services.

INVITATION TO NEGOTIATE (ITN) All solicitation documents, regardless of medium, whether attached to or incorporated by reference in solicitations for responses from firms that invite proposals from interested and qualified firms so the city may enter into negotiations with the firm(s) determined most capable of providing the required goods or services.

REQUEST FOR PROPOSALS (RFP) A solicitation method used for soliciting competitive sealed proposals to determine the best value among proposals for goods or services for which price may not be the prevailing factor in award of the contract, or the scope of work, specifications or contract terms and conditions may be difficult to define. Such solicitation will consider the qualifications of the proposers along with evaluation of each proposal using identified and generally weighted evaluation criteria. RFPs may include price criteria whenever feasible, at the discretion of the city.

REQUEST FOR QUALIFICATIONS (RFQ) A solicitation method used for requesting statements of qualifications in order to determine the most qualified proposer for professional services.

BID – a price and terms quote received in response to an ITB.

PROPOSAL – a proposal received in response to an RFP.

BIDDER – Person or firm submitting a Bid.

PROPOSER – Person or firm submitting a Proposal.

RESPONSIVE BIDDER – A firm who has submitted a bid, offer, quote, or response which conforms in all material respects to the competitive solicitation document and all of its requirements.

RESPONSIBLE BIDDER – A firm who is fully capable of meeting all requirements of the solicitation and subsequent contract. The respondent must possess the full capability, including financial and technical, ability, business judgment, experience, qualifications, facilities, equipment, integrity, capability, and reliability, in all respects to perform fully the contract requirements and assure good faith performance as determined by the city.

FIRST RANKED PROPOSER – That Proposer, responding to a City RFP, whose Proposal is deemed by the City, the most advantageous to the City after applying the evaluation criteria contained in the RFP.

SELLER – Successful Bidder or Proposer who is awarded a Purchase Order or Contract to provide goods or services to the City.

CONTRACTOR – Any firm having a contract with the city. Also referred to as a "Vendor".

CONTRACT – All types of agreements, including purchase orders, for procurement of supplies, services, and construction, regardless of what these agreements may be called.

CONSULTANT – A firm providing professional services for the city.

**2.02 SPECIAL CONDITIONS:** Any and all Special Conditions contained in this ITB that may be in variance or conflict with these General Conditions shall have precedence over these General Conditions. If no changes or deletions to General Conditions are made in the Special Conditions, then the General Conditions shall prevail in their entirety,

## **PART III BIDDING AND AWARD PROCEDURES:**

**3.01 SUBMISSION AND RECEIPT OF BIDS:** To receive consideration, bids must be received prior to the bid opening date and time. Unless otherwise specified, Bidders should use the proposal forms provided by the City. These forms may be duplicated, but failure to use the forms may cause the bid to be rejected. Any erasures or corrections on the bid must be made in ink and initialed by Bidder in ink. All information submitted by the Bidder shall be printed, typewritten or filled in with pen and ink. Bids shall be signed in ink. Separate bids must be submitted for each ITB issued by the City in separate sealed envelopes properly marked. When a particular ITB or RFP requires multiple copies of bids or proposals they may be included in a single envelope or package properly sealed and identified. Only send bids via facsimile transmission (FAX) if the ITB specifically states that bids sent via FAX will be considered. If such a statement is not included in the ITB, bids sent via FAX will be rejected. Bids will be publicly opened in the Procurement Office, or other designated area, in the presence of Bidders, the public, and City staff. Bidders and the public are invited and encouraged to attend bid openings. Bids will be tabulated and made available for review by Bidder's and the public in accordance with applicable regulations.

**3.02 MODEL NUMBER CORRECTIONS:** If the model number for the make specified in this ITB is incorrect, or no longer available and replaced with an updated model with new specifications, the Bidder shall enter the correct model number on the bidder proposal page. In the case of an updated model with new specifications, Bidder shall provide adequate information to allow the City to determine if the model bid meets the City's requirements.

**3.03 PRICES QUOTED:** Deduct trade discounts and quote firm net prices. Give both unit price and extended total. In the case of a discrepancy in computing the amount of the bid, the unit price quoted will govern. All prices quoted shall be F.O.B. destination, freight prepaid (Bidder pays and bears

freight charges, Bidder owns goods in transit and files any claims), unless otherwise stated in Special Conditions. Each item must be bid separately. No attempt shall be made to tie any item or items contained in the ITB with any other business with the City.

- 3.04 TAXES:** The City of Fort Lauderdale is exempt from Federal Excise and Florida Sales taxes on direct purchase of tangible property. Exemption number for EIN is 59-6000319, and State Sales tax exemption number is 85-8013875578C-1.
- 3.05 WARRANTIES OF USAGE:** Any quantities listed in this ITB as estimated or projected are provided for tabulation and information purposes only. No warranty or guarantee of quantities is given or implied. It is understood that the Contractor will furnish the City's needs as they arise.
- 3.06 APPROVED EQUAL:** When the technical specifications call for a brand name, manufacturer, make, model, or vendor catalog number with acceptance of APPROVED EQUAL, it shall be for the purpose of establishing a level of quality and features desired and acceptable to the City. In such cases, the City will be receptive to any unit that would be considered by qualified City personnel as an approved equal. In that the specified make and model represent a level of quality and features desired by the City, the Bidder must state clearly in the bid any variance from those specifications. It is the Bidder's responsibility to provide adequate information, in the bid, to enable the City to ensure that the bid meets the required criteria. If adequate information is not submitted with the bid, it may be rejected. The City will be the sole judge in determining if the item bid qualifies as an approved equal.
- 3.07 MINIMUM AND MANDATORY TECHNICAL SPECIFICATIONS:** The technical specifications may include items that are considered minimum, mandatory, or required. If any Bidder is unable to meet or exceed these items, and feels that the technical specifications are overly restrictive, the bidder must notify the Procurement Services Division immediately. Such notification must be received by the Procurement Services Division prior to the deadline contained in the ITB, for questions of a material nature, or prior to five (5) days before bid due and open date, whichever occurs first. If no such notification is received prior to that deadline, the City will consider the technical specifications to be acceptable to all bidders.
- 3.08 MISTAKES:** Bidders are cautioned to examine all terms, conditions, specifications, drawings, exhibits, addenda, delivery instructions and special conditions pertaining to the ITB. Failure of the Bidder to examine all pertinent documents shall not entitle the bidder to any relief from the conditions imposed in the contract.
- 3.09 SAMPLES AND DEMONSTRATIONS:** Samples or inspection of product may be requested to determine suitability. Unless otherwise specified in Special Conditions, samples shall be requested after the date of bid opening, and if requested should be received by the City within seven (7) working days of request. Samples, when requested, must be furnished free of expense to the City and if not used in testing or destroyed, will upon request of the Bidder, be returned within thirty (30) days of bid award at Bidder's expense. When required, the City may request full demonstrations of units prior to award. When such demonstrations are requested, the Bidder shall respond promptly and arrange a demonstration at a convenient location. Failure to provide samples or demonstrations as specified by the City may result in rejection of a bid.
- 3.10 LIFE CYCLE COSTING:** If so specified in the ITB, the City may elect to evaluate equipment proposed on the basis of total cost of ownership. In using Life Cycle Costing, factors such as the following may be considered: estimated useful life, maintenance costs, cost of supplies, labor intensity, energy usage, environmental impact, and residual value. The City reserves the right to use those or other applicable criteria, in its sole opinion that will most accurately estimate total cost of use and ownership.
- 3.11 BIDDING ITEMS WITH RECYCLED CONTENT:** In addressing environmental concerns, the City of Fort Lauderdale encourages Bidders to submit bids or alternate bids containing items with recycled content. When submitting bids containing items with recycled content, Bidder shall provide documentation adequate for the City to verify the recycled content. The City prefers packaging consisting of materials that are degradable or able to be recycled. When specifically stated in the ITB, the City may give preference to bids containing items manufactured with recycled material or packaging that is able to be recycled.
- 3.12 USE OF OTHER GOVERNMENTAL CONTRACTS:** The City reserves the right to reject any part or all of any bids received and utilize other available governmental contracts, if such action is in its best interest.
- 3.13 QUALIFICATIONS/INSPECTION:** Bids will only be considered from firms normally engaged in providing the types of commodities/services specified herein. The City reserves the right to inspect the Bidder's facilities, equipment, personnel, and organization at any time, or to take any other action necessary to determine Bidder's ability to perform. The Procurement Director reserves the right to reject bids where evidence or evaluation is determined to indicate inability to perform.
- 3.14 BID SURETY:** If Special Conditions require a bid security, it shall be submitted in the amount stated. A bid security can be in the form of a bid bond or cashier's check. Bid security will be returned to the unsuccessful bidders as soon as practicable after opening of bids. Bid security will be returned to the successful bidder after acceptance of the performance bond, if required; acceptance of insurance coverage, if required; and full execution of contract documents, if required; or conditions as stated in Special Conditions.
- 3.15 PUBLIC RECORDS/TRADE SECRETS/COPYRIGHT:** The Proposer's response to the RFP is a public record pursuant to Florida law, which is subject to disclosure by the City under the State of Florida Public Records Law, Florida Statutes Chapter 119.07 ("Public Records Law"). The City shall permit public access to all documents, papers, letters or other material submitted in connection with this RFP and the Contract to be executed for this RFP, subject to the provisions of Chapter 119.07 of the Florida Statutes.

Any language contained in the Proposer's response to the RFP purporting to require confidentiality of any portion of the Proposer's response to the RFP, except to the extent that certain information is in the City's opinion a Trade Secret pursuant to Florida law, shall be void. If a Proposer submits any documents or other information to the City which the Proposer claims is Trade Secret information and exempt from Florida Statutes Chapter 119.07 ("Public Records Laws"), the Proposer shall clearly designate that it is a Trade Secret and that it is asserting that the document or information is exempt. The Proposer must specifically identify the exemption being claimed under Florida Statutes 119.07. The City shall be the final arbiter of whether any information contained in the Proposer's response to the RFP constitutes a Trade Secret. The city's determination of whether an exemption applies shall be final, and the proposer agrees to defend, indemnify, and hold harmless the City and the City's officers, employees, and agents, against any loss or damages incurred by any person or entity as a result of the City's treatment of records as public records. In addition, the proposer agrees to defend, indemnify, and hold harmless the City and the City's officers, employees, and agents, against any loss or damages incurred by any person or entity as a result of the City's treatment of records as exempt from disclosure or confidential. Proposals bearing copyright symbols or otherwise purporting to be subject to copyright protection in full or in part may be rejected. The proposer authorizes the City to publish, copy, and reproduce any and all documents submitted to the City bearing copyright symbols or otherwise purporting to be subject to copyright protection.



EXCEPT FOR CLEARLY MARKED PORTIONS THAT ARE BONA FIDE TRADE SECRETS PURSUANT TO FLORIDA LAW, DO NOT MARK YOUR RESPONSE TO THE RFP AS PROPRIETARY OR CONFIDENTIAL. DO NOT MARK YOUR RESPONSE TO THE RFP OR ANY PART THEREOF AS COPYRIGHTED.

**3.16 PROHIBITION OF INTEREST:** No contract will be awarded to a bidding firm who has City elected officials, officers or employees affiliated with it, unless the bidding firm has fully complied with current Florida State Statutes and City Ordinances relating to this issue. Bidders must disclose any such affiliation. Failure to disclose any such affiliation will result in disqualification of the Bidder and removal of the Bidder from the City's bidder lists and prohibition from engaging in any business with the City.

**3.17 RESERVATIONS FOR AWARD AND REJECTION OF BIDS:** The City reserves the right to accept or reject any or all bids, part of bids, and to waive minor irregularities or variations to specifications contained in bids, and minor irregularities in the bidding process. The City also reserves the right to award the contract on a split order basis, lump sum basis, individual item basis, or such combination as shall best serve the interest of the City. The City reserves the right to make an award to the responsive and responsible bidder whose product or service meets the terms, conditions, and specifications of the ITB and whose bid is considered to best serve the City's interest. In determining the responsiveness of the offer and the responsibility of the Bidder, the following shall be considered when applicable: the ability, capacity and skill of the Bidder to perform as required; whether the Bidder can perform promptly, or within the time specified, without delay or interference; the character, integrity, reputation, judgment, experience and efficiency of the Bidder; the quality of past performance by the Bidder; the previous and existing compliance by the Bidder with related laws and ordinances; the sufficiency of the Bidder's financial resources; the availability, quality and adaptability of the Bidder's supplies or services to the required use; the ability of the Bidder to provide future maintenance, service or parts; the number and scope of conditions attached to the bid.

If the ITB provides for a contract trial period, the City reserves the right, in the event the selected bidder does not perform satisfactorily, to award a trial period to the next ranked bidder or to award a contract to the next ranked bidder, if that bidder has successfully provided services to the City in the past. This procedure to continue until a bidder is selected or the contract is re-bid, at the sole option of the City.

**3.18 LEGAL REQUIREMENTS:** Applicable provisions of all federal, state, county laws, and local ordinances, rules and regulations, shall govern development, submittal and evaluation of all bids received in response hereto and shall govern any and all claims and disputes which may arise between person(s) submitting a bid response hereto and the City by and through its officers, employees and authorized representatives, or any other person, natural or otherwise; and lack of knowledge by any bidder shall not constitute a cognizable defense against the legal effect thereof.

**3.19 BID PROTEST PROCEDURE:** Any proposer or bidder who is not recommended for award of a contract and who alleges a failure by the city to follow the city's procurement ordinance or any applicable law may protest to the chief procurement officer, by delivering a letter of protest to the director of finance within five (5) days after a notice of intent to award is posted on the city's web site at the following url: <https://www.fortlauderdale.gov/departments/finance/procurement-services/notices-of-intent-to-award>

The complete protest ordinance may be found on the city's web site at the following url:  
[https://library.municode.com/fl/fort\\_lauderdale/codes/code\\_of\\_ordinances?nodeid=coor\\_ch2ad\\_artvfi\\_div2pr\\_s2-182direpr](https://library.municode.com/fl/fort_lauderdale/codes/code_of_ordinances?nodeid=coor_ch2ad_artvfi_div2pr_s2-182direpr)

#### **PART IV BONDS AND INSURANCE**

**4.01 PERFORMANCE BOND:** If a performance bond is required in Special Conditions, the Contractor shall within fifteen (15) working days after notification of award, furnish to the City a Performance Bond, payable to the City of Fort Lauderdale, Florida, in the face amount specified in Special Conditions as surety for faithful performance under the terms and conditions of the contract. If the bond is on an annual coverage basis, renewal for each succeeding year shall be submitted to the City thirty (30) days prior to the termination date of the existing Performance Bond. The Performance Bond must be executed by a surety company of recognized standing, authorized to do business in the State of Florida and having a resident agent.

Acknowledgement and agreement is given by both parties that the amount herein set for the Performance Bond is not intended to be nor shall be deemed to be in the nature of liquidated damages nor is it intended to limit the liability of the Contractor to the City in the event of a material breach of this Agreement by the Contractor.

**4.02 INSURANCE:** The Contractor shall assume full responsibility and expense to obtain all necessary insurance as required by City or specified in Special Conditions.

The Contractor shall provide to the Procurement Services Division original certificates of coverage and receive notification of approval of those certificates by the City's Risk Manager prior to engaging in any activities under this contract. The Contractor's insurance is subject to the approval of the City's Risk Manager. The certificates must list the City as an ADDITIONAL INSURED for General Liability Insurance and shall have no less than thirty (30) days written notice of cancellation or material change. Further modification of the insurance requirements may be made at the sole discretion of the City's Risk Manager if circumstances change or adequate protection of the City is not presented. Bidder, by submitting the bid, agrees to abide by such modifications.

#### **PART V PURCHASE ORDER AND CONTRACT TERMS:**

**5.01 COMPLIANCE WITH SPECIFICATIONS, LATE DELIVERIES/PENALTIES:** Items offered may be tested for compliance with bid specifications. Items delivered which do not conform to bid specifications may be rejected and returned at Contractor's expense. Any violation resulting in contract termination for cause or delivery of items not conforming to specifications, or late delivery may also result in:

- Bidder's name being removed from the City's bidder's mailing list for a specified period and Bidder will not be recommended for any award during that period.
- All City Departments being advised to refrain from doing business with the Bidder.
- All other remedies in law or equity.

**5.02 ACCEPTANCE, CONDITION, AND PACKAGING:** The material delivered in response to ITB award shall remain the property of the Seller until a physical inspection is made and the material accepted to the satisfaction of the City. The material must comply fully with the terms of the ITB, be of the required quality, new, and the latest model. All containers shall be suitable for storage and shipment by common carrier, and all prices shall include standard commercial packaging. The City will not accept substitutes of any kind. Any substitutes or material not meeting specifications will be returned at the Bidder's expense. Payment will be made only after City receipt and acceptance of materials or services.

**5.03 SAFETY STANDARDS:** All manufactured items and fabricated assemblies shall comply with applicable requirements of the Occupation Safety and Health Act of 1970 as amended.

- 5.04 ASBESTOS STATEMENT:** All material supplied must be 100% asbestos free. Bidder, by virtue of bidding, certifies that if awarded any portion of the ITB the bidder will supply only material or equipment that is 100% asbestos free.
- 5.05 OTHER GOVERNMENTAL ENTITIES:** If the Bidder is awarded a contract as a result of this ITB, the bidder may, if the bidder has sufficient capacity or quantities available, provide to other governmental agencies, so requesting, the products or services awarded in accordance with the terms and conditions of the ITB and resulting contract. Prices shall be F.O.B. delivered to the requesting agency.
- 5.06 VERBAL INSTRUCTIONS PROCEDURE:** No negotiations, decisions, or actions shall be initiated or executed by the Contractor as a result of any discussions with any City employee. Only those communications which are in writing from an authorized City representative may be considered. Only written communications from Contractors, which are assigned by a person designated as authorized to bind the Contractor, will be recognized by the City as duly authorized expressions on behalf of Contractors.
- 5.07 INDEPENDENT CONTRACTOR:** The Contractor is an independent contractor under this Agreement. Personal services provided by the Proposer shall be by employees of the Contractor and subject to supervision by the Contractor, and not as officers, employees, or agents of the City. Personnel policies, tax responsibilities, social security, health insurance, employee benefits, procurement policies unless otherwise stated in this ITB, and other similar administrative procedures applicable to services rendered under this contract shall be those of the Contractor.
- 5.08 INDEMNITY/HOLD HARMLESS AGREEMENT:** Contractor shall protect and defend at Contractor's expense, counsel being subject to the City's approval, and indemnify and hold harmless the City and the City's officers, employees, volunteers, and agents from and against any and all losses, penalties, fines, damages, settlements, judgments, claims, costs, charges, expenses, or liabilities, including any award of attorney fees and any award of costs, in connection with or arising directly or indirectly out of any act or omission by the Contractor or by any officer, employee, agent, invitee, subcontractor, or sublicensee of the Contractor. Without limiting the foregoing, any and all such claims, suits, or other actions relating to personal injury, death, damage to property, defects in materials or workmanship, actual or alleged violations of any applicable statute, ordinance, administrative order, rule or regulation, or decree of any court shall be included in the indemnity hereunder.
- 5.09 TERMINATION FOR CAUSE:** If, through any cause, the Contractor shall fail to fulfill in a timely and proper manner its obligations under this Agreement, or if the Contractor shall violate any of the provisions of this Agreement, the City may upon written notice to the Contractor terminate the right of the Contractor to proceed under this Agreement, or with such part or parts of the Agreement as to which there has been default, and may hold the Contractor liable for any damages caused to the City by reason of such default and termination. In the event of such termination, any completed services performed by the Contractor under this Agreement shall, at the option of the City, become the City's property and the Contractor shall be entitled to receive equitable compensation for any work completed to the satisfaction of the City. The Contractor, however, shall not be relieved of liability to the City for damages sustained by the City by reason of any breach of the Agreement by the Contractor, and the City may withhold any payments to the Contractor for the purpose of setoff until such time as the amount of damages due to the City from the Contractor can be determined.
- 5.10 TERMINATION FOR CONVENIENCE:** The City reserves the right, in the City's best interest as determined by the City, to cancel any contract by giving written notice to the Contractor thirty (30) days prior to the effective date of such cancellation.
- 5.11 CANCELLATION FOR UNAPPROPRIATED FUNDS:** The obligation of the City for payment to a Contractor is limited to the availability of funds appropriated in a current fiscal period, and continuation of the contract into a subsequent fiscal period is subject to appropriation of funds, unless otherwise authorized by law.
- 5.12 RECORDS/AUDIT:** The Contractor shall maintain during the term of the contract all books of account, reports and records in accordance with generally accepted accounting practices and standards for records directly related to this contract. The Contractor agrees to make available to the City Auditor or the City Auditor's designee, during normal business hours and in Broward, Miami-Dade or Palm Beach Counties, all books of account, reports, and records relating to this contract. The Contractor shall retain all books of account, reports, and records relating to this contract for the duration of the contract and for three years after the final payment under this Agreement, until all pending audits, investigations or litigation matters relating to the contract are closed, or until expiration of the records retention period prescribed by Florida law or the records retention schedules adopted by the Division of Library and Information Services of the Florida Department of State, whichever is later.
- 5.13 PERMITS, TAXES, LICENSES:** The successful Contractor shall, at his/her/its own expense, obtain all necessary permits, pay all licenses, fees and taxes, required to comply with all local ordinances, state and federal laws, rules and regulations applicable to business to be carried out under this contract.
- 5.14 LAWS/ORDINANCES:** The Contractor shall observe and comply with all Federal, state, local and municipal laws, ordinances rules and regulations that would apply to this contract.
- NON-DISCRIMINATION:** The Contractor shall not, in any of its activities, including employment, discriminate against any individual on the basis of race, color, national origin, age, religion, creed, sex, disability, sexual orientation, gender, gender identity, gender expression, marital status, or any other protected classification as defined by applicable law.
1. The Contractor certifies and represents that the Contractor will comply with Section 2-187, Code of Ordinances of the City of Fort Lauderdale, Florida, (2019), as may be amended or revised, ("Section 2-187"), during the entire term of this Agreement.
  2. The failure of the Contractor to comply with Section 2-187 shall be deemed to be a material breach of this Agreement, entitling the City to pursue any remedy stated below or any remedy provided under applicable law.
  3. The City may terminate this Agreement if the Contractor fails to comply with Section 2-187.
  4. The City may retain all monies due or to become due until the Contractor complies with Section 2-187.
  5. The Contractor may be subject to debarment or suspension proceedings. Such proceedings will be consistent with the procedures in section 2-183 of the Code of Ordinances of the City of Fort Lauderdale, Florida.
- 5.15 UNUSUAL CIRCUMSTANCES:** If during a contract term where costs to the City are to remain firm or adjustments are restricted by a percentage or CPI cap, unusual circumstances that could not have been foreseen by either party of the contract occur, and those circumstances significantly affect the Contractor's cost in providing the required prior items or services, then the Contractor may request adjustments to the costs to the City to reflect the changed circumstances. The circumstances must be beyond the control of the Contractor, and the requested adjustments must be fully documented. The City may, after examination, refuse to accept the adjusted costs if they are not properly documented, increases are considered to be excessive, or decreases are considered to be insufficient. In the event the City does not wish to accept the adjusted costs and the matter cannot be resolved to the satisfaction of the City, the City will reserve the following options:

1. The contract can be canceled by the City upon giving thirty (30) days written notice to the Contractor with no penalty to the City or Contractor. The Contractor shall fill all City requirements submitted to the Contractor until the termination date contained in the notice.
2. The City requires the Contractor to continue to provide the items and services at the firm fixed (non-adjusted) cost until the termination of the contract term then in effect.
3. If the City, in its interest and in its sole opinion, determines that the Contractor in a capricious manner attempted to use this section of the contract to relieve Contractor of a legitimate obligation under the contract, and no unusual circumstances had occurred, the City reserves the right to take any and all action under law or equity. Such action shall include, but not be limited to, declaring the Contractor in default and disqualifying Contractor from receiving any business from the City for a stated period of time.

If the City does agree to adjusted costs, these adjusted costs shall not be invoiced to the City until the Contractor receives notice in writing signed by a person authorized to bind the City in such matters.

- 5.16 ELIGIBILITY:** If applicable, the Contractor must first register with the Florida Department of State in accordance with Florida Statutes, prior to entering into a contract with the City.
- 5.17 PATENTS AND ROYALTIES:** The Contractor, without exception, shall defend, indemnify, and hold harmless the City and the City's employees, officers, employees, volunteers, and agents from and against liability of any nature and kind, including cost and expenses for or on account of any copyrighted, patented or un-patented invention, process, or article manufactured or used in the performance of the contract, including their use by the City. If the Contractor uses any design, device, or materials covered by letters, patent or copyright, it is mutually agreed and understood without exception that the bid prices shall include any and all royalties or costs arising from the use of such design, device, or materials in any way involved in the work.
- 5.18 ASSIGNMENT:** Contractor shall not transfer or assign the performance required by this ITB without the prior written consent of the City. Any award issued pursuant to this ITB, and the monies, which may become due hereunder, are not assignable except with the prior written approval of the City Commission or the City Manager or City Manager's designee, depending on original award approval.
- 5.19 GOVERNING LAW; VENUE:** The Contract shall be governed by and construed in accordance with the laws of the State of Florida. Venue for any lawsuit by either party against the other party or otherwise arising out of the Contract, and for any other legal proceeding, shall be in the courts in and for Broward County, Florida, or in the event of federal jurisdiction, in the Southern District of Florida.
- 5.20 PUBLIC RECORDS:**

**IF THE CONTRACTOR HAS QUESTIONS REGARDING THE APPLICATION OF CHAPTER 119, FLORIDA STATUTES, TO THE CONTRACTOR'S DUTY TO PROVIDE PUBLIC RECORDS RELATING TO THIS CONTRACT, CONTACT THE CUSTODIAN OF PUBLIC RECORDS AT [PRRCONTRACT@FORTLAUDERDALE.GOV](mailto:PRRCONTRACT@FORTLAUDERDALE.GOV), 954-828-5002, CITY CLERK'S OFFICE, 100 N. ANDREWS AVENUE, FORT LAUDERDALE, FLORIDA 33301.**

Contractor shall comply with public records laws, and Contractor shall:

1. Keep and maintain public records required by the City to perform the service.
2. Upon request from the City's custodian of public records, provide the City with a copy of the requested records or allow the records to be inspected or copied within a reasonable time at a cost that does not exceed the cost provided in Chapter 119, Florida Statutes (2019), as may be amended or revised, or as otherwise provided by law.
3. Ensure that public records that are exempt or confidential and exempt from public records disclosure requirements are not disclosed except as authorized by law for the duration of the contract term and following completion of the contract if the Contractor does not transfer the records to the City.
4. Upon completion of the Contract, transfer, at no cost, to the City all public records in possession of the Contractor or keep and maintain public records required by the City to perform the service. If the Contractor transfers all public records to the City upon completion of the Contract, the Contractor shall destroy any duplicate public records that are exempt or confidential and exempt from public records disclosure requirements. If the Contractor keeps and maintains public records upon completion of the Contract, the Contractor shall meet all applicable requirements for retaining public records. All records stored electronically must be provided to the City, upon request from the City's custodian of public records, in a format that is compatible with the information technology systems of the City.

**NON-COLLUSION STATEMENT**

By signing this offer, the vendor/contractor certifies that this offer is made independently and *free* from collusion. Vendor shall disclose below any City of Fort Lauderdale, FL officer or employee, or any relative of any such officer or employee who is an officer or director of, or has a material interest in, the vendor's business, who is in a position to influence this procurement.

Any City of Fort Lauderdale, FL officer or employee who has any input into the writing of specifications or requirements, solicitation of offers, decision to award, evaluation of offers, or any other activity pertinent to this procurement is presumed, for purposes hereof, to be in a position to influence this procurement.

For purposes hereof, a person has a material interest if they directly or indirectly own more than 5 percent of the total assets or capital stock of any business entity, or if they otherwise stand to personally gain if the contract is awarded to this vendor.

In accordance with City of Fort Lauderdale, FL Policy and Standards Manual, 6.10.8.3,

3.3. City employees may not contract with the City through any corporation or business entity in which they or their immediate family members hold a controlling financial interest (e.g., ownership of five (5) percent or more).

3.4. Immediate family members (spouse, parents, and children) are also prohibited from contracting with the City subject to the same general rules.

**Failure of a vendor to disclose any relationship described herein shall be reason for debarment in accordance with the provisions of the City Procurement Code.**

**NAME**

**RELATIONSHIPS**

|  |  |
|--|--|
|  |  |
|  |  |
|  |  |
|  |  |

**In the event the vendor does not indicate any names, the City shall interpret this to mean that the vendor has indicated that no such relationships exist.**

\_\_\_\_\_  
Authorized Signature

\_\_\_\_\_  
Title

\_\_\_\_\_  
Name (Printed)

\_\_\_\_\_  
Date

**CONTRACTOR'S CERTIFICATE OF COMPLIANCE WITH  
NON-DISCRIMINATION PROVISIONS OF THE CONTRACT**

The completed and signed form should be returned with the Contractor's submittal. If not provided with submittal, the Contractor must submit within three business days of City's request. Contractor may be deemed non-responsive for failure to fully comply within stated timeframes.

Pursuant to City Ordinance Sec. 2-17(a)(i)(ii), bidders must certify compliance with the Non-Discrimination provision of the ordinance.

- A. Contractors doing business with the City shall not discriminate against their employees based on the employee's race, color, religion, gender (including identity or expression), marital status, sexual orientation, national origin, age, disability, or any other protected classification as defined by applicable law.

Contracts. Every Contract exceeding \$100,000, or otherwise exempt from this section shall contain language that obligates the Contractor to comply with the applicable provisions of this section.

The Contract shall include provisions for the following:

- (i) The Contractor certifies and represents that it will comply with this section during the entire term of the contract.
- (ii) The failure of the Contractor to comply with this section shall be deemed to be a material breach of the contract, entitling the City to pursue any remedy stated below or any remedy provided under applicable law.

\_\_\_\_\_  
Authorized Signature

\_\_\_\_\_  
Print Name and Title

\_\_\_\_\_  
Date

**CONTRACT PAYMENT METHOD**

The City of Fort Lauderdale has implemented a Procurement Card (P-Card) program which changes how payments are remitted to its vendors. The City has transitioned from traditional paper checks to credit card payments via MasterCard or Visa as part of this program.

This allows you as a vendor of the City of Fort Lauderdale to receive your payments fast and safely. No more waiting for checks to be printed and mailed.

In accordance with the contract, payments on this contract will be made utilizing the City's P-Card (MasterCard or Visa). Accordingly, bidders must presently have the ability to accept the credit card or take whatever steps necessary to implement acceptance of a card before the start of the contract term, or contract award by the City.

All costs associated with the Contractor's participation in this purchasing program shall be borne by the Contractor. The City reserves the right to revise this program as necessary.

By signing below, you agree with these terms.

Please indicate which credit card payment you prefer:

\_\_\_\_ MasterCard

\_\_\_\_ Visa

\_\_\_\_\_  
Company Name

\_\_\_\_\_  
Name (Printed)

\_\_\_\_\_  
Signature

\_\_\_\_\_  
Title

\_\_\_\_\_  
Date

## LOCAL BUSINESS PREFERENCE

Section 2-199.2, Code of Ordinances of the City of Fort Lauderdale, (Ordinance No. C-12-04), provides for a local business preference.

In order to be considered for a local business preference, a bidder must include the Local Business Preference Certification Statement of this ITB, as applicable to the local business preference class claimed **at the time of bid submittal**.

Upon formal request of the City, based on the application of a Local Business Preference the Bidder shall, within ten (10) calendar days, submit the following documentation to the Local Business Preference Class claimed:

- A) Copy of City of Fort Lauderdale current year business tax receipt, **or** Broward County current year business tax receipt, **and**
- B) List of the names of all employees of the bidder and evidence of employees' residence within the geographic bounds of the City of Fort Lauderdale or Broward County, as the case may be, such as current Florida driver license, residential utility bill (water, electric, telephone, cable television), or other type of similar documentation acceptable to the City.

Failure to comply at time of bid submittal shall result in the bidder being found ineligible for the local business preference.

**THE COMPLETE LOCAL BUSINESS PREFERENCE ORDINANCE MAY BE FOUND ON THE CITY'S WEB SITE AT THE FOLLOWING LINK:**

[https://library.municode.com/fl/fort lauderdale/codes/code of ordinances?nodeId=COOR CH2 AD ARTVFI DIV2PR S2-186LOBUPR](https://library.municode.com/fl/fort%20lauderdale/codes/code%20of%20ordinances?nodeId=COOR_CH2_AD_ARTVFI_DIV2PR_S2-186LOBUPR)

**Definitions:** The term "Business" shall mean a person, firm, corporation or other business entity which is duly licensed and authorized to engage in a particular work in the State of Florida. Business shall be broken down into four (4) types of classes:

1. Class A Business – shall mean any Business that has established and agrees to maintain a permanent place of business located in a non-residential zone and staffed with full-time employees within the limits of the City **and** shall maintain a staffing level of the prime contractor for the proposed work of at least fifty percent (50%) who are residents of the City.
2. Class B Business - shall mean any Business that has established and agrees to maintain a permanent place of business located in a non-residential zone and staffed with full-time employees within the limits of the City **or** shall maintain a staffing level of the prime contractor for the proposed work of at least fifty percent (50%) who are residents of the City.
3. Class C Business - shall mean any Business that has established and agrees to maintain a permanent place of business located in a non-residential zone **and** staffed with full-time employees within the limits of Broward County.
4. Class D Business – shall mean any Business that does not qualify as either a Class A, Class B, or Class C business.

**LOCAL BUSINESS PREFERENCE CERTIFICATION STATEMENT**

The Business identified below certifies that it qualifies for the local business price preference classification as indicated herein, and further certifies and agrees that it will re-affirm its local preference classification annually no later than thirty (30) calendar days prior to the anniversary of the date of a contract awarded pursuant to this ITB. Violation of the foregoing provision may result in contract termination.

(1) \_\_\_\_\_ is a **Class A** Business as defined in City of Fort Lauderdale Ordinance No. C-17-26, Sec.2-186. A copy of the City of Fort Lauderdale current year Business Tax Receipt **and** a complete list of full-time employees and evidence of their addresses shall be provided within 10 calendar days of a formal request by the City.

Business Name

(2) \_\_\_\_\_ is a **Class B** Business as defined in the City of Fort Lauderdale Ordinance No. C-17-26, Sec.2-186. A copy of the Business Tax Receipt **or** a complete list of full-time employees and evidence of their addresses shall be provided within 10 calendar days of a formal request by the City.

Business Name

(3) \_\_\_\_\_ is a **Class C** Business as defined in the City of Fort Lauderdale Ordinance No. C-17-26, Sec.2-186. A copy of the Broward County Business Tax Receipt shall be provided within 10 calendar days of a formal request by the City.

Business Name

(4) \_\_\_\_\_ requests a **Conditional Class A** classification as defined in the City of Fort Lauderdale Ordinance No. C-17-26, Sec.2-186. Written certification of intent shall be provided within 10 calendar days of a formal request by the City.

Business Name

(5) \_\_\_\_\_ requests a **Conditional Class B** classification as defined in the City of Fort Lauderdale Ordinance No. C-17-26, Sec.2-186. Written certification of intent shall be provided within 10 calendar days of a formal request by the City.

Business Name

(6) \_\_\_\_\_ is considered a **Class D** Business as defined in the City of Fort Lauderdale Ordinance No. C-17-26, Sec.2-186 and does not qualify for Local Preference consideration.

Business Name

BIDDER'S COMPANY: \_\_\_\_\_

AUTHORIZED COMPANY PERSON: \_\_\_\_\_  
PRINT NAME SIGNATURE DATE



## **DISADVANTAGED BUSINESS ENTERPRISE (DBE) PREFERENCE**

Section 2-185, Code of Ordinances of the City of Fort Lauderdale, provides for a disadvantaged business preference.

In order to be considered for a DBE Preference, a bidder must include a certification from a government agency, as applicable to the DBE Preference class claimed **at the time of bid submittal**.

Upon formal request of the City, based on the application of a DBE Preference the Bidder shall, within ten (10) calendar days, submit the following documentation to the DBE Class claimed:

A) Copy of City of Fort Lauderdale current year business tax receipt, **or** Broward County current year business tax receipt, **or** State of Florida active registration **and/or**

B) List of the names of all employees of the bidder and evidence of employees' residence within the geographic bounds of the City of Fort Lauderdale or Broward County, as the case may be, such as current Florida driver license, residential utility bill (water, electric, telephone, cable television), or other type of similar documentation acceptable to the City.

Failure to comply at time of bid submittal shall result in the bidder being found ineligible for the disadvantaged business preference.

**THE COMPLETE DBE PREFERENCE ORDINANCE MAY BE FOUND ON THE CITY'S WEB SITE AT THE FOLLOWING LINK: <https://www.fortlauderdale.gov/home/showpublisheddocument?id=56883>**

### **Definitions**

- a. The term "disadvantaged class 1 enterprise" shall mean any disadvantaged business enterprise that has established and agrees to maintain a permanent place of business located in a non-residential zone, staffed with full-time employees within the limits of the city, and provides supporting documentation of its City of Fort Lauderdale business tax and disadvantaged certification as established in the City's Procurement Manual.
- b. The term "disadvantaged class 2 enterprise" shall mean any disadvantaged business enterprise that has established and agrees to maintain a permanent place of business within the limits of the city with a full-time employees and provides supporting documentation of its City of Fort Lauderdale business tax and disadvantaged certification as established in the City's Procurement Manual.
- c. The term "disadvantaged class 3 enterprise" shall mean any disadvantaged business enterprise that has established and agrees to maintain a permanent place of business located in a non-residential zone, staffed with full-time employees within the limits of the Tri-County area and provides supporting documentation of its City of Fort Lauderdale business tax and disadvantaged certification as established in the City's Procurement Manual.
- d. The term "disadvantaged class 4 enterprise" shall mean any disadvantaged business enterprise that does not qualify as a Class A, Class B, or Class C business, but is located in the State of Florida and provides supporting documentation of its disadvantaged certification as established in the City's Procurement Manual.

**DISADVANTAGED BUSINESS ENTERPRISE CERTIFICATION STATEMENT**

The Business identified below certifies that it qualifies for the disadvantaged business enterprise price preference classification as indicated herein, and further certifies and agrees that it will re-affirm its preference classification annually no later than thirty (30) calendar days prior to the anniversary of the date of a contract awarded pursuant to this solicitation. Violation of the foregoing provision may result in contract termination.

(1) is a disadvantaged class 1 enterprise as defined in the City of Fort Lauderdale Ordinance Section 2-185 disadvantaged business enterprise that has established and agrees to maintain a permanent place of business located in a non-residential zone, staffed with full-time employees within the limits of the city, and provides supporting documentation of its City of Fort Lauderdale business tax and disadvantaged certification as established in the City's Procurement Manual.

\_\_\_\_\_  
Business Name

(2) is a disadvantaged class 2 enterprise as defined in the City of Fort Lauderdale Ordinance Section 2-185 disadvantaged business enterprise that has established and agrees to maintain a permanent place of business within the limits of the city with a full-time employee(s) and provides supporting documentation of its City of Fort Lauderdale business tax and disadvantaged certification as established in the City's Procurement Manual.

\_\_\_\_\_  
Business Name

(3) is a disadvantaged class 3 enterprise as defined in the City of Fort Lauderdale Ordinance Section 2-185 disadvantaged business enterprise that has established and agrees to maintain a permanent place of business located in a non-residential zone, staffed with full-time employees within the limits of the Tri-County area and provides supporting documentation of its City of Fort Lauderdale business tax and disadvantaged certification as established in the City's Procurement Manual.

\_\_\_\_\_  
Business Name

(4) is a disadvantaged class 4 enterprise as defined in the City of Fort Lauderdale Ordinance Section 2-185 disadvantaged business enterprise that does not qualify as a Class A, Class B, or Class C business, but is located in the State of Florida and provides supporting documentation of its disadvantaged certification as established in the City's Procurement Manual.

\_\_\_\_\_  
Business Name

(5) is not considered a Disadvantaged Enterprise Business as defined in the City of Fort Lauderdale Ordinance Sec.2-185 and does not qualify for DBE Preference consideration.

\_\_\_\_\_  
Business Name

BIDDER'S COMPANY: \_\_\_\_\_

AUTHORIZED COMPANY PERSON: \_\_\_\_\_  
PRINT NAME SIGNATURE DATE

Solicitation/Bid /Contract No: \_\_\_\_\_

Project Description:

Contractor/Proposer/Bidder acknowledges and agrees to utilize the U.S. Department of Homeland Security's E-Verify System to verify the employment eligibility of,

- A. all persons employed by Contractor/Proposer/Bidder to perform employment duties within Florida during the term of the Contract, and,
- B. all persons (including subcontractors/vendors) assigned by Contractor/Proposer/Bidder to perform work pursuant to the Contract.

The Contractor/Proposer/Bidder acknowledges and agrees that use of the U.S. Department of Homeland Security's E-Verify System during the term of the Contract is a condition of the Contract.

Contractor/Proposer/ Bidder Company Name: \_\_\_\_\_

Authorized Company Person's Signature: \_\_\_\_\_

Authorized Company Person's Title: \_\_\_\_\_

Date: \_\_\_\_\_

**REFERENCES**

A minimum of three (3) references shall be provided. It is the responsibility of the Bidder/ Proposer to ensure that the information provided is accurate and current. The City may find your firm non-responsive for providing wrong and or outdated information. Additional references may be provided on a separate page.

Company Name: \_\_\_\_\_  
Address: \_\_\_\_\_  
Contact Person: \_\_\_\_\_  
Title: \_\_\_\_\_  
Phone #: \_\_\_\_\_  
Email: \_\_\_\_\_  
Contract Value: \_\_\_\_\_  
Year(s): \_\_\_\_\_  
Description: \_\_\_\_\_  
\_\_\_\_\_  
\_\_\_\_\_

Company Name: \_\_\_\_\_  
Address: \_\_\_\_\_  
Contact Person: \_\_\_\_\_  
Title: \_\_\_\_\_  
Phone #: \_\_\_\_\_  
Email: \_\_\_\_\_  
Contract Value: \_\_\_\_\_  
Year(s): \_\_\_\_\_  
Description: \_\_\_\_\_  
\_\_\_\_\_  
\_\_\_\_\_

Company Name: \_\_\_\_\_  
Address: \_\_\_\_\_  
Contact Person: \_\_\_\_\_  
Title: \_\_\_\_\_  
Phone #: \_\_\_\_\_  
Email: \_\_\_\_\_  
Contract Value: \_\_\_\_\_  
Year(s): \_\_\_\_\_  
Description: \_\_\_\_\_  
\_\_\_\_\_  
\_\_\_\_\_

**CITY OF FORT LAUDERDALE BID/PROPOSAL CERTIFICATION**

**Please Note:** It is the sole responsibility of the bidder/proposer to ensure that their response is submitted electronically through the [City's on-line strategic sourcing platform](#) prior to the bid opening date and time listed. Paper bid submittals will not be accepted. All fields below must be completed. If the field does not apply to you, please note N/A in that field.

If you are a foreign corporation, you may be required to obtain a certificate of authority from the department of state, in accordance with Florida Statute §607.1501 (visit <http://www.dos.state.fl.us/>).

Company: (Legal Registration) \_\_\_\_\_ EIN (Optional): \_\_\_\_\_

Address: \_\_\_\_\_

City: \_\_\_\_\_ State: \_\_\_\_\_ Zip: \_\_\_\_\_

Telephone No.: \_\_\_\_\_ FAX No.: \_\_\_\_\_ Email: \_\_\_\_\_

Delivery: Calendar days after receipt of Purchase Order (**section 1.02 of General Conditions**): \_\_\_\_\_

Total Bid Discount (**section 1.05 of General Conditions**): \_\_\_\_\_

Check box if your firm qualifies for DBE (**section 1.09 of General Conditions**):

**ADDENDUM ACKNOWLEDGEMENT** - Proposer acknowledges that the following addenda have been received and are included in the proposal:

| Addendum No. | Date Issued | Addendum No. | Date Issued | Addendum No. | Date Issued | Addendum No. | Date Issued |
|--------------|-------------|--------------|-------------|--------------|-------------|--------------|-------------|
| _____        | _____       | _____        | _____       | _____        | _____       | _____        | _____       |
| _____        | _____       | _____        | _____       | _____        | _____       | _____        | _____       |
| _____        | _____       | _____        | _____       | _____        | _____       | _____        | _____       |
| _____        | _____       | _____        | _____       | _____        | _____       | _____        | _____       |

**VARIANCES:** If you take exception or have variances to any term, condition, specification, scope of service, or requirement in this competitive solicitation you must specify such exception or variance in the space provided below or reference in the space provided below all variances contained on other pages within your response. Additional pages may be attached if necessary. No exceptions or variances will be deemed to be part of the response submitted unless such is listed and contained in the space provided below. The City does not, by virtue of submitting a variance, necessarily accept any variances. If no statement is contained in the below space, it is hereby implied that your response is in full compliance with this competitive solicitation. If you do not have variances, simply mark N/A.

The below signatory hereby agrees to furnish the following article(s) or services at the price(s) and terms stated subject to all instructions, conditions, specifications addenda, legal advertisement, and conditions contained in the bid/proposal. I have read all attachments including the specifications and fully understand what is required. By submitting this signed proposal, I will accept a contract if approved by the City and such acceptance covers all terms, conditions, and specifications of this bid/proposal. The below signatory also hereby agrees, by virtue of submitting or attempting to submit a response, that in no event shall the City's liability for respondent's direct, indirect, incidental, consequential, special or exemplary damages, expenses, or lost profits arising out of this competitive solicitation process, including but not limited to public advertisement, bid conferences, site visits, evaluations, oral presentations, or award proceedings exceed the amount of Five Hundred Dollars (\$500.00). This limitation shall not apply to claims arising under any provision of indemnification or the City's protest ordinance contained in this competitive solicitation.

Submitted by:

\_\_\_\_\_  
Name (printed)

\_\_\_\_\_  
Signature

\_\_\_\_\_  
Date

\_\_\_\_\_  
Title

**QUESTIONNAIRE**

**Bidder certifies the truth and accuracy of all statements and the answers contained herein.  
Failure to answer each question could result in the disqualification of your bid.**

Company Name: \_\_\_\_\_

Contact Name: \_\_\_\_\_

Contact Phone: \_\_\_\_\_

Contact Email: \_\_\_\_\_

1. Number of years experience you have had in providing these services.

\_\_\_\_\_

2. Number of employees available for this Contract.

\_\_\_\_\_

3. Have you ever failed to complete work awarded to you? If so, where and why?

Yes\_\_\_\_ No\_\_\_\_

\_\_\_\_\_  
\_\_\_\_\_

4. Have you included proof of insurance, including General Liability, Auto Liability and Worker's Compensation with your bid submittal?

General Liability Yes\_\_\_\_ No\_\_\_\_

Auto Liability Yes\_\_\_\_ No\_\_\_\_

Worker's Comp Yes\_\_\_\_ No\_\_\_\_

5. Describe the last 3 projects of this nature that you completed.

\_\_\_\_\_  
\_\_\_\_\_  
\_\_\_\_\_

The bidder understands that the information contained in these bid pages is to be relied upon by the City in awarding the proposed contract, and such information is warranted by the bidder to be true. The bidder agrees to furnish such additional information, prior to acceptance of any contract relating to the qualifications of the bidder, as may be required by the City.

Please review the questionnaire to make sure all questions have been answered. Attach additional sheets if necessary. **Failure to answer each question could result in the disqualification of your bid.**