

Page 1 of 78 p. 708

LOUVERS

| | | | | | | FREE A REA | AIRFLOW | FACE | PRESSURE | |
|------------|-------------------------------|------------------------|-----------|----------------|-------|------------|---------|----------|----------|--|
| MARK | MANUFACTURER | SERVES | MODEL | SYSTEM | SIZE | (SQ FT) | (CFM) | VELOCITY | DROP (in | |
| | | | | | | (0011) | | (FPM) | WC) | |
| L-1 | GREENHECK | A HU-9 OUTSIDE A IR | ESD-635D | INTAKE | 28X20 | 1.7 | 760 | 500 | 0.03 | |
| L-2 | GREENHECK | AHU-13 OUTSIDE AIR | ESD-635DE | INTA KE | 16X16 | 0.6 | 240 | 500 | 0.03 | |
| L-3 | GREENHECK | A HU-5 OUTSIDE A IR | ESD-635DE | INTAKE | 36X36 | 4.8 | 2,150 | 500 | 0.03 | |
| NOTES: | | | | | | | | | | |
| 1. LOUVERS | LOUVERS TO BE HURRICANE RATED | | | | | | | | | |
| | | N DA IN DESISTA NELA N | | | | 550 | | | | |

LOUVERS TO BE WIND-DRIVEN RAIN RESISTANT AND SHALL COMPLY WITH AMCA 550.

| | ELE | CTRIC UNIT | HEATER | SCHE | DULE | | | |
|-------|---------|-------------------|-----------|------|---------|-------|---------|---|
| MARK | SERVING | AIRFLOW (CFM) | DUCT SIZE | КW | VOLTAGE | PHASE | CONTROL | ſ |
| DH-1 | AHU-2 | 2000 | 26X12 | 18 | 480 | 3 | SCR | |
| DH-2 | AHU-2 | 1900 | 26X12 | 18 | 480 | 3 | SCR | |
| DH-3 | AHU-3 | 1800 | 24X12 | 18 | 480 | 3 | SCR | |
| DH-4 | AHU-3 | 1800 | 24X12 | 18 | 480 | 3 | SCR | |
| DH-6 | A HU-6 | 1000 | 18X12 | 10 | 480 | 3 | 3 | ┢ |
| DH-7 | A HU-8 | 2200 | 28X12 | 22 | 480 | 3 | SCR | T |
| DH-8 | A HU-4 | 2600 | 36X12 | 26 | 480 | 3 | SCR | |
| DH-9 | AHU-5 | 2150 | 24X12 | 15 | 480 | 3 | SCR | |
| DH-10 | AHU-9 | 3810 | 66X12 | 21 | 480 | 3 | SCR | |
| DH-11 | AHU-10 | 900 | 14X12 | 10 | 480 | 3 | 3 | |
| DH-12 | AHU-11 | 5700 | 60X12 | 15 | 480 | 3 | SCR | |
| DH-13 | AHU-12 | 1440 | 20X12 | 6 | 480 | 3 | 3 | |
| DH-14 | AHU-13 | 630 | 10X8 | 2.5 | 208 | 1 | 1 | |
| | | | | | | | | |

NOTES: 1. UL LISTED

2. EQUIPPED WITH THERMOSTAT CONTROL

3. EQUIPED WITH THERMAL OV ERLOAD PROTECTION


4. EQUIPED WITH DISCONNECT SWITCH

5. SURFACE MOUNTING STYLE CABNET

6. SELECTION IS BASED ON INDEECO

| | | | | | | | | | | | | Ν | ODU | ILAR | AIR | ΗΑΝ | NDLI | NG U | INIT | SC | HED | ULE | | | | | | | | | | | | | | | |
|--------|----------------|-------------------------------|-----------|------------|----------------------|----------------|----------|------------------|-------------------------|---------------------|----------------|--------------|-----------|-----------|-----------|----------|-----------|-----------|-------|------------|-----------|------------|------------|----------|---------------|------------------------------------|---------|----------|---------------|--------------|-------------------|--------------|-----------|-------------|------------|----------------|---------------|
| | | | | | | | | | | | | | | | | | | | | | С | HILLED | WATER CO | JIL | | | | | MIXING | вох | | | | | | | |
| MARK | TYPE | SPACE SERVED | | | | | | | | FAN | | | MOTOR | EL | ECTRICA | - | CAPAC | ITY (MBH) | | AIR PRC | OPERTIES | 6 | WATE | R PROPE | RTIES | | | | DA | MPER | MANUFACTURER | UNIT SIZE | | | H WDTH | I HEIGHT | T REMARKS |
| | | | VFD | AIR (CFM) | OUTSIDE AIR (CFM) | BI-POLA ION | | IT ESP (IN.WG | .) FAN SIZE (INCHES) | FAN TYPE | NO. OF FANS | RPM H | P RPM | VOLTAG | E PHASE | MCA | TOTAL | SENSIBLI | E EAT | (°F) WB | LAT DB | (°F) WB | EWT (°F) | LWT (°F) | FLOW (GPM) | FLUID PRESSURE DROP (FT OF H20) | ROWS | MERV | RETURN AIR | | | | (LBS) | (in.) | (in.) | (in.) | |
| AHU-1 | VERTICAL | 2ND FLOOR VAV BOXES | YES | 8,580 | 820 | YES | NO | 2.5 | 18 | AF | 1 | 2289 1 | .0 1800 | 480 | 3 | 26.47 | 326.75 | 258.87 | 79.4 | 66.0 | 52.0 | 51.8 | 42 | 60 | 40.17 | 4.67 | 8 | 13 | YES | YES | TRANE | CSAA017 | 2,004 | 50.00 | 72.00 | 98.00 | 1 THRU 15 |
| AHU-2 | HORIZONTAL RTU | WASTE WATER LAB | YES | 3,900 | 3,900 | NO | YES | 2.5 | 12 | AF | 1 | 3246 7 | 5 1800 | 480 | 3 | 13.97 | 370.05 | 169.94 | 93.0 | 75.0 | 52.0 | 51.9 | 42 | 60 | 40.98 | 15.35 | 8 | 13 | NO | YES | TRANE | CSAA010 | 2,235 | 150.50 | 0 61.50 | 43.60 | 1 THRU 12, 16 |
| AHU-3 | HORIZONTAL RTU | INSTRUMENT LAB | YES | 4,600 | 4,600 | NO | YES | 2.5 | 15 | AF | 1 | 2,234 7 | 5 1800 | 480 | 3 | 13.97 | 436.48 | 200.45 | 91.0 | 79.0 | 52.0 | 51.9 | 42 | 60 | 48.34 | 17.74 | 8 | 13 | NO | YES | TRANE | CSAA012 | 2,391 | 143.10 | 0 66.50 | 47.70 | 1 THRU 12, 16 |
| AHU-4 | | WATER LAB | YES | , | 2,600 | NO | YES | 2.5 | 12 | AF | 1 | 2548 5 | 0 1800 | 480 | 3 | 10.47 | 246.65 | 113.30 | 93.0 | 75.0 | 52.0 | 51.9 | 42 | 60 | 27.31 | 6.40 | 8 | 13 | NO | YES | TRANE | CSAA008 | 1967 | 154.50 | 50.50 | 43.60 | 1 THRU 12, 16 |
| AHU-5 | VERTICAL | 3RD FLOOR COMMON SPACES | YES | , | 2,150 | YES | NO | 2.5 | 9 | BC | 1 | 4038 5 | 0 1800 | 480 | 3 | 10.47 | 126.48 | 80.54 | 85.9 | 70.6 | 52.0 | | 42 | 60 | 14.01 | 5.09 | 8 | 13 | NO | YES | TRANE | CSAA006 | 1082 | 48.00 | 44.00 | 74.00 | 1 THRU 15 |
| AHU-6 | HORIZONTAL RTU | 3RD FLOOR BURN ROOM | YES | , | 1,000 | NO | YES | 2.5 | 9 | DD PLENUM | 1 | 2,977 1 | 5 1800 | 480 | 3 | 3.53 | 94.89 | 43.58 | 93.0 | 75.0 | 52.0 | 51.9 | 42 | 60 | 10.51 | 9.29 | 8 | 13 | NO | YES | TRANE | CSAA003 | 1,352 | 150.40 | 31.50 | 34.70 | 1 THRU 12, 16 |
| AHU-8 | | BIOLOGY LAB | YES | , | 2,200 | NO | YES | 2.5 | 9 | BC | 1 | 3,969 3 | 0 1800 | 480 | 3 | 6.22 | 208.11 | 95.87 | 93.0 | 75.0 | 52.0 | 51.9 | 42 | 60 | 23.05 | 5.31 | 8 | 13 | NO | YES | TRANE | CSAA006 | 1,726 | 149.50 | 0 44.00 | 41.10 | 1 THRU 12, 16 |
| AHU-9 | VERTICAL | 1ST FLOOR EAST WING | YES | , | 760 | YES | NO | 1.5 | 12 | FC | 1 | 1,587 5 | 0 1600 | 480 | 3 | 9.5 | 175.22 | 121.35 | 80.9 | 67.1 | 52.0 | 51.9 | 42 | 54.45 | 28.05 | 4.47 | 8 | 13 | YES | YES | TRANE | UCCA | 673 | 33.44 | 51.00 | 65.06 | 1 THRU 15 |
| AHU-10 | | 1ST FLOOR LOCKERS | YES | | 900 | NO | YES | 2.5 | 11 | BELT-DRIVE PLENUN | 1 1 | 2,636 1 | 5 1800 | 480 | 3 | 3.53 | 52.94 | 33.72 | 93.0 | 75.0 | 52.0 | 51.9 | 42 | 60 | 5.86 | 4.01 | 8 | 13 | NO | YES | TRANE | CSAA006 | 1038 | 88.00 | | 32.50 | (|
| AHU-11 | | 1ST FLOOR LOBBY | YES | 5,700 | 570 | YES | YES | 2.5 | 15 | AF | 1 | 2,327 1 | .0 1800 | 480 | 3 | 17.72 | 307.21 | 201.97 | 84.1 | 69.3 | 52.0 | 51.9 | 42 | 60 | 34.02 | 4.58 | 8 | 13 | YES | YES | TRANE | CSAA012 | 1,701 | 69.00 | 66.50 | 86.50 | 1 THRU 16 |
| AHU-12 | | 1ST FLOOR OFFICES | YES | 1,440 | 250 | YES | YES | 2.5 | 11 | BELT-DRIVE PLENUN | 1 1 | 3262 2 | 0 1800 | 480 | 3 | 4.47 | 65.05 | 45.38 | 80.6 | 66.9 | 52.0 | 51.9 | 42 | 60 | 7.20 | 4.94 | 8 | 13 | YES | YES | TRANE | CSAA006 | 1047 | 88.00 | 31.50 | 32.50 | 1 THRU 16 |
| AHU-13 | VERTICAL | 2ND FLOOR ROOM 201 & 202 | NO | 630 | 240 | YES | NO | 2.5 | 9.5 | FC | 1 | 1,779 0 | 5 1800 | 208 | 1 | 5.33 | 28.7 | 19.44 | 80.0 | 67.0 | 52.0 | 51.9 | 42 | 55.38 | 4.3 | 3.3 | 6 | 13 | YES | YES | TRANE | BCCD024 | 159 | 18.00 | 28.00 | 51.85 | 1 THRU 15 |
| NOTES | | | | | | <u></u> | | 1 | | | | | | | | | | | | | | | | - | | | | | | | | | | | | | |
| | | 1. AIR HANDLING UNIT SHALL BE | | | ONSTRUCTION | ON. | | | | 8. SELECT MOTORS | | | | | | | | _ | | | | | 14. CON II | RACTORI | | UT OPENING FOR SU | | AND REI | | | S AS REQUIRED | ~~~~~ | \sim | \sim | ~~~~~ | $\sim\sim\sim$ | |
| | | 2. PROVIDE PREMIUM EFFICIENC | CYMOTO | ORS. | | | | | | 9. PROVIDE HINGED | ACCESSI | DOOR ON M | XING BOX, | FILTER, C | | SS AND F | FAN SECTI | ION | | | | } | 15. FULLY | COORDI | NATE THE N | MOUNTING HARDWA | RE AND | D REQUIF | REMENTS | S WITH THE B | 3PI MANUFACTUREF | PRIOR TO B | D. COOLIN | NGCOILS | SECTION SH | IALL BE M | |
| | | 3. PROVIDE TWO WAY SLOPE DO | OUBLE V | VALL STAIN | LESS STEEL | L DRAIN P | PANS. | | | 10. BASE RAIL HEIGH | T SHALL | BE 6" AT A M | NIMUM TC | ACCOMM | ODATE TH | E ENTIRI | E HEIGHT | | | | | 2 | ALLOW | FOR FIEL | _D INSTALL | ATION OF BPI. BPI S | YSTEM | SHALL C | ONNECT | TTO CONTRO | DLS SYSTEM AND SH | IALL ONLY BE | ON WHE | .N FAN IS (| ON. PROVID | /E BPI "NE | EDLE POINT" |
| | | 4. PROVIDE FACTORY MIXING BC |)X. FIELI | D FABRICA | TED BOX IS I | NOT ACCE | EPTABLE. | | | OF CONDENSATE | DRAIN TR | RAP ABOVE | IOUSE KE | EPING PAD | D SURFAC | E | | | | | | ζ | BARSI | NSTALLEI | D UPSTRE | AM OF THE COOLING | COIL. I | ELECTRI | CAL CON | NTRACTOR TO | O COORDINATE PO | VER REQUIR | EMENTS. | | | | } |
| | | 5. MAXIMUM 12 FINS PER INCH. | | | | | | | | 11. PROVIDE 5 YEARS | S WARRA | NY PARTS A | ID LABOR | | | | | | | | | } | 16. PROVI | DE FACTO | ORY INSTAL | LED HIGH-INTENSIT | YUVLI | GHTS DO | WNSTRI | EAM OF THE | COOLING COIL; MIN | IMUM 15-20 V | √SF-FT. C | ;OMPONE | NTS EXPOS | ED TO U۱ | VLIGHT SHALL |
| | | 6. COOLING COIL FACE VELOCIT | Y SHALL | NOT EXCE | ED 500 FPN | 1 | | | | 12. PROVIDE TUBE FI | N COIL C | ONSTRUCT | ON. MICRO | OCHANNEL | L NOT ACC | EPTABL | E | | | | | <u> </u> | BE APF | PROPRIAT | ELY PROTI | ECTED. PROVIDE DO | OR SW | ITCHES, | VIEWING | G WINDOW AN | ND SAFETY SIGNAGE | E. FULLY COC | RDINATE | THE MOU | NTING HAR | | AND 2 |

6. COULING CUIL FACE VELOCITY SHALL NUT EXCEED 5001 7. MAX FILTER FACE VELOCITY 500 FPM

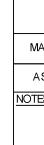

| | | EX | PANSI | ON TANK | SCHE | DULE | | |
|---------------|--|-------------------|-------------|-----------------|-----------------|--------------|-----------|---------|
| MARK | UNIT LOCA TION | DIA METER (IN) | HEIGHT (IN) | PRE-CHARGE(PSI) | WEIGHT (LBS) | MANUFACTURER | MODEL # | REMARKS |
| ET-1 | Chiller Yard | 20 | 59 | 12 | 290 | TACO | CA215-125 | 1,2 |
| <u>NOTES:</u> | 1. ASME CERTIFIED. 2. FULL ACCEPTANCE E | BLA DDER. | <u>.</u> | | | | | |

| MARK | SERVES | VFD FLO | | HEAD (FT) | IMPELLER DIA. | MC | DTOR | ELECT | RICAL | MANUFACTURER | TYPE | MODEL | WEIGHT | REMARKS | | | | |
|--------|--|---------------|----------------------|--------------------------|-----------------|--|---|--|--------------|----------------------------|------------------------|---------|--------|---------|--|--|--|--|
| | | | (GPM) | | | HP | RPM | VOLTAGE | PHASE | | | | | | | | | |
| CHWP-1 | CH-1 AND CH-2 | YES | 300 | 120 | 11.3 | 20 | 1750 | 460 | 3 | TACO | BASE MOUNT END SUCTION | FI2513D | 860 | 1-12 | | | | |
| CHWP-2 | CH-1 AND CH-2 | YES | 300 | 120 | 11.3 | 20 | 1750 | 460 | 3 | TACO | HORIZONTAL SPLIT CASE | FI2513D | 860 | 1-12 | | | | |
| NOTES: | 1. VARIABLE FRQUENCY DRIVES. 7. PROVIDE WITH SUCTION DIFFUSER. | | | | | | | | | | | | | | | | | |
| | 2. MOTOR SHALL BE | , | | ALL POINTS C | N THE IMPELLER | CURVE. | 8. PROVIDE AEGIS SHAFT GROUNDING RINGS FOR ALL MOTORS | | | | | | | | | | | |
| | X 3. PROVIDE 10 INCH | THICK INERTIA | A BASE $\frac{1}{2}$ | $\underline{\mathbf{x}}$ | | | 9. PROVIDE | E STA INLESS S | STEEL FLEX (| CONNECTIONS | | | | | | | | |
| | 4. IMPELLER SHALL E | BE NO GREAT | TER THAN 85 | % of the Ma | XIMUM PUMP IMPI | /IUM PUMP IMPELLER. 10. SELECT MOTORS SO THAT BHP DOES NOT EXCEED 85% OF RATED POWER | | | | | | | | | | | | |
| | 5. PROVIDE HIGH EFF | ICIENCY PUN | 1PS. | | | | 11. PROVIE | DE WITH FREEZ | E PROTECTI | DTECTION SUCH AS HEAT TAPE | | | | | | | | |
| | 6. PROVIDE TEFC MOTORS. | | | | | | | 12. PUMPS SHALL BE EQUIPPED WITH AN OVERRIDE TO ALLOW THE PUMPS CIRCULATE WATER VIA DDC CONTROLS | | | | | | | | | | |

| NOTES | ; |
|-------|--|
| THRU | 6 |
| | |
| THRU | 6 |
| | |
| | |
| | |
| | |
| | THRU THRU THRU THRU THRU THRU THRU THRU |

| | | | | | | | | | Alf | R COC | LED C | HILLE | R SCH | IEDUL | .E | | | | | | | | |
|------|---|--|---|---|--|---|---|---|------------|------------------------|---|---|---|--|---|---|---|--|------------------|------------|--------------|---------------------|---------|
| | | A HRI CO | NDITIONS | COND | ENSER | | | EVAPC | RATOR | | | | | ELECTRICA | ۱L | | | | | | | | |
| MARK | NOMINAL CAPACITY (TONS) | EER | NPLV | EAT DB (°F) | FAN POWER (kW) | WATER FL | OW (GPM) | EWT (°F) | LWT (°F) | NUMBER OF PASSES | PRESSURE DROP (FT) | | MCA | MOCP | VOLTAGE | PHASE | MANUFACTURER | MODEL | LENGTH (in.) | WDTH (in.) | HEIGHT (in.) | OPERATING WEIGHT | REMARKS |
| | | | | | | DESIGN | MIN | | | | | | | | | | | | | | | | |
| CH-1 | 120 | 10.2 | 15.54 | 95 | 9.721 | 154.4 | 135.9 | 60 | 42 | 2 | 6.46 | 134.2 | 249 | 300 | 460 | 3 | TRANE | CGAM | 166 | 89 | 93 | 6884 | ALL |
| CH-2 | 120 | 10.2 | 15.54 | 95 | 9.721 | 154.4 | 135.9 | 60 | 42 | 2 | 6.46 | 134.2 | 249 | 300 | 460 | 3 | TRANE | CGAM | 166 | 89 | 93 | 6884 | ALL |
| | PROVIDE REI CHILLERS TC CHILLERS TC INSULATION INSTALL MA PROVIDE CH PROVIDE CH PROVIDE CH PROVIDE CH PROVIDE CH | D HAVE A M D HAVE AUT (ALL COLD NUFACTURE ILLER WITH LER ON 2 IN ILLER ISOLA ILLER WITH | INIMUM OF T TO-RESTART PARTS) DES ER-PROVIDEL BACNET FOF CH THICK EL ITION VALVI FACTORY M | WO INDEPENE IN THE EVEN GIGNED FOR H D DP FLOW S ^V R COMMUNICA A STOMERIC I ES FOR EACH OUNTED HAIL | DENT REFRIG T OF A POW IIGH HUMIDIT WITCHES IN I A TION WITH SOLATION F I CHILLER WI GUARD. | GERANT CIRCL (AR FAILURE Y PIPE AND WIR BAS. (ADS PROVIDE ITH VICTAULIC | JITS. E TO CONTF ED WITH CHI C CONNNEC | ROL CENTER. LLER BY MA FION AT CHIL | NUFA CTURE | ٦. | 12 13 14 15 16 17 18 (19 | CHILLER SH PROVIDE 5 PROVIDE W PROVIDE A PROVIDE C PROVIDE F PROVIDE F TOTAL CAR | HALL BE OU YEAR PART MTH CORRO CROSS THE ALIBRATED ACTORY MC ULL HEIGHT PACITY BET | TFITTED WIT S, LABOR A SION PROTE LINE START BALANCING DUNTED HIGH ARCHITECTU WEEN BOTH | ECTION COATIN TER, COORDIN & VALVES AT H FAULT CIRC URAL LOUVE CHILLERS SC TO PREPARE F | PE COMPRES ANT WARRA NG ON COND ATE EXACT EACH CHILLI UIT BRAKER RED PANELS HEDULED IS OR ANY BUI | SSORS ANTY COVERING ENTIR ENSER COILS PERFORMANCE WITH M ER. AND 65 KVA SHORT CI | ANUFACTUR RCUIT RATIN ACITY BETW | G ÆEN ALL AIR | | | | 5 |

12. PROVIDE TOBE FIN COIL CONSTRUCTION. MICROCHANNEL NOT ACCEPTABLE

13. MECHANICAL CONTRACTOR SHALL BE REPOSIBLE TO DISSASEMBLE/ORDER UNIT TO FIT THROUGHT STANDARD 36" DOOR UNIT SHALL BE ORDERED IN A MANNER THAT ALLOWS UNIT TO FIT THROUGH A 36 INCH OPENING. NO EXCEPTIONS.

PROPRIATELY PROTECTED. PROVIDE DOOR SWITCHES, VIEWING WINDOW AND SAFETY SIGNAGE. FULLY COORDINATE THE MOUNTING HARDWARE AND REQUIREMENTS WITH THE UV LIGHT MANUFACTURER PRIOR TO BID. UV SYSTEM SHALL CONNECT TO CONTROLS SYSTEM AND SHALL ONLY BE ON WHEN FAN IS ON.

| | | AIR S | EPARAT | OR SC | HEDULE | | |
|------|---------------|-------|------------------|-------------------|--------------|----------|---------|
| ARK | SERVICE | GPM | WORKING FLUID | DIA METER (IN) | MANUFACTURER | MODEL # | REMARKS |
| \S-1 | CHILLED WATER | 300 | WATER | 6 | TACO | AC06-125 | 1,2 |
| ES: | | | | | | | |


1. A SME CERTIFIED.


2. INLET AND OUTLET SHALL BE SAME SIZE AS FIPE

HYDRONIC PUMP SCHEDULE


ELECTRICAL CONTRACTOR TO COORDINATE POWER REQUIREMENTS. 2




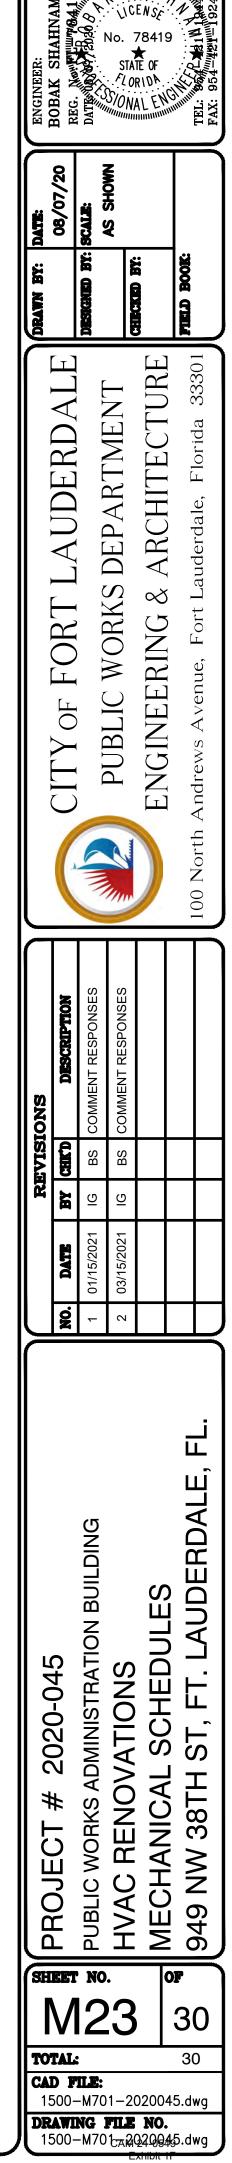


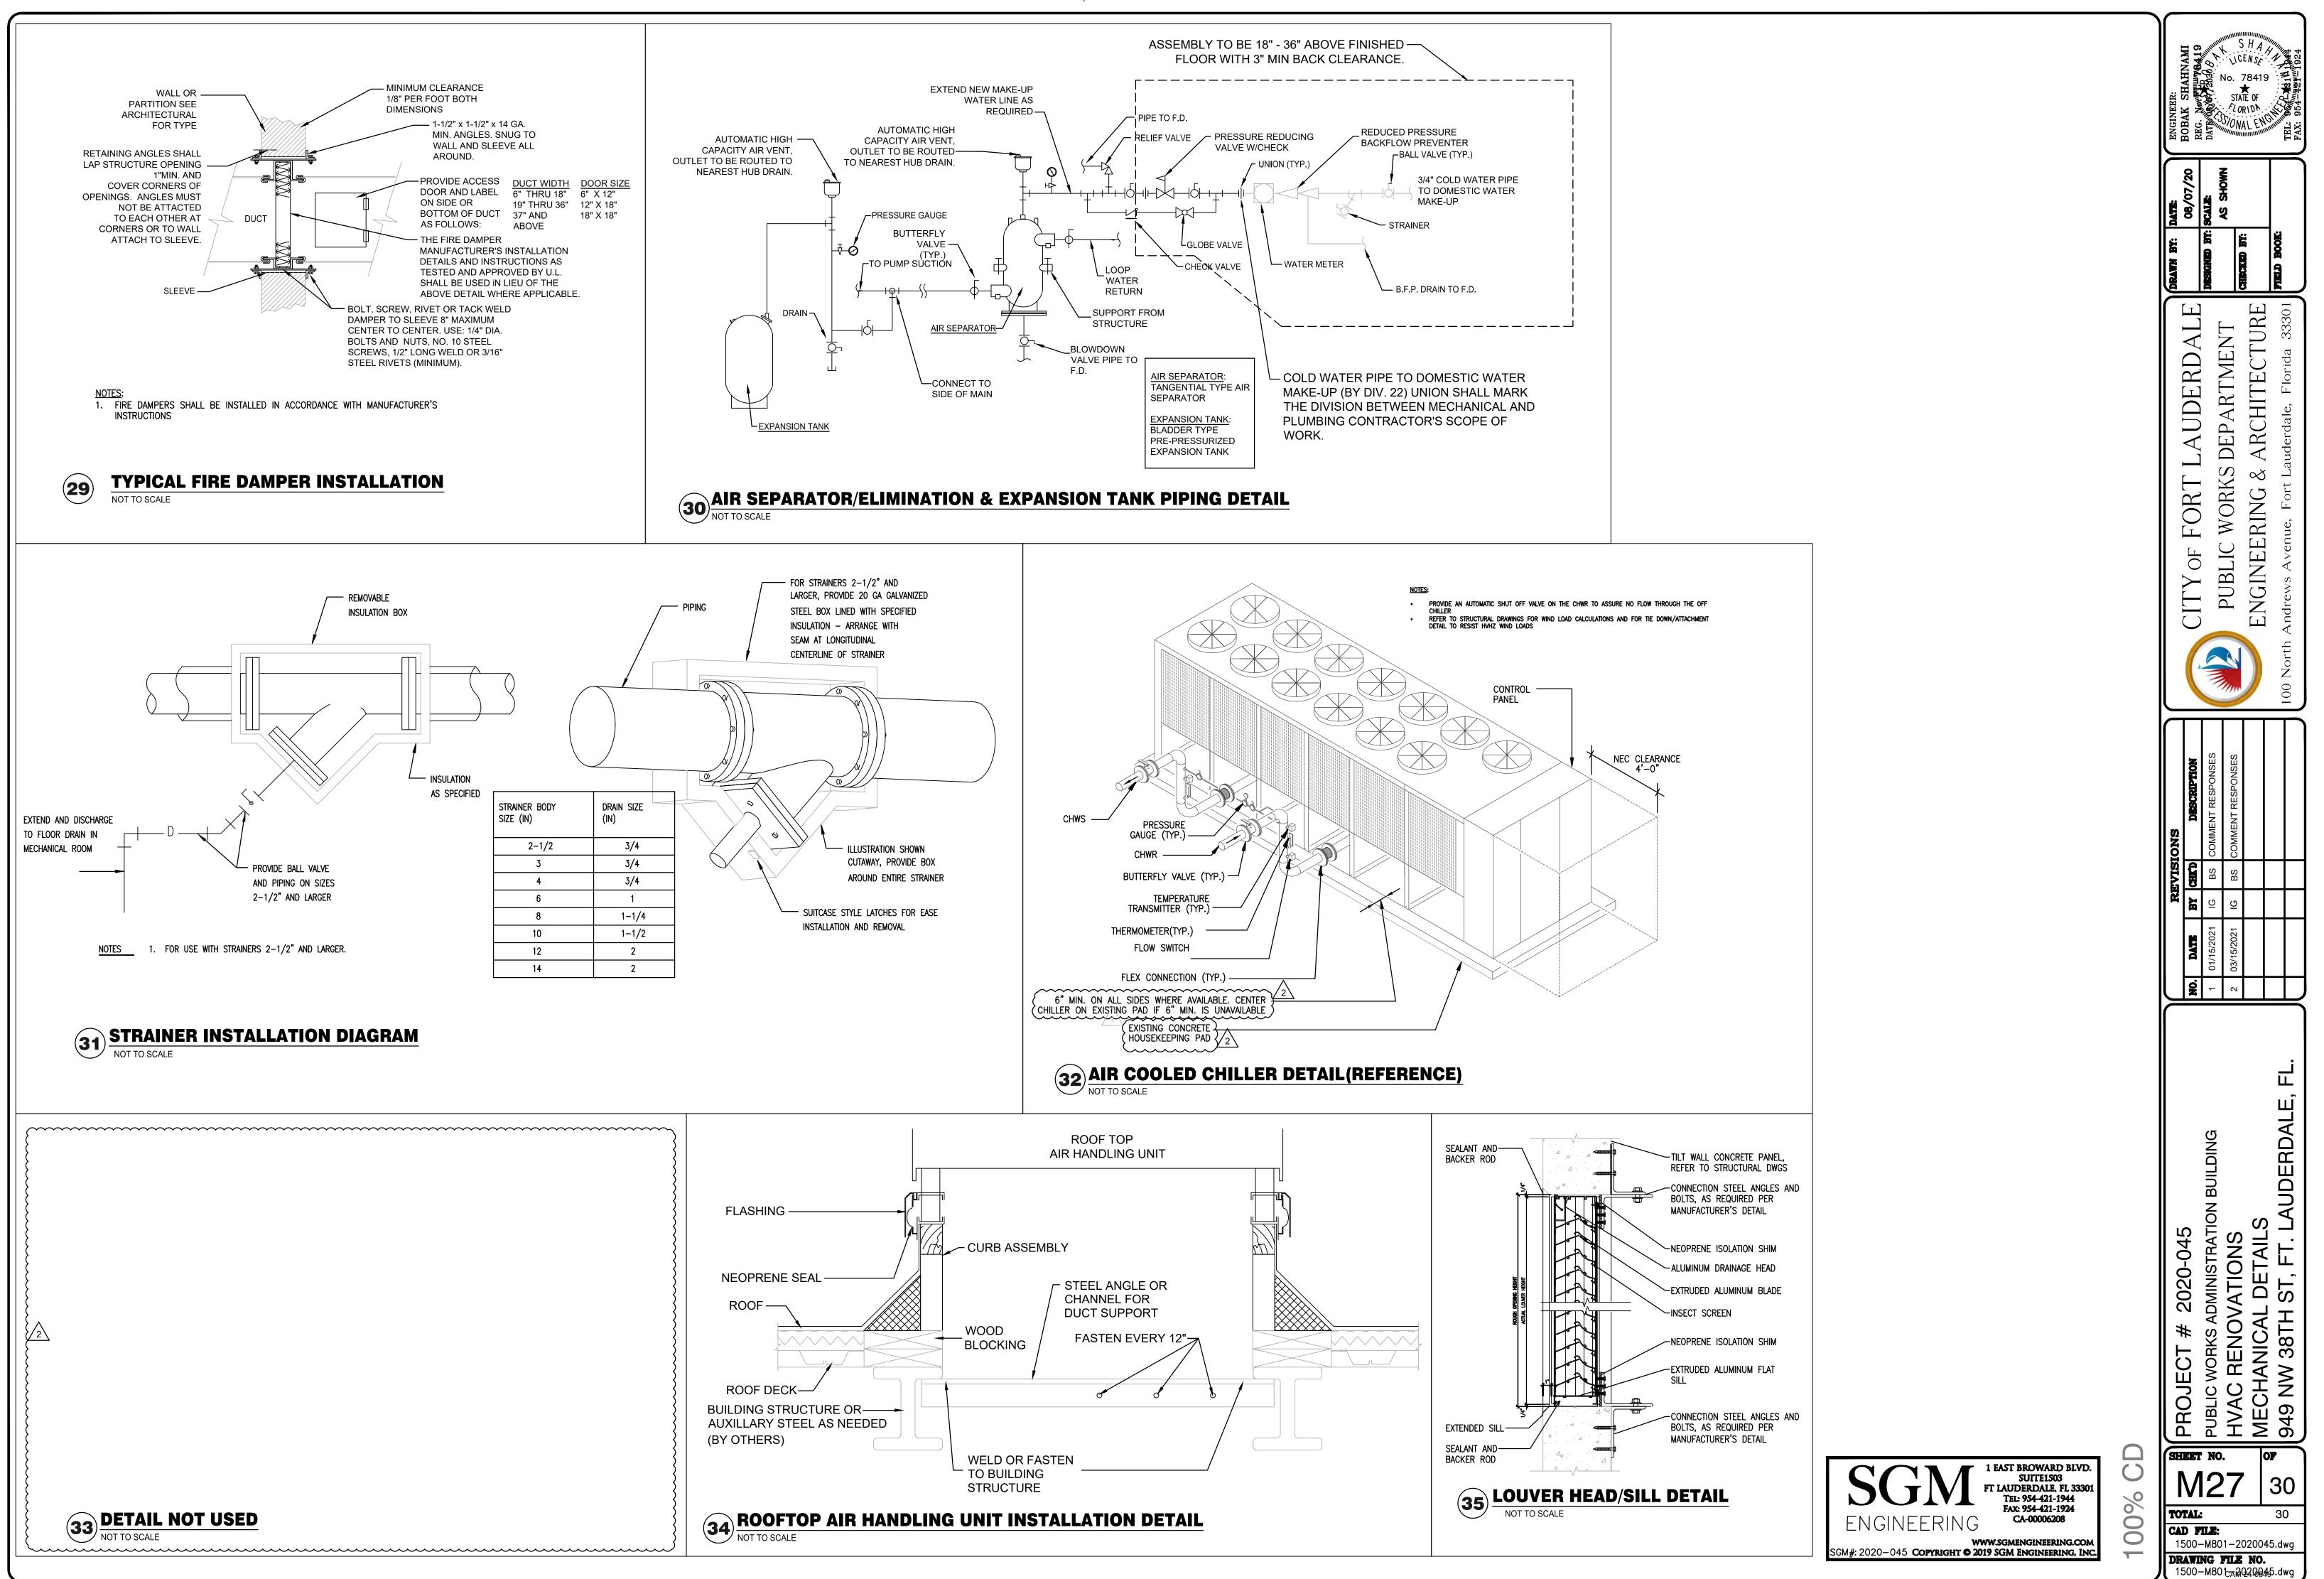

City of Fort Lauderdale

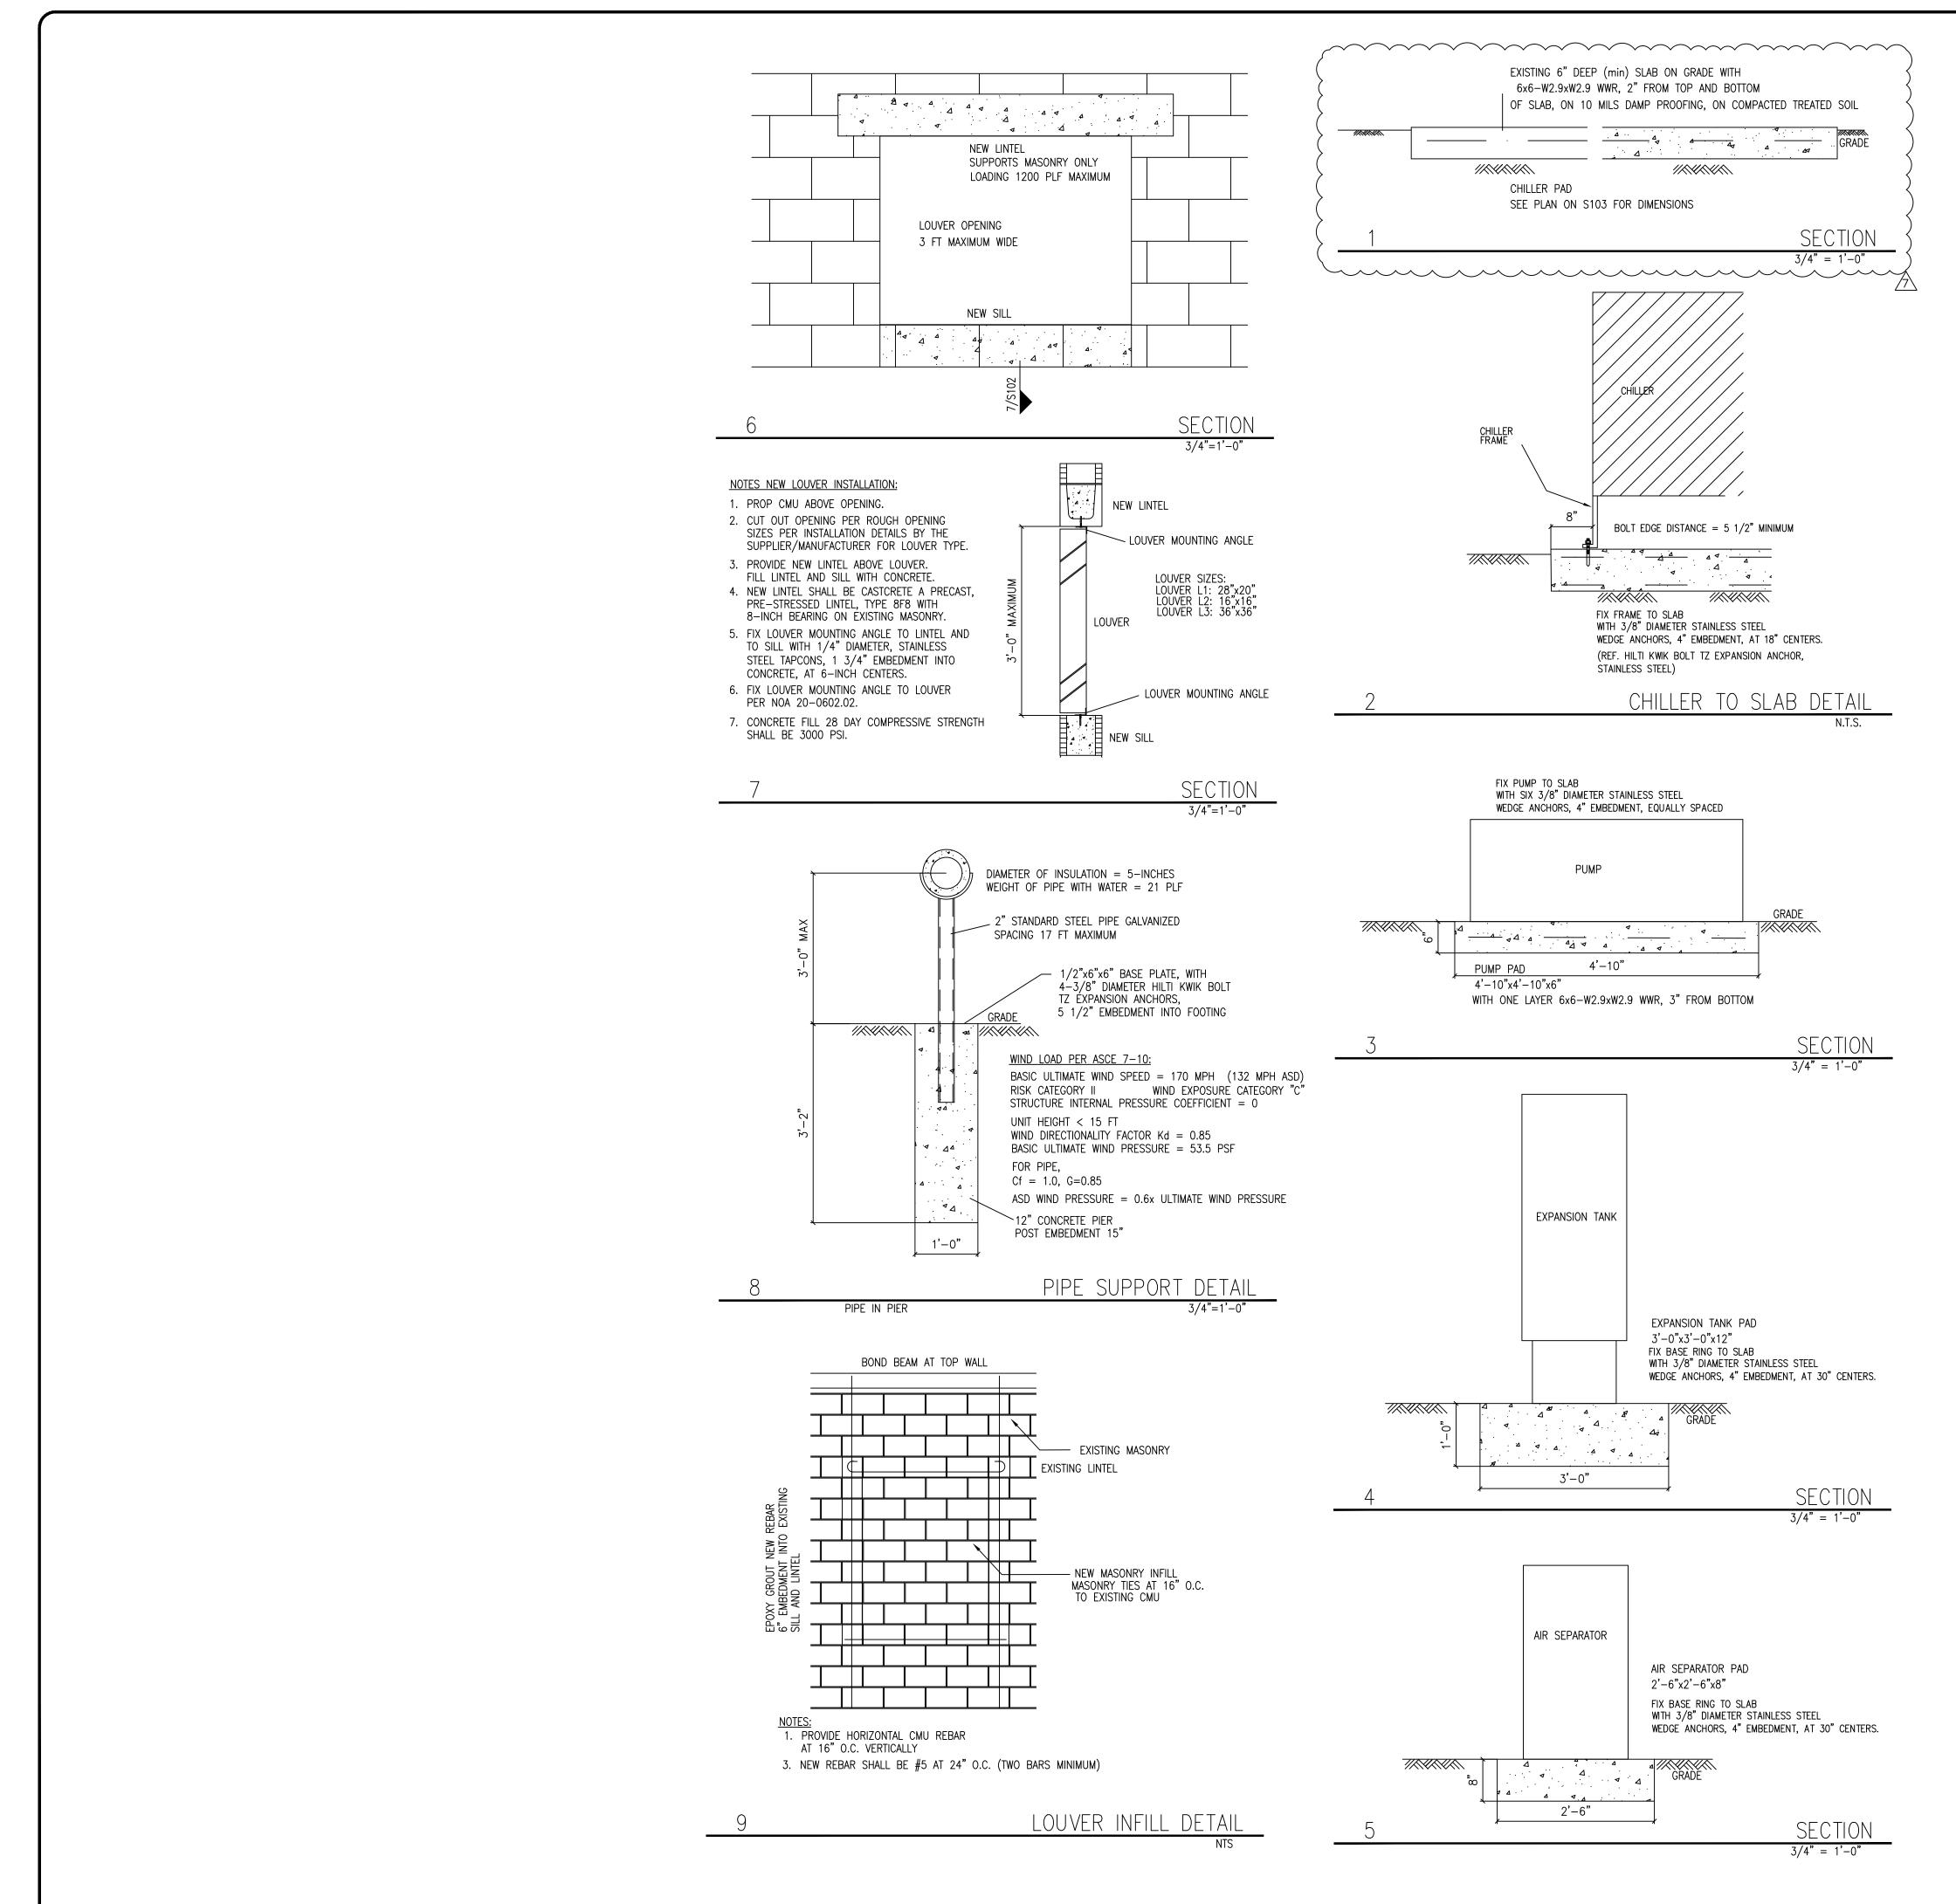

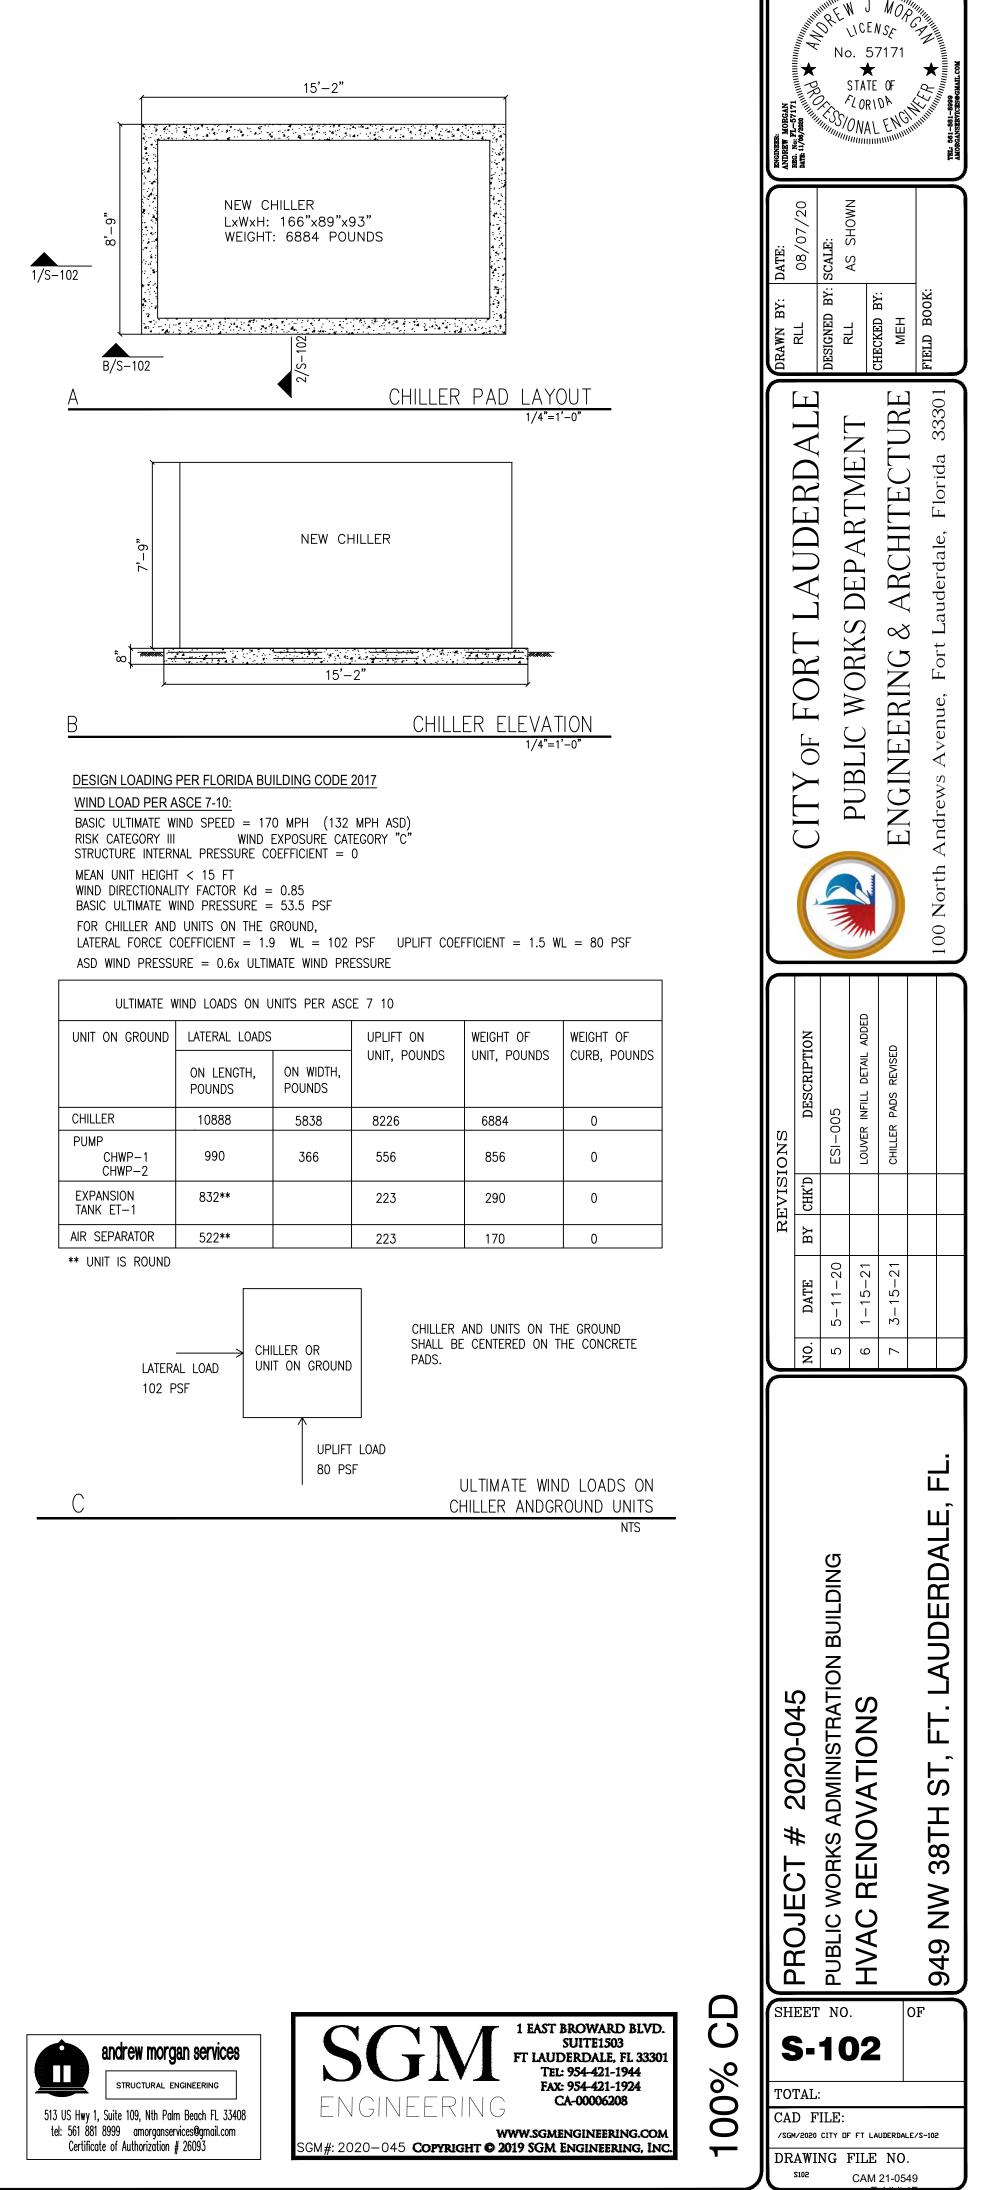

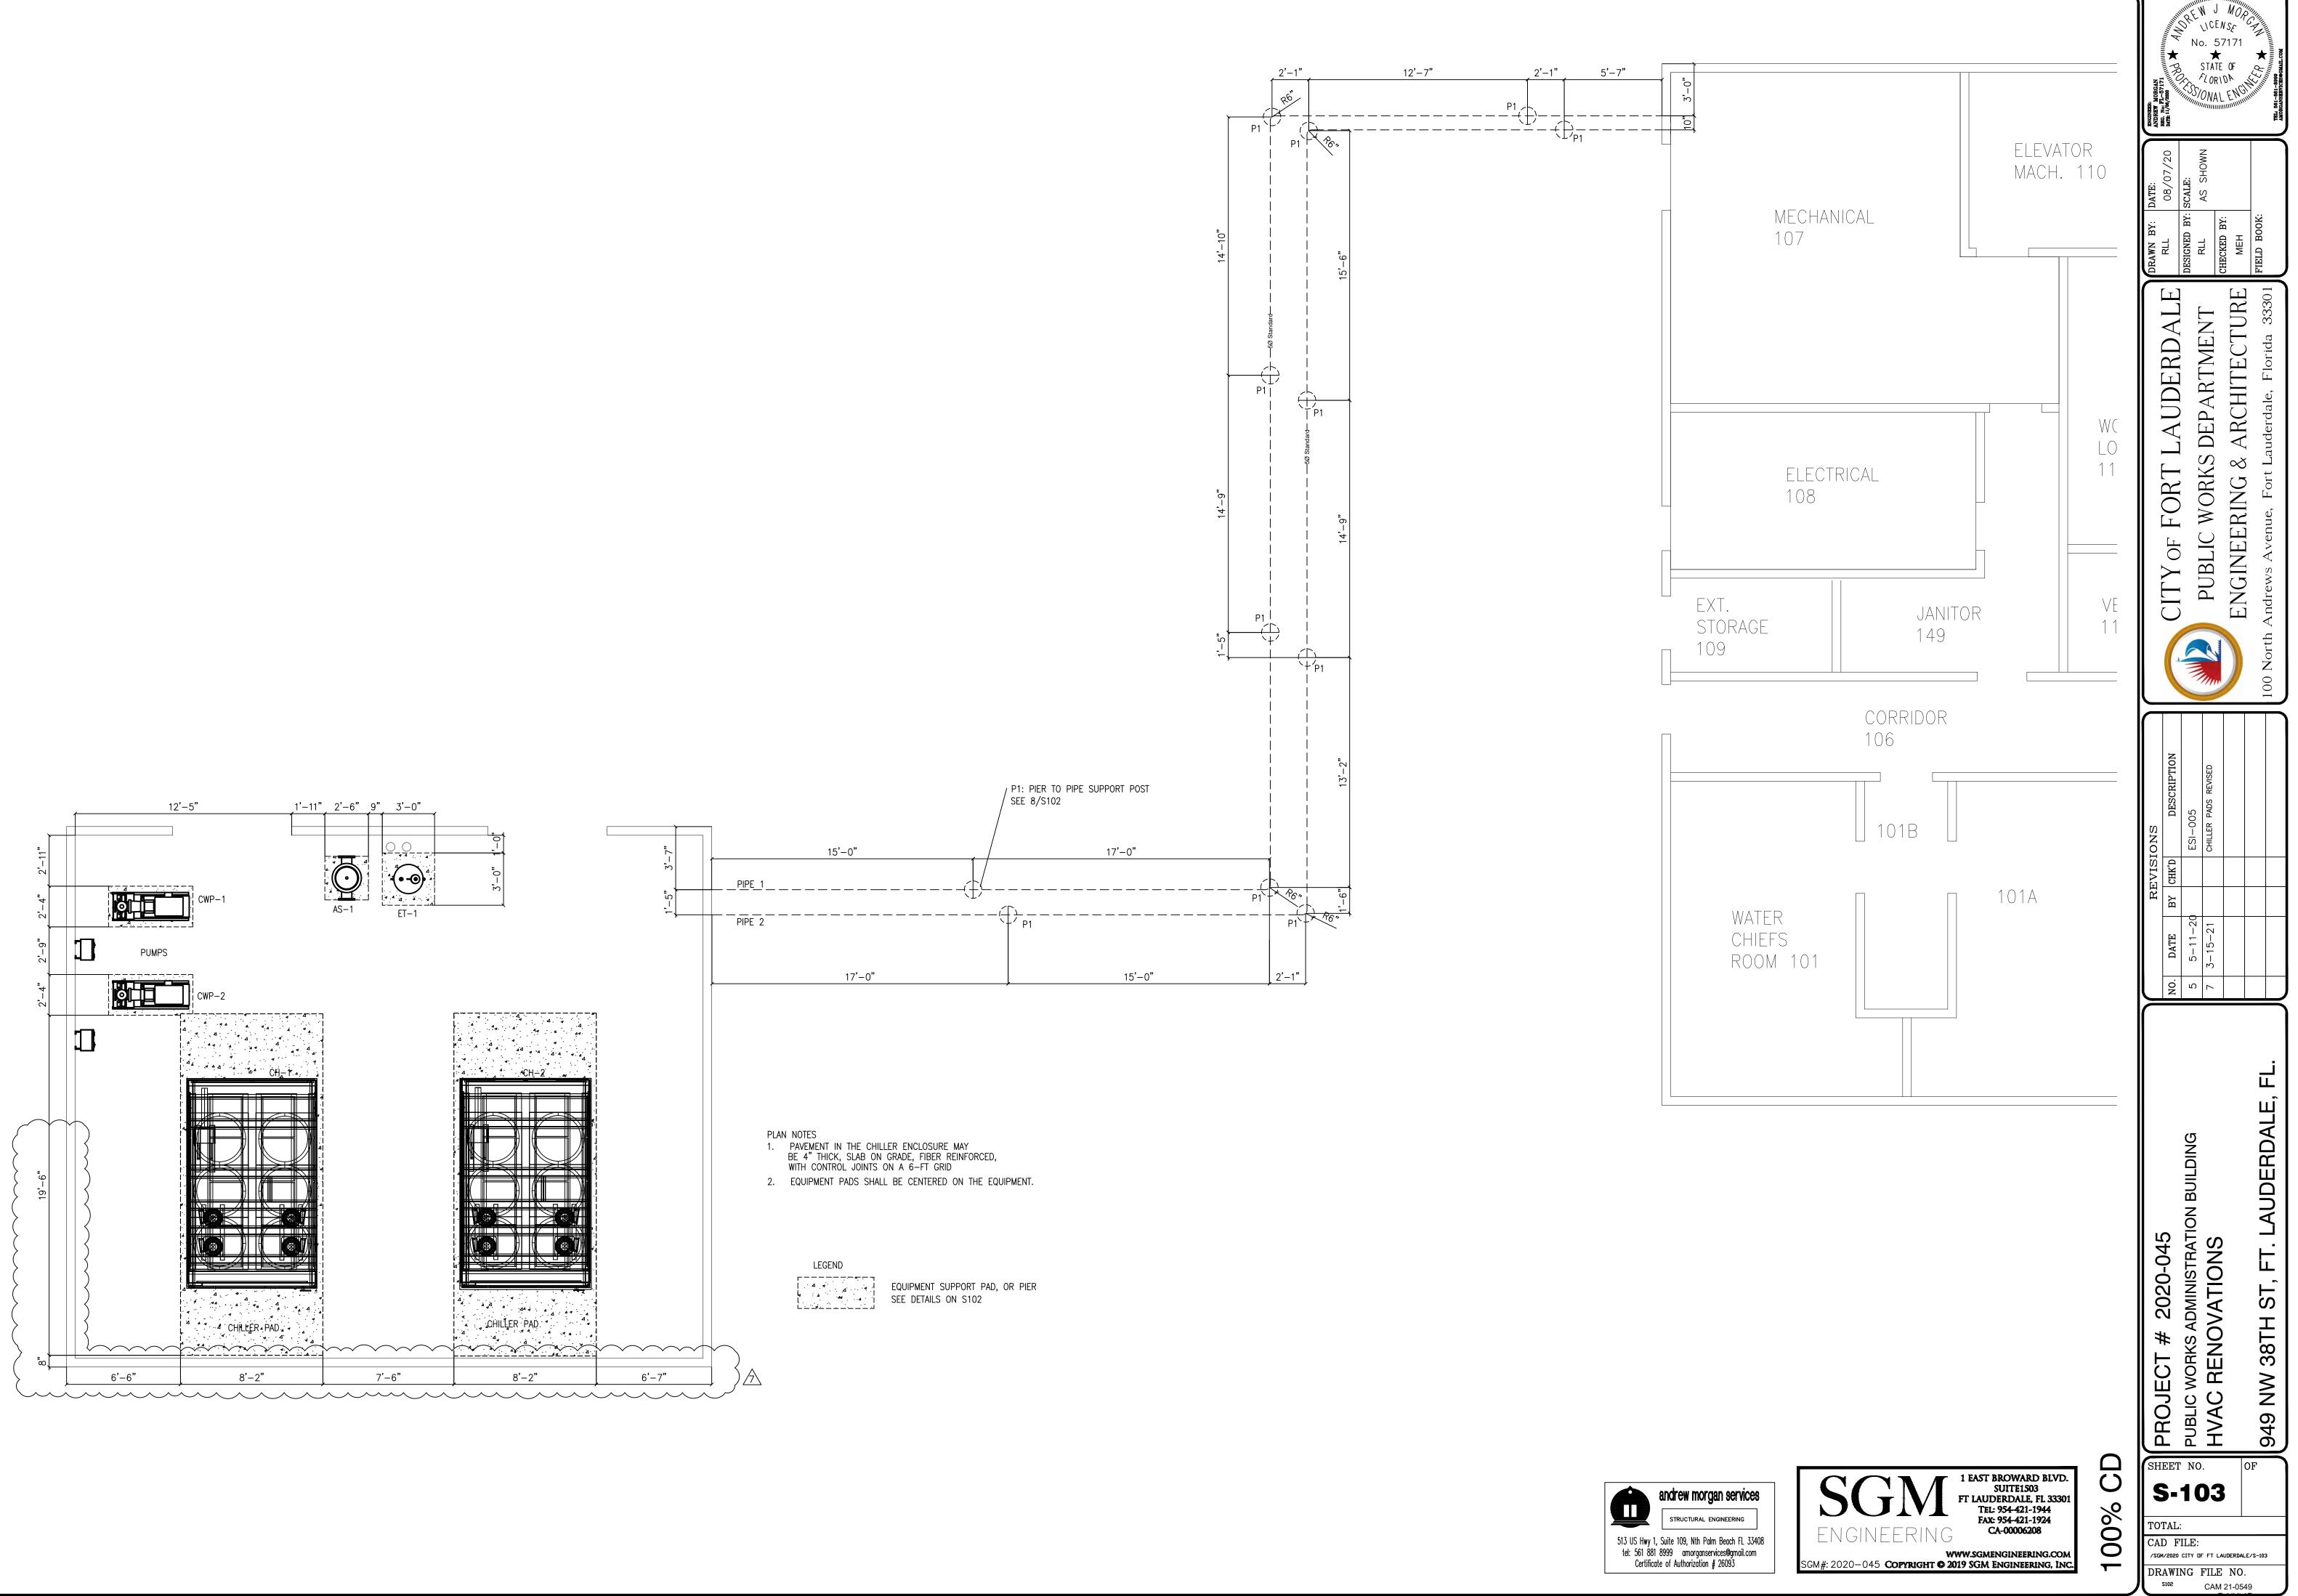



City of Fort Lauderdale • Procurement Services Division 100 N. Andrews Avenue, 619 • Fort Lauderdale, Florida 33301 954-828-5933 Fax 954-828-5576 purchase@fortlauderdale.gov

ITB NO. 12467-113

Public Works Administration Building Air Conditioning

ADDENDUM NO. 2

ISSUED: April 14, 2021

This Addendum is being issued to provide the following information. It is hereby made a part of the Plans and Specifications and shall be included with all contract documents.

Acknowledge receipt of this Addendum by inserting its number and date on the CITB Construction Bid Certification Page.

A) Opening Bid and Q&A will be extended:

New Date: Opening Bid: April 28, 2021

New Date: Q&A: April 19, 2021

B) These drawings were revised:

T00, M11, M15, M16, M17

C) New Drawings were added:

R01, R02, R03, R04, R05

D) New Specifications were added:

055000, 061053, 070150, 076200, 076500

All other terms, conditions, and specifications remain unchanged.

Fausto Fargas Procurement Specialist

Company Name: _____

(please print)

Bidder's Signature:

Date: _____

| | DRAWING INDEX |
|---|--|
| | COVER SHEET |
| MOI | MECHANICAL SYMBOLS AND LEGEND |
| M02 | MECHANICAL GENERAL NOTES |
| MO3 | MECHANICAL GENERAL NOTES CONT'D |
| MO4 | MECHANICAL DEMO 19T FLOOR PLAN $2\sqrt{1}$ |
| M05 | MECHANICAL DEMO 2ND FLOOR PLAN |
| M06 | MECHANICAL DEMO 3RD FLOOR PLAN |
| M07 | MECHANICAL DEMO ROOF PLAN |
| MO8 | MECHANICAL RENO 19T FLOOR PLAN 🖄 |
| M09 | MECHANICAL RENO 2ND FLOOR PLAN |
| MIO | MECHANICAL RENO 3RD FLOOR PLAN |
| | MECHANICAL RENO ROOF PLAN |
| M12 | MECHANICAL ENLARGED PLANS 2 |
| MI3 | MECHANICAL ENLARGED PLANS |
| M14 | MECHANICAL ENLARGED PLANS |
| M15 | MECHANICAL ENLARGED PLANS |
| M16 | MECHANICAL ENLARGED PLANS |
| M17 | MECHANICAL ENLARGED PLANS |
| M18 | MECHANICAL CONTROL DRAWINGS |
| M19 | MECHANICAL CONTROL DRAWINGS |
| M20 | MECHANICAL CONTROL DRAWINGS |
| M21 | MECHANICAL CONTROL DRAWINGS |
| M22 | MECHANICAL CONTROL DRAWINGS |
| M23 | MECHANICAL SCHEDULES 2 |
| M24 | MECHANICAL DETAILS |
| M25 | MECHANICAL DETAILS |
| M26 | |
| M27 | MECHANICAL DETAILS \triangle |
| M28 | MECHANICAL DETAILS |
| | |
| M29 | MECHANICAL ALTERNATE - CRAC UNIT |



| M30 E01 E02 E03 E04 E05 E06 E07 E08 E09 E10 E10 E11 E12 E13 E14 E15 E16 E17 E18 | MECHANICAL ALTERNATE - EXHAUST FAN ELECTRICAL SYMBOLS AND LEGENDS ELECTRICAL GENERAL NOTES ELECTRICAL DEMO 1ST FLOOR LIGHTING PLAN ELECTRICAL DEMO 3RD FLOOR LIGHTING PLAN ELECTRICAL DEMO 3RD FLOOR LIGHTING PLAN ELECTRICAL DEMO 1ST FLOOR POWER PLAN ELECTRICAL DEMO 1ST FLOOR POWER PLAN ELECTRICAL DEMO 3RD FLOOR POWER PLAN ELECTRICAL DEMO 1ST FLOOR POWER PLAN ELECTRICAL RENO 1ST FLOOR POWER PLAN ELECTRICAL PANEL SCHEDULES ELECTRICAL DETALS |








THE OBJECTIVES OF THIS PROJECT AS IDENTIFIED ON THE DRAWINGS, INCLUDES: A. NFPA 70 NATIONAL ELECTRICAL CODE (2014 EDITION) B. FLORIDA BUILDING CODE (2017 SIXTH EDITION) C. FLORIDA FIRE PREVENTION CODE (2017 SIXTH EDITION) D. LOCAL REQUIREMENTS OF THE AUTHORITY HAVING JURISDICTION

| | D | RAWI |
|--------------------|------------|-----------|
| { | R01 | PARTIAL F |
| $\left\{ \right\}$ | R02 | MECHANK |
| $\left\{ \right\}$ | R03 | MECHANK |
| $\left\{ \right.$ | R04 | MISCELLA |
| $\left\{ \right\}$ | R05 | GENERAL |
| | | |



CITY OF FORT LAUDERDALE

PROJECT #2020 -045

PUBLIC WORKS ADMINISTRATION BUILDING

HVAC RENOVATION

949 NW 38TH ST

FORT LAUDERDALE, FLORIDA

GENERAL SCOPE OF WORK

REPLACEMENT OF THE EXISTING ROOFTOP AND INDOOR AIR HANDLING UNITS IN COMPLIANCE WITH THE CURRENT CODES AND REGULATIONS
 ELECTRICAL UPGRADES NECESSARY TO ACCOMMODATE NEW ROOFTOP AND INDOOR AIR HANDLING UNITS IN COMPLIANCE WITH CURRENT CODES AND REGULATIONS

THIS BRIEF DESCRIPTION OF THE SCOPE OF WORK IS NOT ALL INCLUSIVE AND IS COMPLIMENTED BY THE SET OF CONSTRUCTION DOCUMENTS AND SPECIFICATIONS.

ALL WORK AND MATERIALS SHALL BE IN COMPLIANCE WITH ALL GOVERNING CODES AND STANDARDS. THIS SHALL INCLUDE BUT NOT BE LIMITED TO THE FOLLOWING.



NG INDEX CONTINUED

ROOF PLAN + SPECIFIC NOTES

ICAL FLASHING DETAILS

CAL FABRICATION DETAILS


ANEOUS DETAILS

ROOFING NOTES + FASTENING SCHEDULE

DRAWING INDEX CONTIN

| 12467-113 | |
|-----------|-----------|
| | |
| | 12467-113 |

| | | | RE | VISIONS |
|-----|------------|----|--------|-------------------|
| NO. | DATE | BY | CHIK,D | DESCRIPTION |
| 1 | 01/15/2021 | IG | BS | COMMENT RESPONSES |
| 2 | 03/15/2021 | IG | BS | COMMENT RESPONSES |
| 3 | 04/09/2021 | IG | BS | COMMENT RESPONSES |
| | | | | |

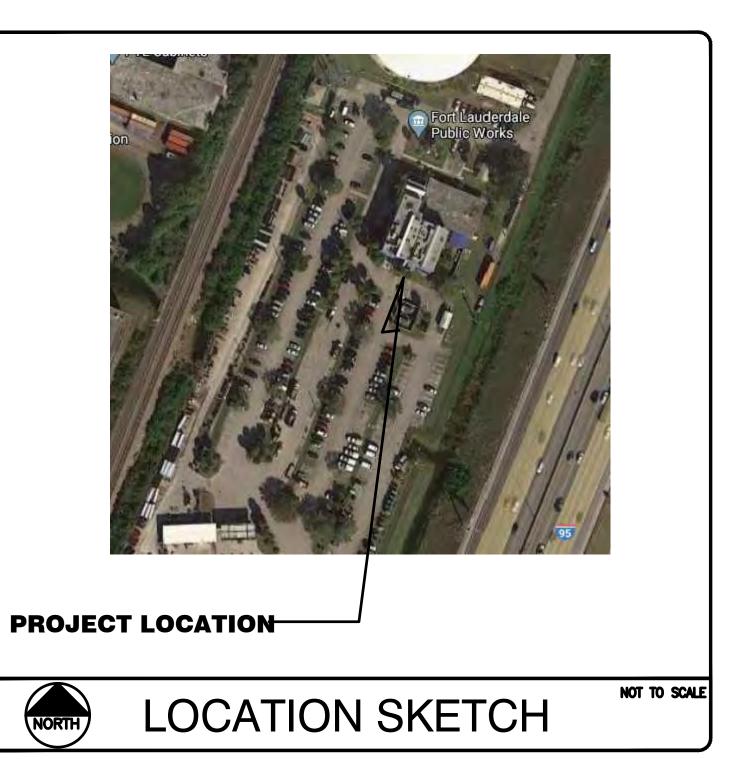

PROJECT #2020-045 CITY OF FT. LAUDERDALE PUBLIC WORKS HVAC RENOVATIONS 949 NW 38ST AVE, FT. LAUDERDALE, FL 33311



FORT LAUDERDALE CITY COMMISSION

DEAN J. TRANTALIS HEATHER MORAITIS STEVEN GLASSMAN ROBERT L. McKINZIE BEN SORENSEN

| MAYOR | |
|-------------------------|-----|
| COMMISSIONER - DISTRICT | Ι |
| COMMISSIONER - DISTRICT | Π |
| COMMISSIONER - DISTRICT | III |
| COMMISSIONER - DISTRICT | IV |

IRINA TOKAR, R.A. DANICA GRUJICIC SGM ENGINEERING. INC. SENIOR PROJECT MANAGER PROJECT MANAGER II **MECHANICAL & ELECTRICAL** 954-828-6891 954-828-5055 954-421-1944

DATE: 09/15/2020

CAD FILE: 1200-T000-2020045

DRAWING FILE No.: 1200-T000-2020045


100% CD


CAM 21-0549


Page 8 of 78 p. 715


1 EAST BROWARD BLVD. SUITE1503 FT LAUDERDALE, FL 33301 Tel: 954-421-1944 FAX: 954-421-1924 CA-00006208 WWW.SGMENGINEERING.COM


| NUED | |
|------|--|
| | |
| | |
| | |
| | |
| | |

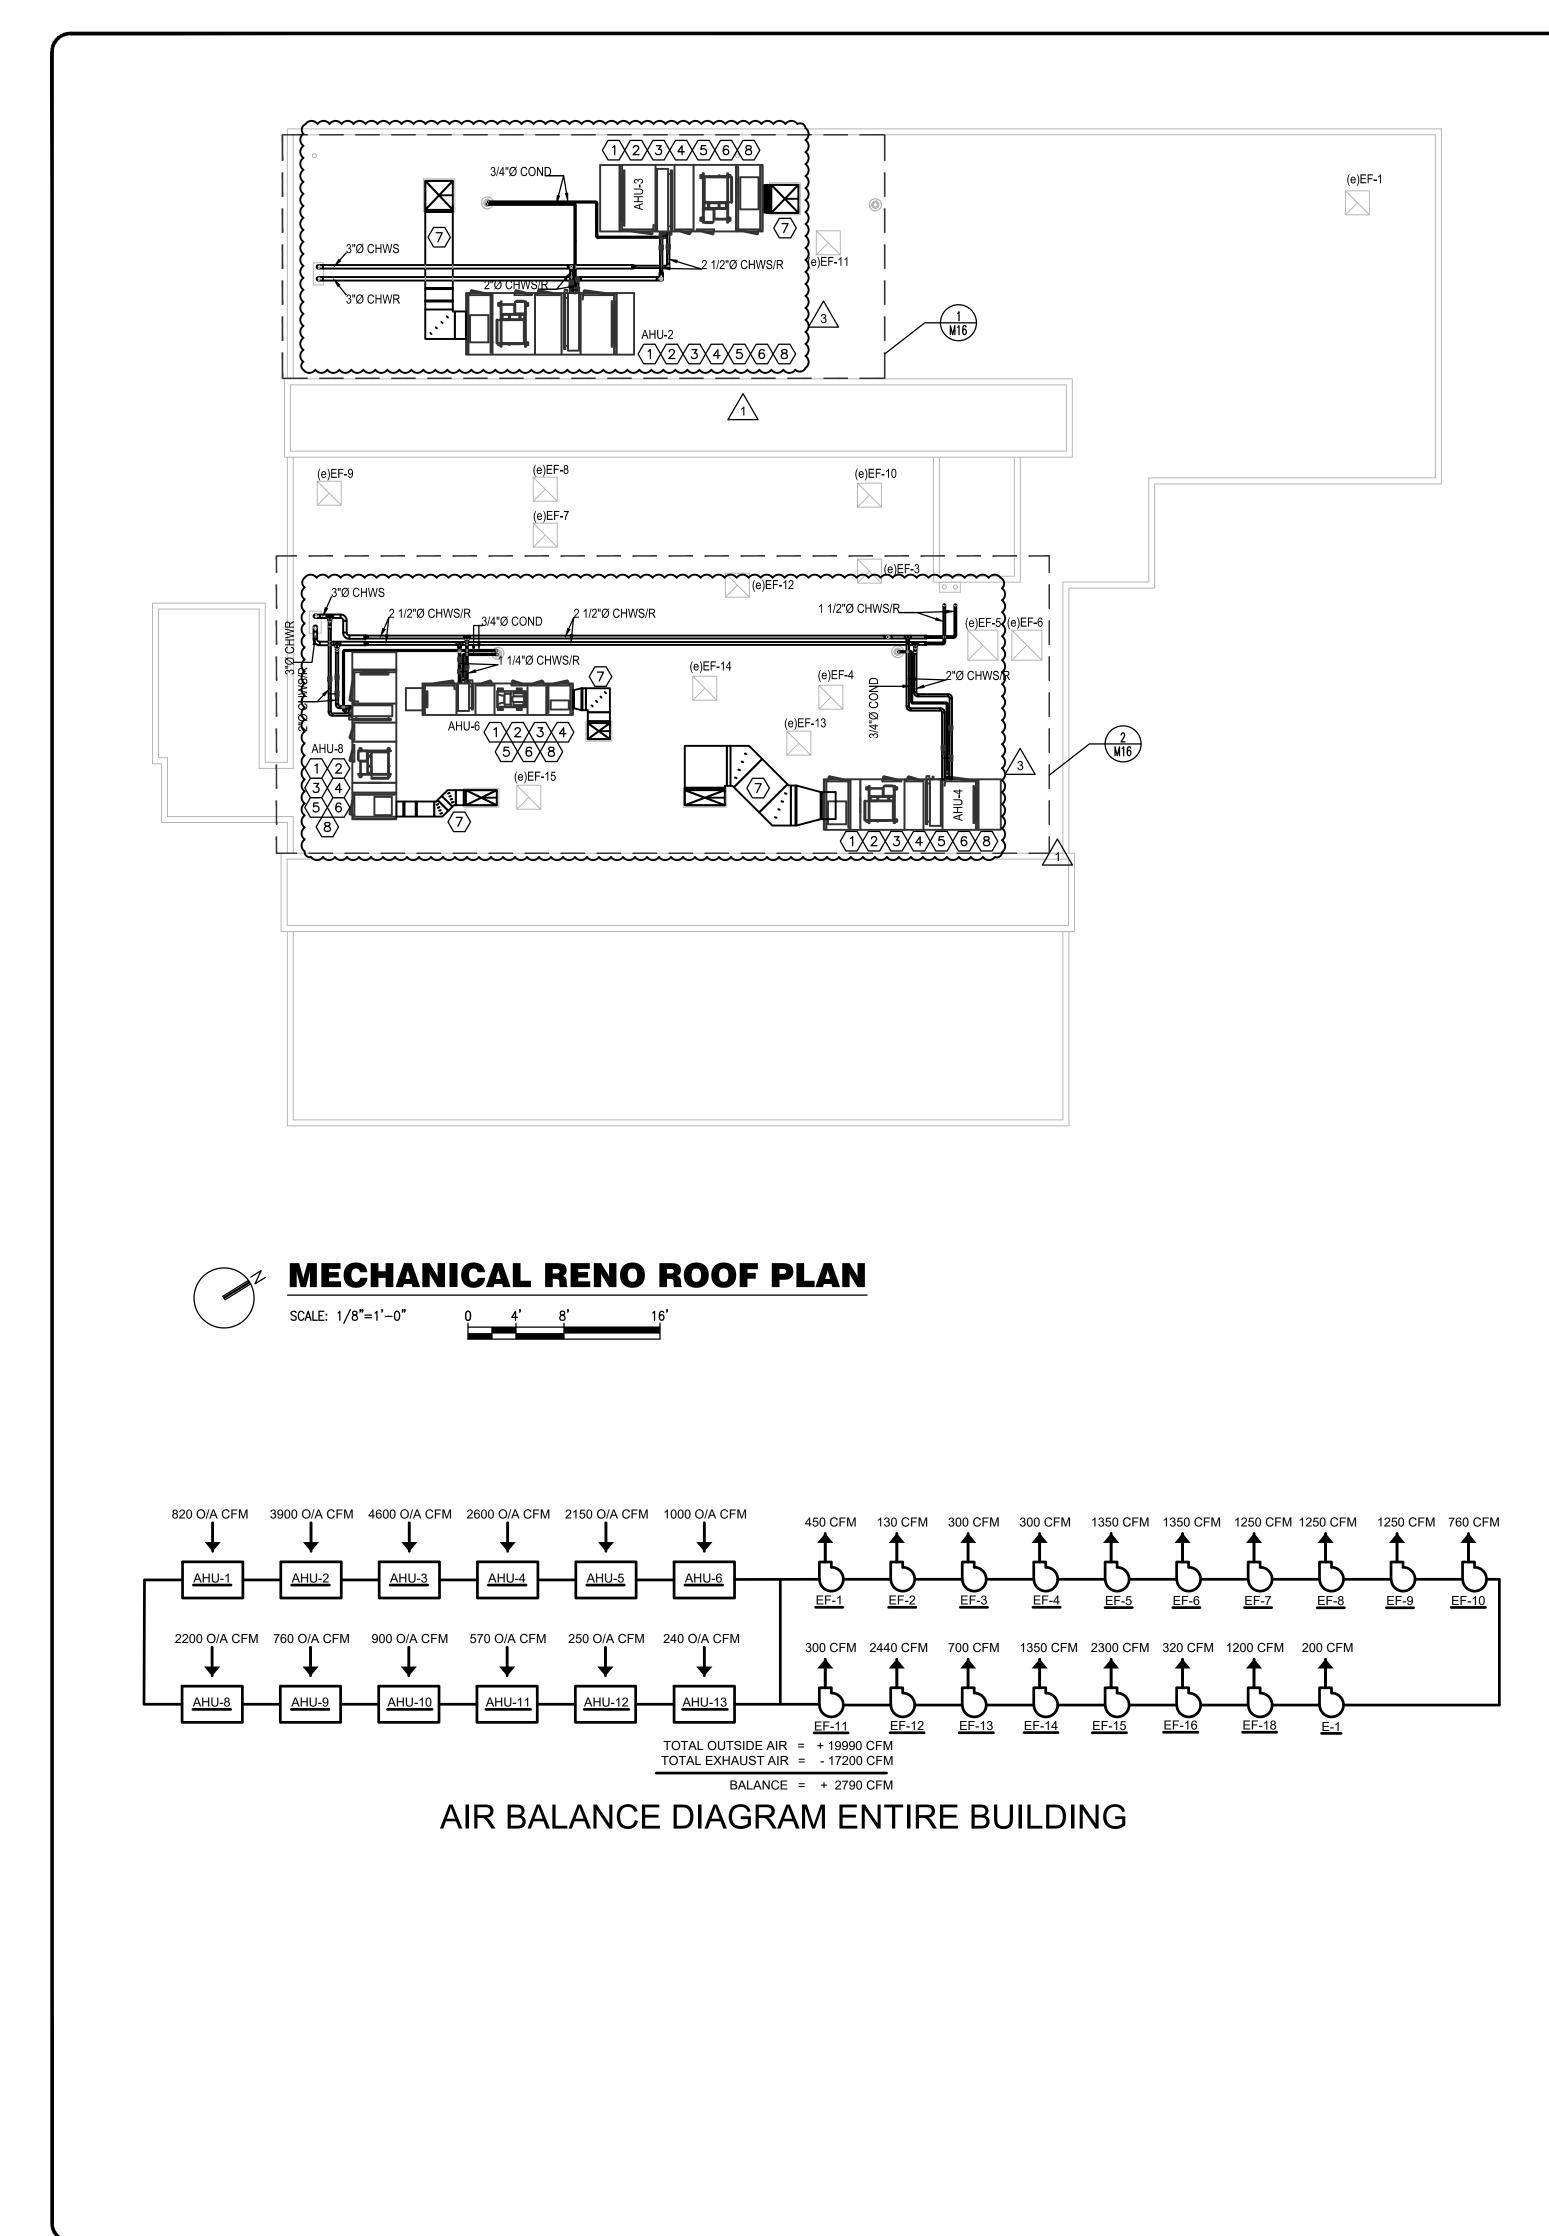

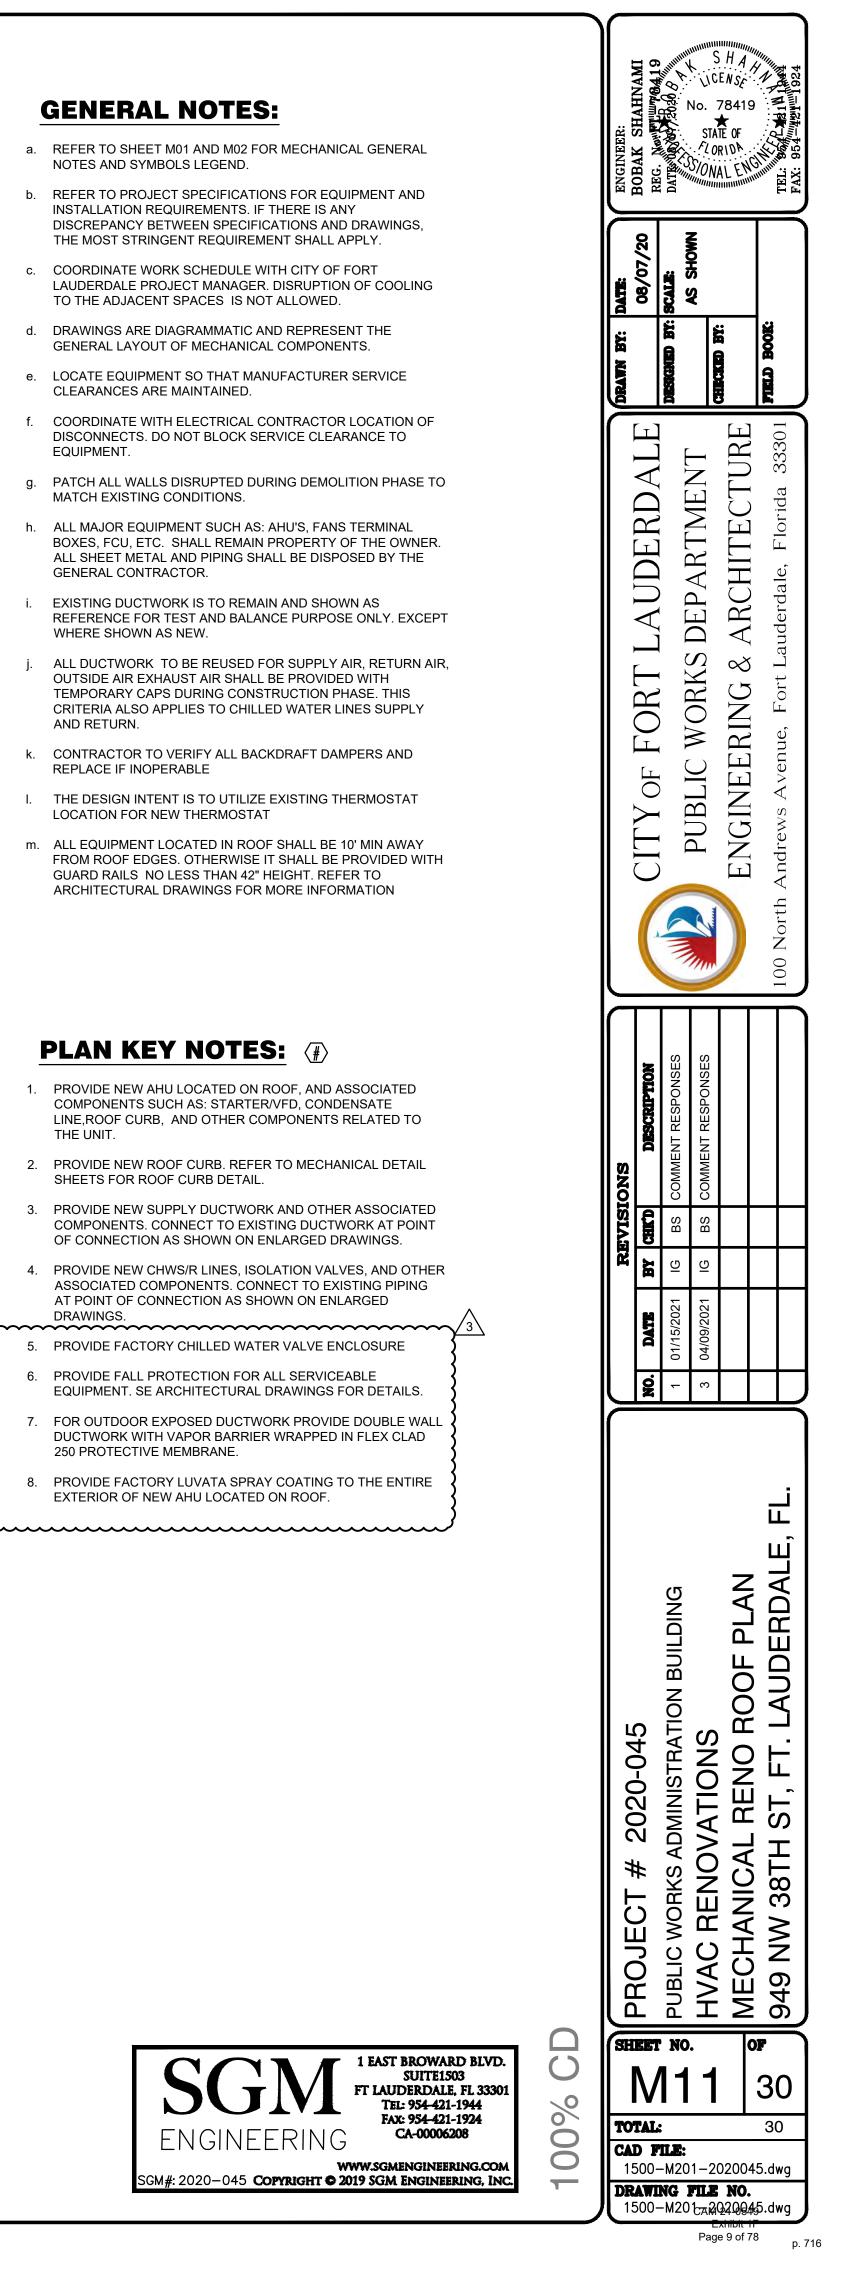

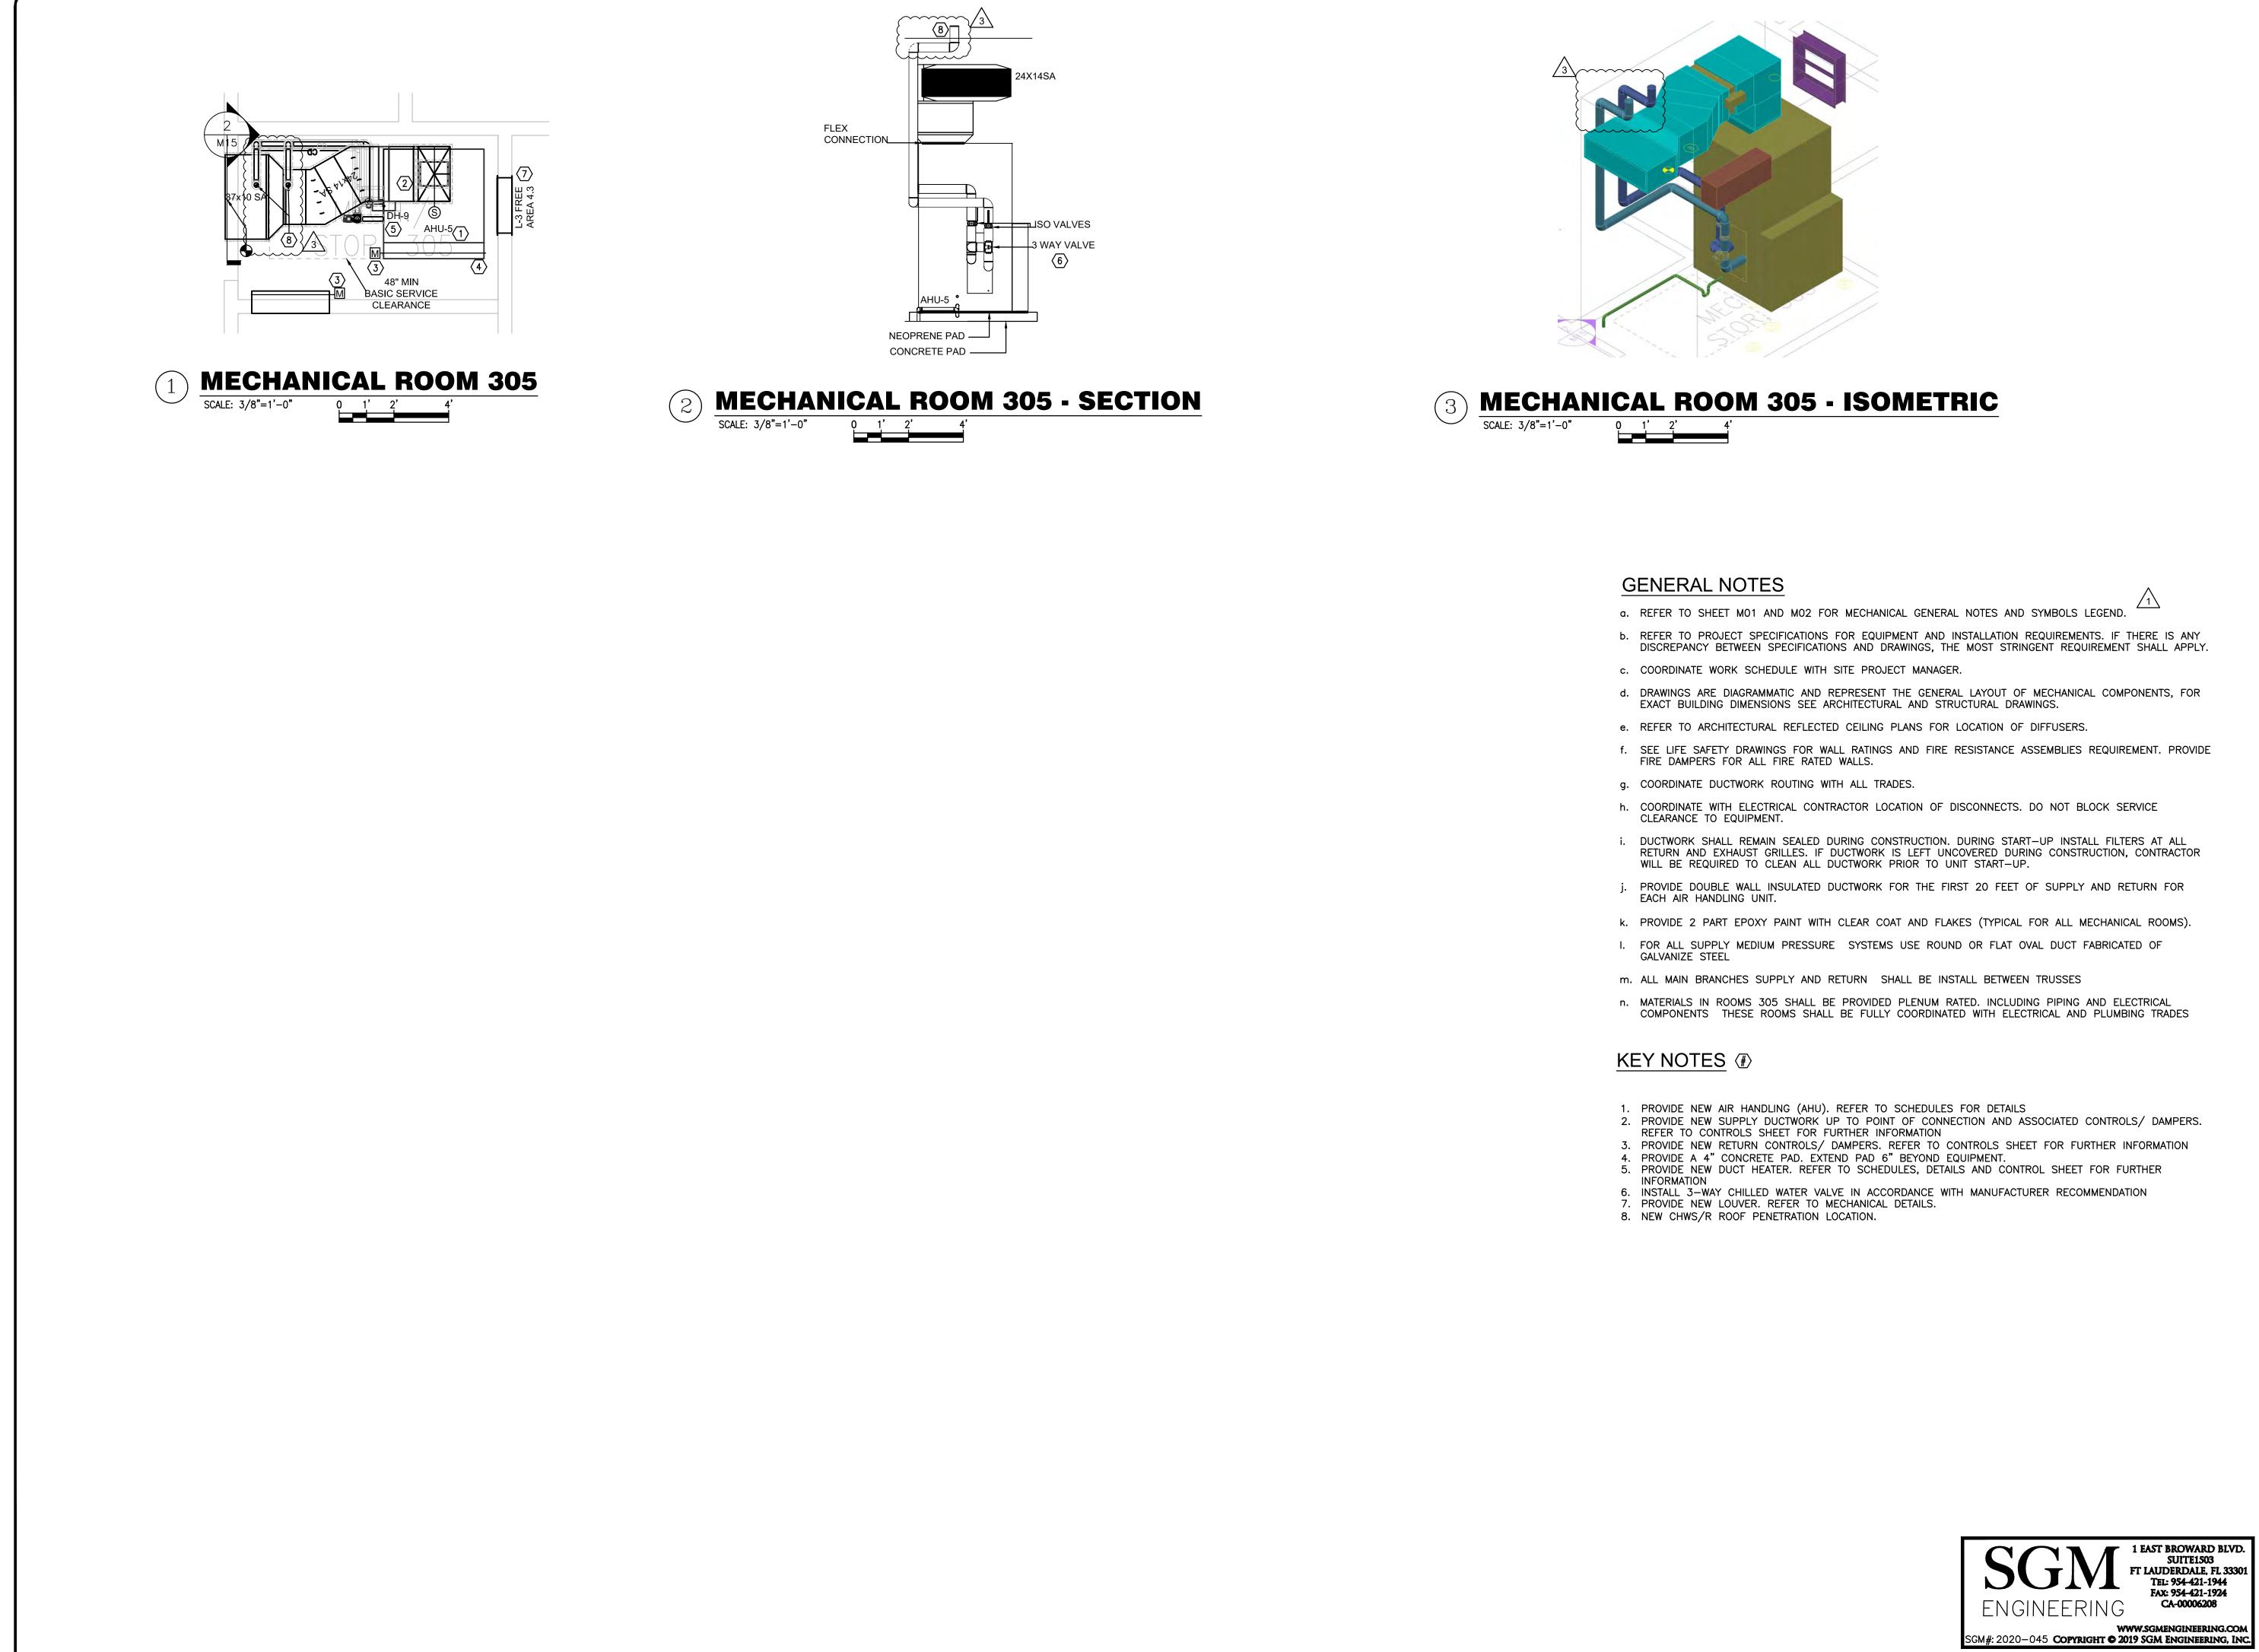

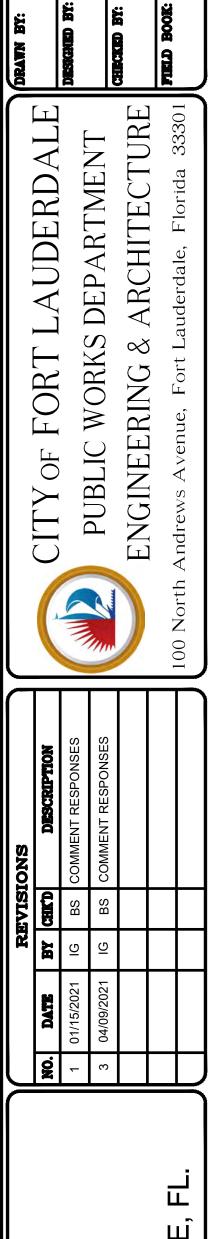

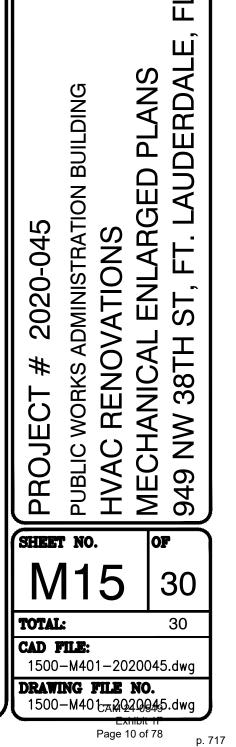


 \checkmark

0

0

O

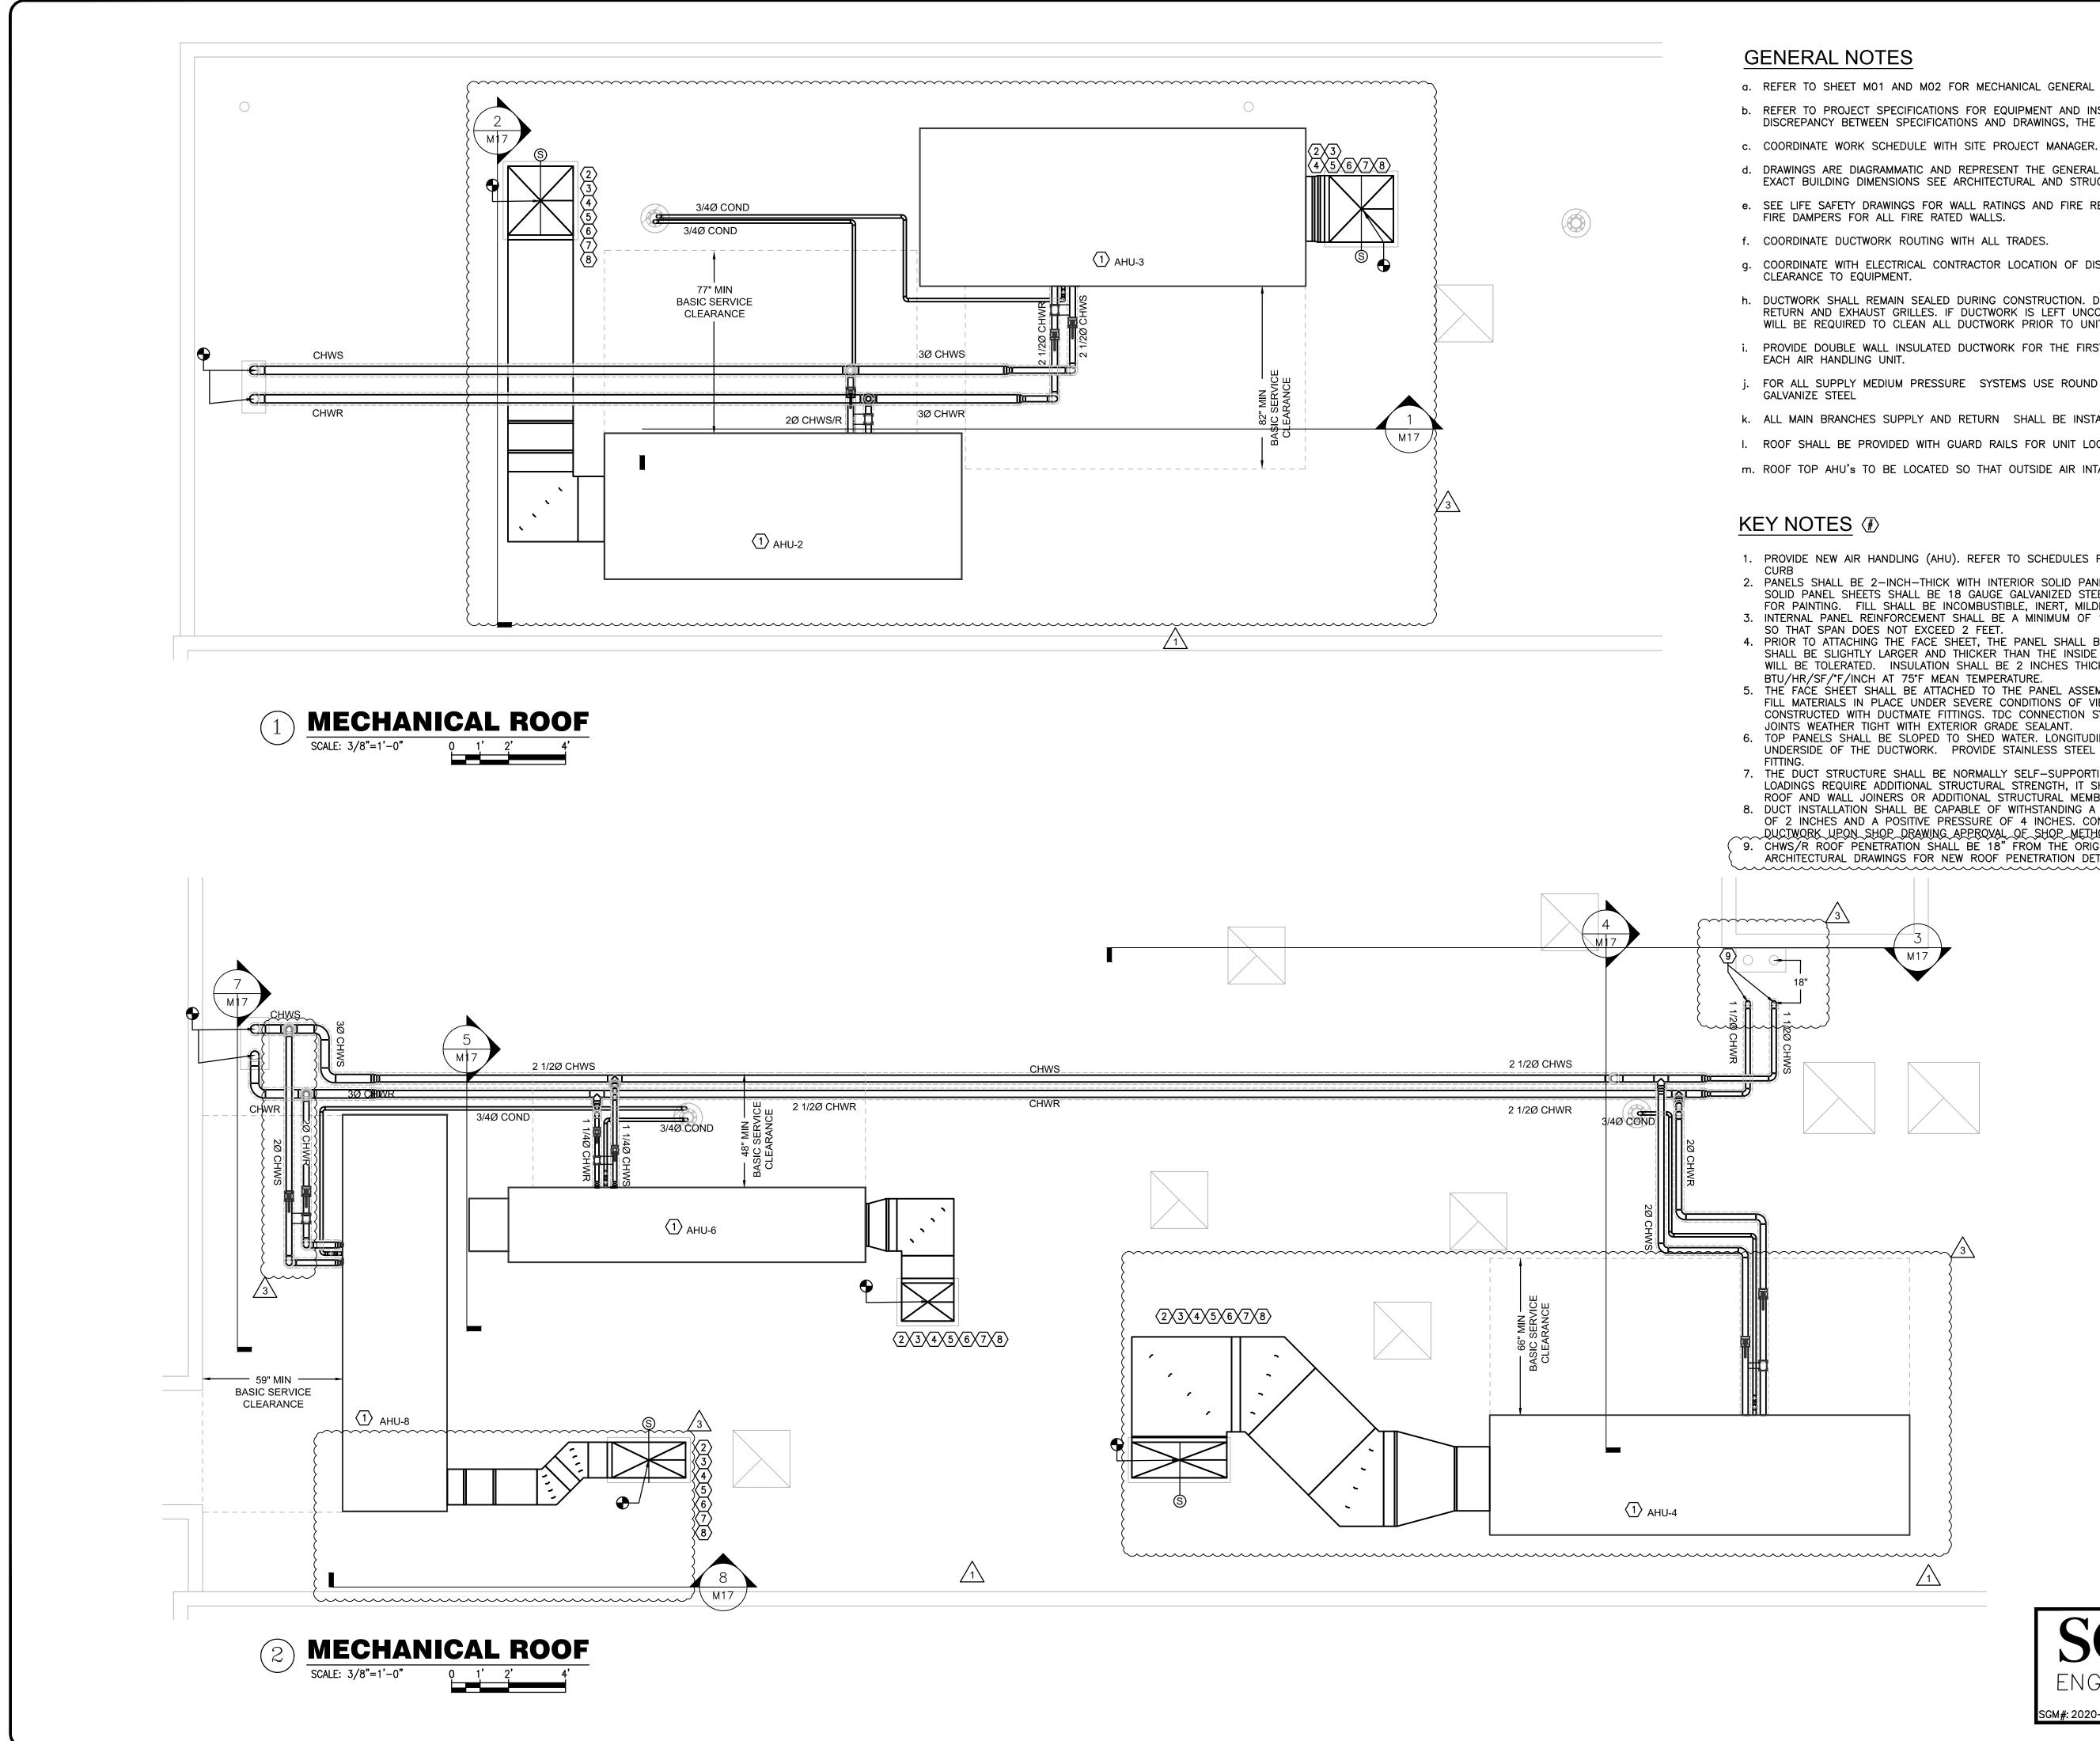

JCENSr ' 78419

STATE OF 12 ORIDA

a. REFER TO SHEET MO1 AND MO2 FOR MECHANICAL GENERAL NOTES AND SYMBOLS LEGEND.

b. REFER TO PROJECT SPECIFICATIONS FOR EQUIPMENT AND INSTALLATION REQUIREMENTS. IF THERE IS ANY DISCREPANCY BETWEEN SPECIFICATIONS AND DRAWINGS, THE MOST STRINGENT REQUIREMENT SHALL APPLY.

d. DRAWINGS ARE DIAGRAMMATIC AND REPRESENT THE GENERAL LAYOUT OF MECHANICAL COMPONENTS, FOR EXACT BUILDING DIMENSIONS SEE ARCHITECTURAL AND STRUCTURAL DRAWINGS.

e. SEE LIFE SAFETY DRAWINGS FOR WALL RATINGS AND FIRE RESISTANCE ASSEMBLIES REQUIREMENT. PROVIDE FIRE DAMPERS FOR ALL FIRE RATED WALLS.

f. COORDINATE DUCTWORK ROUTING WITH ALL TRADES.

g. COORDINATE WITH ELECTRICAL CONTRACTOR LOCATION OF DISCONNECTS. DO NOT BLOCK SERVICE

h. DUCTWORK SHALL REMAIN SEALED DURING CONSTRUCTION. DURING START-UP INSTALL FILTERS AT ALL RETURN AND EXHAUST GRILLES. IF DUCTWORK IS LEFT UNCOVERED DURING CONSTRUCTION, CONTRACTOR WILL BE REQUIRED TO CLEAN ALL DUCTWORK PRIOR TO UNIT START-UP.

i. PROVIDE DOUBLE WALL INSULATED DUCTWORK FOR THE FIRST 20 FEET OF SUPPLY AND RETURN FOR

j. FOR ALL SUPPLY MEDIUM PRESSURE SYSTEMS USE ROUND OR FLAT OVAL DUCT FABRICATED OF

k. ALL MAIN BRANCHES SUPPLY AND RETURN SHALL BE INSTALL BETWEEN TRUSSES

I. ROOF SHALL BE PROVIDED WITH GUARD RAILS FOR UNIT LOCATED 10' OR LESS FROM EDGE OF ROOF m. ROOF TOP AHU'S TO BE LOCATED SO THAT OUTSIDE AIR INTAKE IS 10' AWAY FROM ANY EXHAUST FAN.

1. PROVIDE NEW AIR HANDLING (AHU). REFER TO SCHEDULES FOR DETAILS WITH A 18" FACTORY ROOF 2. PANELS SHALL BE 2-INCH-THICK WITH INTERIOR SOLID PANEL SHEETS STAINLESS STEEL. EXTERIOR SOLID PANEL SHEETS SHALL BE 18 GAUGE GALVANIZED STEEL WITH GALVANIZED COATING SUITABLE FOR PAINTING. FILL SHALL BE INCOMBUSTIBLE, INERT, MILDEW RESISTANT AND VERMIN-PROOF. 3. INTERNAL PANEL REINFORCEMENT SHALL BE A MINIMUM OF 18 GAUGE STAINLESS STEEL AND SPACED


SO THAT SPAN DOES NOT EXCEED 2 FEET. 4. PRIOR TO ATTACHING THE FACE SHEET, THE PANEL SHALL BE FILLED WITH INSULATING FILL. THE FILL SHALL BE SLIGHTLY LARGER AND THICKER THAN THE INSIDE DIMENSIONS OF THE PANEL. NO VOIDS WILL BE TOLERATED. INSULATION SHALL BE 2 INCHES THICK WITH A K_FACTOR OF 0.23


5. THE FACE SHEET SHALL BE ATTACHED TO THE PANEL ASSEMBLY SO AS TO COMPRESS AND HOLD THE FILL MATERIALS IN PLACE UNDER SEVERE CONDITIONS OF VIBRATION. EXTERIOR JOINTS SHALL BE CONSTRUCTED WITH DUCTMATE FITTINGS. TDC CONNECTION SYSTEM IS NOT PERMITTED. SEAL ALL


6. TOP PANELS SHALL BE SLOPED TO SHED WATER. LONGITUDINAL JOINTS SHALL BE LOCATED ON THE UNDERSIDE OF THE DUCTWORK. PROVIDE STAINLESS STEEL HAT CHANNELS OVER EACH DUCTMATE

7. THE DUCT STRUCTURE SHALL BE NORMALLY SELF-SUPPORTING. WHERE ROOF SPANS AND WALL LOADINGS REQUIRE ADDITIONAL STRUCTURAL STRENGTH, IT SHALL BE FURNISHED EITHER BY HEAVIER ROOF AND WALL JOINERS OR ADDITIONAL STRUCTURAL MEMBERS. 8. DUCT INSTALLATION SHALL BE CAPABLE OF WITHSTANDING A NEGATIVE INTERNAL STATIC AIR PRESSURE OF 2 INCHES AND A POSITIVE PRESSURE OF 4 INCHES. CONTRACTOR MAY CONSTRUCT DOUBLE WALL DUCTWORK UPON SHOP DRAWING APPROVAL OF SHOP METHODS AND DETAILS. 9. CHWS/R ROOF PENETRATION SHALL BE 18" FROM THE ORIGINAL LOCATION, AS SHOWN. SEE ARCHITECTURAL DRAWINGS FOR NEW ROOF PENETRATION DETAILS.



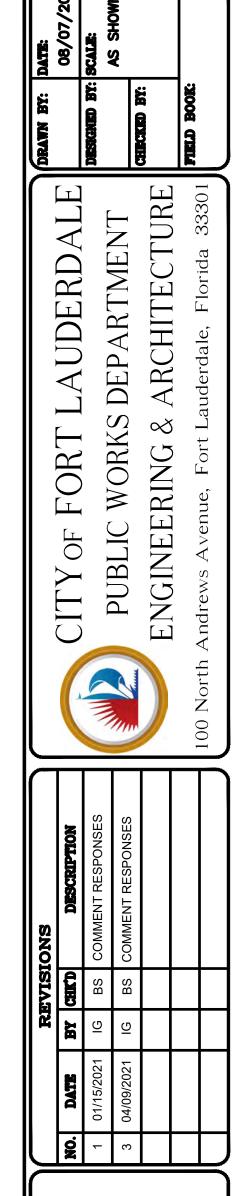

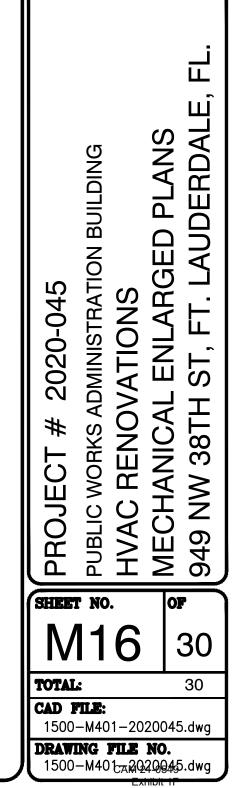

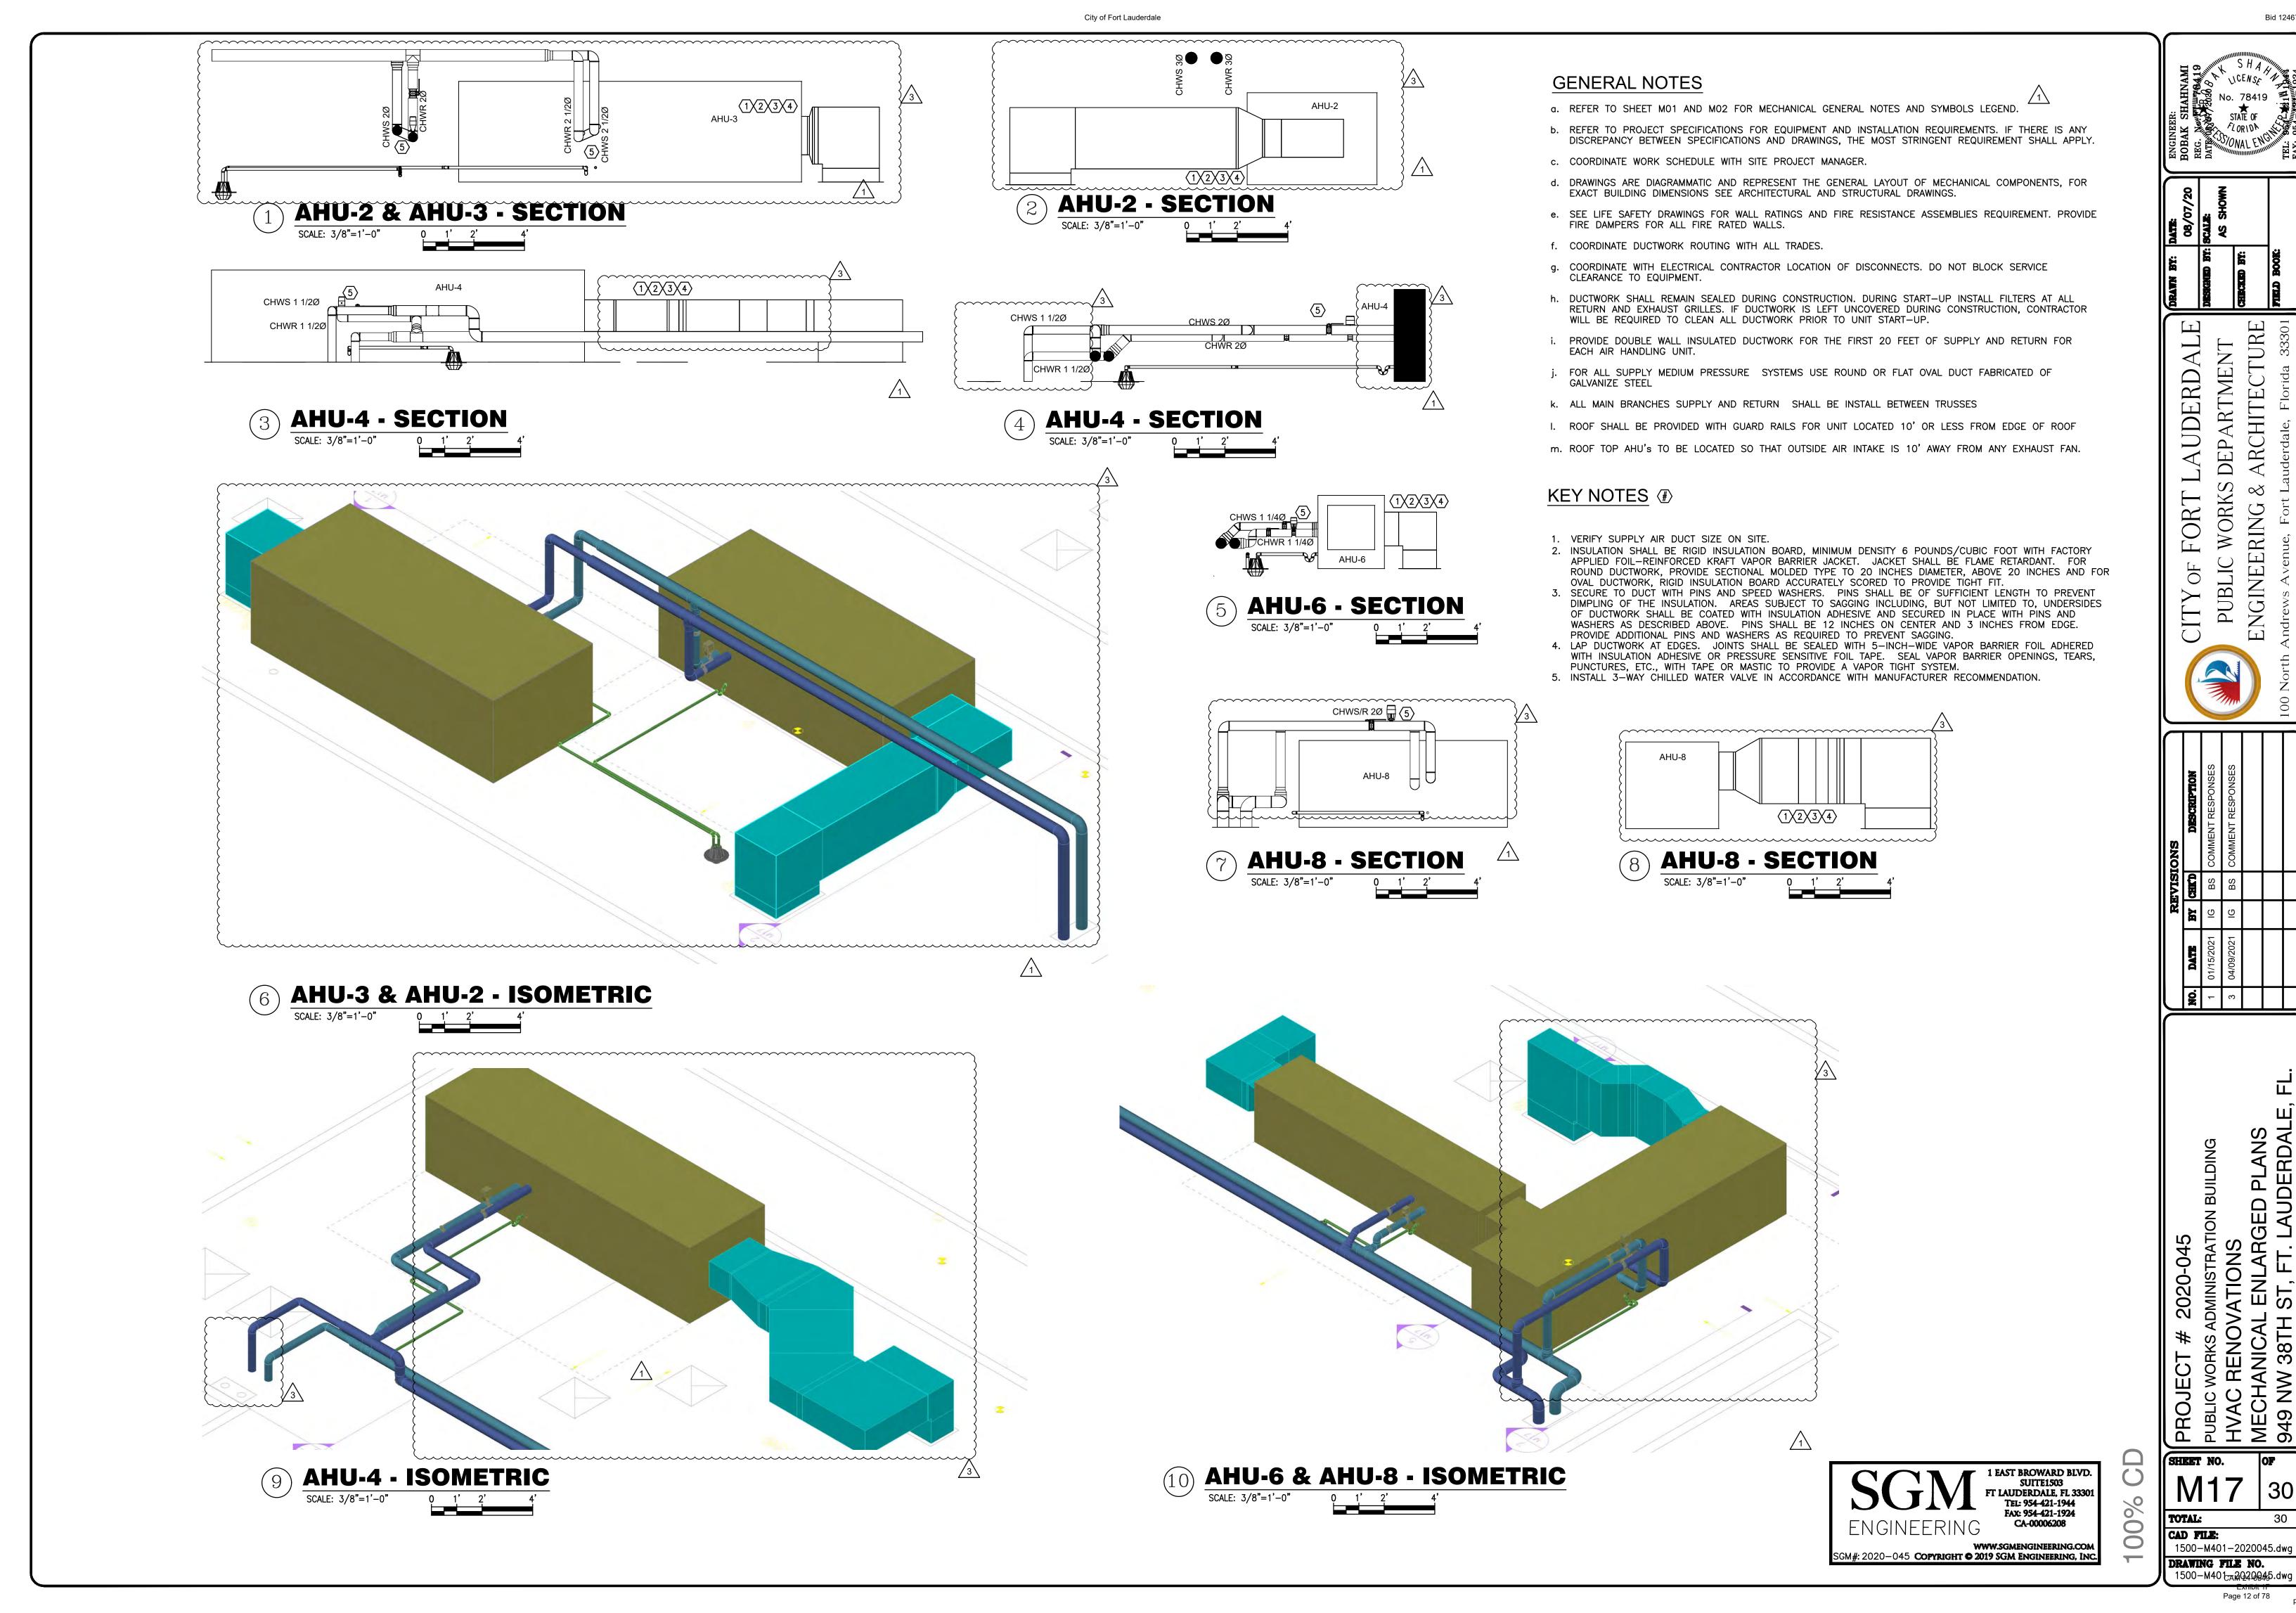



) CENSA 78419

STATE OF

ZORIDA

URE

 \square

μ

TIL

Ţ

RC

 \triangleleft

 \propto

 \mathcal{O}

NGINEERIN

MEN

AR

DEP

 \mathcal{L}

ORK


 \geq

UBLIC

Ы

30

ERDAI

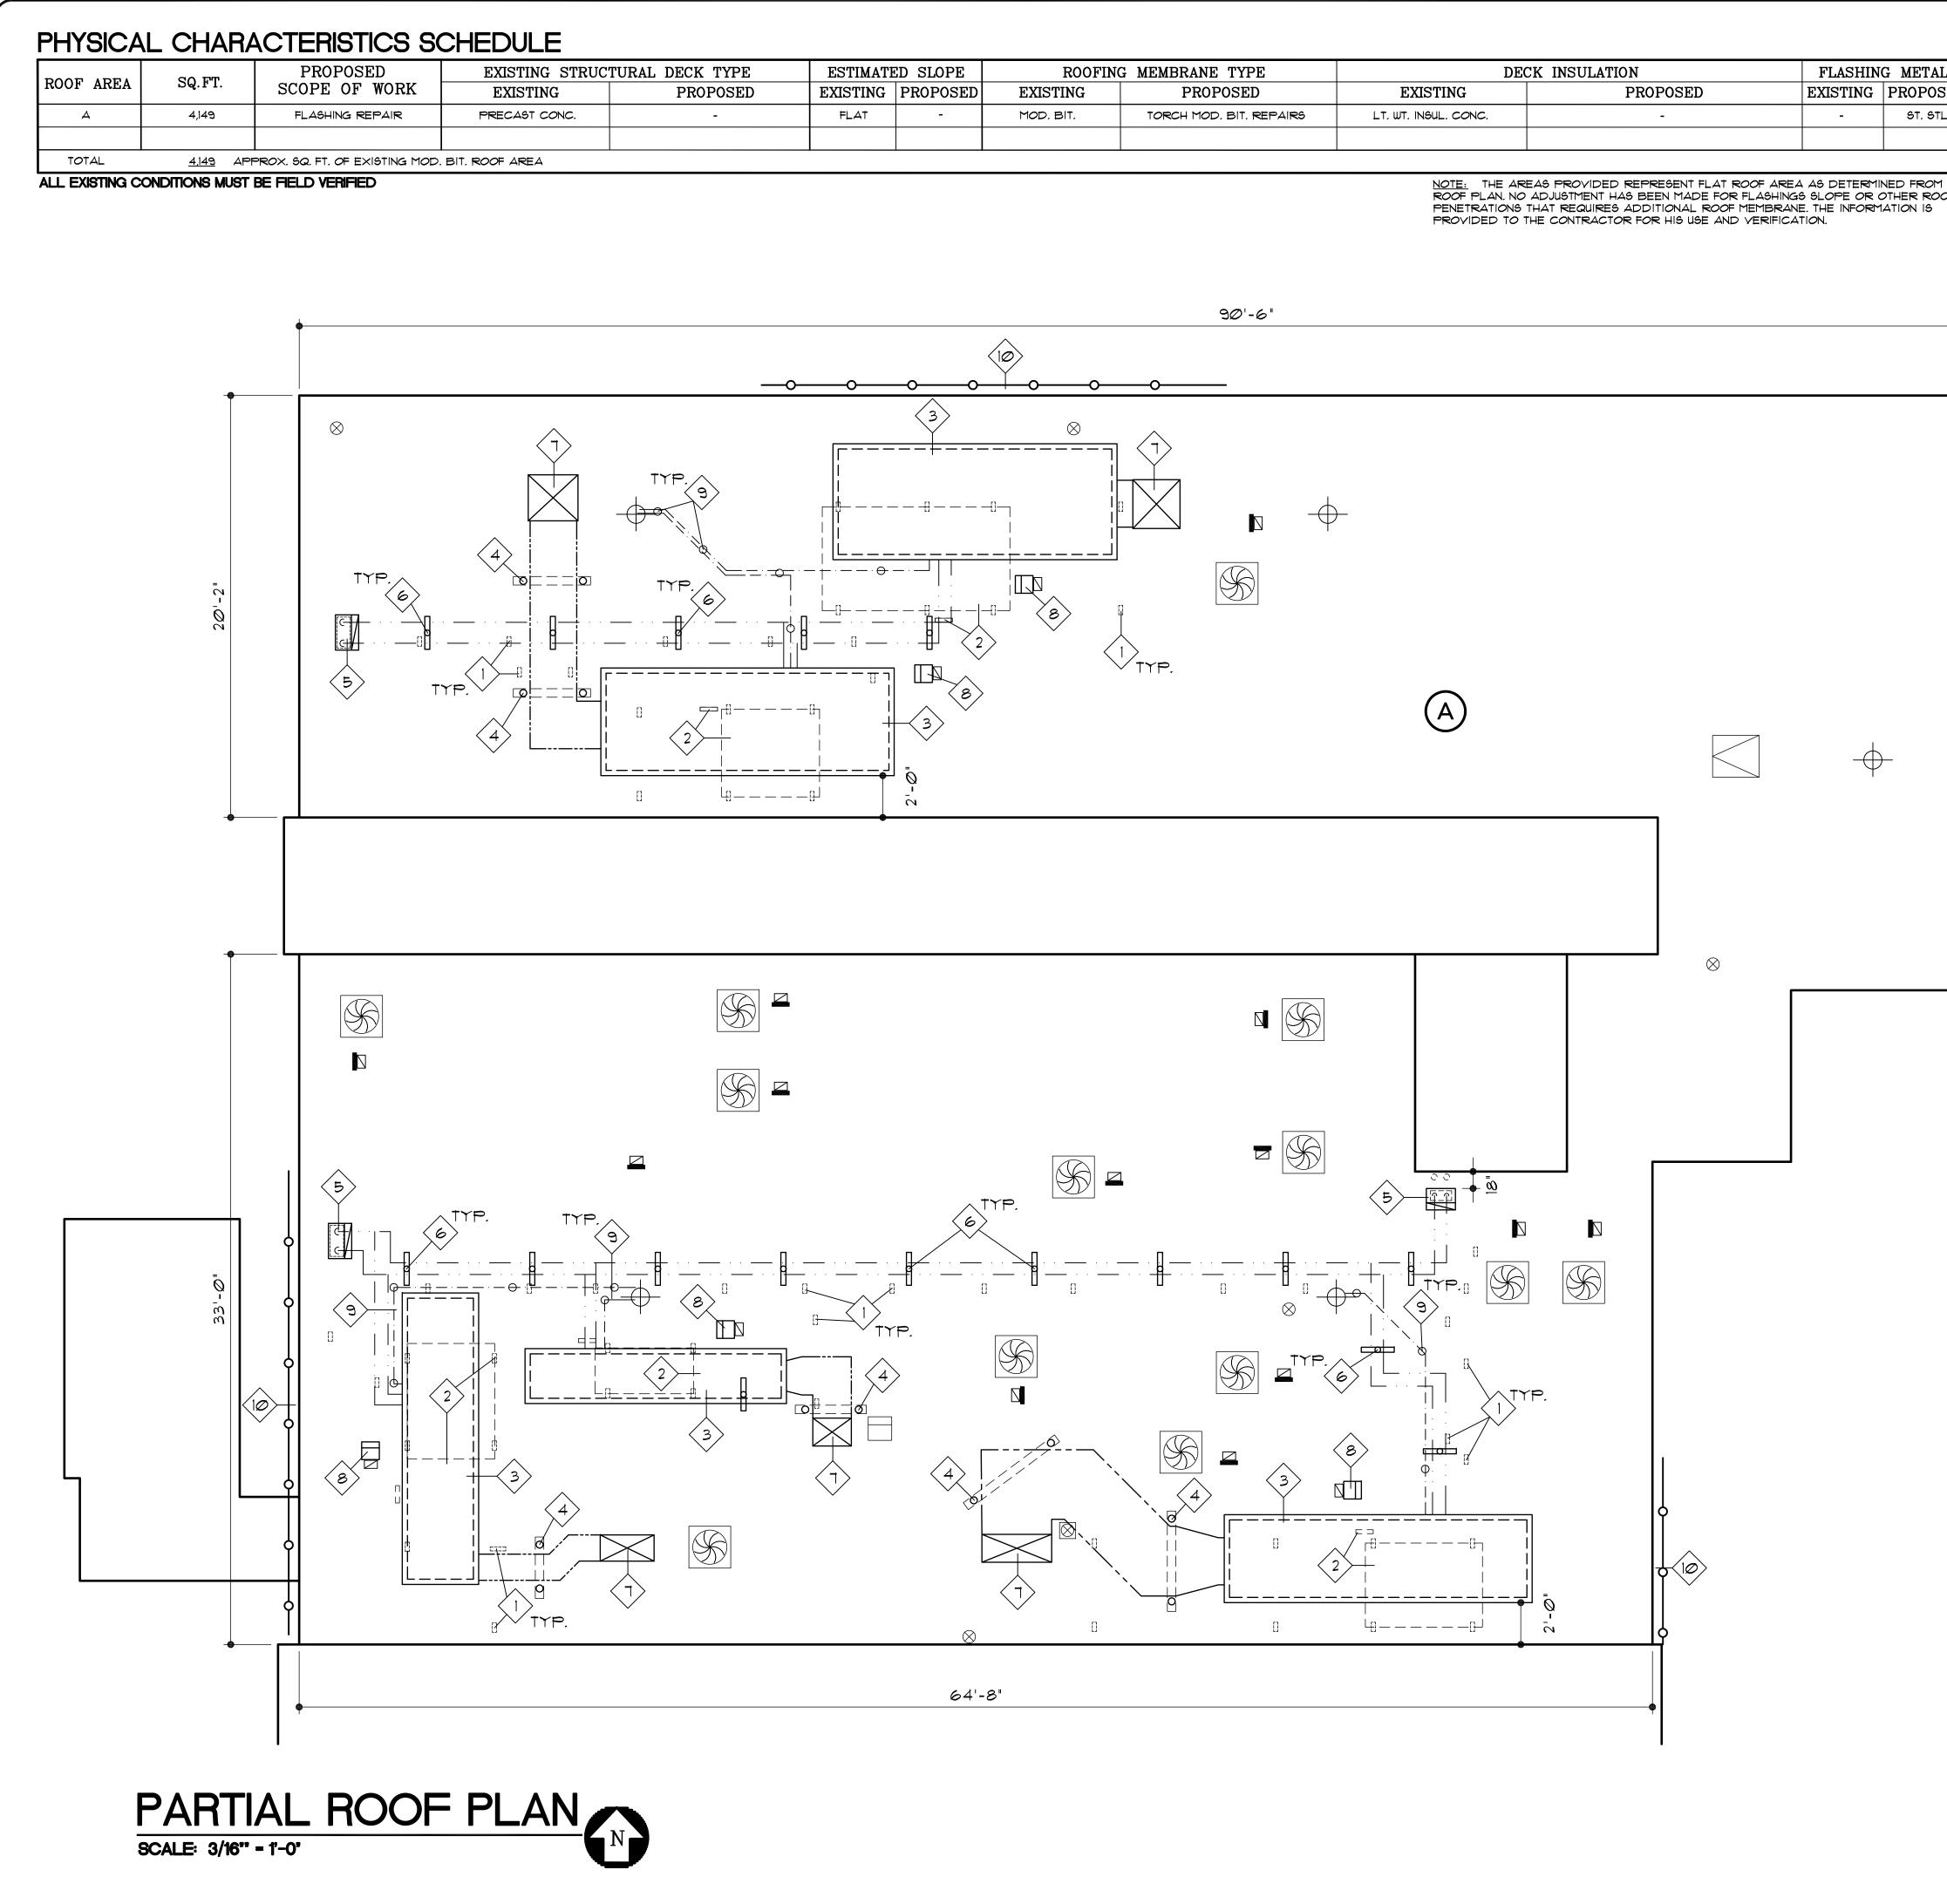

| TED SLOPE ROOFING MEMBRANE TYPE | | DEC | FLASHING MET | | | | |
|---------------------------------|----------|-----------|-------------------------|----------------------|----------|----------|---------|
| ŗ | PROPOSED | EXISTING | PROPOSED | EXISTING | PROPOSED | EXISTING | PROPOS |
| | - | MOD. BIT. | TORCH MOD. BIT. REPAIRS | LT. WT. INGUL. CONC. | - | - | ST. STL |
| | | | | | | | |

944 924

| L | |
|--------|--|
| SED | |
| ΓL. | |
| | |
| | |
| 1 THIS | |

SYMBOLS LEGEND

| | L3 LEGEND | | | MM 68 |
|-----------|--|-----------------|---|------------------------------------|
| | ROOF EDGE CHILLER LINES | | EXIST HVAC UNIT (TO BE REMOVED) | IEER: K SHAHNAMI No: FL74989 |
| _·· | CONDENSATE LINE NEW DUCT WORK | | NEW LARGE HVAC UNIT | ENGINEER BOBAK S REG. No:] |
| O | GUARDRAIL SYSTEM | | NEW DUCT WORK SUPPORT | |
| \otimes | SANITARY VENT PIPE PENETRATION | \square | DUCT WORK CURB PENETRATION | 07/2 |
| 5223 | EXIGT. PITCH PANS (TO BE REMOVED) | | NEW CHILLER LINE SUPPORT | DATE: 08/ |
| | EXIST. EMERGENCY SHUT-OFF TO REMAIN | | NEW WEATHERHEAD At chiller lines | BY: |
| | EXIST. ROOF DRAIN TO REMAIN | | EMERGENCY SHUT-OFF AT NEW WEATHERHEAD | DRAWN TJG |
| Ś | POWER VENT (TO REMAIN) | (A) | ROOF I.D. | (H) |
| | EXIST. WEATHERHEAD | (BØ2.1) | DETAIL NUMBER | AI |
| | ROOF HATCH | $\overbrace{1}$ | SPECIFIC NOTE ROOF AREA ID | RD |

SPECIFIC NOTES

- REMOVE ABANDONED SUPPORT POSTS OR CONDUIT WIRING DOWN TO STRUCTURAL DECK. REMOVE ALL ASSOCIATED PITCH PANS AND PATCH ROOF MEMBRANE PER DETAIL (BØ3.1)
- 2 EXISTING LARGE HVAC UNITS, SUPPORT FRAMING, DUCT WORK AND ASSOCIATED ELECTRICAL CONDUIT TO BE REMOVED.
- 3 NEW HVAC UNIT AND PRE-MANUFACTURED CURB TO BE LOCATED PER PLANS. INSTALL NEW TWO-PIECE RECEIVER AND COUNTERFLASHING TRANSITION PRIOR TO HVAC INSTALLATION- SEE DETAIL (B02.1) FOR FLASHING, COORDINATE INSTALLATION OF NEW UNIT, ELECTRICAL AND CHILLER PIPING CONNECTION WITH MECHANICAL PLANS.
- NEW DUCT WORK PO<u>ST SU</u>PPORT STANDS @ MINIMUM 6' O.C. -FLASH PER DETAIL(BØ3.2). COORDINATE DUCT WORK ROUTING $\langle 4 \rangle$ PER MECHANICAL PLANS.
- INGTALL NEW WEATHERHEAD AND PRE-MANUFACTURED CURB 5 AT EXISTING CHILLER PIPE PENETRATION. FLASH PER DETAIL (B02.5). RELOCATE PENETRATION (WHERE REQ'D.) A MINIMUM 18" FROM EDGE OF ROOF, WALL OR CURB. COORDINATE INSTALLATION WITH MECHANICAL PLANS.
- NEW CHILLER LINES TO BE FASTENED TO DECK MOUNTED SUPPORTS SEE DETAIL (BØ3.3) FOR FLASHING COOPDIN. SUPPORTS - SEE DETAIL (BØ3.3) FOR FLASHING. COORDINATE PIPE ROUTING AND SUPPORT POST SPACING WITH MECHANICAL PLANS.
- EXISTING DUCT PENETRATION CURB TO BE RAISED, INSTALL TWO-PIECE COUNTERFLASHING RECEIVER (PVC COATED) AND FLASH PER DETAIL (B02.4). APPLY SINGLE-PLY MEMBRANE AROUND PROPOSED DUCT WORK, TERMINATE BY FULLY HEAT WELDING TO NEW FLASHING RECEIVER.
- AS REQUIRED PROVIDE NEW SMALL WEATHERHEAD AND PRE-MANUFACTURED CURB FOR ELECTRICAL CONDUIT AND DISCONNECT/SHUT-OFF ASSOCIATED WITH NEW LARGE HVAC UNITS. INSTALL PER DETAIL (B03.4). FIELD VERIFY LOCATION OF CURB. LOCATE A MINIMUM OF 18" FROM NEW OR EXISTING CURBS OR WALL CONDITIONS
- PROVIDE NEW A/C CONDENSATE DRAIN USING FIELD PAINTED, UV RESISTANT PVC PIPING ON COMPOSITE SUPPORT BLOCK AT 4'-0" O.C. MAX. SEE DETAIL (B04.1). (৽>
- , INSTALL NEW ALUMINUM WALL MOUNTED GUARD RAILS ALONG ROOF PERIMETER NEARBY LARGE HVAC UNITS AS INDICATED PER PLANS. FABRICATE RAILS AND SECURE PER DETAIL(B04.2) $\langle | \mathcal{O} \rangle$



Associates, Inc. Architecture Roof Consulting Construction Technology

1 EAST BROWARD BLVD.

SUITE1503 FT LAUDERDALE, FL 33301


TEL: 954-421-1944 FAX: 954-421-1924

CA-00006208

601 North Fern Creek Avenue Suite 100 Orlando, FL. 32803-4899 Tel. 407-896-7875 Fax. 407-898-6043

ENGINEERING

WWW.SGMENGINEERING.COM SGM#: 2020-045 COPYRIGHT © 2019 SGM ENGINEERING, INC.

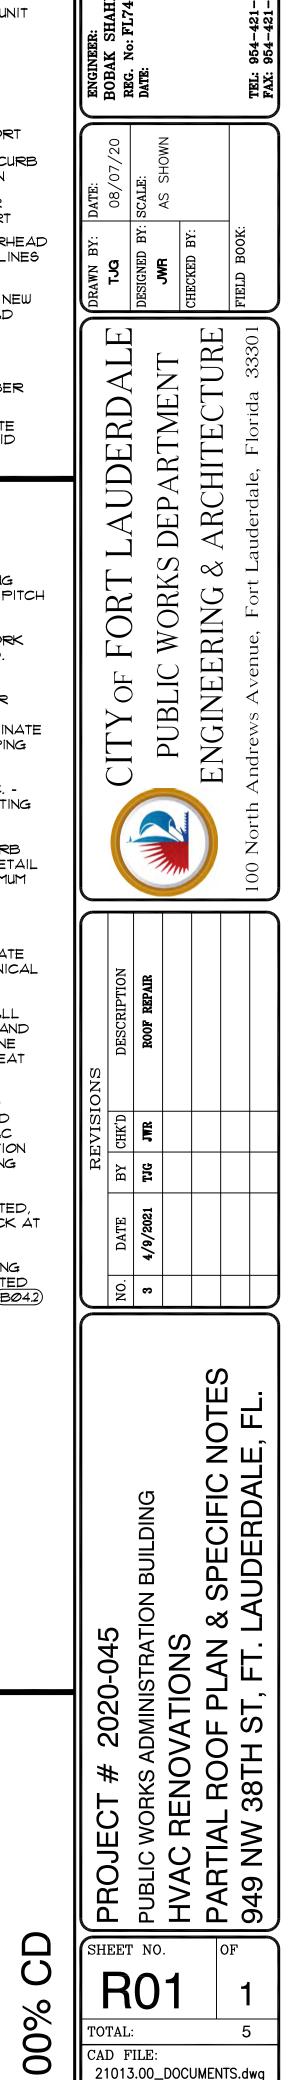


'OTAL:

CAD FILE:

21013.00_DOCUMENTS.dwg

DRAWING FILE NO. 21013.00_QQGUMEATS.dwg

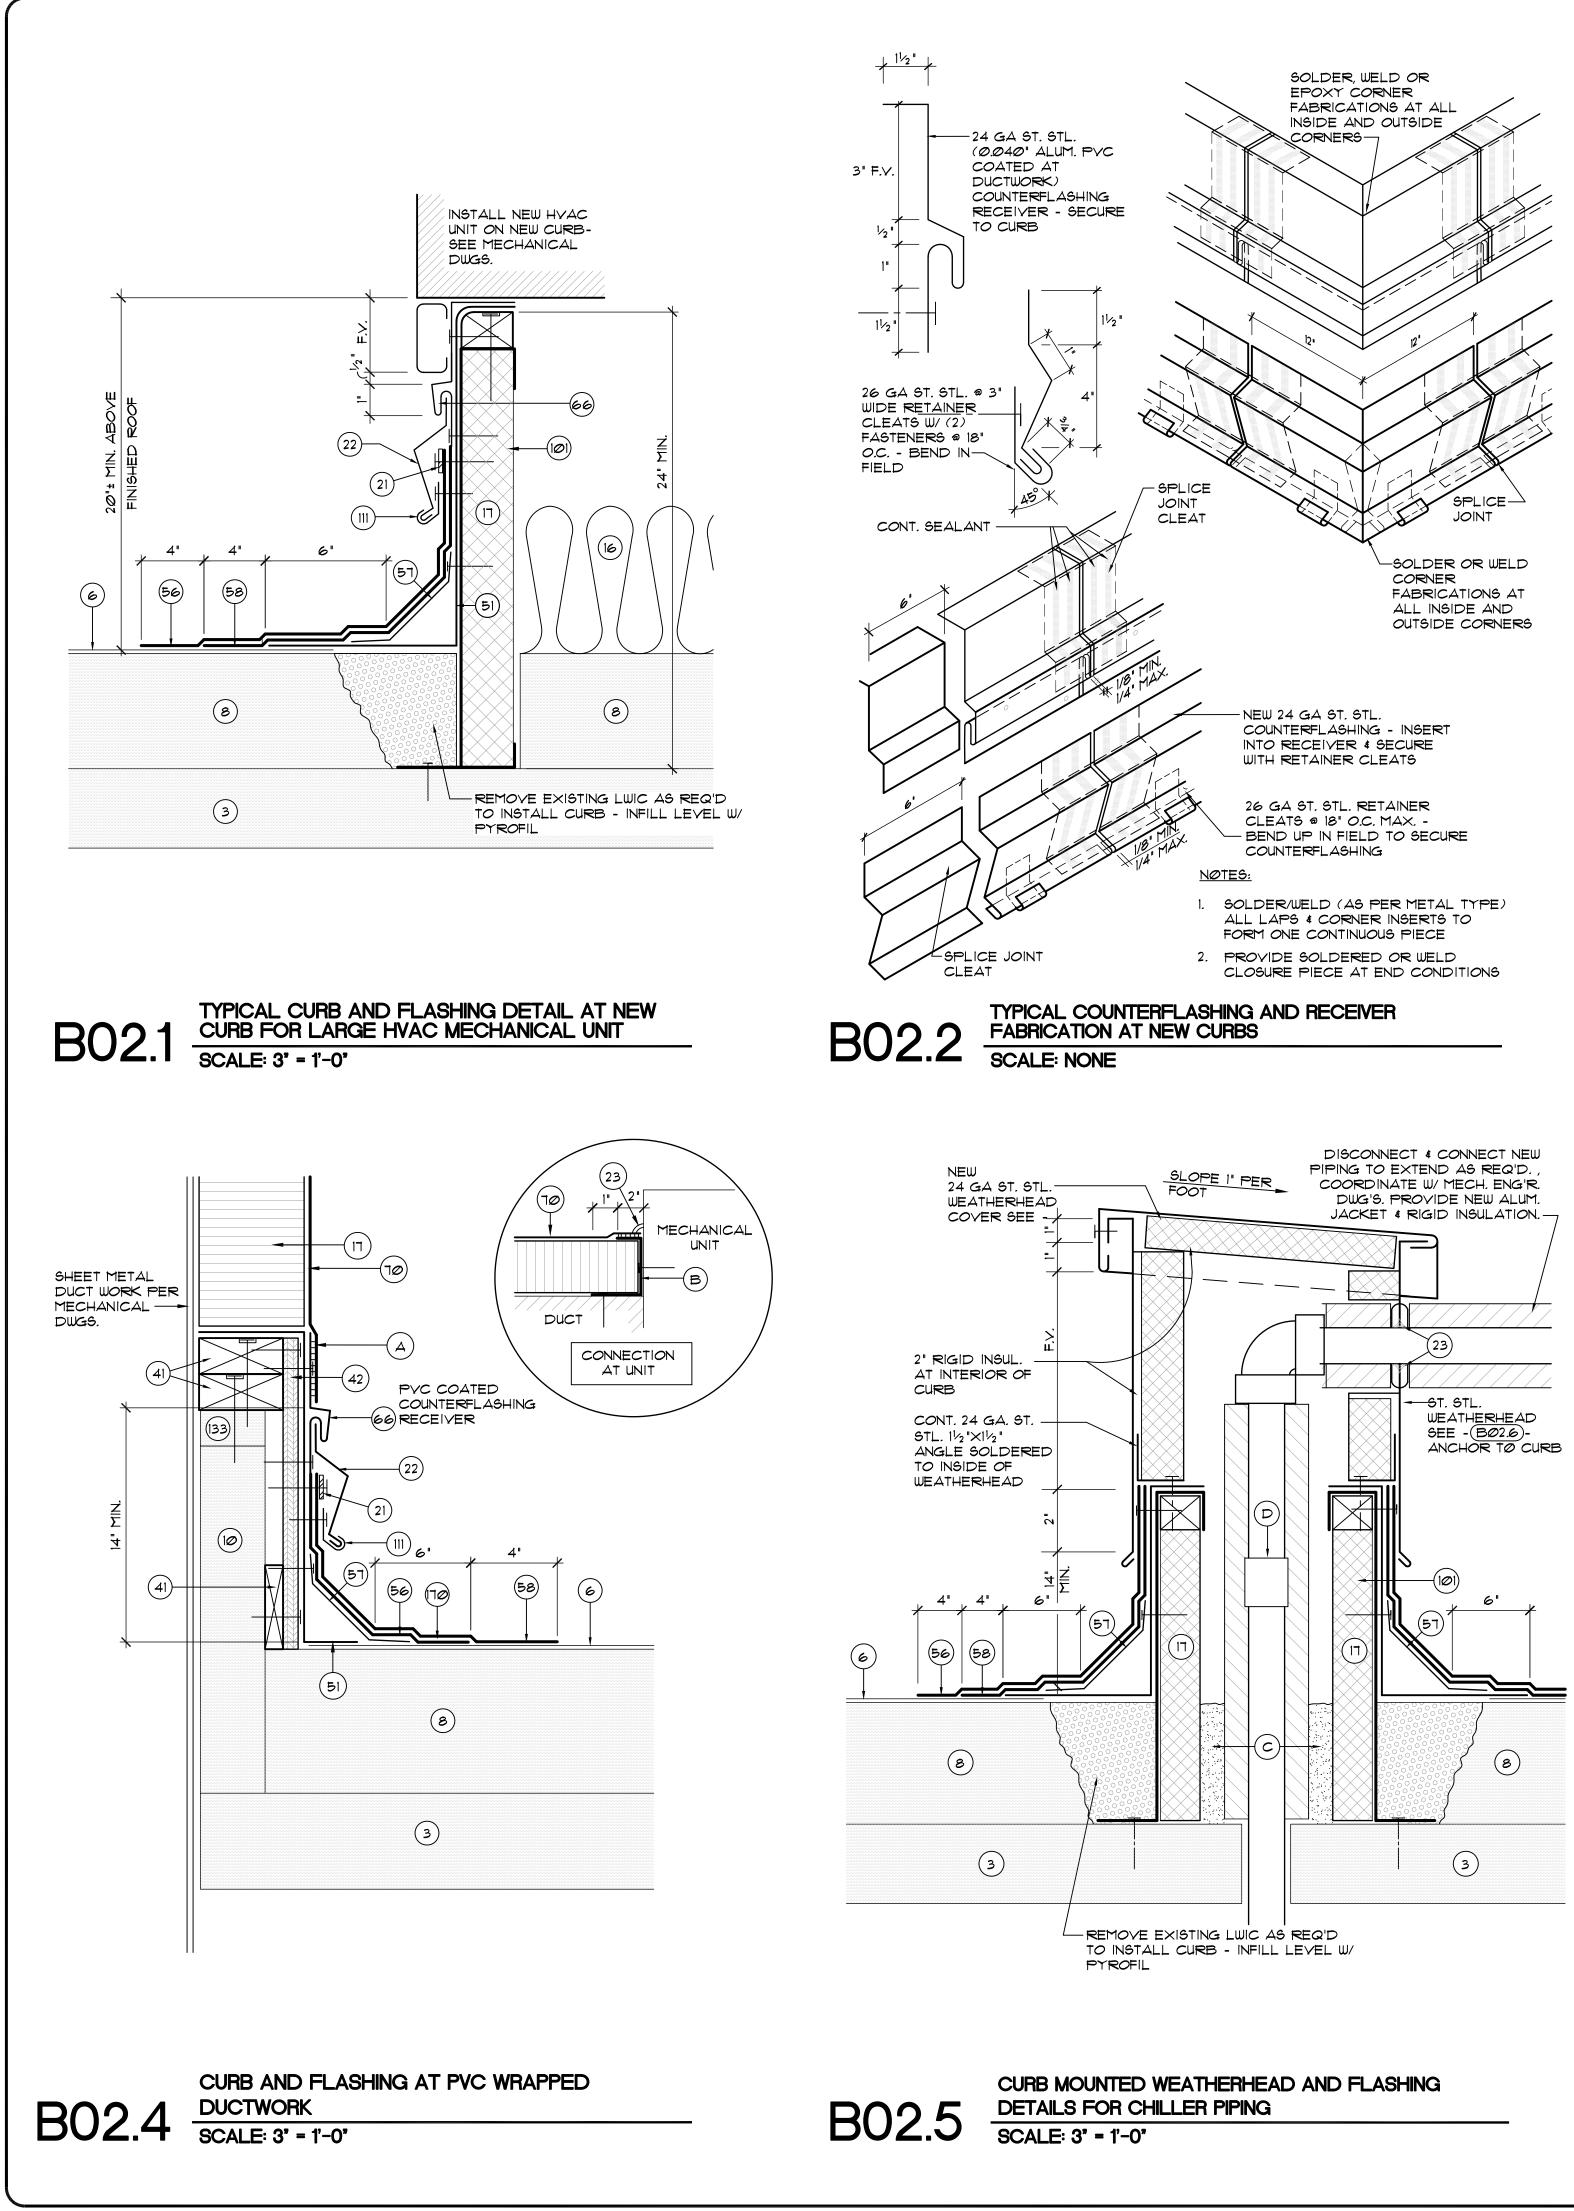


ALL CORNERS & JOINTS -— G 90 GALV. STL. CURB -TO BE FULLY WELDED SEE CHART BELOW FOR GAGE TTP. P.T. WOOD - BLOCKING WITHIN CURB SLOPE BOTTOM OF CURB IF ROOF DECK IS SLOPED -1 1/2" RIGID BOARD INSULATION <u>NOTE:</u> ADHERED TO INTERIOR OF CURB 1. WELD ALL LAPS & CORNERS TO FORM ONE CONTINUOUS PIECE

> 2. DIMENSIONS NOT GIVEN TO BE FIELD VERIFIED.

<u>SECTION</u>

| | CURB DATA | | | | | | | | |
|-------------|-------------|---------------|---|--|--|--|--|--|--|
| MIN SIZE | MAX SIZE | METAL GAGE | ANCHORAGE - CONC DECK | | | | | | |
| - | 24" SQ | 2Ø GA. | 1/4" + × 21/4" LG. TAPCONS@ 24" O.C. | | | | | | |
| 25" SQ | 60" SQ | 18 GA. | 1/4" + × 21/4" LG. TAPCONS@ 18" O.C. | | | | | | |
| 61" SQ | 12Ø" SQ | 16 GA. | $\frac{1}{4}$ " $\phi \times \frac{2}{4}$ " LG. TAPCONS@ 12" O.C. | | | | | | |
| 121" SQ | 24Ø" SQ | 14 GA. | ³%"¢ x 3" RAWL-BOLT @ 24" O.C. | | | | | | |




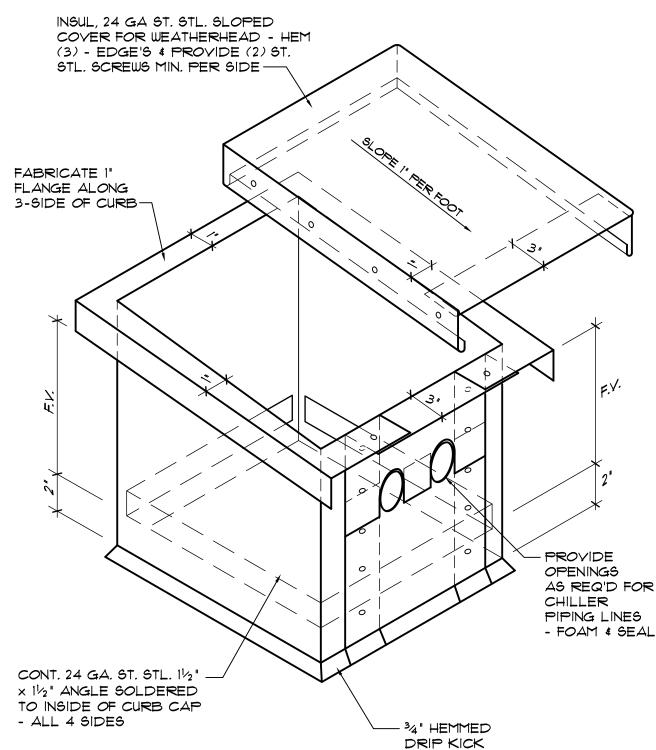



CHILLER PIPING WEATHERHEAD FABRICATION

Bid 12467-113

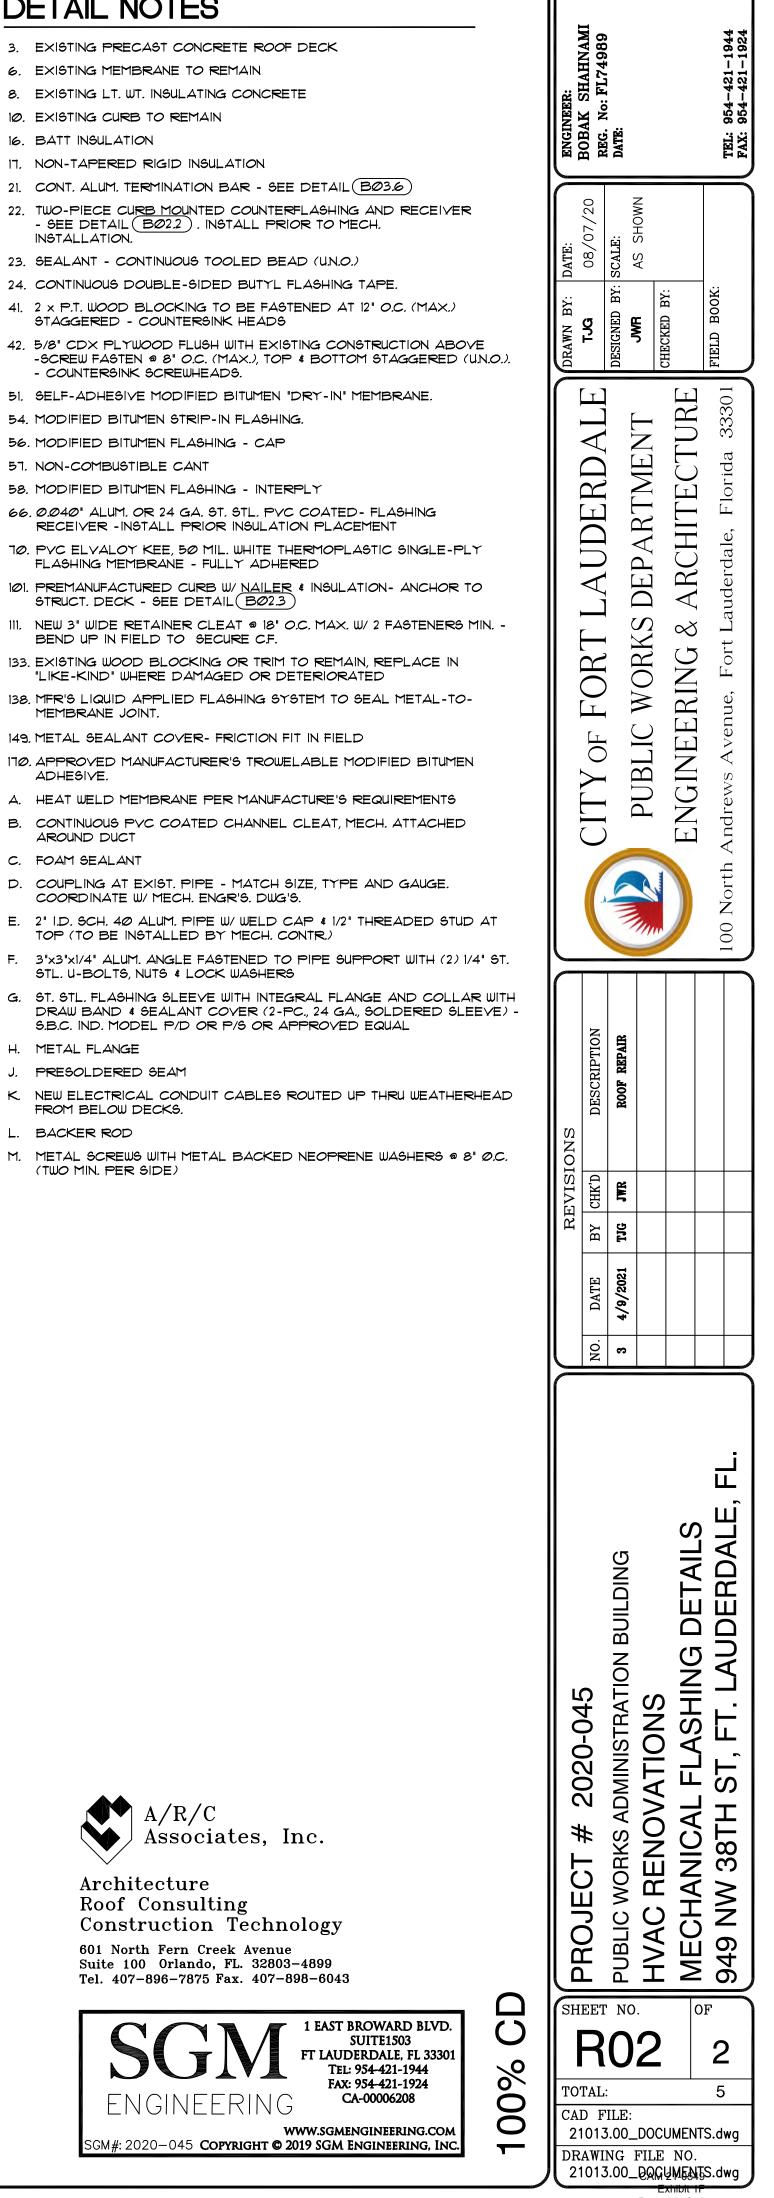

DETAIL NOTES

10. EXISTING CURB TO REMAIN

- COUNTERSINK SCREWHEADS.

57. NON-COMBUSTIBLE CANT

MEMBRANE JOINT.

ADHESIVE.

AROUND DUCT

C. FOAM SEALANT

H. METAL FLANGE

BACKER ROD


PRESOLDERED SEAM

FROM BELOW DECKS.

(TWO MIN. PER SIDE)

16. BATT INGULATION


INSTALLATION.

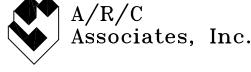

Architecture Roof Consulting Construction Technology 601 North Fern Creek Avenue Suite 100 Orlando, FL. 32803-4899 Tel. 407-896-7875 Fax. 407-898-6043



Page 14 of 78 p. 721

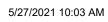



WEATHERHEAD FOR CONDUIT AND CURB INSTALLATION AND FLASHING DETAIL B03.4 SCALE: 11/2" = 1'-0"

REMOVE LUIC TO

CURB

INGTALL NEW PRE-FAB.



FABRICATION DETAIL FOR CURB MOUNTED UTILITY WEATHERHEAD SCALE: NONE

<u>NOTE:</u>

³4" HEMMED DRIP KICK

ONE-PIECE SOLDERED 20 GA. ST. STL. WEATHERHEAD FABRICATION

DISCONNECT SWITCH MTD TO SIDE OF WEATHERHEAD AS REQ'D.

B03.2

FLASHING REPAIR DETAIL AT ABANDONED PITCH PAN OR SUPPORT SCALE: 3" = 1'-0"

NEW ST. STL. WEATHERHEAD

W/ REMOVABLE COVER SEE

4" MIN. F.V.

-PACK/FILL OPEN

END W/ FOAM

(56)

(8)

3

URETHANE PAINT-

-DET. (BØ3.5)

PAINT WITH

B03.1

(M)

24)

 \mathcal{N}

MOUNT-

8

3

(51

DISCONNECT

IF REQ'D.

SWITCH ON SIDE OF WEATHERHEAD


REMOVE ABANDONED - PITCH PAN 4" 4" 4" (6) 58 (56) (56) (58 REMOVE EXISTING-LWIC AS REQ'D TO 8 REMOVE POST - INFILL LEVEL W/ PYROFIL 3 -REMOVE ABANDONED ELEC. CONDUIT AS REQ'D. - INFILL OPENING PRIOR TO INSULATION INFILL.


-REMOVE ABANDONED PIPE

DECK

SUPPORTS FROM STRUCTURAL


NOTE: & GRIND SMOOTH-

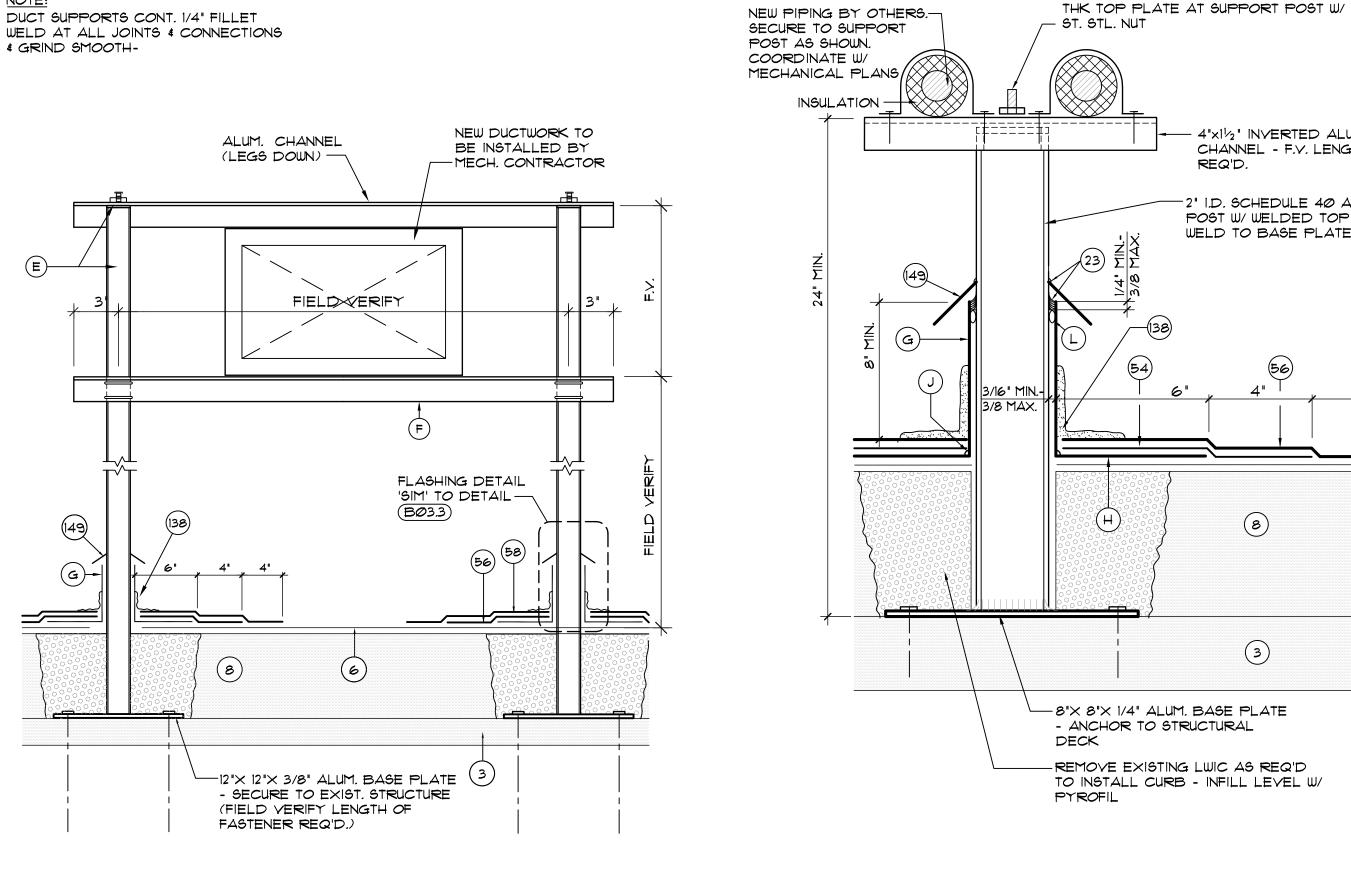

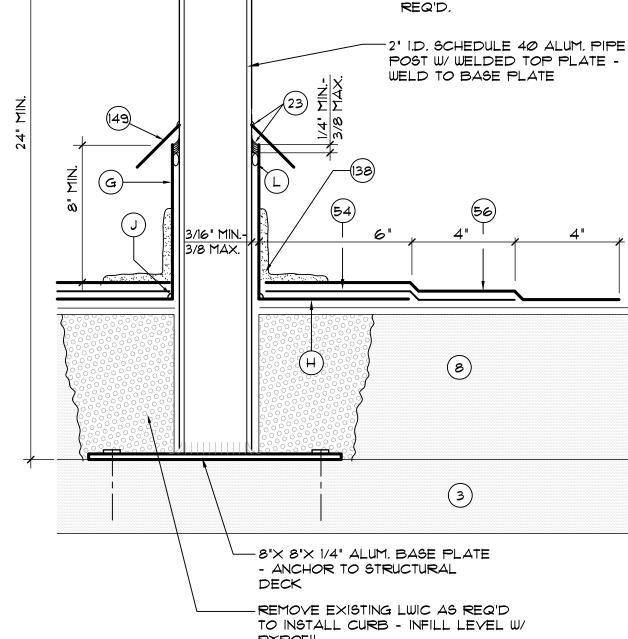


 $\frac{1}{2}$ " THREADED STUD WELDED TO $\frac{1}{4}$ "

DUCT SUPPORT SYSTEM AND FLASHING REPAIR DETAIL SCALE: NONE

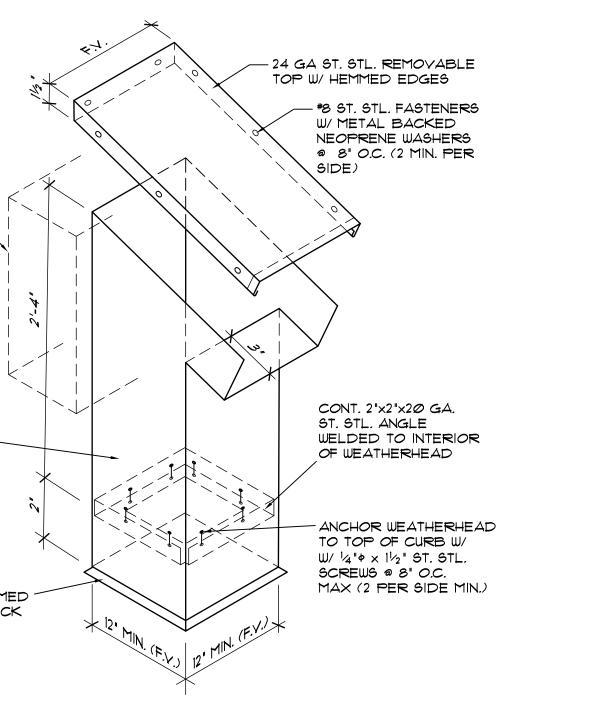

PYROFIL ROOF MOUNTED CHILLER SUPPORT POST FLASHING DETAIL B03.3 SCALE: 3" = 1'-0" EXIST. WALL CONT. SEALANT ERMINATION BAR \bigcirc (ALUM) NEOPRENE WASHER W/ST. STL. SHIELD-

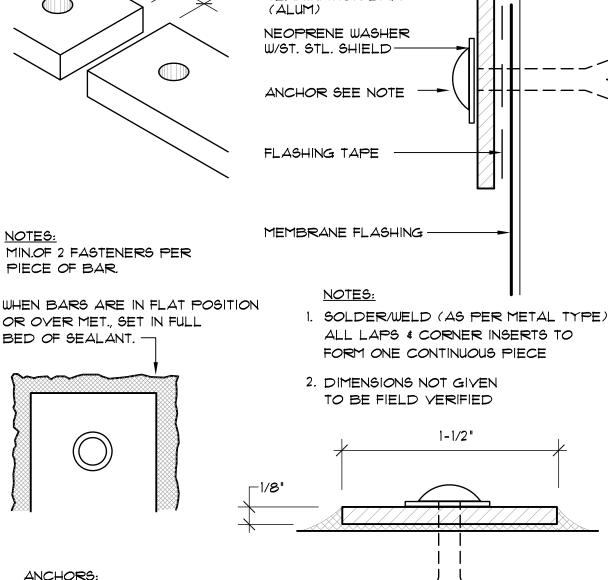

1. WELD ALL LAPS & CORNER INSERTS TO FORM ONE CONTINUOUS PIECE

2. DIMENSIONS NOT GIVEN TO BE FIELD VERIFIED.



NOTES:

PIECE OF BAR.

BED OF SEALANT.

 \bigcirc

WOOD: 3/4" No.10 WOOD SCREW

METAL: 1/2" NO. 10 S.S. SHT. METAL SCREWS

NEOPRENE WASHERS.

CONC. BLK. & CONC .: 1/4" DRIVEPIN OF SUFFICIENT


<u>BRICK:</u> 3/16" \times 2-1/4" TAPCONS WITH METAL BACKED

ANCHORS:

TYPICAL TERMINATION BAR DETAIL SCALE: NONE

LENGTH TO IMBED 1" MIN.

Bid 12467-113

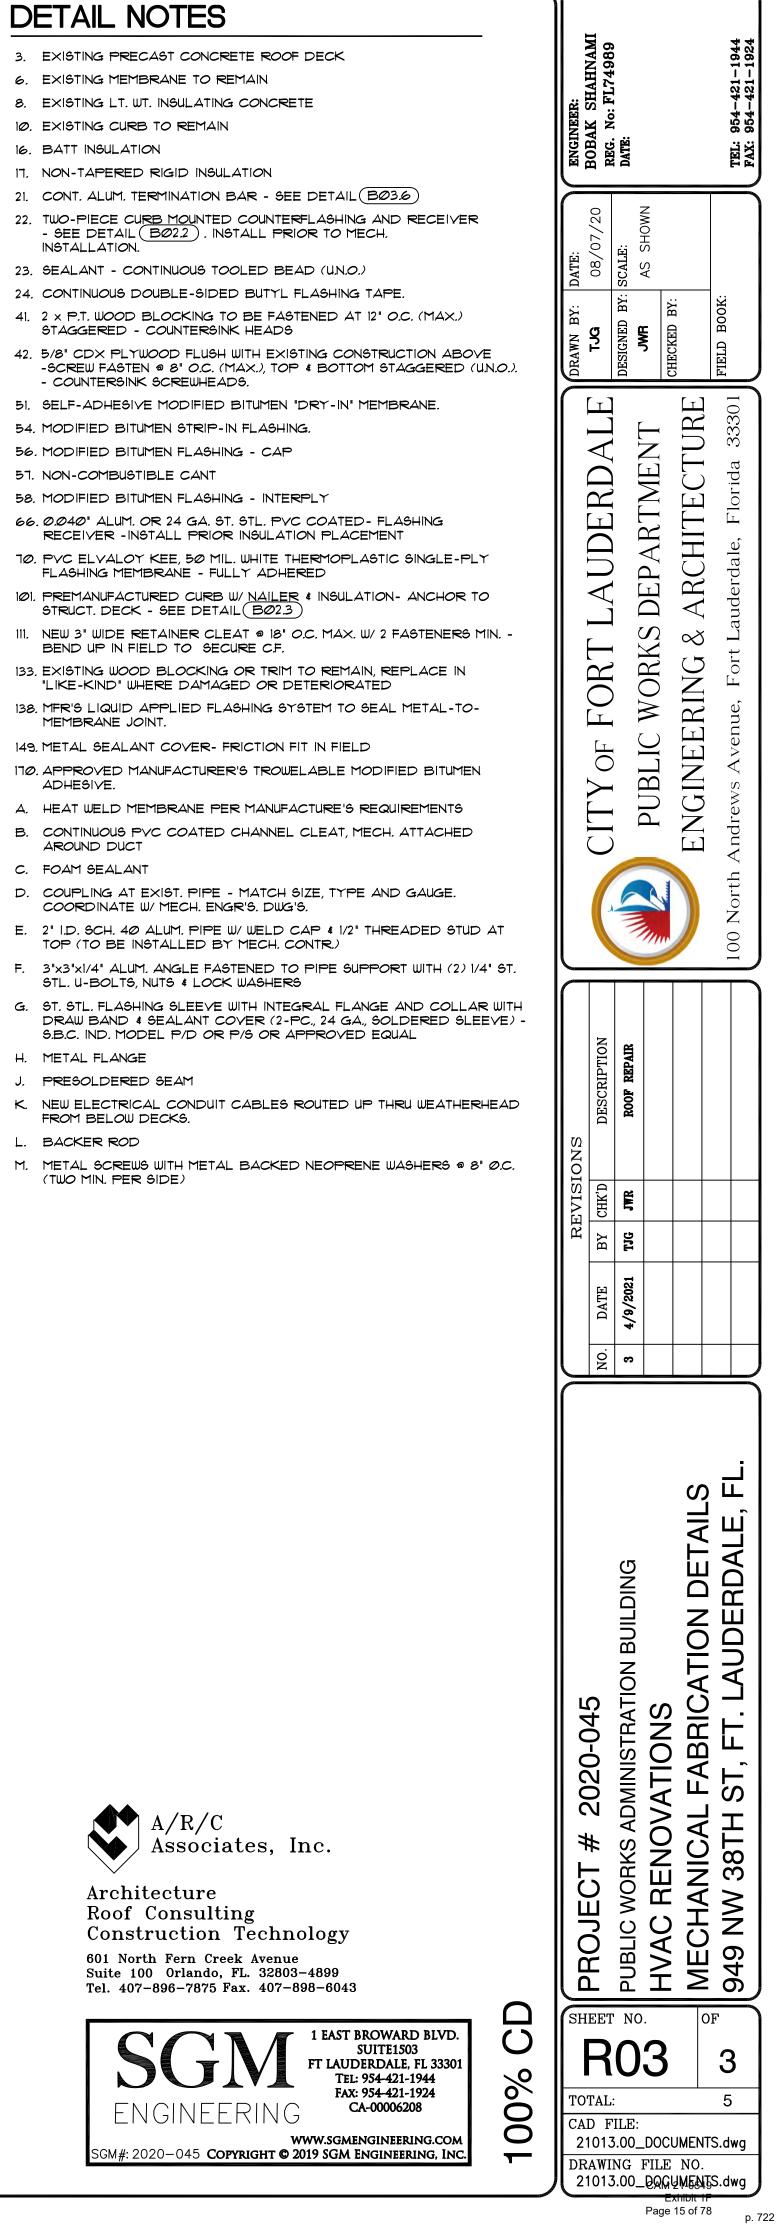

- $4"\times1\frac{1}{2}"$ INVERTED ALUM. CHANNEL - F.V. LENGTH (6) 16. BATT INGULATION

INSTALLATION.

MEMBRANE JOINT.


ADHESIVE.

AROUND DUCT

C. FOAM SEALANT


H. METAL FLANGE


BACKER ROD

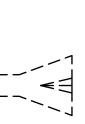



Architecture Roof Consulting Construction Technology 601 North Fern Creek Avenue Suite 100 Orlando, FL. 32803-4899

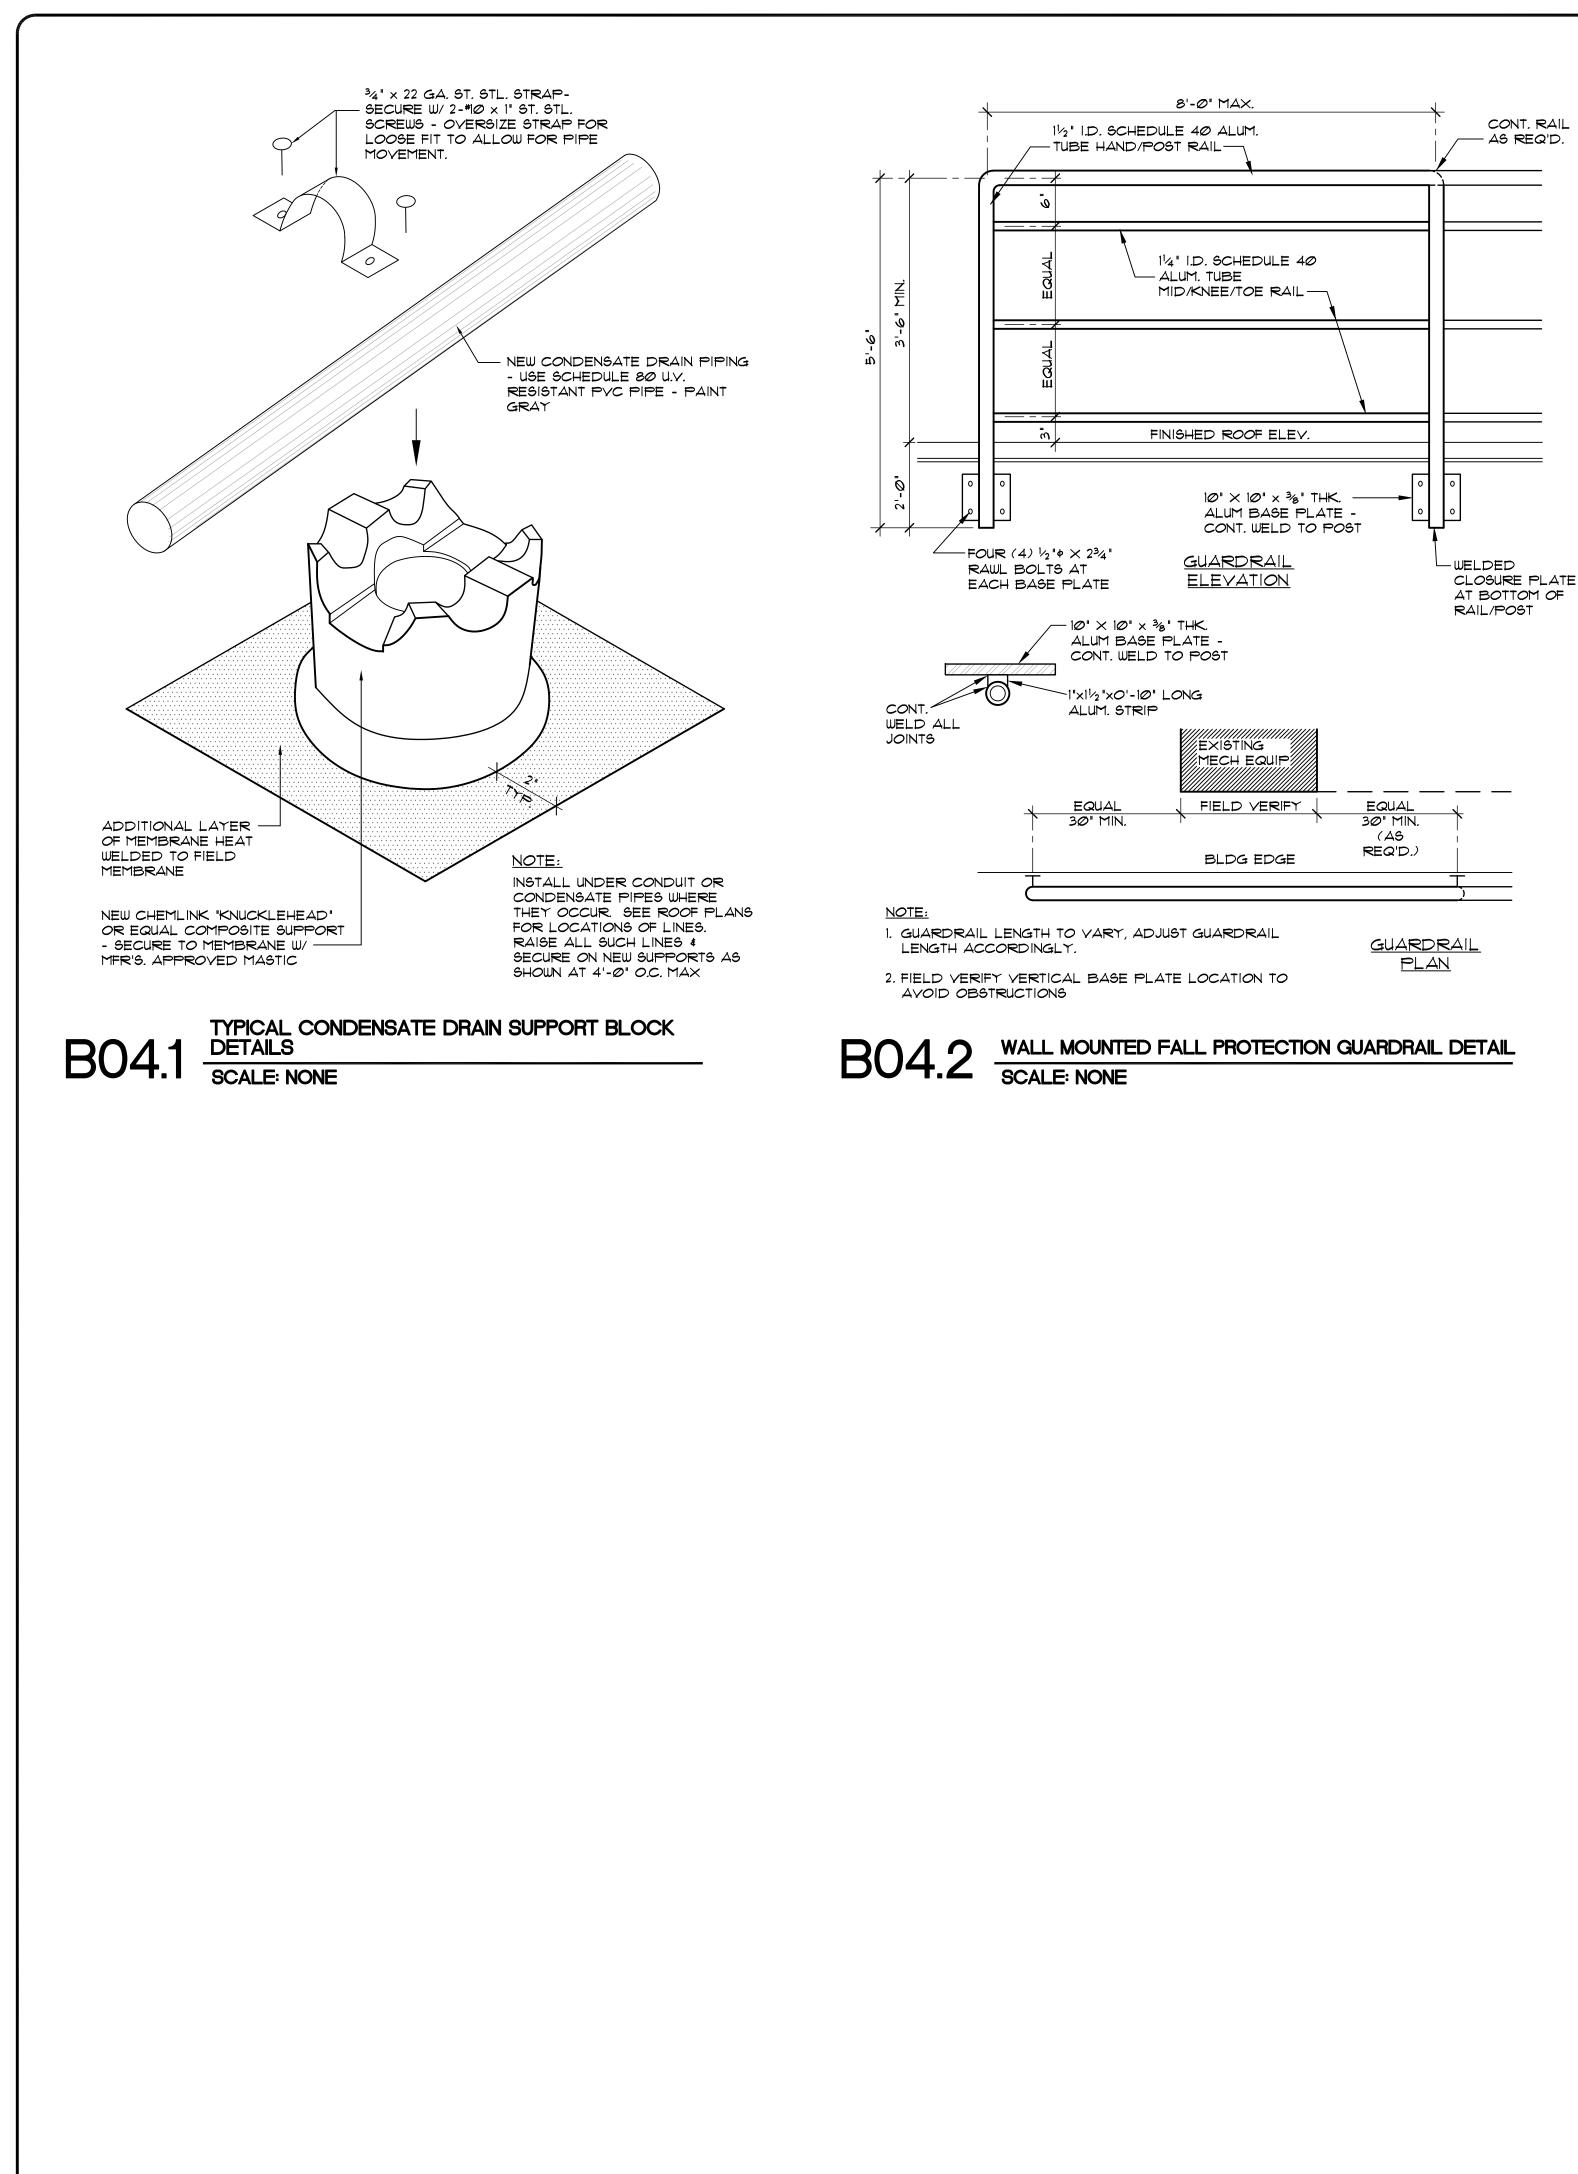

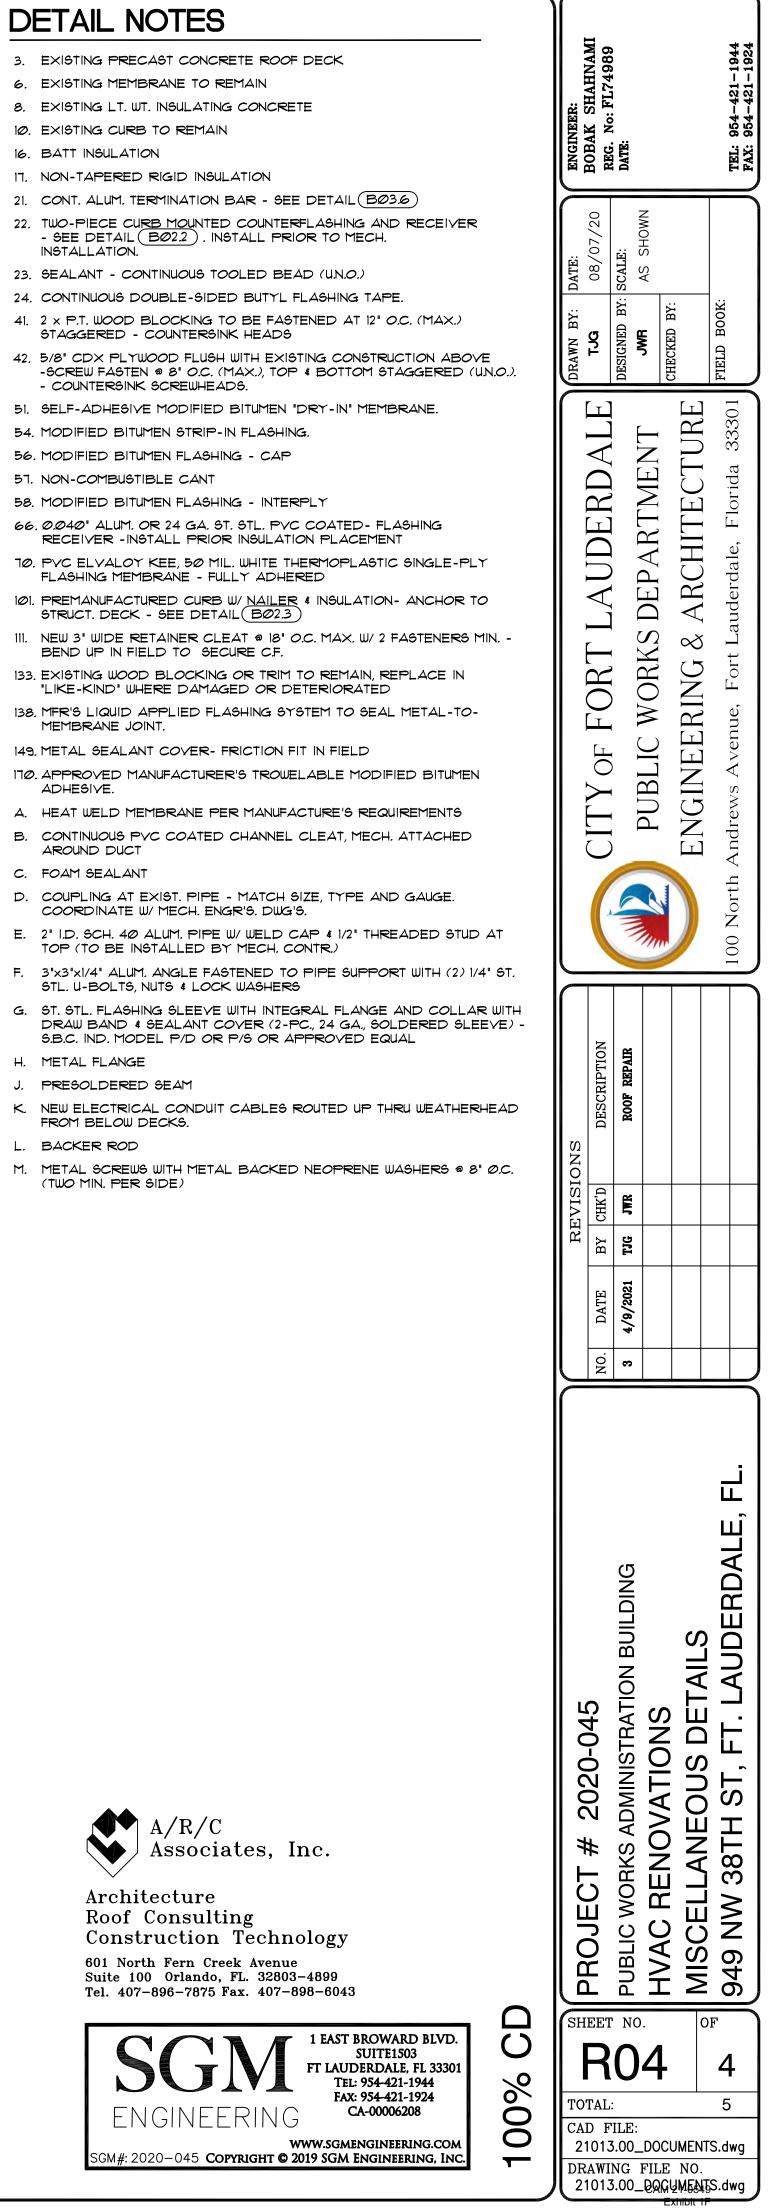

Page 16 of 78 p. 723

| <i>a</i> | | | | | | |
|-----------|---|---|--|---|---------------------|---|
| | GEN | NERAL RO | OFING | NOTES | | |
| 1. | FROM T OF FIEL | | CTURAL DOCU KEN BY A/R/C | | 1Ø. | SHEET METAL DETAIL REQUIRED AS IF SHOU THESE REQUIREMENTS SHOP FABRICATION. |
| | PRE-RE DIMENS THE DIM DIMENS THE CO | EQUISITE FOR BIDDING IONS SHALL BE FIELD 1ENSIONS UTILIZED IN IONS TAKEN, CONFIRM NTRACTOR SHALL VE | THE PROJEC VERIFIED BY BIDDING THE ED OR CORR RIFY ALL DIM | REACH BIDDER SO THAT PROJECT WILL BE THOSE ECTED BY THE BIDDER. IENSIONS, DETAILS, AND | 11. | CONTRACTOR SHALL FINISHING OF ALL SUR THE WORK. WORK NOT REPAIRS AND FINISHE CONDITIONS TO REMA |
| | DISCRE | PANCIES PRIOR TO F | ROCEEDING | | 12. | CONTRACTOR SHALL REPLACE INTERIOR F DAMAGED DURING TH |
| 2. | EXISTIN SITE AF OTHERU VISUAL | G CONDITIONS AT THE RE INCLUDED IN THE F JISE (N.I.C.). THE CONT FIELD SURVEY (PRIOR | E PROJECT SI PROJECT UNLE RACTOR SHA R TO BID) IN | DICATE APPROXIMATE TE. ALL BLDGS. ON THE ESS SPECIFICALLY NOTED ILL BE RESPONSIBLE FOR A REGARD TO QUANTITIES, 4 LOCAL BUILDING CODE. | 13. | CONTRACTOR SHALL REQUIRED TO PROPE AND COMPONENTS WI |
| 3. | PROJEC THE SIT NEARB DETER ITEMS IN GIVEN T FINISHE | CT ARCHITECT AND OU E AND PHOTO AND V Y THAT MAY BE AFFEC 1INE THE CONTRACTOR N THEIR CURRENT STA TO CEILING, LIGHT FIXT | UNERS REPRE IDEO TAPE TH CTED BY THIS R'S RESPONS TUS, SPECIAL TURES, EXTER TC. PARTICUL | CONTRACTOR WITH THE ESENTATIVE SHALL VISIT HE SITE AND ALL SPACES PROJECT IN ORDER TO IBILITY IN KEEPING THOSE ATTENTION SHALL BE IOR AND INTERIOR WALL ARLY IN THOSE AREAS RVED. | | |
| 4. | SHALL BOTH T DISCON | BE OPERATED IN THE HE CONTRACTOR AND | PRESENCE C OWNER PRIC CAL FUNCTION | COMPONENTS (EQUIPMENT) DF REPRESENTATIVES OF DR TO ANY DEMOLITION OR NG, IN ORDER TO ESTABLISH TIONS. | | |
| 5. | REMOV PROPE RELOC, ITEMS F | AL TO ASSURE THAT I RLY REMOVED AND I ATED ARE PROTECTE | TEMS SCHEDU TEMS TO REM, D FROM DAM, OT TO RE REI | RING DEMOLITION AND ILED FOR DEMOLITION ARE AIN AND/OR TO BE AGE, ALL SALVAGEABLE USED SHALL BE DISPOSED | | |
| 6. | RENOV, PROTEC | ATION UNLESS ALL EX CTION ARE CONTINUOU | ISTING EXITS ISLY MAINTAIN | DURING REMODELING OR AND ANY EXISTING FIRE NED, OR IN LIEU THEREOF VIDE EQUIVALENT SAFETY. | | |
| ٦. | DAMAG The Pr Repor | E REPORT, WITH PHOT OJECT ARCHITECT ON | OGRAPHS SH | INTERIOR OF STRUCTURES, A IALL BE COMPLETED BY 1/E BEEN NOTIFIED. THE NER AND THE CONTRACTOR | | |
| 8. | BY TEL RESULT THEFT (| EPHONE IN EACH INST ING FROM FIRE, WATER | ANCE OF PRO | E OWNER OR ARCHITECT OPERTY DAMAGE LEGAL ENTRY, VANDALISM, GE WITHIN 24 HOURS OF | | |
| 9. | AND AF OCCURS WERE "(| RE NOT CUT AT EVERY 3. BID AND EXECUTE | LOCATION W A COMPLETE | DRAWINGS ARE "TYPICAL" HERE THE CONDITION E PROJECT AS IF DETAILS UCH CONDITION OR SIMILAR | | |
| | ABE | BREVIATION | NS | | | |
| | J | ADAJACENT | DIA | DIAMETER | LΨ | LIGHTWEIGHT |
| A/C AL | .⊤ | AIR CONDITIONING ALTERNATE | DIM DS | DIMENSION Downspout | LLH LLV | LONG LEG HOR LONG LEG VER |
| ALI AN | IOD | ALUMINUM ANODIZED | DWG: | | MFR | MANUFACTURE(|
| | PROX RCH | APPROXIMATE ARCHITECT(URAL) | E ELEC EL (ELEV) | EAST ELECTRIC(AL) ELEVATION | MATL MAX MECI | MAXIMUM |
| BR | | BEARING | EQ | | MTL | METAL |
| BIT | I | BITUMINOUS BITUMEN | EQUIP EXH | EQUIPMENT EXHAUST | MIN MISC | MINIMUM MIGCELLANEOU |
| BL | | BLOCK | EXIST | EXISTING | MOD | |
| BL BD | .KG > | BLOCKING BOARD | EXP | EXPANGION Exterior | MTD | MOUNTED(ING) |
| BC | | BOTTOM | EXT | EXTERIOR | NOM | NOMINAL |
| | .DG | BUILDING | FIN | FINIGH(ED) | N | |
| BU | R | BUILT UP ROOF | FLASH FLEX | FLASHING FLEXIBLE | | NOT IN CONTRA |
| CIF | 0 | CAST-IN-PLACE | FLEX | FLEXIBLE FOOTING | NTS NO | NOT TO SCALE NUMBER |
| CB | 3 | CATCH BASIN | FDN | FOUNDATION | | |

NS TO REMAIN UNCHANGED.

TOR SHALL PROVIDE ALL SUPPLEMENTAL MATERIALS) TO PROPERLY INSTALL, SUPPORT AND BRACE ALL ITEMS PONENTS WITHIN THE WORK.

| ADJ | ADAJACENT | DIA | DIAMETER | LΨ | LIGHTWEIGHT | RAD | RADIUS |
|--------|-------------------------|-----------|-------------------------------------|------------|---------------------------------------|--------|-----------------------|
| A/C | AIR CONDITIONING | DIM | DIMENSION | LLH | LONG LEG HORIZONTAL | RWL | RAINWATER LEADER |
| ALT | ALTERNATE | DS | DOWNSPOUT | LLV | LONG LEG VERTICAL | REF | REFERENCE |
| ALUM | ALUMINUM | DWG | DRAWING | | | REINF | REINFORCE (D), (MENT) |
| ANOD | ANODIZED | _ | - / | MFR | MANUFACTURE(ER) | RCP | REINF. CONCRETE PIPE |
| APPROX | APPROXIMATE | E | EAST | MATL | MATERIAL(S) | REV | REVISION |
| ARCH | ARCHITECT(URAL) | ELEC | ELECTRIC(AL) | MAX | MAXIMUM | RD | ROOF DRAIN |
| | | EL (ELEV) | ELEVATION | MECH | MECHANIC(AL) | RO | ROUGH OPENING |
| BRG | BEARING | EQ | EQUAL | MTL | METAL | | |
| BIT | BITUMINOUS | EQUIP | EQUIPMENT | MIN | MINIMUM | SCH | SCHEDULE |
| | BITUMEN | Ε×Η | EXHAUST | MISC | MISCELLANEOUS | SEAL | SEALANT |
| BLK | BLOCK | EXIST | EXISTING | MOD | MODIFY / MODIFIED | SHT | SHEET |
| BLKG | BLOCKING | EXP | EXPANSION | MTD | MOUNTED(ING) | SIM | SIMILAR |
| BD | BOARD | EXT | EXTERIOR | | | 5 | SOUTH |
| BOT | BOTTOM | | FINIGH(ED) | NOM | NOMINAL | SPK | SPEAKER |
| BLDG | BUILDING | FIN | | N | NORTH | SPEC | SPECIFICATION(S) |
| BUR | BUILT UP ROOF | FLASH | | NIC | NOT IN CONTRACT | | |
| CIP | CAST-IN-PLACE | FLEX | FLEXIBLE | NTS | NOT TO SCALE | ରେ | SQUARE |
| CB | CATCH BASIN | FTG | FOOTING | NO | NUMBER | SF | SQUARE FEET |
| CLG | | FDN | FOUNDATION | <i>o</i> c | ON CENTER(S) | ST STL | STAINLESS STEEL |
| COL | | GA | GAGE (GAUGE) | | ON CENTER EACH WAY | STD | STANDARD |
| COMP | COMPRESS, | GALV | | OPG | OPENING | STL | STEEL |
| | (ION), (IBLE) | GWB | GYPSUM WALL BOARD | OPP | OPPOSITE | STRUCT | STRUCTURAL |
| CONC | CONCRETE | | | | OUTSIDE DIAMETER | | |
| CMU | CONCRETE | HDWE | HARDWARE | | OUTSIDE DIAMETER OUTSIDE DIMENSION | THK | THICK(NESS) |
| | MASONRY UNIT | HVAC | HEATING/VENTILATION | | | T≰G | TONGUE AND GROOVE |
| CONST | CONSTRUCTION | | /AIR CONDITIONING | PTD | PAINT(ED) | 17P | TYPICAL |
| CONT | CONTINUOUS | HT (HGT) | HEIGHT | PR | PAIR | UNO | UNLESS NOTED OTHERWIS |
| | OR CONTINUE | НM | HOLLOW METAL | PL | PLATE | UNC | |
| CJ | CONTROL JOINT | HORIZ | HORIZONTAL | PLYWD | PLYWOOD | VERT | VERTICAL |
| CTR | CENTER | | | PVC | POLYVINYL CHLORIDE | | |
| C.F. | CUBIC FOOT | | INCLUDE(D), (ING) | PSF | POUNDS PER SQUARE FOOT | WW⊨ | WELDED WIRE FABRIC |
| | | D | INSIDE DIAMETER INSIDE DIMENSION | PSI | POUNDS PER SQUARE INCH | ω | WEST |
| DEMO | DEMOLISH, DEMOLITION | INSUL | INSULATE(D), (ION) | PC | PRECAST CONCRETE | μM | WIRE MESH |
| | | | INTERIOR | PT | PRESSURE TREATED | W/ | WITH |
| | | | INTERIOR | | | W/O | WITHOUT |
| DIAG | DIAGONAL | | | | | WD | WOOD |

ETAL DETAILS AND TRANSITIONS NOT SHOWN SHALL BE AS IF SHOWN, PREPARE, AND SUBMIT SHOP DRAWINGS OF EQUIREMENTS TO THE ARCHITECT FOR APPROVAL PRIOR TO

CTOR SHALL BE RESPONSIBLE FOR REPAIR AND PAINTING / OF ALL SURFACES EXPOSED OR DAMAGED AS A RESULT WORK NOT COVERED BY NEWLY INSTALLED WORK. AND FINISHES SHALL MATCH EXISTING ADJACENT

TOR SHALL BE RESPONSIBLE TO REMOVE REINSTALL OR INTERIOR FINISHES WHICH MAY HAVE BEEN DISTURBED OR D DURING THE CONSTRUCTION PROCESS.

ROOF COMPONENT FASTENING SCHEDULE


A. GENERAL NOTES:

- 1. THIS SCHEDULE AND THE FASTENING METHODS INDICATED HEREIN ARE INTENDED TO ADDRESS TYPICAL CONDITIONS, AND MAY NOT APPLY TO ALL CONDITIONS FOR THIS PROJECT.
- 2. CONTRACTOR / INSTALLER MUST ALSO REFER TO THE DETAILS FOR THIS SPECIFIC PROJECT. IN THE CASE OF CONFLICTING DATA, THE PROJECT SPECIFIC DETAILS SHALL GOVERN.
- 3. FOR ALL CONDITIONS NOT COVERED WITHIN SCHEDULE, REFER TO FASTENER REQUIREMENTS OF THE SPECIFICATIONS OR CONSULT WITH THE ARCHITECT.
- 4. MANUFACTURERS OF SPECIALITY FASTENER SHALL PERFORM FIELD TESTS TO VERIFY WITHDRAWAL VALUES AND FASTENING PATTERNS FOR THE SPECIFIC PROJECT CONDITIONS PRIOR TO INSTALLATION, A WRITTEN REPORT SHALL BE SUBMITTED TO THE ARCHITECT FOR REVIEW AND APPROVAL.
- 5. ALL EXPOSED FASTENERS AND THOSE USED IN PRESSURE TREATED LUMBER SHALL BE STAINLESS STEEL, ALL OTHERS MUST HAVE A CORROSION RESISTANT COATING THAT EXCEEDS F.M. APPROVAL STANDARD 4470, UNLESS NOTED OTHERWISE.
- 6. ALL FASTENERS AND THEIR INSTALLATION METHODS MUST COMPLY WITH THE REQUIREMENTS DEFINED IN THE FLORIDA BUILDING CODE, ROOFING APPLI-CATION STANDARD (RAS) NO. 111 - "STANDARD REQUIREMENTS FOR ATTACHMENT OF PERIMETER WOOD BLOCKING AND METAL FLASHINGS" UNLESS NOTED OTHERWISE,
- B. WOOD BLOCKING (2" NOMINAL THICKNESS)
- CONCRETE: 3/8" DIA, ST, STL, SELF-TAPPING MASONRY SCREW AT 16" O.C. MAX., LENGTH AS REQUIRED FOR 1.15" MIN. EMBEDMENT. OPTION: 5/16" DIA. DEFORMED OR FLUTED NAIL AT 12" O.C. MAX., LENGTH AS REQUIRED FOR 1.25" MIN, EMBEDMENT, COUNTERSINK HEADS AS REQUIRED.
- 2. CONCRETE BLOCK (CMU): 3/8" DIA. ST. STL. SELF-TAPPING MASONRY SCREW AT 12" O.C., MAX., LENGTH AS REQUIRED FOR 1.75" MIN. EMBEDMENT. OPTION: 3/8" DIA, HEAVY DUTY SLEEVE STYLE EXPANSION BOLT ANCHOR (RAWL-BOLT) @ 18" O.C., LENGTH AS REQUIRED FOR 2" MIN. EMBEDMENT. COUNTER-SINK HEADS AS REQUIRED.
- 3. BRICK: 3/8" DIA. ST. STL. SELF-TAPPING MASONRY SCREW AT 12" O.C., MAX., LENGTH AS REQUIRED FOR 1.75" MIN. EMBEDMENT. OPTION: 3/8" DIA. HEAVY DUTY SLEEVE STYLE EXPANSION BOLT ANCHOR (RAWL- BOLT) @ 18" O.C., LENGTH AS REQUIRED FOR 2" MIN. EMBEDMENT. COUNTERSINK HEADS AS REQUIRED.
- 4. STRUCTURAL STEEL: 1/4" DIA. ST. STL. SELF-DRILLING, SELF-TAPPING SCREWS WITH "WINGS" @ 16" O.C. MAX., LENGTH AS REQUIRED FOR 1/2" MIN. PENETRATION OF THREADS THROUGH STEEL, COUNTERSINK HEADS AS REQUIRED.
- 5. METAL DECK: 1/4" DIA. ST. STL. SELF-TAPPING "DECK" SCREWS AT 12" O.C. MAX., LENGTH AS REQUIRED FOR 1/2" MIN. PENETRATION THROUGH UNDERSIDE OF DECK. COUNTERSINK HEADS REQUIRED.
- 6. LIGHT GAGE METAL FRAMING: 1/4" DIA. ST. STL. SELF-TAPPING "DECK" SCREWS, ONE MIN. PER FRAMING MEMBER, LENGTH AS REQ'D FOR 1/2" MIN. PENETRATION THROUGH FRAMING, COUNTERSINK HEADS AS REQUIRED.
- 7. PLYWOOD DECK: 1/4" DIA. ST. STL. SELF-TAPPING "DECK" SCREWS, ONE MIN. PER FRAMING MEMBER, LENGTH AS REQ'D FOR 1/2" MIN. PENETRATION THROUGH UNDERSIDE OF DECK. COUNTERSINK HEADS AS REQUIRED.
- 8. WOOD BLOCKING: 1/4" DIA. ST. STL. SELF-TAPPING "DECK" SCREWS AT 12" O.C MAX., LENGTH AS REQUIRED FOR 1.50" MIN. EMBEDMENT. OPTION: TWO 3/8" DIA. CONTINUOUS BEADS OF CONSTRUCTION ADHESIVE THE FULL LENGTH OF THE BOARD TO BE APPLIED, # 12d NAILS @ 4" O.C. (IN 2 ROWS-STAGGERED).
- C. PLYWOOD SHEATHING:
- CONCRETE: 1/4" DIA. ST. STL. SELF-TAPPING MASONRY SCREWS AT 12" O.C. MAX. (AT EDGES), AND 16" O.C. MAX. IN THE FIELD, LENGTH AS REQUIRED FOR 1.50" MIN. EMBEDMENT. OPTION: 1/4" DIA. DEFORMED OR FLUTED NAIL AT SAME SPACING AS ABOVE, LENGTH AS REQ'D. FOR 14" MIN. EMBEDMENT.
- 2. CONCRETE BLOCK (CMU): 1/4" DIA. ST. STL. SELF-TAPPING MASONRY SCREWS AT 12" O.C. MAX. (AT EDGES), AND 16" O.C. MAX. IN THE FIELD, LENGTH AS REQUIRED FOR 1.50" MIN. EMBEDMENT. OPTION: 1/4" DIA. DEFORMED OR FLUTED NAIL AT SAME SPACING AS ABOVE, LENGTH AS REQ'D. FOR 14" MIN. EMBEDMENT.
- 3. BRICK: 1/4" DIA. ST. STL. SELF-TAPPING MASONRY SCREWS AT 12" O.C. MAX. (AT EDGES), AND 16" O.C. MAX. IN THE FIELD, LENGTH AS REQUIRED FOR 1.50" MIN. EMBEDMENT. OPTION: 1/4" DIA. DEFORMED OR FLUTED NAIL AT SAME SPACING AS ABOVE, LENGTH AS REQ'D. FOR 14" MIN. EMBEDMENT.
- 4. STRUCTURAL STEEL: #10 DIA, ST. STL, SELF-DRILLING, SELF-TAPPING SCREWS WITH "WINGS" AT 12" O.C. MAX. (AT EDGES), AND 16" O.C. MAX. IN THE FIELD, LENGTH AS REQ'D. FOR 1/2" MIN. PENETRATION OF THREADS THROUGH STEEL.
- 5. METAL DECK: #10 DIA. SELF-TAPPING "DECK" SCREWS AT 12" O.C. MAX. (AT EDGES), AND 16" O.C. MAX. IN THE FIELD, LENGTH AS REQUIRED FOR 1/2" MIN. PENETRATION THROUGH UNDERSIDE OF DECK.
- 6. LIGHT GAGE METAL FRAMING: #10 DIA. SELF-TAPPING "DECK" SCREWS AT 12" O.C. MAX. (AT EDGES), AND 16" O.C. MAX. ALONG EACH FRAMING MEMBER. LENGTH AS REQ'D FOR 1/2" MIN. PENETRATION THROUGH, FRAMING. FRAMING TO BE SPACED AT 24" O.C. MAX., UNLESS NOTED OTHERWISE BY DETAILS.
- 1. WOOD FRAMING: #10 DIA. SELF-TAPPING "DECK" SCREWS AT 12" O.C. MAX. ALONG EACH FRAMING MEMBER, LENGTH AS REQUIRED FOR 1.50" MIN. EMBEDMENT. OPTION: 8d ANNULAR RING NAILS AT 6" O.C. MAX. (AT EDGES) AND 12" O.C. MAX. IN FIELD OF PANEL. DECREASE SPACING AT ROOF EDGE 4 CORNER WIND ZONES TO 4" O.C. MAX. AT EDGES, AND 8" O.C. MAX. IN FIELD.
- D. METAL DECKING:
- 1. INSTALL AND SECURE PER STEEL JOIST INSTITUTE (SJI) GUIDELINES, SEE SPECIFICATIONS OR STRUCTURAL DETAILS FOR ADDITIONAL INFORMATION.
- E. MINOR STRUCTURAL STEEL
- ANCHORAGE OF LOAD BEARING STEEL AND LARGE STEEL FABRICATIONS, (SUCH AS LADDERS), IS TO BE AS DEFINED BY STRUCTURAL ENGINEERING. DRAWINGS OR AS ENGINEERED BY THE SUPPLIER. MINOR STRUCTURAL STEEL WOULD BE CONSIDERED ITEMS SUCH AS SUPPORT STANDS, WALL LEDGER ANGLES, ETC.
- 2. CONCRETE: 3/8" DIA, HEAVY-DUTY, SLEEVE STYLE EXPANSION BOLT ANCHOR (RAWL-BOLT) @ 16" O.C., LENGTH AS REQ'D FOR 2" MIN. EMBEDMENT.

- 3. CONCRETE BLOCK (CMU): 3/8" DIA. HEAVY-DUTY, SLEEVE STYLE EXPANSION BOLT ANCHOR (RAWL-BOLT) @ 16" O.C., LENGTH AS REQUIRED FOR 2" MIN. EMBEDMENT. IF CMU 16 HOLLOW, BREAK INTO BLOCK ABOVE, AND FILL CELL OF BLOCK TO RECEIVE ANCHOR SOLID, PERFORM ANY REPAIR AND PATCHING NECESSARY
- 4. BRICK: 3/8" DIA, HEAVY-DUTY, SLEEVE STYLE EXPANSION BOLT ANCHOR (RAWL-BOLT) @ 16" O.C., LENGTH AS REQ'D FOR 2" MIN. EMBEDMENT.
- 5. STRUCTURAL STEEL: 1/4" DIA. ST. STL. SELF-DRILLING, SELF-TAPPING SCREWS @ 16" O.C. MAX., LENGTH AS REQUIRED FOR 1/2" MIN. PENETRATION OF THREADS THROUGH STEEL.
- F. RIGID INSULATION BOARD
- 1. INSTALL AND SECURE PER THE MANUFACTURER'S RECOMMENDATIONS, TESTING AND APPROVALS TO COMPLY WITH THE DESIGN REQUIREMENTS OF THIS PROJECT. SEE PROJECT SPECIFICATIONS AND FASTENING DETAIL FOR ADDITIONAL INFORMATION.
- G. ROOF MEMBRANE SYSTEM
- 1. INSTALL AND SECURE PER THE MANUFACTURER'S RECOMMENDATIONS, TESTING AND APPROVALS TO COMPLY WITH THE DESIGN REQUIREMENTS OF THIS PROJECT. SEE PROJECT SPECIFICATIONS AND FASTENING DETAIL FOR ADDITIONAL INFORMATION.
- H. FLANGED SHEETMETAL (EDGE METAL):
- WOOD BLOCKING: #12 GAGE x 1.50" ANNULAR RING STAINLESS STEEL ROOFING NAILS AT 4" O.C. MAX., STAGGERED IN 2 ROWS INSET AT 3/4"+ FROM EACH EDGE OF THE FLANGE.
- 2. LIGHTGAGE METAL: #10 DIA. STAINLESS STEEL, SELF TAPPING, WAFER OR FLAT HEAD SCREWS AT 12" O.C. MAX., 8" O.C. WITHIN ROOF CORNER ZONES, LENGTH AS REQUIRED FOR 1/2" MIN. PENETRATION OF THREADS THROUGH STEEL.
- 3. CONCRETE: 3/16" DIA. ST. STL. SELF-DRILLING, SELF-TAPPING, MASONRY SCREW, LENGTH AS REQUIRED FOR 1.50" MIN. EMBEDMENT. OPTION: 1/4" DIA. x 1.50" LONG ZAMAC "NAIL-IN" DRIVE PIN, EXPANSION TYPE FASTENER WITH A STAINLESS STEEL DRIVE PIN. INSTALL AT 12" O.C. MAX., 8" O.C. WITHIN ROOF CORNER ZONES
- CLEATS FOR SHEETMETAL FLASHINGS:
- WOOD BLOCKING: #12 GAGE × 1.50" ANNULAR RING, STAINLESS STEEL ROOFING. NAILS AT 8" O.C. MAX, (4" O.C. AT CORNER ZONES OF ROOF)
- LIGHTGAGE METAL: #10 DIA, STAINLESS STEEL, SELF TAPPING, WAFER OR FLAT HEAD SCREWS, LENGTH AS REQ'D FOR $\frac{1}{2}$ " MIN. PENETRATION OF THREADS THROUGH STEEL, LOCATE AT 10" O.C. MAX., 6" O.C. WITHIN ROOF CORNER ZONES,
- CONCRETE: 3/16" DIA. ST. STL. SELF-DRILLING, SELF-TAPPING, MASONRY SCREW, LENGTH AS REQUIRED FOR 1.50" MIN. EMBEDMENT. OPTION: 1/4" DIA. X 1.50" LONG ZAMAC "NAIL-IN" DRIVE PIN, EXPANSION TYPE FASTENER WITH A STAINLESS STEEL DRIVE PIN. INSTALL AT 10" O.C. MAX., 6" O.C. WITHIN ROOF CORNER ZONES.
- 4. CONCRETE BLOCK (CMU): 3/16" DIA. ST. STL. SELF-DRILLING, SELF-TAPPING, MASONRY SCREW, LENGTH AS REQUIRED FOR 1.50" MIN. EMBEDMENT. OPTION: 1/4" DIA. X 1.50" LONG ZAMAC "NAIL-IN" DRIVE PIN, EXPANSION TYPE FASTENER WITH A STAINLESS STEEL DRIVE PIN. INSTALL AT 10" O.C. MAX., 6" O.C. WITHIN ROOF CORNER ZONES.
- 5. BRICK: 1/4" DIA. ST. STL. SELF-DRILLING, SELF-TAPPING, MAGONRY SCREW, LENGTH AS REQUIRED FOR 1.50" MIN. EMBEDMENT. OPTION: 1/4" DIA. × 1.50" LONG ZAMAC "NAIL-IN" DRIVE PIN, EXPANSION TYPE FASTENER WITH A STAINLESS STEEL DRIVE PIN. INSTALL AT 10" O.C. MAX., 6" O.C. WITHIN ROOF CORNER ZONES.
- APPLIED SHEETMETAL (COUNTERFLASHINGS, ETC.)
- WOOD BLOCKING: #12 DIA, SELF-TAPPING, STAINLESS STEEL SCREWS AT 8" O.C. MAX., LENGTH AS REQUIRED FOR 1.25" MIN. EMBEDMENT INTO WOOD. IF EXPOSED TO THE WEATHER, USE "SCOTS" TYPE SCREW WITH INTEGRAL NEOPRENE SEALING WASHER.
- SHEETMETAL BACKING: #12" DIA. SELF-TAPPING STAINLESS STEEL SCREWS AT 2. 8" O.C. MAX., LENGTH AS REQ'D FOR 1/2" MIN. PENETRATION OF THREADS THROUGH STEEL. IF EXPOSED TO THE WEATHER PROVIDE "SCOTS" TYPE SCREW WITH INTEGRAL NEOPRENE SEALING WASHER.
- 3. CONCRETE: 1/4" DIA SELF-TAPPING STAINLESS STEEL MASONRY SCREWS AT 8" O.C. MAX., LENGTH AS REQUIRED FOR 14" MIN. EMBEDMENT. OPTION: 1/4" DIA. X 1.50" ZAMAC "NAILIN" DRIVE PIN, EXPANSION TYPE FASTENERS @ 8" O.C. MAX., WITH STAINLESS STEEL DRIVE PIN. IF EXPOSED TO THE WEATHER PROVIDE METAL BACKED NEOPRENE SEALING WASHERS - ADJUST LENGTH AS REQ'D BY OVERLYING FINIGH TO MAINTAIN 1.25" MIN. EMBEDMENT INTO CONCRETE.
- 4. CONCRETE BLOCK (CMU): 1/4" DIA. SELF-TAPPING STAINLESS STEEL MASONRY SCREWS AT 8" O.C. MAX., LENGTH AS REQUIRED FOR 1.25" MIN. EMBEDMENT. OPTION: 1/4" DIA. X 1.50" ZAMAC "NAILIN" DRIVE PIN EXPANSION TYPE FASTENERS @ 8" O.C. MAX., WITH STAINLESS STEEL DRIVE PIN. IF EXPOSED TO THE WEATHER PROVIDE METAL BACKED NEOPRENE SEALING WASHERS-INCREASE LENGTH IF REQ'D BY OVERLYING FINISH FOR 1.25" MIN. EMBEDMENT INTO CONCRETE BLOCK.
- BRICK: 1/4" DIA. SELF-TAPPING STAINLESS STEEL MASONRY SCREWS AT 8" O.C. 5 MAX., LENGTH AS REQUIRED FOR 1.25" MIN. EMBEDMENT. OPTION: 1/4" DIA. X 1.50" ZAMAC "NAILIN" DRIVE PIN EXPANSION TYPE FASTENERS @ 8" O.C. MAX., WITH STAINLESS STEEL DRIVE PIN. IF EXPOSED TO THE WEATHER PROVIDE METAL BACKED NEOPRENE SEALING WASHERS- INCREASE LENGTH IF REQ'D BY OVERLYING FINISH FOR 1.25" MIN. EMBEDMENT INTO BRICK.



Architecture Roof Consulting Construction Technology 601 North Fern Creek Avenue Suite 100 Orlando, FL. 32803-4899 Tel. 407-896-7875 Fax. 407-898-6043

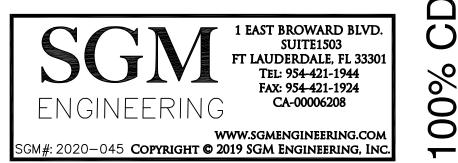

| ТО | | REVISIONS | 0 | | | DR | ENGINEER |
|-----------------|-------------------------------------|--------------------|-------------|---------------------|--|---------------------|----------------|
| TAL | | NO. DATE BY CHK'D | DESCRIPTION | CITY | CITY OF FORT LAUDERDALE | TJG 08/07/20 | |
| 0 : TILE: | _ | 3 4/9/2021 TJG JWR | ROOF REPAIR | | | DESIGNED BY: S | DATE: |
| 5 | | | | PUBL | PUBLIC WORKS DEPARTMENT | CHECKED DV. | NMO |
| | GFN RO | | | ENGIN | ENGINEERING & ARCHITECTURE | | |
| 5 | 949 NW 38TH ST, FT. LAUDERDALE, FL. | | | 100 North Andrews A | 100 North Andrews Avenue, Fort Lauderdale, Florida 33301 | FIELD BOOK: | TEL: 954-421-1 |
| | | _ | | | | | FAX: 954-42 |
| | | | | | | | |


21013.00_DOCUMENTS.dwg


21013.00_QQGUMENTS.dwg

Page 17 of 78 p. 724

DRAWING FILE NO.

944 924

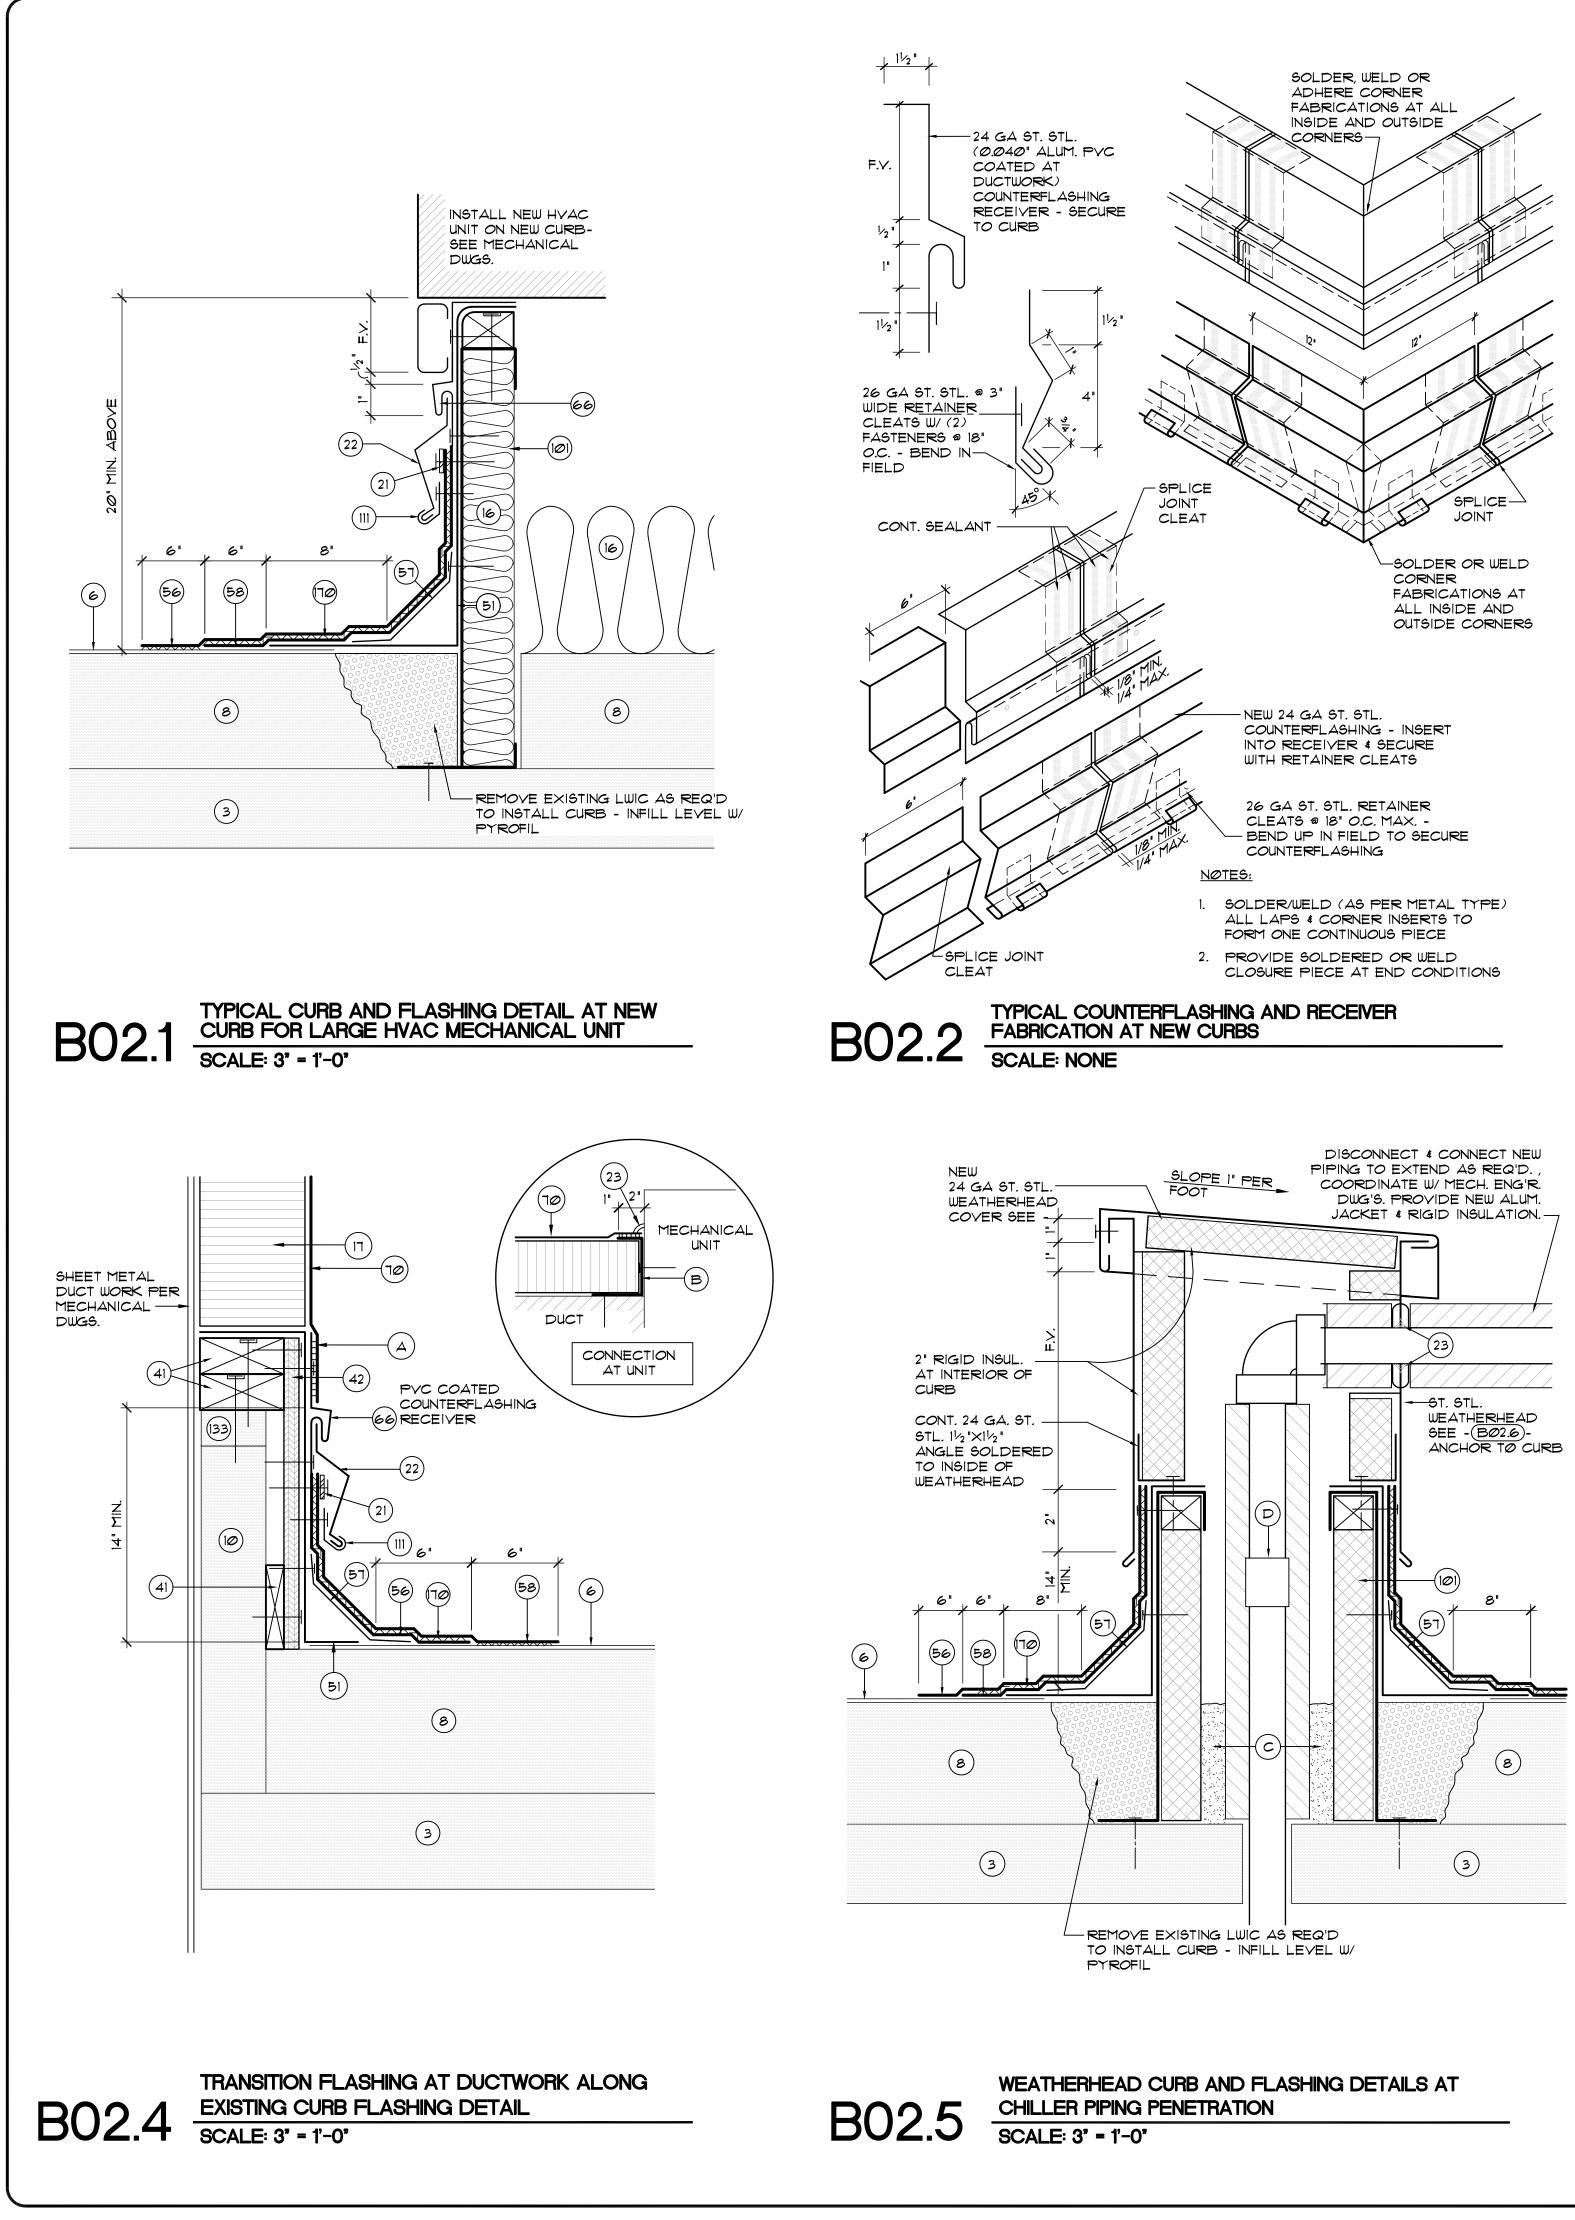

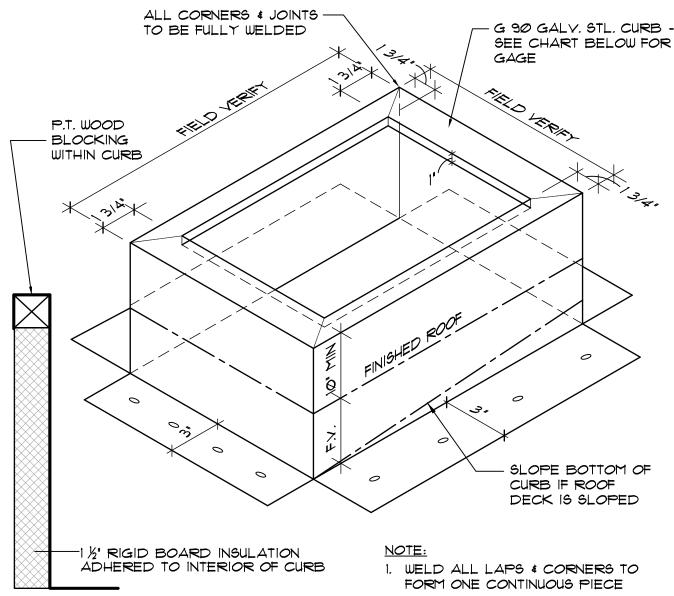


2. DIMENSIONS NOT GIVEN TO BE FIELD VERIFIED.

<u>SECTION</u>

| | CURB DATA | | | | | | | | |
|-------------|-------------|---------------|---|--|--|--|--|--|--|
| MIN SIZE | MAX SIZE | METAL GAGE | ANCHORAGE - CONC DECK | | | | | | |
| - | 24" SQ | 20 GA. | 1/4"\$ × 21/4" LG. TAPCONS@ 24" O.C. | | | | | | |
| 25" SQ | େଡ" ରେ | 18 GA. | 1/4" + × 21/4" LG. TAPCONS@ 18" O.C. | | | | | | |
| 61" SQ | 12Ø" SQ | 16 GA. | $\frac{1}{4}$ " $\phi \times \frac{2}{4}$ " LG. TAPCONS@ 12" O.C. | | | | | | |
| 121" SQ | 24Ø" SQ | 14 GA. | ³ ∕8"¢ × 3" RAWL-BOLT @ 24" O.C. | | | | | | |




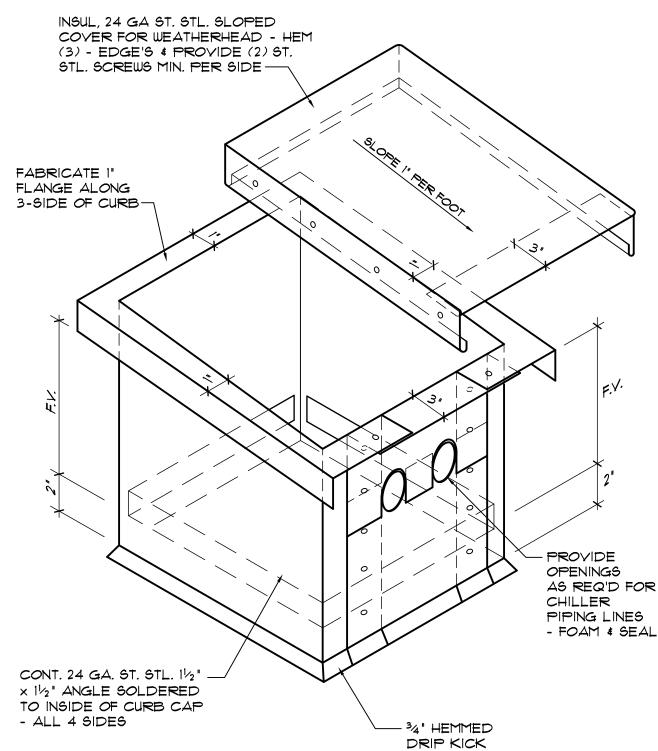




CHILLER PIPING WEATHERHEAD FABRICATION


Bid 12467-113

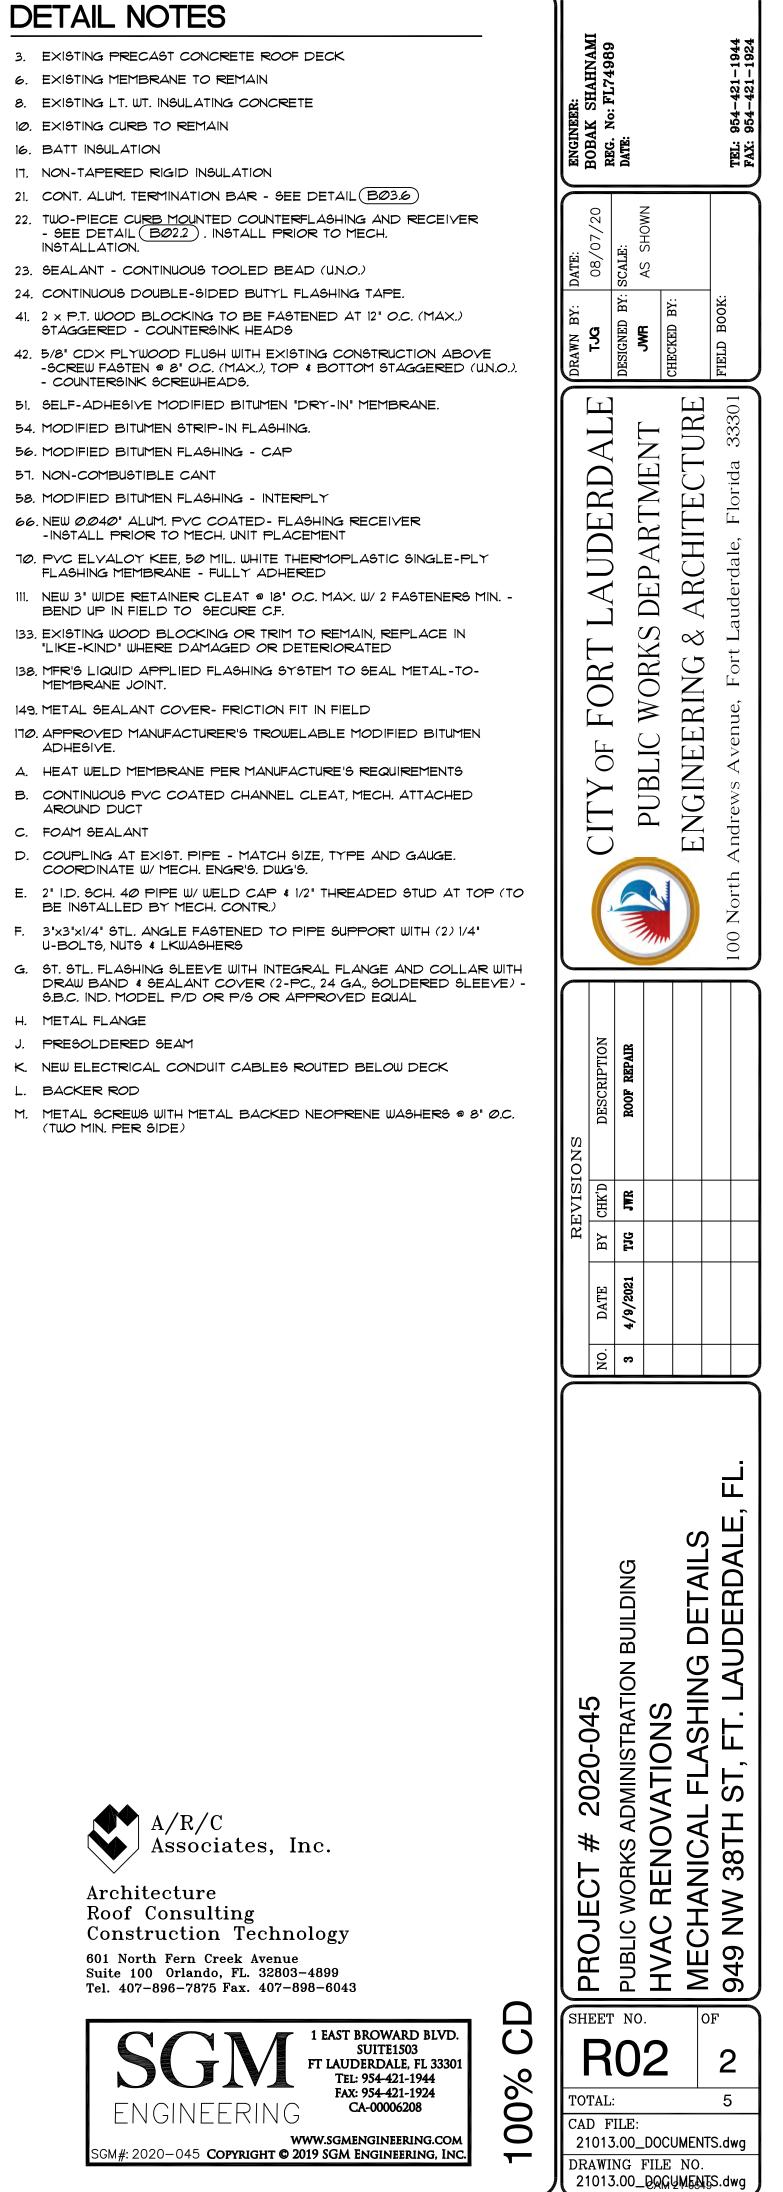




Page 18 of 78 p. 725

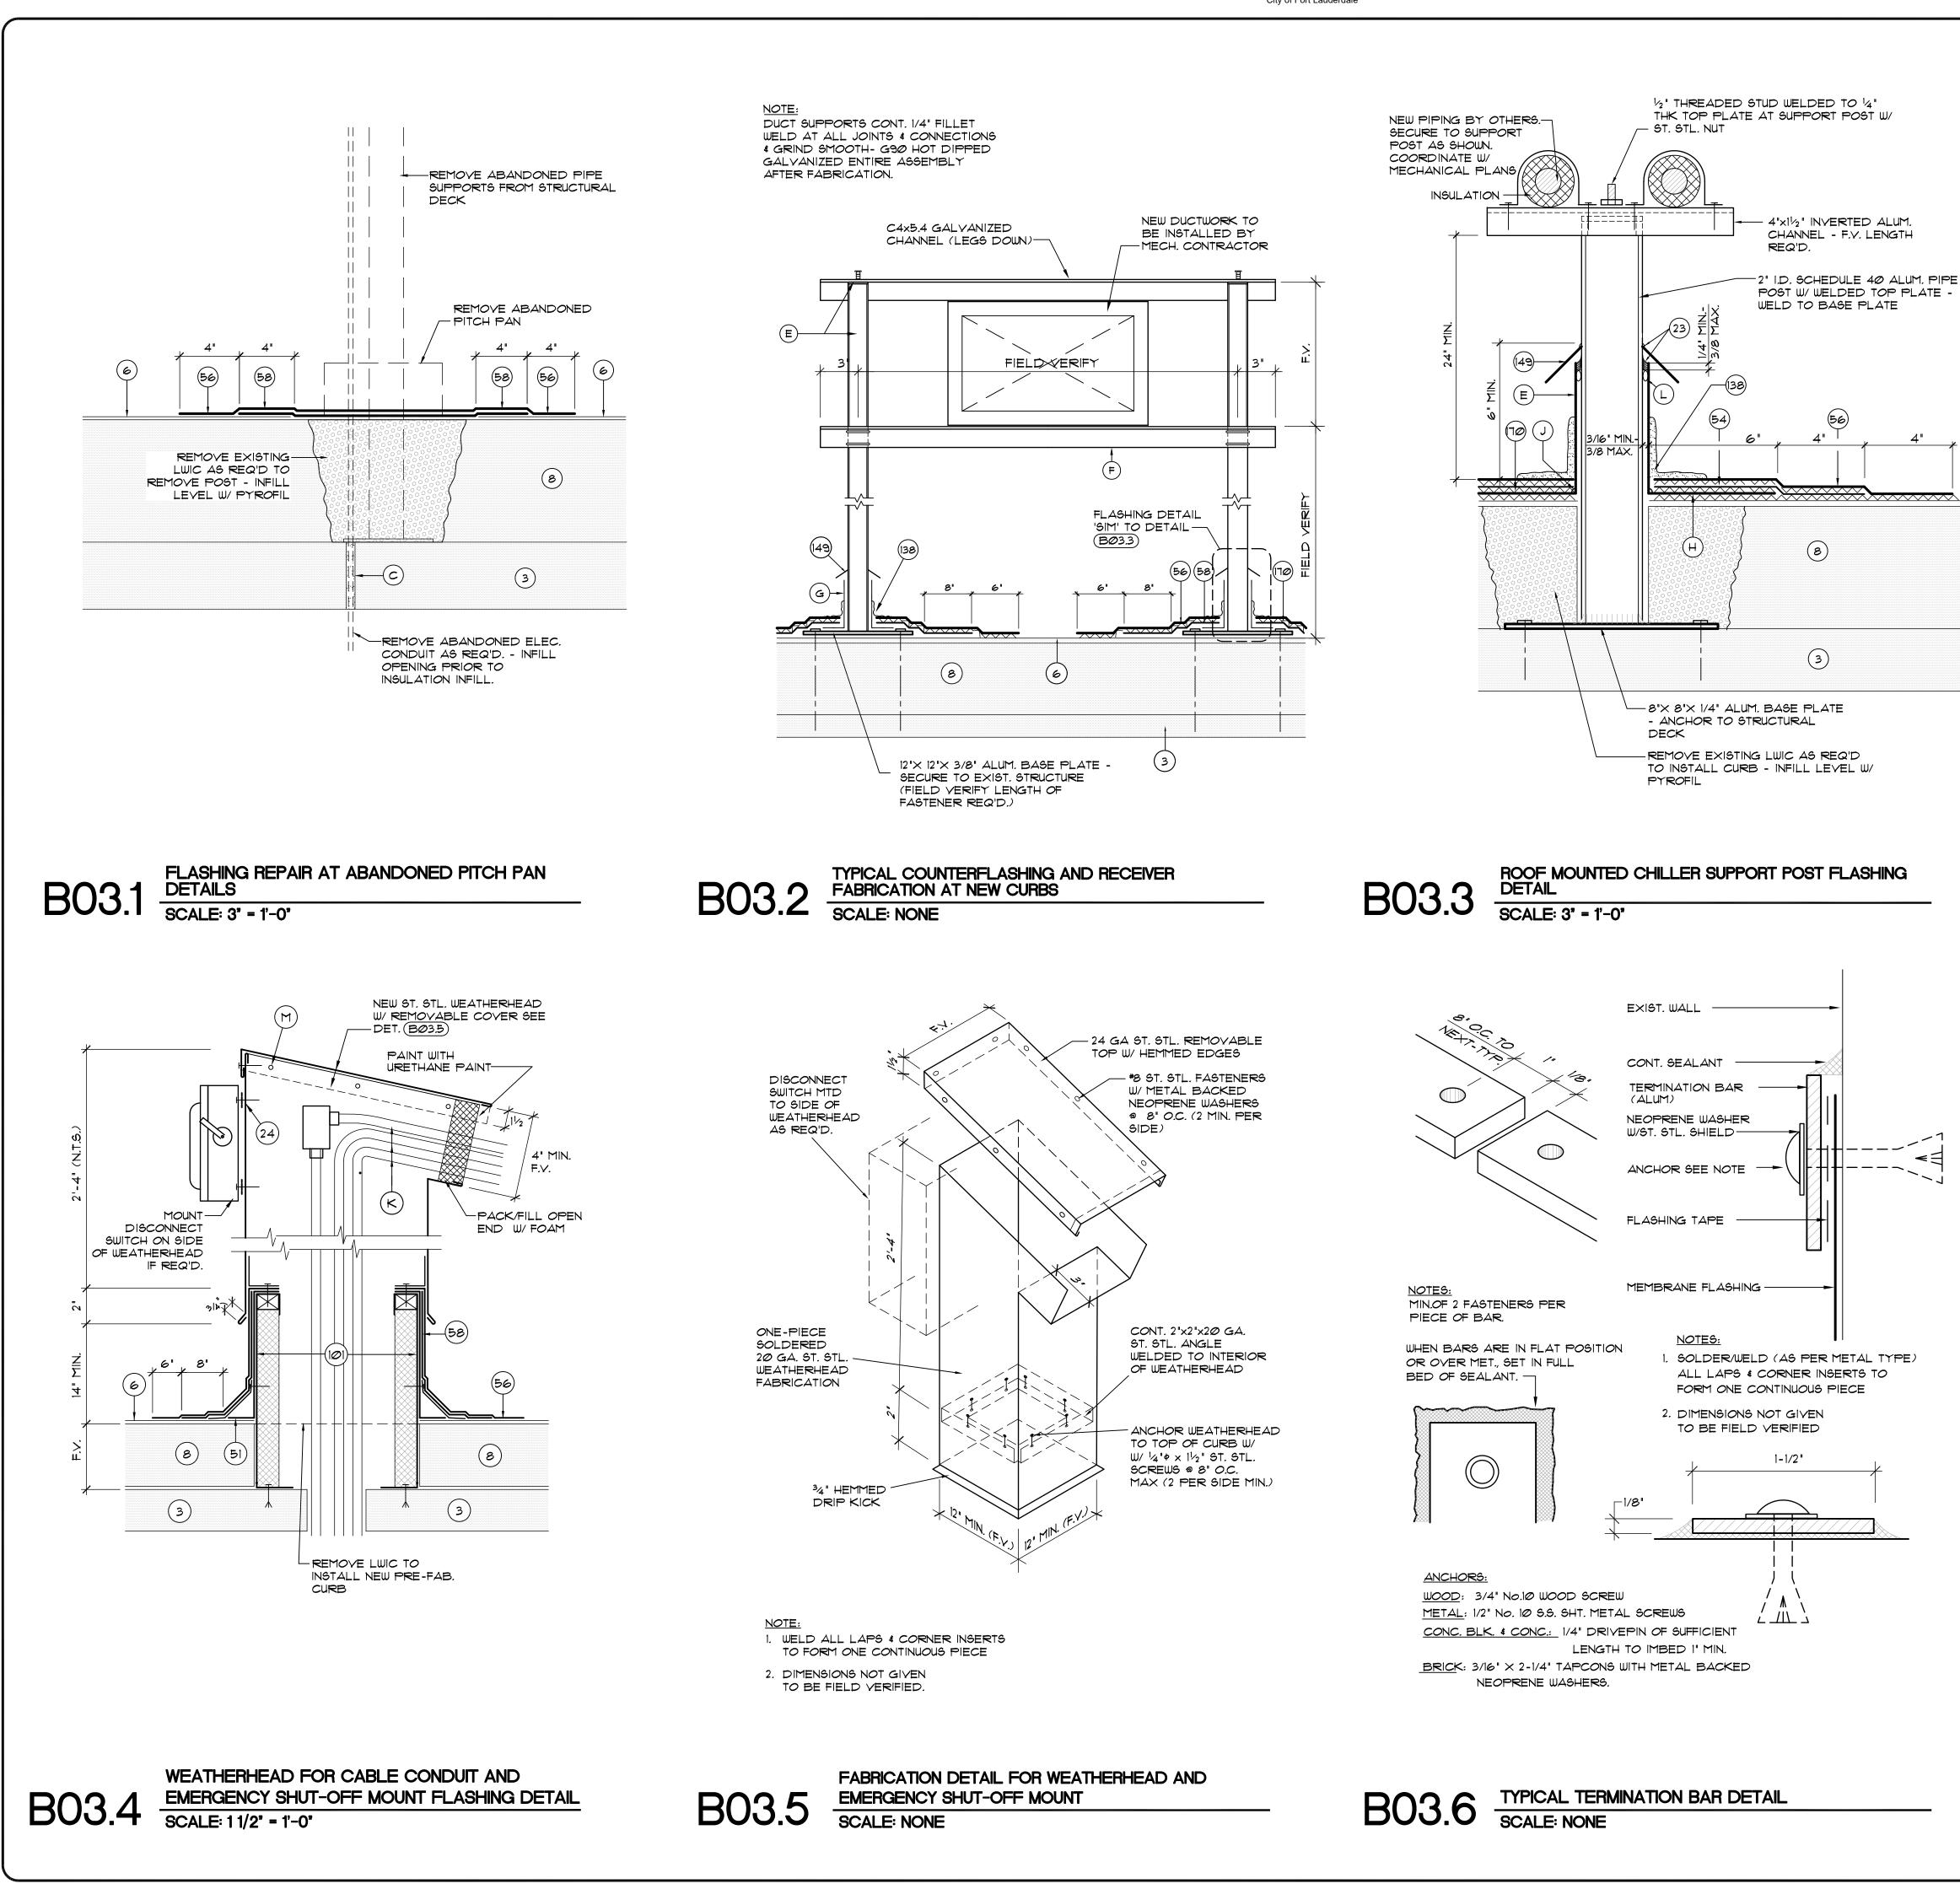


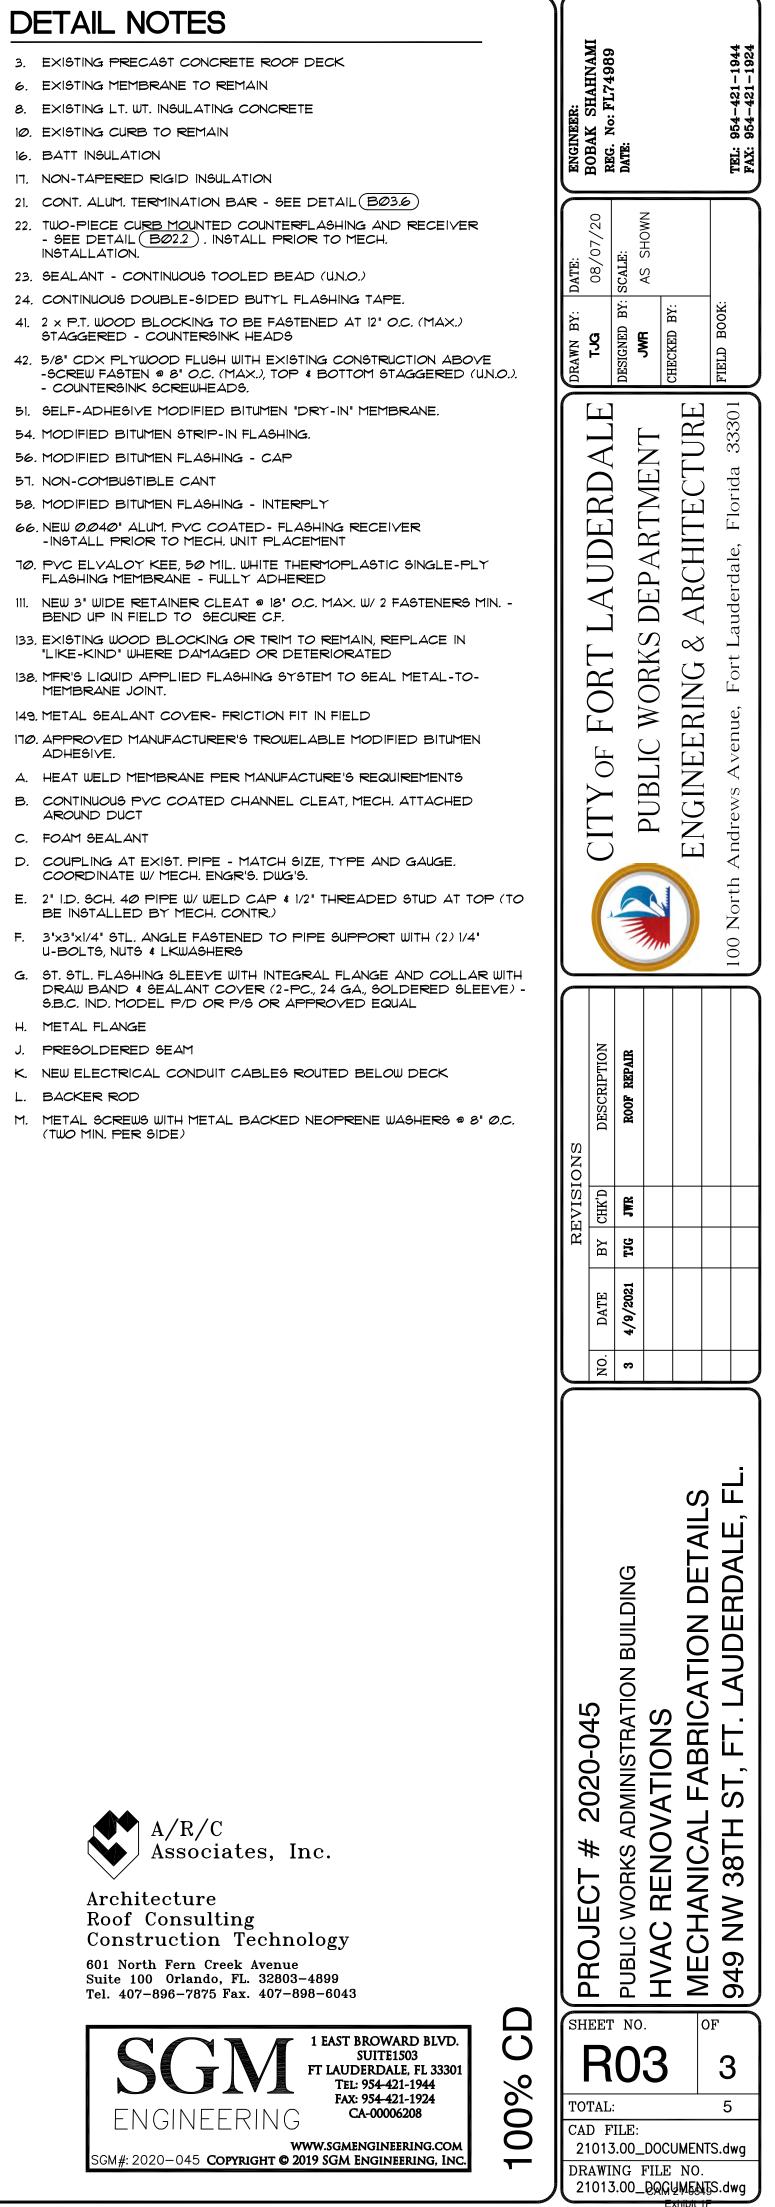

(6)

 $\sim\sim\sim\sim\sim\sim$

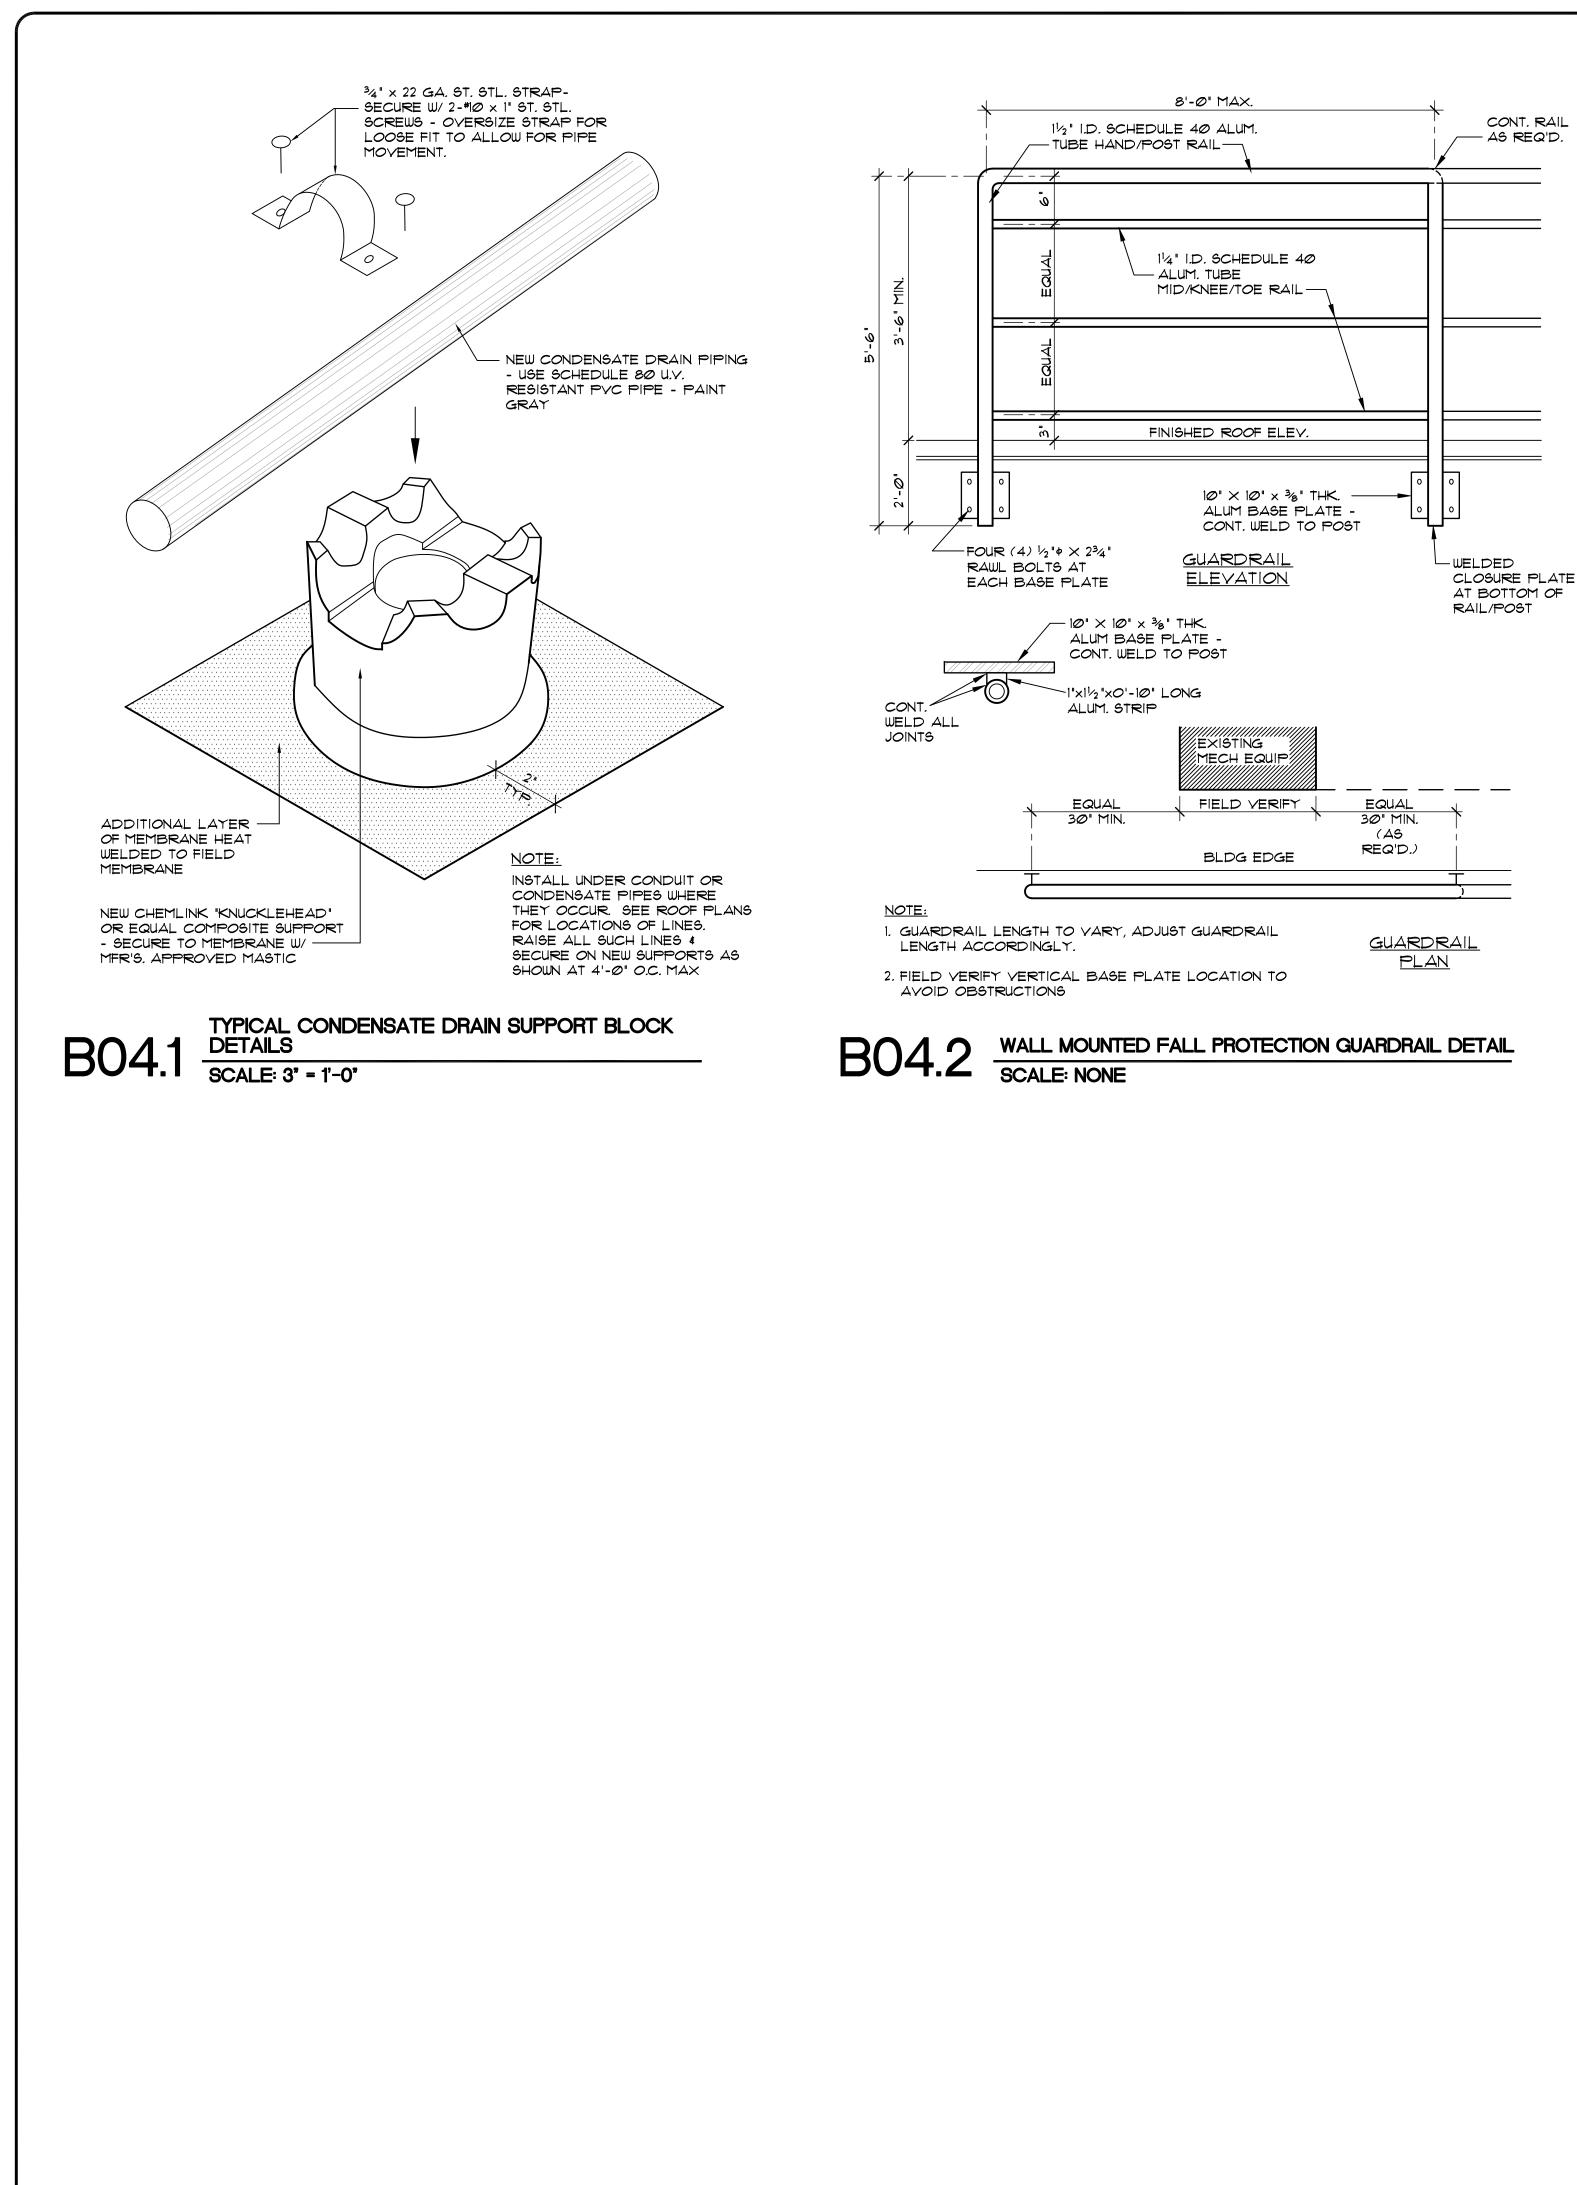

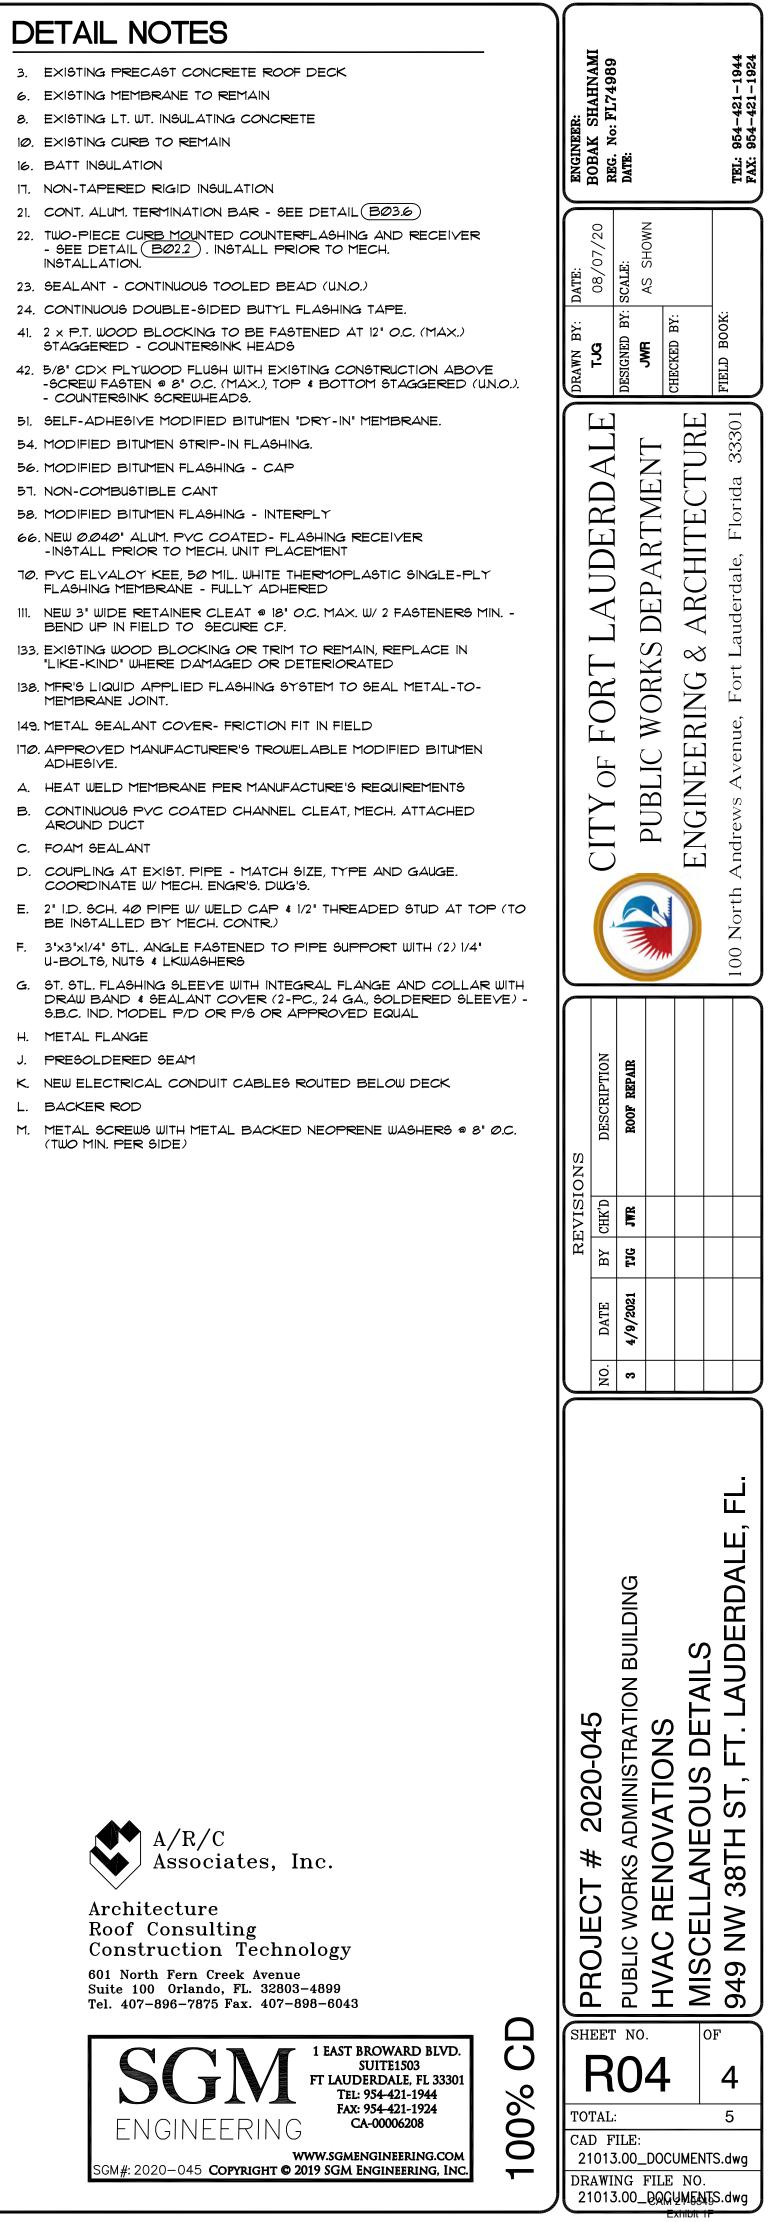

Page 20 of 78 p. 727

| <i>a</i> | | | | | | |
|-----------|---|---|--|---|---------------------|---|
| | GEN | NERAL RO | OFING | NOTES | | |
| 1. | FROM T OF FIEL | | CTURAL DOCU KEN BY A/R/C | | 1Ø. | SHEET METAL DETAIL REQUIRED AS IF SHOU THESE REQUIREMENTS SHOP FABRICATION. |
| | PRE-RE DIMENS THE DIMENS THE CO | EQUISITE FOR BIDDING IONS SHALL BE FIELD 1ENSIONS UTILIZED IN IONS TAKEN, CONFIRM NTRACTOR SHALL VE | THE PROJEC VERIFIED BY BIDDING THE ED OR CORR RIFY ALL DIM | REACH BIDDER SO THAT PROJECT WILL BE THOSE ECTED BY THE BIDDER. IENSIONS, DETAILS, AND | 11. | CONTRACTOR SHALL FINISHING OF ALL SUR THE WORK. WORK NOT REPAIRS AND FINISHE CONDITIONS TO REMA |
| | DISCRE | PANCIES PRIOR TO F | ROCEEDING | | 12. | CONTRACTOR SHALL REPLACE INTERIOR F DAMAGED DURING TH |
| 2. | EXISTIN SITE AF OTHERU VISUAL | G CONDITIONS AT THE RE INCLUDED IN THE F JISE (N.I.C.). THE CONT FIELD SURVEY (PRIOR | E PROJECT SI PROJECT UNLE RACTOR SHA R TO BID) IN | DICATE APPROXIMATE TE. ALL BLDGS. ON THE ESS SPECIFICALLY NOTED ILL BE RESPONSIBLE FOR A REGARD TO QUANTITIES, 4 LOCAL BUILDING CODE. | 13. | CONTRACTOR SHALL REQUIRED TO PROPE AND COMPONENTS WI |
| 3. | PROJEC THE SIT NEARB DETER ITEMS IN GIVEN T FINISHE | CT ARCHITECT AND OU E AND PHOTO AND V Y THAT MAY BE AFFEC 1INE THE CONTRACTOR N THEIR CURRENT STA TO CEILING, LIGHT FIXT | UNERS REPRE IDEO TAPE TH CTED BY THIS R'S RESPONS TUS, SPECIAL TURES, EXTER TC. PARTICUL | CONTRACTOR WITH THE ESENTATIVE SHALL VISIT HE SITE AND ALL SPACES PROJECT IN ORDER TO IBILITY IN KEEPING THOSE ATTENTION SHALL BE IOR AND INTERIOR WALL ARLY IN THOSE AREAS RVED. | | |
| 4. | SHALL BOTH T DISCON | BE OPERATED IN THE HE CONTRACTOR AND | PRESENCE C OWNER PRIC CAL FUNCTION | COMPONENTS (EQUIPMENT) DF REPRESENTATIVES OF DR TO ANY DEMOLITION OR NG, IN ORDER TO ESTABLISH TIONS. | | |
| 5. | REMOV PROPE RELOC, ITEMS F | AL TO ASSURE THAT I RLY REMOVED AND I ATED ARE PROTECTE | TEMS SCHEDU TEMS TO REM, D FROM DAM, OT TO RE REI | RING DEMOLITION AND ILED FOR DEMOLITION ARE AIN AND/OR TO BE AGE, ALL SALVAGEABLE USED SHALL BE DISPOSED | | |
| 6. | RENOV, PROTEC | ATION UNLESS ALL EX CTION ARE CONTINUOU | ISTING EXITS ISLY MAINTAIN | DURING REMODELING OR AND ANY EXISTING FIRE NED, OR IN LIEU THEREOF VIDE EQUIVALENT SAFETY. | | |
| ٦. | DAMAG The Pr Repor | E REPORT, WITH PHOT OJECT ARCHITECT ON | OGRAPHS SH | INTERIOR OF STRUCTURES, A IALL BE COMPLETED BY 1/E BEEN NOTIFIED. THE NER AND THE CONTRACTOR | | |
| 8. | BY TEL RESULT THEFT (| EPHONE IN EACH INST ING FROM FIRE, WATER | ANCE OF PRO | E OWNER OR ARCHITECT OPERTY DAMAGE LEGAL ENTRY, VANDALISM, GE WITHIN 24 HOURS OF | | |
| 9. | AND AF OCCURS WERE "(| RE NOT CUT AT EVERY 3. BID AND EXECUTE | LOCATION W A COMPLETE | DRAWINGS ARE "TYPICAL" HERE THE CONDITION E PROJECT AS IF DETAILS UCH CONDITION OR SIMILAR | | |
| | ABE | BREVIATION | NS | | | |
| | J | ADAJACENT | DIA | DIAMETER | LΨ | LIGHTWEIGHT |
| A/C AL | .⊤ | AIR CONDITIONING ALTERNATE | DIM DS | DIMENSION Downspout | LLH LLV | LONG LEG HOR LONG LEG VER |
| ALI AN | IOD | ALUMINUM ANODIZED | DWG: | | MFR | MANUFACTURE(|
| | PROX RCH | APPROXIMATE ARCHITECT(URAL) | E ELEC EL (ELEV) | EAST ELECTRIC(AL) ELEVATION | MATL MAX MECI | MAXIMUM |
| BR | | BEARING | EQ | | MTL | METAL |
| BIT | I | BITUMINOUS BITUMEN | EQUIP EXH | EQUIPMENT EXHAUST | MIN MISC | MINIMUM MIGCELLANEOU |
| BL | | BLOCK | EXIST | EXISTING | MOD | |
| BL BD | .KG > | BLOCKING BOARD | EXP | EXPANGION Exterior | MTD | MOUNTED(ING) |
| BC | | BOTTOM | EXT | EXTERIOR | NOM | NOMINAL |
| | .DG | BUILDING | FIN | FINISH(ED) | N | |
| BU | R | BUILT UP ROOF | FLASH FLEX | FLASHING FLEXIBLE | | NOT IN CONTRA |
| CIF | 0 | CAST-IN-PLACE | FLEX | FLEXIBLE FOOTING | NTS NO | NOT TO SCALE NUMBER |
| CB | 3 | CATCH BASIN | FDN | FOUNDATION | | |

NS TO REMAIN UNCHANGED.

TOR SHALL PROVIDE ALL SUPPLEMENTAL MATERIALS) TO PROPERLY INSTALL, SUPPORT AND BRACE ALL ITEMS PONENTS WITHIN THE WORK.

| ADJ | ADAJACENT | DIA | DIAMETER | LΨ | LIGHTWEIGHT | RAD | RADIUS |
|--------|-------------------------|-----------|-------------------------------------|------------|---------------------------------------|--------|-----------------------|
| A/C | AIR CONDITIONING | DIM | DIMENSION | LLH | LONG LEG HORIZONTAL | RWL | RAINWATER LEADER |
| ALT | ALTERNATE | DS | DOWNSPOUT | LLV | LONG LEG VERTICAL | REF | REFERENCE |
| ALUM | ALUMINUM | DWG | DRAWING | | | REINF | REINFORCE (D), (MENT) |
| ANOD | ANODIZED | _ | - / | MFR | MANUFACTURE(ER) | RCP | REINF. CONCRETE PIPE |
| APPROX | APPROXIMATE | E | EAST | MATL | MATERIAL(S) | REV | REVISION |
| ARCH | ARCHITECT(URAL) | ELEC | ELECTRIC(AL) | MAX | MAXIMUM | RD | ROOF DRAIN |
| | | EL (ELEV) | ELEVATION | MECH | MECHANIC(AL) | RO | ROUGH OPENING |
| BRG | BEARING | EQ | EQUAL | MTL | METAL | | |
| BIT | BITUMINOUS | EQUIP | EQUIPMENT | MIN | MINIMUM | SCH | SCHEDULE |
| | BITUMEN | Ε×Η | EXHAUST | MISC | MISCELLANEOUS | SEAL | SEALANT |
| BLK | BLOCK | EXIST | EXISTING | MOD | MODIFY / MODIFIED | SHT | SHEET |
| BLKG | BLOCKING | EXP | EXPANSION | MTD | MOUNTED(ING) | SIM | SIMILAR |
| BD | BOARD | EXT | EXTERIOR | | | 5 | SOUTH |
| BOT | BOTTOM | | FINIGH(ED) | NOM | NOMINAL | SPK | SPEAKER |
| BLDG | BUILDING | FIN | | N | NORTH | SPEC | SPECIFICATION(S) |
| BUR | BUILT UP ROOF | FLASH | | NIC | NOT IN CONTRACT | | |
| CIP | CAST-IN-PLACE | FLEX | FLEXIBLE | NTS | NOT TO SCALE | ରେ | SQUARE |
| CB | CATCH BASIN | FTG | FOOTING | NO | NUMBER | SF | SQUARE FEET |
| CLG | | FDN | FOUNDATION | <i>o</i> c | ON CENTER(G) | ST STL | STAINLESS STEEL |
| COL | | GA | GAGE (GAUGE) | | ON CENTER EACH WAY | STD | STANDARD |
| COMP | COMPRESS, | GALV | | OPG | OPENING | STL | STEEL |
| | (ION), (IBLE) | GWB | GYPSUM WALL BOARD | OPP | OPPOSITE | STRUCT | STRUCTURAL |
| CONC | CONCRETE | | | | OUTSIDE DIAMETER | | |
| CMU | CONCRETE | HDWE | HARDWARE | | OUTSIDE DIAMETER OUTSIDE DIMENSION | THK | THICK(NESS) |
| | MASONRY UNIT | HVAC | HEATING/VENTILATION | | | T≰G | TONGUE AND GROOVE |
| CONST | CONSTRUCTION | | /AIR CONDITIONING | PTD | PAINT(ED) | 17P | TYPICAL |
| CONT | CONTINUOUS | HT (HGT) | HEIGHT | PR | PAIR | UNO | UNLESS NOTED OTHERWIS |
| | OR CONTINUE | НM | HOLLOW METAL | PL | PLATE | UNC | |
| CJ | CONTROL JOINT | HORIZ | HORIZONTAL | PLYWD | PLYWOOD | VERT | VERTICAL |
| CTR | CENTER | | | PVC | POLYVINYL CHLORIDE | | |
| C.F. | CUBIC FOOT | | INCLUDE(D), (ING) | PSF | POUNDS PER SQUARE FOOT | WW⊨ | WELDED WIRE FABRIC |
| | | D | INSIDE DIAMETER INSIDE DIMENSION | PSI | POUNDS PER SQUARE INCH | ω | WEST |
| DEMO | DEMOLISH, DEMOLITION | INSUL | INSULATE(D), (ION) | PC | PRECAST CONCRETE | μM | WIRE MESH |
| | | | INTERIOR | PT | PRESSURE TREATED | W/ | WITH |
| | | | INTERIOR | | | W/O | WITHOUT |
| DIAG | DIAGONAL | | | | | WD | WOOD |

ETAL DETAILS AND TRANSITIONS NOT SHOWN SHALL BE AS IF SHOWN, PREPARE, AND SUBMIT SHOP DRAWINGS OF EQUIREMENTS TO THE ARCHITECT FOR APPROVAL PRIOR TO

CTOR SHALL BE RESPONSIBLE FOR REPAIR AND PAINTING / OF ALL SURFACES EXPOSED OR DAMAGED AS A RESULT WORK NOT COVERED BY NEWLY INSTALLED WORK. AND FINISHES SHALL MATCH EXISTING ADJACENT

TOR SHALL BE RESPONSIBLE TO REMOVE REINSTALL OR INTERIOR FINISHES WHICH MAY HAVE BEEN DISTURBED OR D DURING THE CONSTRUCTION PROCESS.

ROOF COMPONENT FASTENING SCHEDULE

A. GENERAL NOTES:

- 1. THIS SCHEDULE AND THE FASTENING METHODS INDICATED HEREIN ARE INTENDED TO ADDRESS TYPICAL CONDITIONS, AND MAY NOT APPLY TO ALL CONDITIONS FOR THIS PROJECT.
- 2. CONTRACTOR / INSTALLER MUST ALSO REFER TO THE DETAILS FOR THIS SPECIFIC PROJECT. IN THE CASE OF CONFLICTING DATA, THE PROJECT SPECIFIC DETAILS SHALL GOVERN.
- 3. FOR ALL CONDITIONS NOT COVERED WITHIN SCHEDULE, REFER TO FASTENER REQUIREMENTS OF THE SPECIFICATIONS OR CONSULT WITH THE ARCHITECT.
- 4. MANUFACTURERS OF SPECIALITY FASTENER SHALL PERFORM FIELD TESTS TO VERIFY WITHDRAWAL VALUES AND FASTENING PATTERNS FOR THE SPECIFIC PROJECT CONDITIONS PRIOR TO INSTALLATION, A WRITTEN REPORT SHALL BE SUBMITTED TO THE ARCHITECT FOR REVIEW AND APPROVAL.
- 5. ALL EXPOSED FASTENERS AND THOSE USED IN PRESSURE TREATED LUMBER SHALL BE STAINLESS STEEL, ALL OTHERS MUST HAVE A CORROSION RESISTANT COATING THAT EXCEEDS F.M. APPROVAL STANDARD 4470, UNLESS NOTED OTHERWISE.
- 6. ALL FASTENERS AND THEIR INSTALLATION METHODS MUST COMPLY WITH THE REQUIREMENTS DEFINED IN THE FLORIDA BUILDING CODE, ROOFING APPLI-CATION STANDARD (RAS) NO. 111 - "STANDARD REQUIREMENTS FOR ATTACHMENT OF PERIMETER WOOD BLOCKING AND METAL FLASHINGS" UNLESS NOTED OTHERWISE,
- B. WOOD BLOCKING (2" NOMINAL THICKNESS)
- CONCRETE: 3/8" DIA, ST, STL, SELF-TAPPING MASONRY SCREW AT 16" O.C. MAX., LENGTH AS REQUIRED FOR 1.15" MIN. EMBEDMENT. OPTION: 5/16" DIA. DEFORMED OR FLUTED NAIL AT 12" O.C. MAX., LENGTH AS REQUIRED FOR 1.25" MIN, EMBEDMENT, COUNTERSINK HEADS AS REQUIRED.
- 2. CONCRETE BLOCK (CMU): 3/8" DIA. ST. STL. SELF-TAPPING MASONRY SCREW AT 12" O.C., MAX., LENGTH AS REQUIRED FOR 1.75" MIN. EMBEDMENT. OPTION: 3/8" DIA, HEAVY DUTY SLEEVE STYLE EXPANSION BOLT ANCHOR (RAWL-BOLT) @ 18" O.C., LENGTH AS REQUIRED FOR 2" MIN. EMBEDMENT. COUNTER-SINK HEADS AS REQUIRED.
- 3. BRICK: 3/8" DIA. ST. STL. SELF-TAPPING MASONRY SCREW AT 12" O.C., MAX., LENGTH AS REQUIRED FOR 1.75" MIN. EMBEDMENT. OPTION: 3/8" DIA. HEAVY DUTY SLEEVE STYLE EXPANSION BOLT ANCHOR (RAWL- BOLT) @ 18" O.C., LENGTH AS REQUIRED FOR 2" MIN. EMBEDMENT. COUNTERSINK HEADS AS REQUIRED.
- 4. STRUCTURAL STEEL: 1/4" DIA. ST. STL. SELF-DRILLING, SELF-TAPPING SCREWS WITH "WINGS" @ 16" O.C. MAX., LENGTH AS REQUIRED FOR 1/2" MIN. PENETRATION OF THREADS THROUGH STEEL, COUNTERSINK HEADS AS REQUIRED.
- 5. METAL DECK: 1/4" DIA. ST. STL. SELF-TAPPING "DECK" SCREWS AT 12" O.C. MAX., LENGTH AS REQUIRED FOR 1/2" MIN. PENETRATION THROUGH UNDERSIDE OF DECK. COUNTERSINK HEADS REQUIRED.
- 6. LIGHT GAGE METAL FRAMING: 1/4" DIA. ST. STL. SELF-TAPPING "DECK" SCREWS, ONE MIN. PER FRAMING MEMBER, LENGTH AS REQ'D FOR 1/2" MIN. PENETRATION THROUGH FRAMING, COUNTERSINK HEADS AS REQUIRED.
- 7. PLYWOOD DECK: 1/4" DIA. ST. STL. SELF-TAPPING "DECK" SCREWS, ONE MIN. PER FRAMING MEMBER, LENGTH AS REQ'D FOR 1/2" MIN. PENETRATION THROUGH UNDERSIDE OF DECK. COUNTERSINK HEADS AS REQUIRED.
- 8. WOOD BLOCKING: 1/4" DIA. ST. STL. SELF-TAPPING "DECK" SCREWS AT 12" O.C MAX., LENGTH AS REQUIRED FOR 1.50" MIN. EMBEDMENT. OPTION: TWO 3/8" DIA. CONTINUOUS BEADS OF CONSTRUCTION ADHESIVE THE FULL LENGTH OF THE BOARD TO BE APPLIED, # 12d NAILS @ 4" O.C. (IN 2 ROWS-STAGGERED).
- C. PLYWOOD SHEATHING:
- CONCRETE: 1/4" DIA. ST. STL. SELF-TAPPING MASONRY SCREWS AT 12" O.C. MAX. (AT EDGES), AND 16" O.C. MAX. IN THE FIELD, LENGTH AS REQUIRED FOR 1.50" MIN. EMBEDMENT. OPTION: 1/4" DIA. DEFORMED OR FLUTED NAIL AT SAME SPACING AS ABOVE, LENGTH AS REQ'D. FOR 14" MIN. EMBEDMENT.
- CONCRETE BLOCK (CMU): 1/4" DIA, ST. STL, SELF-TAPPING MASONRY SCREWS 2. AT 12" O.C. MAX. (AT EDGES), AND 16" O.C. MAX. IN THE FIELD, LENGTH AS REQUIRED FOR 1.50" MIN. EMBEDMENT. OPTION: 1/4" DIA. DEFORMED OR FLUTED NAIL AT SAME SPACING AS ABOVE, LENGTH AS REQ'D. FOR 14" MIN. EMBEDMENT.
- 3. BRICK: 1/4" DIA. ST. STL. SELF-TAPPING MASONRY SCREWS AT 12" O.C. MAX. (AT EDGES), AND 16" O.C. MAX. IN THE FIELD, LENGTH AS REQUIRED FOR 1.50" MIN. EMBEDMENT. OPTION: 1/4" DIA. DEFORMED OR FLUTED NAIL AT SAME SPACING AS ABOVE, LENGTH AS REQ'D. FOR 14" MIN. EMBEDMENT.
- 4. STRUCTURAL STEEL: #10 DIA. ST. STL. SELF-DRILLING, SELF-TAPPING SCREWS WITH "WINGS" AT 12" O.C. MAX. (AT EDGES), AND 16" O.C. MAX. IN THE FIELD, LENGTH AS REQ'D. FOR 1/2" MIN. PENETRATION OF THREADS THROUGH STEEL.
- 5. METAL DECK: #10 DIA. SELF-TAPPING "DECK" SCREWS AT 12" O.C. MAX. (AT EDGES), AND 16" O.C. MAX. IN THE FIELD, LENGTH AS REQUIRED FOR 1/2" MIN. PENETRATION THROUGH UNDERSIDE OF DECK.
- 6. LIGHT GAGE METAL FRAMING: #10 DIA. SELF-TAPPING "DECK" SCREWS AT 12" O.C. MAX. (AT EDGES), AND 16" O.C. MAX. ALONG EACH FRAMING MEMBER. LENGTH AS REQ'D FOR 1/2" MIN. PENETRATION THROUGH, FRAMING. FRAMING TO BE SPACED AT 24" O.C. MAX., UNLESS NOTED OTHERWISE BY DETAILS.
- 1. WOOD FRAMING: #10 DIA. SELF-TAPPING "DECK" SCREWS AT 12" O.C. MAX. ALONG EACH FRAMING MEMBER, LENGTH AS REQUIRED FOR 1.50" MIN. EMBEDMENT. OPTION: 8d ANNULAR RING NAILS AT 6" O.C. MAX. (AT EDGES) AND 12" O.C. MAX. IN FIELD OF PANEL. DECREASE SPACING AT ROOF EDGE 4 CORNER WIND ZONES TO 4" O.C. MAX. AT EDGES, AND 8" O.C. MAX. IN FIELD.
- D. METAL DECKING:
- 1. INSTALL AND SECURE PER STEEL JOIST INSTITUTE (SJI) GUIDELINES, SEE SPECIFICATIONS OR STRUCTURAL DETAILS FOR ADDITIONAL INFORMATION.
- E. MINOR STRUCTURAL STEEL
- ANCHORAGE OF LOAD BEARING STEEL AND LARGE STEEL FABRICATIONS, (SUCH AS LADDERS), IS TO BE AS DEFINED BY STRUCTURAL ENGINEERING. DRAWINGS OR AS ENGINEERED BY THE SUPPLIER. MINOR STRUCTURAL STEEL WOULD BE CONSIDERED ITEMS SUCH AS SUPPORT STANDS, WALL LEDGER ANGLES, ETC.
- 2. CONCRETE: 3/8" DIA, HEAVY-DUTY, SLEEVE STYLE EXPANSION BOLT ANCHOR (RAWL-BOLT) @ 16" O.C., LENGTH AS REQ'D FOR 2" MIN. EMBEDMENT.

- 3. CONCRETE BLOCK (CMU): 3/8" DIA. HEAVY-DUTY, SLEEVE STYLE EXPANSION BOLT ANCHOR (RAWL-BOLT) @ 16" O.C., LENGTH AS REQUIRED FOR 2" MIN. EMBEDMENT. IF CMU 16 HOLLOW, BREAK INTO BLOCK ABOVE, AND FILL CELL OF BLOCK TO RECEIVE ANCHOR SOLID, PERFORM ANY REPAIR AND PATCHING NECESSARY
- 4. BRICK: 3/8" DIA, HEAVY-DUTY, SLEEVE STYLE EXPANSION BOLT ANCHOR (RAWL-BOLT) @ 16" O.C., LENGTH AS REQ'D FOR 2" MIN. EMBEDMENT.
- 5. STRUCTURAL STEEL: 1/4" DIA. ST. STL. SELF-DRILLING, SELF-TAPPING SCREWS @ 16" O.C. MAX., LENGTH AS REQUIRED FOR 1/2" MIN. PENETRATION OF THREADS THROUGH STEEL.
- F. RIGID INSULATION BOARD
- 1. INSTALL AND SECURE PER THE MANUFACTURER'S RECOMMENDATIONS, TESTING AND APPROVALS TO COMPLY WITH THE DESIGN REQUIREMENTS OF THIS PROJECT. SEE PROJECT SPECIFICATIONS AND FASTENING DETAIL FOR ADDITIONAL INFORMATION.
- G. ROOF MEMBRANE SYSTEM
- 1. INSTALL AND SECURE PER THE MANUFACTURER'S RECOMMENDATIONS, TESTING AND APPROVALS TO COMPLY WITH THE DESIGN REQUIREMENTS OF THIS PROJECT. SEE PROJECT SPECIFICATIONS AND FASTENING DETAIL FOR ADDITIONAL INFORMATION.
- H. FLANGED SHEETMETAL (EDGE METAL):
- WOOD BLOCKING: #12 GAGE x 1.50" ANNULAR RING STAINLESS STEEL ROOFING NAILS AT 4" O.C. MAX., STAGGERED IN 2 ROWS INSET AT 3/4"+ FROM EACH EDGE OF THE FLANGE.
- 2. LIGHTGAGE METAL: #10 DIA. STAINLESS STEEL, SELF TAPPING, WAFER OR FLAT HEAD SCREWS AT 12" O.C. MAX., 8" O.C. WITHIN ROOF CORNER ZONES, LENGTH AS REQUIRED FOR 1/2" MIN. PENETRATION OF THREADS THROUGH STEEL.
- 3. CONCRETE: 3/16" DIA. ST. STL. SELF-DRILLING, SELF-TAPPING, MASONRY SCREW, LENGTH AS REQUIRED FOR 1.50" MIN. EMBEDMENT. OPTION: 1/4" DIA. x 1.50" LONG ZAMAC "NAIL-IN" DRIVE PIN, EXPANSION TYPE FASTENER WITH A STAINLESS STEEL DRIVE PIN. INSTALL AT 12" O.C. MAX., 8" O.C. WITHIN ROOF CORNER ZONES
- CLEATS FOR SHEETMETAL FLASHINGS:
- WOOD BLOCKING: #12 GAGE × 1.50" ANNULAR RING, STAINLESS STEEL ROOFING. NAILS AT 8" O.C. MAX, (4" O.C. AT CORNER ZONES OF ROOF)
- LIGHTGAGE METAL: #10 DIA, STAINLESS STEEL, SELF TAPPING, WAFER OR FLAT HEAD SCREWS, LENGTH AS REQ'D FOR $\frac{1}{2}$ " MIN. PENETRATION OF THREADS THROUGH STEEL, LOCATE AT 10" O.C. MAX., 6" O.C. WITHIN ROOF CORNER ZONES,
- CONCRETE: 3/16" DIA. ST. STL. SELF-DRILLING, SELF-TAPPING, MASONRY SCREW, LENGTH AS REQUIRED FOR 1.50" MIN. EMBEDMENT. OPTION: 1/4" DIA. X 1.50" LONG ZAMAC "NAIL-IN" DRIVE PIN, EXPANSION TYPE FASTENER WITH A STAINLESS STEEL DRIVE PIN. INSTALL AT 10" O.C. MAX., 6" O.C. WITHIN ROOF CORNER ZONES.
- 4. CONCRETE BLOCK (CMU): 3/16" DIA. ST. STL. SELF-DRILLING, SELF-TAPPING, MASONRY SCREW, LENGTH AS REQUIRED FOR 1.50" MIN. EMBEDMENT. OPTION: 1/4" DIA. X 1.50" LONG ZAMAC "NAIL-IN" DRIVE PIN, EXPANSION TYPE FASTENER WITH A STAINLESS STEEL DRIVE PIN. INSTALL AT 10" O.C. MAX., 6" O.C. WITHIN ROOF CORNER ZONES.
- 5. BRICK: 1/4" DIA. ST. STL. SELF-DRILLING, SELF-TAPPING, MAGONRY SCREW, LENGTH AS REQUIRED FOR 1.50" MIN. EMBEDMENT. OPTION: 1/4" DIA. × 1.50" LONG ZAMAC "NAIL-IN" DRIVE PIN, EXPANSION TYPE FASTENER WITH A STAINLESS STEEL DRIVE PIN. INSTALL AT 10" O.C. MAX., 6" O.C. WITHIN ROOF CORNER ZONES.
- APPLIED SHEETMETAL (COUNTERFLASHINGS, ETC.)
- WOOD BLOCKING: #12 DIA, SELF-TAPPING, STAINLESS STEEL SCREWS AT 8" O.C. MAX., LENGTH AS REQUIRED FOR 1.25" MIN. EMBEDMENT INTO WOOD. IF EXPOSED TO THE WEATHER, USE "SCOTS" TYPE SCREW WITH INTEGRAL NEOPRENE SEALING WASHER.
- SHEETMETAL BACKING: #12" DIA. SELF-TAPPING STAINLESS STEEL SCREWS AT 2. 8" O.C. MAX., LENGTH AS REQ'D FOR 1/2" MIN. PENETRATION OF THREADS THROUGH STEEL. IF EXPOSED TO THE WEATHER PROVIDE "SCOTS" TYPE SCREW WITH INTEGRAL NEOPRENE SEALING WASHER.
- CONCRETE: 1/4" DIA SELF-TAPPING STAINLESS STEEL MASONRY SCREWS AT 8" 3. O.C. MAX., LENGTH AS REQUIRED FOR 14" MIN. EMBEDMENT. OPTION: 1/4" DIA. X 1.50" ZAMAC "NAILIN" DRIVE PIN, EXPANSION TYPE FASTENERS @ 8" O.C. MAX., WITH STAINLESS STEEL DRIVE PIN. IF EXPOSED TO THE WEATHER PROVIDE METAL BACKED NEOPRENE SEALING WASHERS - ADJUST LENGTH AS REQ'D BY OVERLYING FINIGH TO MAINTAIN 1.25" MIN. EMBEDMENT INTO CONCRETE.
- 4. CONCRETE BLOCK (CMU): 1/4" DIA. SELF-TAPPING STAINLESS STEEL MASONRY SCREWS AT 8" O.C. MAX., LENGTH AS REQUIRED FOR 1.25" MIN. EMBEDMENT. OPTION: 1/4" DIA. X 1.50" ZAMAC "NAILIN" DRIVE PIN EXPANSION TYPE FASTENERS @ 8" O.C. MAX., WITH STAINLESS STEEL DRIVE PIN. IF EXPOSED TO THE WEATHER PROVIDE METAL BACKED NEOPRENE SEALING WASHERS-INCREASE LENGTH IF REQ'D BY OVERLYING FINISH FOR 1.25" MIN. EMBEDMENT INTO CONCRETE BLOCK.
- BRICK: 1/4" DIA. SELF-TAPPING STAINLESS STEEL MASONRY SCREWS AT 8" O.C. 5 MAX., LENGTH AS REQUIRED FOR 1.25" MIN. EMBEDMENT. OPTION: 1/4" DIA. X 1.50" ZAMAC "NAILIN" DRIVE PIN EXPANSION TYPE FASTENERS @ 8" O.C. MAX., WITH STAINLESS STEEL DRIVE PIN. IF EXPOSED TO THE WEATHER PROVIDE METAL BACKED NEOPRENE SEALING WASHERS- INCREASE LENGTH IF REQ'D BY OVERLYING FINISH FOR 1.25" MIN. EMBEDMENT INTO BRICK.



Architecture Roof Consulting Construction Technology 601 North Fern Creek Avenue Suite 100 Orlando, FL. 32803-4899 Tel. 407-896-7875 Fax. 407-898-6043



| Y: DATE: | 07/20 :: SHOWN | | | | | |
|-----------------------|-------------------------|--------------------------------------|-------------------------|-------------------------------------|--------------|---|
| | CITY OF FORT LAUDERDALE | | PUBLIC WORKS DEPARTMENT | ENGINEERING & ARCHITECTURE | FIELD BOOK | NOUTH ATHLEWS AVEILLE, FOIL LAURE UAIE, FIOLIUA 33301 |
| | | | 1111 | | | |
| REVISIONS | DESCRIPTION | ROOF REPAIR | | | | |
| | BY CHK'D | TJG JWR | | | | |
| | DATE | 4/9/2021 | | | | |
| | NO. | 6 | | | | |
| | | PUBLIC WORKS ADMINISTRATION BUILDING | HVAC RENOVATIONS | GEN. ROOFING NOTES & FASTENING SCH. | | |
| SHI | EET | | • | |))F 5 | |
| TOTAL: 5 CAD FILE: | | | | | | |

Bid 12467-113

944 924

AMI 89

21013.00_DOCUMENTS.dwg

21013.00_QQGUMENTS.dwg

DRAWING FILE NO.

SECTION 05 50 00 METAL FABRICATIONS

PART 1 GENERAL

1.1 SUMMARY

- A. Section Includes:
 - 1. Shop fabricated aluminum exterior wall rails and related items.
 - 2. Miscellaneous steel tubing and angles required for elevating and supporting HVAC equipment, piping and duct work.
 - 3. Drawings and general provisions of the Contract, including General and Supplementary Conditions and Division 1 Specification sections, apply to work of this section.
- B. Related Sections:
 - 1. Section 07 62 00 Sheet Metal Flashing

1.2 REFERENCES

- A. ASTM– American Society for Testing and Materials
 - 1. ASTM B 209 Standard Specification for Aluminum and Aluminum-Alloy Sheet and Plate.
 - 2. ASTM B 221 Standard Specification for Aluminum and Aluminum-Alloy Extruded Bars, Rods, Wire, Profiles, and Tubes.
 - 3. ASTM B 241 Standard Specification for Aluminum-Alloy Seamless Pipe and Seamless Extruded Tube.
 - 4. ASTM E 985 Standard Specification for Permanent Metal Railing Systems and Rails for Buildings.
- B. AAMA American Architectural Manufacturers Association
 - 1. 611 Voluntary Specification for Anodized Architectural Aluminum.
 - 2. 2603 Voluntary Specification, Performance Requirements and Test Procedures for Pigmented Organic Coatings on Architectural Extrusions and Panels.
 - 3. 2604 Voluntary Specification, Performance Requirements and Test Procedures for High Performance Organic Coatings on Architectural Extrusions and Panels.
 - 4. 2605 Voluntary Specification, Performance Requirements and Test Procedures for Superior Performing Organic Coatings on Architectural Extrusions and Panels.
- C. ANSI American National Standards Institute
 - 1. ANSI A14.3 Ladders, Fixed, Safety Requirements

- D. AWS American Welding Society
 - 1. AWS D1.2 Structural Welding Code Aluminum.
- E. SSPC Society for Protective Coatings
 - 1. SSPC Painting Manual

1.3 DESCRIPTION OF WORK

- A. Definition: Metal fabrications include items made from aluminum and/or steel shapes, plates, bars, strips, tubes, pipes and castings which are not a part of other structural metal systems specified elsewhere.
- B. Types of work in this section include metal fabrications for:
 - 1. Wall mounted ladders (aluminum).
 - 2. Roof and wall mounted guardrails (aluminum).
 - 3. Miscellaneous aluminum and/or fabrications.

1.4 SUBMITTALS

- A. Submittals in accordance with Division 1 provisions.
- B. Shop Drawings:
 - 1. Indicate profiles, sizes, connection attachments, reinforcing, anchorage, size and type of fasteners, and accessories. Include erection drawings, elevations, and details where applicable.
 - 2. Field Measurements: Take field measurements prior to preparation of shop drawings and fabrication, where possible. Do not delay job progress; allow for trimming and fitting where taking field measurements before fabrication might delay work.
 - 3. Submit shop drawings for fabrication and erection of miscellaneous metal fabrications. Include plans, elevations and details of sections and connections. Show anchorage and accessory items. Provide templates for anchor and bolt installation by others.
 - 4. Indicate welded connections using standard AWS A2.0 welding symbols. Indicate net weld lengths.
- C. Welder Certificates
 - 1. Submit Welder Certificates certifying welders employed on the Work, have been AWS qualified within the previous 12 months.
- D. Shop Assembly:
 - 1. Preassemble items in shop to greatest extent possible to minimize field splicing and assembly. Disassemble units only as necessary for shipping and handling limitations. Clearly mark units for reassembly and coordinated installation.
- E. Samples: Typical Joint Sample finished in accordance with NOMMA Guideline #

1.5 QUALITY ASSURANCE

A. Finish joints in accordance with NOMMA Guideline 1.

- B. Perform Work in accordance with good industry standards and the current Florida Building Code.
- 1.6 QUALIFICATIONS
 - A. Fabricator Qualifications: Minimum 10 years documented experience in work of this Section
 - B. Design ladders and railings under direct supervision of a Professional Engineer experienced in design of this type of work and licensed in the State of Florida.
 - C. Mockup:
 - 1. Provide a mock-up of requested metal fabrications. Locate where directed.
 - 2. Approved mockup may remain as part of the Work.

1.7 JOB CONDITIONS

- A. Existing Conditions
 - 1. This project involves metal fabrication work on existing building(s). Verify existing conditions and other fabrications visible conditions prior to bidding.
 - 2. Report conflicts and problems to the Architect prior to bidding for resolution. Failure to report these conflicts and problems places the responsibility on the Contractor to complete the work in accordance with the Documents at no additional cost to the Owner.
 - 3. Failure to install the work in strict accordance with provisions of this Section is subject to total rejection of work specified herein.

1.8 DELIVERY, STORAGE AND HANDLING

- A. Store and handle products in accordance with the provisions of Division 1.
- B. Accept metal fabrications on site in labeled shipments. Inspect for damage.
- C. Protect metal fabrications from damage by exposure to weather.

1.9 FIELD MEASUREMENTS

A. Verify that field measurements are as indicated on approved shop drawings.

PART 2 PRODUCTS

2.1 MANUFACTURERS

- A. Acceptable Manufacturers (fabricators)
 - 1. ACL Industries, Inc Aluminum Access Ladders
 - 2. Superior Aluminum Products Aluminum Pipe Railing
 - 3. The Wagner Companies Aluminum Pipe Railing
- B. Substitutions are permitted under the provisions of Division 1

2.2 MATERIALS – GENERAL

- A. Metal Surfaces, General: For fabrication of miscellaneous metal work which will be exposed to view, use only materials which are smooth and free of surface blemishes including pitting, seam marks, roller marks, rolled trade names and roughness.
- 2.3 MATERIALS ALUMINUM
 - A. Extrusions: ASTM B221, 6063-T5 alloy and temper.
 - B. Sheet: ASTM B209, alloy and temper best suited to application.
 - C. Pipe: ASTM B241, extruded, anodizing quality, Schedule 40, 6063 aluminum pipe, temper T4
 - D. Base Flanges, anchors and railing accessories: ASTM B 247.
 - 1. Manufacturer's standard 713 aluminum alloy cast bases or solid aluminum 6063 stock.
 - E. Fasteners: Provide concrete anchorage for fastening and complying with applicable codes and standards. All fasteners used in the system shall be aluminum or stainless steel.
 - F. Anchoring Grout: Non-shrink Portland cement-based hydraulic grout mixed and applied in accordance with manufacturer's instructions; gypsum based material is not acceptable.
 - 1. Provide formulation that is resistant to erosion from water exposure without needing protection by a sealer or waterproof coating and that is recommended by manufacturer for exterior use.

2.4 MATERIALS – STEEL

- A. Steel Plates, Shapes and Bars: ASTM A 36
- B. Galvanized Structural Steel Sheet: ASTM A 446, of grade required for design loading. Coating designation shall be G90.
- C. Brackets, Flanges and Anchors: Cast or formed metal of the same type material and finish as supported rails.
- D. Concrete Inserts: Threaded or wedge type; galvanized ferrous castings, either malleable iron, ASTM A 47, or cast steel, ASTM A 27. Provide bolts, washers and shims as required, hot-dip galvanized, ASTM A 153
- E. Galvanizing Repair Paint: High zinc dust content paint for re-galvanizing welds in galvanized steel, complying with the Military Specifications MIL-P-21035 (Ships) or SSPC-Paint-20

2.5 ACCESSORIES AND FASTENERS (ALL METALS)

- A. General: Provide fasteners of the same material as the metal being fastened zinccoated fasteners for exterior use or where built into exterior walls. Select fasteners for the type, grade and class required.
- B. Bolts and Nuts: Regular hexagon head type, ASTM A 307, Grade A.
- C. Lag Bolts: Square head type, FS FF-B-561.
- D. Machine Screws: Cadmium plated steel, FS FF-S-92.
- E. Wood Screws: Flat head carbon steel, FS FF-S-111.
- F. Plain Washers: Round, carbon steel, FS FF-W-92.
- G. Masonry Anchorage Devices: Expansion shields, FS FF-S-325.
- H. Toggle Bolts: Tumble-wing type, FS FF-B-588, type, class and style as required.
- I. Anchoring Cement Non-shrink cementitious, non-metallic; Pre-mixed, factory packaged, non-staining, non-corrosive, non-gaseous grout. Provide grout specifically recommended by manufacturer for interior and exterior applications of type specified in this section.

2.6 FABRICATION

- A. General:
 - 1. <u>Workmanship</u>: Use materials of size and thickness indicated or, if not indicated, as required to produce strength and durability in finished product for use intended. Work to dimensions shown or accepted on shop drawings, using proven details of fabrication and support. Use type of materials shown or specified for various components of work.
 - 2. Form exposed work true to line and level with accurate angles and surfaces and straight sharp edges. Ease exposed edges to a radius of approximately 1/32" unless otherwise shown. Form bent metal corners to smallest radius possible without causing grain separation or otherwise impairing work.
 - 3. Weld corners and seams continuously, complying with AWS recommendations. At exposed connections, grind exposed welds smooth and flush to match and blend with adjoining surfaces.
 - 4. Form exposed connections with hairline joints, flush and smooth, using concealed fasteners wherever possible. Use exposed fasteners of type shown or, if not shown, Phillips flat-head (countersunk) screws or bolts.
 - 5. Provide for anchorage of type shown, coordinated with supporting structure. Fabricate and space anchoring devices to provide adequate support for intended use.
 - 6. Provide for anchorage of type shown, coordinated with supporting structure. Fabricate and space anchoring devices to provide adequate support for intended use.
 - 7. Fabricate joints which will be exposed to weather in a manner to exclude water or provide weep holes where water may accumulate.

2.7 FINISHES

- A. Aluminum:
 - 1. Exterior aluminum surfaces: Exterior anodized clear finish
 - 2. Apply two (2) coats of bituminous paint to concealed aluminum surfaces in contact with cementitious or dissimilar materials.
 - 3. Apply non-slip abrasive coating to aluminum grate platform and rungs (aluminum oxide granules set in epoxy resin adhesive).
- B. Steel-
 - 1. Prepare surfaces to be primed in accordance with SSPC SP 2.1
 - 2. Galvanizing for fabrications: Hot Dip ASTM A 123, after fabrication.
 - 3. Galvanizing for fasteners, connectors and anchors: Hot Dip ASTM A 153.

PART 3 EXECUTION

- 3.1 EXAMINATION AND PREPARATION
 - A. Verify that field conditions are acceptable and are ready to receive the work of this Section.
 - B. Field Measurement: Take field measurements prior to preparation of shop drawings and fabrication where possible. Do not delay job progress; allow for trimming and fitting where taking field measurements before fabrication might delay work.
 - C. Coordinate and furnish anchorages, setting drawings, diagrams, templates, instructions, and directions for installation of anchorages, such as concrete inserts, sleeves, anchor bolts and miscellaneous items having integral anchors, which are to be embedded in concrete or masonry construction. Coordinate delivery of such items to project site.

3.2 INSTALLATION

- A. Fastening to In-place Construction: Provide anchorage devices and fasteners where necessary for securing miscellaneous metal fabrications to in-place construction: including, threaded fasteners for concrete and masonry inserts, toggle bolts, thru-bolts with plate washers, lag bolts, wood screws and other connectors as required. Verify existing conditions for determining proper anchorage.
- B. Cutting, Fitting and Placement: Perform cutting, drilling and fitting required for installation of miscellaneous metal fabrications. Set work accurately in location, alignment and elevation, plumb, level, true and free of rack, measured from established lines and levels. Provide temporary bracing or anchors in formwork for items which are to be built into concrete, masonry or similar construction.
- C. For hollow masonry anchorage, use toggle bolts having square heads.

3.3 ERECTION TOLERANCES

A. Section 01 40 00 - Quality Requirements: Tolerances

3.4 SCHEDULES

- The following Schedule is a list of principal items only. Refer to Project Details for items not specifically scheduled.1. Life Safety wall mounted Rails Α.

 - Piping and ductwork support post stands 2.

END OF SECTION

SECTION 06 10 53 ROUGH CARPENTRY

PART 1 GENERAL

1.1 SUMMARY

- A. Section includes:
 - 1. Miscellaneous framing and sheathing;
 - 2. Nailers and blocking,
 - 3. Preservative treatment of wood where indicated.
- B. The specifications in this section are not project specific. Contractor shall review the actual project conditions to determine the roof system components most appropriate to provide a successful outcome.

1.2 REFERENCES

- A. American National Standards Institute:
 - 1. ANSI A208.1 Mat-Formed Wood Particleboard.
- B. American Wood-Preservers' Association:
 - 1. AWPA Standard U1, UC 1-4 All Timber Products Preservative Treatment by Pressure Process.
 - 2. AWPA Standard U1, UCF A and B Structural Lumber Fire-Retardant Treatment by Pressure Processes.
- C. ASTM International:
 - 1. ASTM E84 Standard Test Method for Surface Burning Characteristics of Building Materials.
- D. National Fire Protection Association:
 - 1. NFPA 255 Standard Method of Test of Surface Burning Characteristics of Building Materials.
- E. Southern Pine Inspection Bureau:
 - 1. SPIB Standard Grading Rules for Southern Pine Lumber.
- F. Underwriters Laboratories Inc.:
 - 1. UL 723 Tests for Surface Burning Characteristics of Building Materials.
- G. U. S Department of Commerce National Institute of Standards and Technology:
 - 1. DOC PS 1 Construction and Industrial Plywood.
 - 2. DOC PS 2 Performance Standard for Wood-Based Structural-Use Panels.
 - 3. DOC PS 20 American Softwood Lumber Standard.
- 1.3 SUBMITTALS
 - A. Section 01 33 00 Submittal Procedures
 - B. Product Data: Submit technical data on
 - 1. Wood /Plywood

- 2. Fasteners and Anchors
- 3. Wood preservative and fire retardant treatment materials and application instructions.
- 4. MSDS of treatment materials.
- C. Samples:
 - 1. Fastener types : Two (2) of each type
 - 2. Material Samples, if requested by the Architect.

1.4 QUALITY ASSURANCE

- A. Perform Work in accordance with the following:
 - 1. Lumber Grading Agency: Certified by DOC PS 20.
 - 2. Lumber: DOC PS 20.
- B. Surface Burning Characteristics:
 - 1. Fire Retardant Treated Materials: Maximum 25/450 flame spread/smoke developed index when tested in accordance with ASTM E84.
- C. Apply label from agency approved by authority having jurisdiction to identify each preservative treated and fire retardant treated material.
- D. Perform Work in accordance with current Florida Building Code requirements.
- 1.5 DELIVERY, STORAGE, AND HANDLING
 - A. Deliver to site, store, protect, and handle products under provisions of Section 01 60 00.
 - B. Protect materials from physical damage. Store materials on raised platform and protect from weather.

1.6 PROJECT CONDITIONS

- A. Existing Conditions
 - 1. Verify existing conditions, such as soundness of perimeter conditions, and varying deck and wall thickness for length of anchoring surfaces required and other visible conditions prior to bidding. Nailers height indicated on the details may vary from actual requirement. Coordinate nailer height with lightweight concrete supplier prior to bidding.
 - 2. Report conflicts or problems to the Architect for resolution prior to Bidding. Failure to report these conflicts and problems places the responsibility on the Contractor to complete the work in accordance with the Documents at no additional cost to the Owner.
 - 3. Replace or restore to original condition any materials or work damaged during construction.

- 4. Surfaces not designated to receive the system shall be properly masked or otherwise protected against accidental spillage or application of the material to those areas.
- 5. Failure to install the work in strict accordance with provisions of this Section, is subject to total rejection of work specified herein.
- 6. The bulk of the carpentry work for this project is the correction of the roof edge condition to provide a uniform 3:12 roof slope as indicated by the details, the contractor must review and be familiar with this condition prior to bidding.

PART 2 PRODUCTS

2.1 MATERIALS

- A. Lumber Grading Rules: SPIB.
- B. Blocking, Battens, Studding, Nailers, Curb Extensions (within roof system) and Fascia Replacement: Stress Group D, 1x and 2x (as noted in drawings), No. 2 Grade Southern Yellow Pine species, 19 percent maximum moisture content, pressure preservative treated where noted by project details.
 - 1. Nominal sizes are shown or specified within the project documents, except as shown by actual dimensions.
- C. Plywood Sheathing/Decking:
 - 1. <u>Protected location within roof system or as noted on drawings</u> (under membrane): APA Rated, Structural I, Span Rating – 40/20, 5/8" nominal thickness (unless otherwise noted on plans or details), Grade: CDX; pressure preservative treated (and fire retardant treated) where noted on project details.
 - 2. <u>Exposed locations within roof system or as noted on drawings</u>: APA Rated Sheathing, Span rating 40/20, Thickness: nominal 5/8", (or as noted otherwise on drawings), CDX Grade; pressure preservative treated at locations in contact with concrete, masonry, or other materials capable of retaining moisture. (and fire retardant treated where noted).

2.2 ACCESSORIES

- A. Fasteners and Anchors:
 - 1. <u>All fasteners</u>: For high humidity and <u>treated wood locations</u> shall be stainless steel and/or hot dip galvanized steel.
 - a. Wood (Framing): 1/4" screw x 2" penetration.
 - b. Wood (Framing): 12d pneumatically driven nail with heat activated adhesive.
 - c. Sheathing: 8d and 12d pneumatically driven, annular "ring" shank nail with heat activated adhesive.
 - d. Concrete/Masonry: 1/4" "tapcon" or "Zamac Nail-in" x 1-1/2" minimum penetration into concrete or masonry.
 - 2. Nails: ASTM F1667; ring-shanked, except as otherwise directed.
 - 3. Anchors:
 - a. Toggle bolt or self-threading type for anchorage to hollow masonry.
 - b. Expansion shield and lag bolt/drive pin or self-threading type for anchorage to solid masonry or concrete.

- c. Bolt or ballistic fastener for anchorages to steel.
- 4. Construction adhesive:
 - a. Cartridge "gun" dispensed structural construction adhesive, such as "Liquid Nails" or approved equal.
 - b. Compliance with ASTM D 3498 (latest edition)
- 5. Sheathing Joint Tape:
 - a. Three (3) inch wide polyethylene coated cloth tape with rubber resin adhesive, Scotch 3M Product #6969 or equal.
- 2.3 FACTORY WOOD TREATMENT "USE CATEGORY SYSTEM" (AWPA Standard U1)
 - A. <u>Use Category UC1</u> Interior/Dry Conditions: Wood and wood based materials used in interior construction not in contact with the ground or foundations or any sources of moisture including roof and plumbing leaks.
 - Wood Preservative (Pressure Treatment): AWPA Standard U1, Use Category 2 (UC2) or 3 (UC3); minimum of 0.25 pounds of ACQ-C (Alkaline Copper Quaternary) water borne preservative per cubic foot of wood product.
 - B. <u>Use Category UC2</u> Interior/Damp Conditions: Wood and wood based materials used in interior construction not in contact with the ground protected from direct exposure to the weather but may be subject to dampness (e.g., roof/curb blocking or plywood sheathing.
 - Wood Preservative (Pressure Treatment): AWPA Standard U1, Use Category 2 (UC2) or 3 (UC3); minimum of 0.25 pounds of ACQ-C (Alkaline Copper Quaternary) water borne preservative per cubic foot of wood product.
 - C. Use Category UC4A General Use Conditions: Wood and wood-based materials used in contact with the ground, fresh water or other situations favorable to deterioration.
 - 1. Wood Preservative (Pressure Treatment): AWPA Standard U1, Use Category 4A (UC4A); minimum of 0.40 pounds of ACQ-C (Alkaline Copper Quaternary) water borne preservative per cubic foot of wood product.
 - D. <u>Fire Retardant Treatment for Wood/Plywood (FRTW)</u>: FRT plywood shall be impregnated with chemicals by a pressure process. Fire retardant chemical shall provide protection against termites and fungal decay, shall be registered for use as a wood preservative by the U.S. Environmental Protection Agency (EPA), shall comply with formulation FR-1 of the current edition of AWPA Standard P49, and shall be free of halogens, sulfates and ammonium phosphate. Treated wood shall have a flamespread of less than 25 when tested in an extended 30 minute tunnel test in accordance with ASTM E 84, NFPA 255 or UL 723.
 - E. Wood preservatives shall not contain arsenic, chromium other EPA classified hazardous preservatives.

PART 3 EXECUTION

- 3.1 EXAMINATION
 - A. Section 01 30 00 Administrative Requirements: Verification of existing conditions before starting work.

- B. Verify substrate conditions are ready to receive blocking, curbing, sheathing and framing.
- C. Any use of the unit price allowances must be field verified and approved by the Owner and/or Architect prior to work being performed if possible. Any use of unit price allowances must be properly documented in order for payment to be authorized.

3.2 PREPARATION

A. Coordinate placement of blocking, curbing, sheathing and framing items.

3.3 INSTALLATION

- A. General:
 - 1. Discard material with defects which might impair quality of work and units which are too small to fabricate work with minimum joints or optimum joint arrangement.
 - 2. Set carpentry work accurately to required levels and lines, with members plumb and true and accurately cut and fitted.
 - 3. Securely attach carpentry work to substrate by anchoring and fastening as shown or as required by recognized standards. Countersink fastener heads on exposed carpentry work.
 - 4. Use fasteners and anchorages as indicated. Make tight connections between members. Install fasteners without splitting of wood; pre-drill as required. Holes drilled oversized or wallered out, shall be re-drilled.
 - 5. Place horizontal members, crown side up.
 - 6. Construct curb members of solid wood sections.
 - 7. Do not install wood nailers or sheathing more than one day in advance from installation of roofing. Install dry-in felt over any wood nailers and sheathing.
- B. Nailers, Blocking and Curb Extensions:
 - 1. Coordinate curb extensions and installation of wood nailers with roof construction work.
 - 2. Provide blocking and edging wherever shown and where required for screeding or attachment of other work.
 - 3. Set members level and plumb, in correct position.
 - 4. Construct curb members of single pieces.
 - 5. Curb roof openings [except where prefabricated curbs are provided]. Form corners by alternating lapping side members.
 - 6. Attach to substrates as required to support applied loading. Countersink bolts and nuts with washers flush with surfaces, unless otherwise shown.
 - 7. Where new members are doubled, ends shall be lapped and thoroughly spiked to each other and to bearing members.
 - 8. Where new members bear on concrete, securely fasten to same by bolts or lag screws on centers as called for on drawings, staggered. Provide heads of all bolts or lag screws with large-head washers.
 - 9. Round edges and corners of wood plates where flashing occurs.
- C. Plywood Sheathing (wall, curbs, parapets and roof, as applicable):
 - 1. Install sheathing properly framed to required lines, level and rigidly secured in place.
 - 2. Cut sheathing sections to fit. Leave 1/8" clearance between panels at side laps. Cover sheathing with dry-in felt and seal top horizontal edge.

3.4 SCHEDULES

- A. Roof Perimeter Nailers, Curbs and Curb Extensions: See project manual details and plans for sizes and locations.
- B. General Framing Lumber (as applicable): See project manual details and plans for sizes.
- C. Plywood Sheathing (as applicable): See project manual details and plans for locations.

END OF SECTION

SECTION 07 01 50 REPAIR SPECIFICATION FOR MODIFEID BITUMEN ROOFING SYSTEMS

PART 1 GENERAL

1.1 SECTION INCLUDES

- A. Connection of new flashing to existing modified bitumen roofing system membrane where new construction abuts existing construction as indicated on the drawings.
- B. Extension of existing modified bitumen roofing system membrane onto limited areas of new construction as indicated on the drawings.
- C. Miscellaneous modified bitumen roofing system membrane repairs.
- D. Sacrificial pads for condensate piping supports (adhesive application)

1.2 RELATED SECTIONS

- A. Section 06 10 53 Rough Carpentry: Wood blocking and nailers for roofing substrate profiles.
- B. Section 07 62 00 Sheet Metal Flashing and Trim
- C. Section 07 65 00 Roof Penetration Flashing.
- D. Section 07 92 00 Joint Sealers.

1.3 REFERENCES

- A. ASTM C 165: Recommended Practice for Measuring Compressive Properties of Thermal Insulations.
- B. ASTM C 518: "Test Method for Steady-State Heat Flux Measurements and Thermal Transmission Properties by Means of the Heat Flow Meter Apparatus.
- C. ASTM E 96: Test Methods for Water Vapor Transmission of Materials.
- D. ASTM D 5: Penetration of Bituminous Materials.
- E. ASTM D 36: Test Method for Softening Point of Bitumen (Ring-and-Ball Apparatus).
- F. ASTM D 41: Specification for Asphalt Primer Used in Roofing and Waterproofing.
- G. ASTM D 92: Test for Flash and Fire Points by Cleveland Open Cup.
- H. ASTM D 312: Specification for Asphalt Used in Roofing.
- I. ASTM D 412: Rubber Properties in Tension.

- J. ASTM D 1668: Glass Fabrics (Woven and Treated) for Roofing and Waterproofing.
- K. ASTM D 573: Standard Test for Rubber Deterioration in an Air Oven.
- L. ASTM D 751: Standard Test Methods for Coated Fabrics.
- M. ASTM D 2178: Asphalt Glass Felt Used in Roofing and Waterproofing.
- N. ASTM D 2523: Standard Practice for Testing Load-Strain Properties of Roofing Membranes.
- O. ASTM D 4586: Specification for Asphalt Roof Cement, Asbestos Free.
- P. ASTM D 4601: Base Sheets, Inorganic, Asphalt Coated (for built-up roofs).
- Q. ASTM D 4073: Standard Test Method for Tensile-Tear Strength of Bituminous Roofing Membranes.
- R. ASTM D 4798: Standard Test Method for Accelerated Weathering Test Conditions and Procedures for Bituminous Materials (Xenon-Arc Method).
- S. ASTM D 5147: Standard Test Methods for Sampling and Testing Modified Bituminous Sheet Material.
- T. ASTM D 6163-98: Standard Specification for Styrene Butadiene Styrene (SBS) Modified Bitumen Sheet Materials using Glass Fiber Reinforcements.
- U. ASTM D 6164-98: Standard Specification for Styrene Butadiene Styrene (SBS) Modified Bitumen Sheet Materials using Polyester Reinforcements.
- V. ASTM D 6222-98: Standard Specification for Atactic Polypropylene (APP) Modified Bituminous Sheet Materials Using Polyester Reinforcements.
- W. ASTM D 6298-98: Standard Specification for Fiberglass Reinforced Styrene-Butadiene-Styrene (SBS) Modified Bituminous Sheets with a Factory Applied Metal Surface.
- X. ASTM E 84: Surface Burning Characteristics of Building Materials.
- Y. FM 4470 Base ply fasteners to meet Factory Mutual Research Approval Standard #4470
- Z. NRCA/ARMA Manual of Roof Maintenance and Roof Repairs.
- AA. NRCA (National Roofing Contractors Association) The NRCA Roofing and Waterproofing Manual.
- BB. ULI (Underwriters Laboratories, Inc.) Fire Hazard Classifications.
- 1.4 SYSTEM DESCRIPTION
 - A. Repairs to modified bitumen roofing systems utilizing hot and cold process techniques.

- B. Removal of all pitch pans from abandoned support posts, piping and conduit penetrations to have modified bitumen repairs at roof system.
- C. Modified bitumen flashing applied to new curbs, pipe support and conduit penetrations.

1.5 SUBMITTALS

- A. Product Data: Provide membrane materials, base flashing materials, insulation, vapor retarders and protective coating.
- B. Samples: Submit two sample 10 lb containers of roofing aggregate.
- C. Submit manufacturer's recommended primers.
- D. Manufacturer Notifications: (If Applicable) Submit repair notification to the manufacturer of existing roof system in accordance with that manufacturer's warranty requirements. Failure to notify manufacturer places remainder of warranty obligations on the Repair Contractor.
 - 1. Manufacturer's Installation Instructions: Indicate special precautions required for seaming the membrane for roofs to maintain a current warranty requirements.
 - 2. Manufacturer's Certificate: Certify that products installed on warranted roofs meet or exceed specified requirements.
 - 3. Manufacturer's Field Reports: Submit a Manufacturer's field report as follows:
 - a. Reports: Indicate procedures followed, ambient temperatures and wind velocity during application, and special conditions that occurred during the repairs.
- E. All products used shall be asbestos free.

1.6 QUALITY ASSURANCE

- A. Perform Work in accordance with NRCA Manual of Roof Maintenance and Roof Repairs except where NRCA requirements differ from the project manual requirements.
- B. Perform Work in accordance with the existing roof manufacturer's published or written details and recommendations and the project details, the most stringent shall govern.
- C. Maintain one copy of each document on site.
- D. Preliminary (Pre-Product Submittal) Roofing Conference: As soon as possible after award of roofing work, meet with roofing installer, roofing membrane manufacturer, flashing and sheet metal contractor, installers of substrate construction (decks), primary mechanical, electrical, and plumbing contractors other installers of rooftop work, Design Professional, Construction Manager, and representatives of other entities directly concerned with performance of roofing system including (as applicable) Owner's insurers and test agencies.

- 1. Review and discuss:
 - a. Coordination with other trades
 - b. Roofing and overall construction schedule
 - c. Governing regulations
 - d. Insurance requirements
 - e. Certification requirements
 - f. Submittal requirements
 - g. Warranty requirement
 - h. Availability of materials, equipment and personnel
 - i. Staging
 - j. Inspections
 - k. Testing
 - I. Weather related issues (rainfall will not be considered justification for project delays)
 - m. Roofing system protection
 - n. General roofing application procedures
- 2. The Design Professional shall record discussions, including agreement or disagreement on matters of significance; furnish copy of recorded discussions to each participant. If disagreements concerning contract requirements exist at conclusion of conference, determine how disagreements will be resolved and set date for reconvening conference.
- E. Pre-Application Roofing Conference: Approximately two weeks prior to scheduled commencement of roofing installation and associated work, meet at project site with roofing membrane installer, roofing membrane manufacturer, flashing and sheet metal contractor, primary mechanical, electrical and plumbing contractors, installers of deck or substrate construction to receive roofing work, installers of rooftop units and other work in and around roofing that must precede or follow roofing work, Design Professional, Construction Manager, and other representatives directly concerned with performance of the work, including (where applicable) Owner's insurers, test agencies, and governing authorities.
 - 1. Review and Discuss:
 - a. Outstanding submittals and resolution thereof
 - b. Roofing methods and procedures
 - c. Roofing and overall construction schedule
 - d. Availability of materials, equipment and personnel
 - e. Staging
 - f. Inspections
 - g. Testing
 - h. Weather related issues:
 - 1) Review weather and forecasted weather conditions
 - 2) Procedures for coping with unfavorable conditions.
 - 3) Night seals, water cutoffs, sealing of all penetrations and terminations.
 - 4) Liabilities associated with potential water intrusion.

- 2. Tour representative areas of roofing substrates (decks). Inspect and discuss:
 - a. Deck condition
 - b. Roof drain installations
 - c. Curbs
 - d. Penetrations (existing and planned)
 - e. Installation of nailers and blocking (coordination with insulation)
 - f. Abutting walls (parapets, penthouses, girder beams, other)
 - g. Any other preparatory work performed by other trades
 - h. Significant deviations from contract drawings.
- 3. Substrate Acceptance: The roofing membrane manufacturer and installer shall provide written acceptance of substrate conditions prior to start of roofing membrane application. Start of insulation and roofing membrane application will be considered full acceptance of substrate conditions by the roofing membrane manufacturer and installer.
- 4. The Design Professional shall record discussions of conference, including decisions and agreements (or disagreements) reached, and furnish copy of record to each party attending. If disagreements concerning contract requirements exist at conclusion of conference, determine how disagreements will be resolved and set date for reconvening conference.
- F. Non-Asbestos Containing Materials: Provide only roofing materials which are completely free of asbestos.

1.7 QUALIFICATIONS

- A. Manufacturer: Company specializing in manufacturing the products specified in this section with five years current documented experience. Materials provided for repairs shall be identical to the existing roofing materials in place, or be certified as compatible for use with the existing materials in place by the original manufacturer if the existing roofing system is still within the original warranty period.
- B. Older roof systems no longer under warranty: Materials provided for repairs shall be of the same type as the existing roofing materials in place, and be certified as compatible for use with the existing materials in place by the manufacturer/ supplier of the repair materials.
- C. Applicator: A single installer specializing in performing the work of this section with three current years documented experience and approved in writing by system manufacturer a minimum of 10 days prior to Bidding.
 - 1. Original Manufacturer's Warranty Period: If the existing roof system is still within the original manufacturer's warranty period, all repairs and modifications to the roof system shall be done by an applicator approved in writing by the original manufacturer a minimum of 10 days prior to Bidding.
 - 2. Original Applicator's Warranty Period: If the existing roof system is still within the original applicator's warranty period, all repairs and modifications to the roof system shall be done by an applicator approved in writing by the original applicator

a minimum of 10 days prior to Bidding.

- D. Manufacturer's Field Inspection and Services (Warranty Work Only)
 - 1. Manufacturer of the roofing materials shall provide qualified personnel to observe field conditions of surfaces and installation, quality of workmanship as applicable, and to make appropriate recommendations.
 - 2. Representative shall submit written reports, within seven days of visit to Contractor and Construction Manager listing observations, recommendations and related comments.

1.8 REGULATORY REQUIREMENTS

- A. Provide materials complying with governing regulations and codes installed to comply with the following:
 - 1. UL Listing: Provide roofing system materials and component materials that have been tested for application and slopes indicated and are listed by Underwriters Laboratories, Inc. (UL) for Class A external fire exposure.
 - a. Provide roof covering materials bearing UL Classification Marking on bundle, package, or container containing that materials have been produced under UL's Classification and Follow-up Service.
 - FM Listing: Provide only roofing systems and component materials which have been evaluated and shown to meet the requirements of Factory Mutual for fire spread, wind up-lift and hail damage, and which are listed and approved for FM I-135 classification (FM I-150 for roof elevations in excess of 96 feet) in the current "Factory Mutual Research Corporation (FMRC) Approval Guide".
 - a. Provide roof-covering materials bearing FM approval marking on bundle, package or container indicating that material has been subjected to FM's examination and follow-up inspection service.
 - b. Reroofing systems over existing lightweight insulating concrete do not require Factory Mutual Listing, but shall comply with Factory Mutual standards and the requirements of the Florida Building Code.
- B. Wind Up-lift Criteria and Related Provisions:
 - 1. ASCE 7 Compliance: Minimum design pressures required by this Section for Miami Dade County Product Control Notice of Acceptance are based on Wind Load Uplift Pressure Calculations performed in accordance with the requirements of ASCE 7.
 - 2. The roofing contractor together with the membrane manufacturer shall be responsible for verifying adequate fastening of the roofing system based on wind uplift pressures calculated for the specific project and/or location. The Roofing Membrane Manufacturer shall submit a certified letter, signed jointly by the Roofing

Contractor, attesting to compliance with up-lift requirements required by this section.

1.9 CERTIFICATION

- A. Materials: For each material specified with a standard or reference material designation, certification labels shall appear on each package of bulk-shipments to project with certificate of compliance.
- B. Installer: Provide two copies of all certification to Construction Manager prior to beginning roofing work.
- C. The Contractor shall have pull tests conducted on the job site with the specified fasteners to determine the pull-out resistance of the existing deck. Submit the data to the Construction Manager.
- 1.10 NOTIFICATION TO Construction Manager
 - A. Twenty-four hours prior to the commencement of scheduled repairs, send written notification to Construction Manager regarding time Contractor's crew will be present on site. Indicate duration or time to perform repairs. Notification by Contractor is not required for emergency roof repairs. Notifications may be faxed to the Construction Manager.

1.11 DELIVERY, STORAGE, AND HANDLING

- A. If site storage is required, store rolls, cans and drums of cements, primers, and coatings, on end and over clean raised platforms.
- B. Store and handle materials to protect them from.
 - 1. Moisture, whether due to precipitation, or condensation.
 - 2. Temperatures over 110 degrees F or below 40 degrees F.
 - 3. Direct sunlight.
 - 4. Mud, dust, sand, oil and grease.
- C. Comply with fire, safety, and environmental protection regulations.
- D. Do not store materials on roof decks, nor position roofing installation equipment on roof decks, in concentrations exceeding design live loads.
- E. Take special precautions against traffic on roofing when ambient temperature is above 80 degree F. Avoid heavy traffic on the work during installation.

1.12 PROJECT CONDITIONS

- A. Environmental Requirements:
 - 1. Proceed with roofing work only when existing and forecast weather conditions will permit work to be performed in accordance with manufacturers' recommendations and warranty requirements.

- 2. Comply with manufacturer's recommended minimum and maximum installation temperatures. Do not proceed with roof installation during threatening or unfavorable weather conditions. If roofing work cannot be performed, provide the necessary protection to keep building watertight.
 - a. Do not expose materials vulnerable to water or sun damage in quantities greater than can be weatherproofed during the same day.
 - b. Do no apply roofing membrane when ambient temperature is below 40 degrees Fahrenheit (F).
- B. Existing Conditions:
 - 1. Contractor shall accept the conditions of the job site as they exist and perform his work accordingly. Any adverse condition which might affect the performance of the work described in these specifications must be brought to the attention of the Design Professional in writing immediately upon its discovery and no later than when it could have reasonably been expected to be observed or discovered.
 - 2. Contractor shall be held responsible for protecting all adjacent construction from damage. Existing structures or installations damaged by operations connected with this work shall be replaced or repaired by the Contractor to the satisfaction of the Design Professional and at no additional cost to the Owner.
 - 3. Contractor shall field verify all measurements (dimensions, elevations) and conditions necessary for proper installation of work covered by this Section. Exact measurements are Contractor's responsibility.

1.13 COORDINATION

A. Coordinate work under provisions of Division 1.

1.14 WARRANTIES

A. Applicator's Warranty: Furnish per the attached pages.

PART 2 PRODUCTS

- 2.1 MATERIALS, GENERAL
 - A. COOL ROOF RATING COUNCIL (CRRC):
 - 1. The cap sheet shall be granule-surfaced **(SG bright white granule-surfaced cap sheet is basis of design)**. Cap sheet shall be listed by the Cool Roof Rating Council (CRRC) with the following minimum published values, including CRRC 3-year Rapid Ratings:
 - a. Solar Reflectance: Initial: 0.66 3-year: 0.62
 - b. Thermal Emittance: Initial: 0.91 3-year: 0.91
 - c. Solar Reflectance Index (SRI): Initial: 81 3-year: 75

- A. Insurance and Code Requirements: Provide materials complying with governing regulations, installed to comply with Underwriters Laboratories Class A and FM I-135 wind up-lift requirements.
 - 1. Comply with Factory Mutual I-135 wind up-lift requirements.
- B. Obtain primary built-up and modified bitumen roofing materials from a single manufacturer to match the existing membrane and provide secondary materials only as recommended by the manufacturer of the primary material, as specified.
 - 1. The Drawings are generic and not based on a specific manufacturer. Detail deviations will be accepted so as to permit utilization of the selected manufacturer's standard products and details when, in the Design Professional's judgment, such deviations do not materially detract from design concept or intended performance. Submit proposed deviations to Design Professional for approval in writing prior to ordering materials that are in the category of substitutions.

2.2 SHEET MATERIALS

- A. Strip-In Flashing: ASTM D-2178-88, Type IV glass fiber felt
- B. Ply Felt Flashing: ASTM D-2178-88, Type IV glass fiber felt
- C. Roof Membrane: ASTM D-2178-88, Type IV glass fiber felts.
- D. Dry-In Felt: ASTM D226, #15 organic felt.
- E. Base Sheet: ASTM D-4601, Type II, non perforated glass fiber base sheet.
- F. Modified Bitumen Membrane: Granular surfaced (SBS) membrane; 140 mil minimum thickness; reinforced with fiberglass, polyester or combination of both. Granular surface to match existing granule color. Smooth surface flashing to comply to previous requirements.

2.3 INSULATION

- A. Polyisocyanurate Insulation: Closed cell glass fiber reinforced type, conforming to the following (tapered and non-tapered):
 - 1. Board Size: 4 x 4 feet, (4 x 8 feet if mechanically attached).
 - 2. Board Thickness: 2" min. (at duct work)
 - 3. Compressive Strength: 25 psi per ASTM C 165
 - 4. Facing: Factory applied skin of glass fiber facing on both faces.
 - 5. Board Edges: Square.
 - 6. Water Absorption: In accordance with ASTM C209, 1 percent by volume maximum.
 - 1. Foam Core Flame Spread: 25 Max. ASTM E-84 (Tunnel Test).
 - 2. ULI Fire Rating: Conform to the current ULI, Class A, Roof/Ceiling fire rated assemblies (see current ULI "Fire Resistance Directory").

- B. Tapered Perlite Edge Strips For Use at Crickets Within Roof System: 1/2" per foot tapered preformed units, as approved for use within a 20 year warranted roof system by the roofing manufacturer, of material with the following characteristics:
 - 1. Board Density: 8 lb/cu ft.
 - 2. Board Size: 2x4 feet.
 - 3. Board Thickness/slope: ½" per foot slope for all crickets.
 - 4. Compressive Strength: Minimum 35 psi.
 - 5. Water Absorption: In accordance with ASTM C 209, 1.5 percent by volume maximum.
 - 6. Board Edges: Square.
 - 7. ULI Fire Rating: Conform to the current ULI, Class A, Roof/Ceiling fire rated assemblies (see current ULI "Fire Resistance Directory").
- 2.4 GYPSUM ROOF BOARD (Options)
 - A. Gypsum Roof Board (Glass fiber reinforced/faced gypsum): as approved for use within a 20 year warranted roof system by the roofing manufacturer, with the following characteristics:
 - 1. Board Type: manufacturer standard product for use over polyisocyanurate insulation and over metal decks.
 - 2. Manufacturer and Product: Georgia-Pacific Corporation, Gypsum Division, Dens-Deck Prime Roof Board or approved equal.
 - 3. Board Size: 4 feet x 4 feet x 1/4" minimum thickness.
 - 4. Compressive Strength: Minimum 35 psi.
 - 5. Water Absorption: In accordance with ASTM C 1177-91
 - 6. Board Edges: Square.
 - 7. UL Fire Rating: Conform to the current UL, Class A, Roof/Ceiling fire rated assemblies (see current UL "Fire Resistance Directory").
 - B. Gypsum Roof Board (Glass fiber reinforced with no face layer) : as approved for use within a 20 year warranted roof system by the roofing manufacturer, with the following characteristics:
 - 1. Board Type: manufacturer standard product for use over polyisocyanurate insulation and over metal decks.
 - 2. Manufacturer and Product: United States Gypsum Company, Securock Roof Board or approved equal.
 - 3. Board Size: 4 feet x 4 feet x 1/4" minimum thickness.
 - 4. Compressive Strength: Minimum 1,250 psi.
 - 5. Water Absorption: 10 In accordance with ASTM C 473
 - 6. Board Edges: Square.
 - 7. UL Fire Rating: Conform to the current UL, Class A, Roof/Ceiling fire rated assemblies (see current UL "Fire Resistance Directory").

2.5 BITUMINOUS MATERIALS

- A. Asphalt Bitumen: ASTM D312, Type III.
- B. Asphalt Primer: ASTM D41.
- C. Coal Tar Pitch: ASTM D 450, Type I
- D. Plastic Cement: ASTM D2822 Type II, cutback asphalt type.

E. Modified Bituminous Flashing Adhesive: ASTM D3019-85 Type III.

2.6 MECHANICAL FASTENERS

- A. Roofing Nails: Galvanized, hot dipped or non-ferrous type, size as required to suit application.
- B. For Fastening Vented Base Sheet to Lightweight Concrete Deck: Lightweight concrete base ply fastener with FM I-90 discs. Base ply fastener shall comply with Factory Mutual Approval Standard #4470.
- C. For Fastening Base Sheet to Wood Deck: Rawl deck screw with FM I-90 discs.
- D. For Fastening Insulation to Metal Decks: #12 deck screw; FM 4470 coated; 3" FM I-90 disc; screw length sufficient to penetrate deck 1". Insulation fasteners shall be supplied by roof membrane manufacturer on warranted roofs.
- E. For All Other Locations: Provide size, type, material and finish as required, matching material being fastened. Fasteners used on warranted roof systems shall be an approved fastener used by membrane manufacturer.

2.7 ACCESSORIES

- A. Cant Strip: Perlite, preformed to 45 degree angle.
- B. Vent Pipe Flashing: Prefabricated pipe flashing of 2.5 lb. per square foot common pig lead having a 4" flange.
- C. Conduit/Condensate Line Supports: 3000 psi concrete, smooth exposed finish, 8" wide x 16" long x 2" thick; free of surface defects.
- D. Lead Drain Flashing: 36" square flashing of 4 lb. common DE-silvered pig lead sheet.
- E. Walk Pads: traffic resistant polymer modified bitumen sheet, polyester reinforced, surfaced with mineral granules.
- F. Flashing Tape: double sided, extruded or preformed, cross-linked butyl rubber, self adhesive tape, 1/8" minimum thickness, 3/4" minimum width unless noted otherwise on the drawings.
 - 1.Pecora CorporationExtru-Seal Glazing TapeTremco Construction Products440 II Tape
 - 2. Equivalent products as approved by the Construction Manager and Design Professional.

2.8 PITCH PAN FILLER

- A. Pitch Pan Filler (Pitch pans are not approved for use on new roofs. Special and specific written approval from the design professional is required for use on existing roofs.): Firestone S-10 RubberGard two part urethane pourable sealer (no substitutions allowed) installed over Five Star non-shrink grout (by U.S. Grout, Corporation) or approved equal.
- 2.9 JOINT SEALANTS: Refer to Section 07 90 00 Joint Protection

2.10 SURFACING

- A. Aggregate: ASTM-D-1863, Size and color to match existing roof aggregate.
- B. Protective Cover Coating: Fibrated, Aluminum type.
- 2.11 MISCELLANEOUS MATERIALS:
 - A. All other material and accessories, not specifically described, but required for a complete and proper installation of roofing, shall be products of, or recommend by the manufacturer of the primary material and subject to the approval of the Construction Manager.

PART 3 EXECUTION

3.1 EXAMINATION

- A. Verify that surfaces and site conditions are ready to receive work.
- B. Verify deck is dry and clean.
- 3.2 INSTALLATION REQUIREMENTS
 - A. Protect other work from spillage of bitumen roofing asphalt materials and prevent liquid materials from entering or clogging drains and conductors. Replace or restore other work damaged by installation of modified bitumen sheet roofing system work.
 - B. Work to be performed by a manufacturer approved applicator.
- 3.3 BITUMEN HEATING (Large Scale Repairs or Re-Flashing of Equipment Curbs)
 - A. Heat bitumen in accordance with bitumen manufacturer's requirements.
 - B. For aggregate surfaced pour coats of asphalt, limit application temperature to minimum required for proper embedment of aggregate and maximum which will permit retention of a coating of weight required.
- 3.4 BASIC REPAIRS Basic Small Scale Repair Techniques (Cold Application)
 - A. Remove gravel surfacing down to the felts. Clean and dry surface 24" around the damaged area.
 - B. Preparation: Brush prime surface using asphaltic primer.
 - C. Apply plastic cement into the deficiency.

- D. Embed required number of felts over deficiency. For three ply roof system, cover deficiency using 3 plies of felt. Each ply shall overlap the preceding ply by 6".
- E. Re-apply new gravel surfacing in a layer of mastic.
- 3.5 BASIC REPAIRS Basic Large Scale Repair Techniques (Hot Bitumen Application)
 - A. Remove gravel surfacing down to the felts. Clean and dry surfaces 24" around the damaged area.
 - B. Preparation: Brush prime exposed membrane surface using asphaltic or coal tar primer.
 - C. Replace damaged insulation.
 - D. Embed required number of felts over repair area in hot bitumen. With an existing three ply roof repair using three plies of felt. Each ply shall overlap the preceding ply by 6".
 - E. Re-apply new gravel surfacing in a flood coat of hot bitumen.

3.6 SPECIFIC REPAIRS

- A. Surface Conditions Gravel Surfaced Built-Up Roofs:
 - 1. Remove loose aggregate, debris and dirt.
 - 2. Repair any membrane surfaces damaged.
 - 3. Trim and dispose of any loose or curled felt.
 - 4. For small scale repairs (less than 3 feet in area), apply plastic cement and embed new gravel over area.
 - 5. For large scale Repairs (greater than 3 feet in area), apply a 60# per square flood coat of hot bitumen over roof surface. Embed new gravel into the asphalt at a rate of 400# per square.
- B. Alligatoring or Cracking
 - 1. Light Checking/Crazing:
 - a. Clean surface and remove thick pieces of bitumen.
 - b. Prime surface
 - c. Apply an asphalt emulsion to surface ensuring that fissures are filled.
 - d. Reinstall surfacing or coat surface with fibrated aluminum coating.
 - 2. Heavy Checking/Deep Crazing to Felts:
 - a. Clean surface and remove thick pieces of bitumen.
 - b. Prime surface
 - c. Apply an asphalt emulsion to surface ensuring that fissures are filled. While emulsion is fluid, inlay a fiber glass mat over area.

- d. Reinstall surfacing or coat surface with fibrated aluminum coating.
- C. Surface Slippage Flow of Bitumen and Aggregate
 - 1. Clean around drains or wall scupper.
 - 2. Remove surfacing aggregate and install gravel stop/pitch dam.
 - 3. Strip-in dam and, re-apply surfacing as listed in Basic Repairs.

3.7 MEMBRANE CONDITION

- A. Blisters Built-Up Asphalt or Coal Tar Roofing:
 - 1. Remove gravel surfacing down to the felts. Clean and dry surfaces 24" from around damaged area.
 - 2. Remove entire blister where until the existing ply felts are found well adhered together.
 - 3. Preparation: Brush prime surface using asphaltic primer.
 - 4. Apply plastic cement into blister void. Allow mastic to be slightly raised above adjacent surface.
 - 5. Embed required number of felts over deficiency. Each ply shall overlap the preceding ply by 6".
 - 6. Re-apply surfacing as listed in Basic Repairs.
- B. Blisters Cap Sheet or Modified Bitumen Roofing:
 - 1. Brush loose granules away from the blister.
 - 2. Prime surface with asphaltic primer.
 - 3. X cut roof surface. Fold membrane back and apply modified bitumen adhesive in void.
 - 4. Press membrane back into adhesive.
 - 5. Install new modified bitumen cap target in adhesive over primed area. Ensure that membrane is firmly seated into modified bitumen adhesive.
 - 6. A torch grade material may be applied in lieu of cold applied SBS. Do not use mastic in void when using a torch. Remove material from void entirely.
- C. Ridging, Wrinkling, Buckling, fishmouths and Splits:
 - 1. Remove gravel surfacing down to the felts. Clean and dry surfaces 12" around the damaged area.

- 2. Repair as indicated in Basic Repair Proceeders.
- 3. Membrane Splits: Membrane splits are normally associated with building expansion or membrane tension. This type of problem requires the addition of an expansion joint or area divider. Severe or long membrane splits shall be brought to the attention of the Construction Manager, Design Professional and Owner prior to repairing.
- D. Punctures or Ruptures:
 - 1. Remove gravel surfacing 24" around puncture.
 - 2. Clean and Prime surface.
 - 3. Embed required number of felts over deficiency. Repair as listed in Basic Repairs.
- E. Membrane Slippage
 - 1. Strapping Technique:
 - a. Remove roof gravel. Gravel shall be removed in 12" width and running entire parallel to the roof slope the entire length of the roof. Strapping runs shall be space 15 feet apart.
 - b. Nail 6" o.c. through a new strip of 6" wide Type IV felt. Nail parallel to slope.
 - c. Apply a layer of mastic over length and width of strip. Pull half of sheet over fasteners than fold other side over preceding.
 - d. An additional 12" roof ply shall be mopped over strapping in hot bitumen.
 - e. Apply new aggregate surfacing in a flood coat of hot bitumen.

3.8 FLASHING REPAIRS

- A. Punctures or Holes:
 - 1. Three course over puncture or hole using reinforcing polyester membrane and flashing adhesive. Coat exposed asphalt with fibrated aluminum coating.
- B. Deteriorated Base Flashing:
 - 1. Remove loose and damaged roof material. Prime surface with asphaltic primer.
 - 2. Apply modified bitumen adhesive to vertical surface and, set modified bitumen flashing into place. Tuck flashing under metal counterflashing. Hand rub flashing into adhesive. Back nail along top.
 - 3. Three course side laps and over fasteners using reinforcing polyester membrane and flashing adhesive.
 - 4. Coat exposed asphalt with fibrated aluminum coating.

- C. Flashing Blisters:
 - 1. Clean then prime surface over and around blister with asphaltic primer.
 - 2. Check each repair area for moisture damage and replace any damaged or deteriorated cant strips.
 - 3. X cut over blister. fold flashing outward and trowel modified bitumen adhesive into void. Fold back and press membrane into adhesive.
 - 4. Apply modified bitumen adhesive to vertical surface and, set modified bitumen flashing into place. Tuck flashing under metal counterflashing. Hand rub flashing into adhesive. Back nail along top.
 - 5. Three course side laps and over fasteners using reinforcing polyester membrane and flashing adhesive. Coat exposed asphalt with fibrated aluminum coating.
- D. Open Flashing Laps:
 - 1. Install adhesive into lap and, firmly press together.
 - 2. Check each repair area for moisture damage and replace any damaged or deteriorated cant strips.
 - 3. Nail lap down vertical lap.
 - 4. Three course over lap and fasteners using reinforcing polyester membrane and flashing adhesive. Coat exposed asphalt with fibrated aluminum coating.
- E. Ridging or Wrinkling Flashing:
 - 1. Patch using Basic Repair Techniques.
- F. Falling and Buckled Flashing:
 - 1. Apply modified bitumen adhesive to surface behind fallen flashing.
 - 2. Check each repair area for moisture damage and replace any damaged or deteriorated cant strips.
 - 3. Secure top of flashing to wall 4" on center.
 - 4. Three course side laps and over fasteners using reinforcing polyester membrane and flashing adhesive. Coat exposed asphalt with fibrated aluminum coating.

3.9 COUNTERFLASHING

- A. Reglet Flashing:
 - 1. Clean wall reglet. Remove caulking from wall and counterflashing surfaces.

- 2. Reset counterflashing into reglet joint, and secure with lead wedges at 4" o.c. Apply sealant at metal overlap.
- 3. Apply urethane sealant over reglet joint and tool.
- B. Surface Mounted Counter Flashing:
 - 1. Remove sealant from counterflashing metal and wall.
 - 2. Apply sealant to over lap joints and reset counterflashing.
 - 3. Prime surface of existing wall as required to insure optimum adhesion. Secure counterflashing to wall using drive pins or tapcons with metal backed neoprene washers.
 - 4. Apply urethane sealant to receiver joint and tool.

3.10 METAL COPING AND CURB CAPS

- A. Ensure coping is properly attached to wall. Do not mechanically attach coping thru the top. Verify coping receiver is hand tong at clips or at continuous cleat. Re-secure mechanically fastened coping thru the vertical surface at 8" o.c.
- B. Remove sealant from metal surface at end lap. Reseal using urethane sealant and tool.
- C. Holes in coping:
 - 1. Thoroughly clean scale around deteriorated area.
 - 2. Prime surface with asphaltic primer. Apply 3 beads of sealant on each side of deteriorated area.
 - 3. Install a cover plate. Use pressure turn downs at each side of plate, and tong plate at bottom edges over coping to secure. Cover plate material shall be same as coping metal.

3.11 ROOF EDGING/FASCIA

- A. Remove gravel surfacing down to the felts. Clean and dry surfaces 18" from the damaged area. Remove cover plate at laps and, clean and reinstall in beads of sealant.
- B. Brush prime surfaces using asphaltic primer.
- C. Apply plastic cement over primed area. Embed 2 ply of Type IV felts over flange. Each ply shall overlap the preceding ply by 6". Re-apply surfacing as listed indicated in Basic Repairs.
- 3.12 PITCH PANS/FLANGE MOUNTED ROOF PENETRATIONS.
 - A. Remove gravel surfacing 16" around flange. Ensure metal and roof surfaces are clean and dry.

- B. Brush prime surfaces using asphaltic primer.
- C. Apply plastic cement over primed area. Strip-in flanges using 2 plies of felt. Each strip-in ply shall overlap the preceding ply by 6". Re-apply surfacing using method listed in Basic Repairs.
- D. Use modified bitumen flashing cement when repairs are performed to modified bitumen roof system. A torch may be used if compatible with material.

3.1 CLEANING

- A. In areas where finished surfaces are soiled by work of this section, clean those surfaces.
 - 1. Remove trash, scraps and spudded roof gravel from roof.

3.2 PROTECTION

- A. Protect building surfaces against damage from roofing work.
- B. Repair or replace any roofing and associated materials damaged during the work to a condition free of damage and deterioration.

END OF SECTION

APPLICATOR WARRANTY FOR ROOFING REPAIRS

| Whereas | | | | |
|---|--|--|--|--|
| of (Address) | | | | |
| herein called the "Roofing Contractor", has performed roofing, flashing and sheet metal and associated ("work") on following project: | | | | |
| Owner: | | | | |
| Address: | | | | |
| Name and Type of Building: | | | | |
| Address: | | | | |
| Area of Work: | | | | |
| Date of Acceptance: | | | | |
| Warranty Period: Two Years Date of Expiration: | | | | |

AND WHEREAS Roofing Contractor has contracted (either directly with Construction Manager or indirectly as a subcontractor) to warrant said work against leaks and faulty or defective materials and workmanship for designated Warranty Period.

NOW THEREFORE Roofing Contractor hereby warrants, subject to terms and conditions herein set forth, that during Warranty Period he will at his own cost and expense, make or cause to be made such repairs to or replacements of said work as are necessary to correct faulty and defective work, and as are necessary to maintain said work in watertight condition.

This Warranty is made subject to the following terms and conditions.

- 1. Specifically excluded from this Warranty are damages to roofing work and other parts of the building, and to building contents, caused by: a) lightning, windstorm; b) fire; c) failure of roofing system substrate or structure (including cracking, settlement, excessive deflection, deterioration, and decomposition). When work has been damaged by any of the foregoing causes, Warranty shall be null and void until such damage has been repaired and until cost or repairs has been paid by the Owner or by another responsible party as so designated.
- 2. The Roofing Contractor is responsible for damage to work covered by this Warranty, and is not liable for consequential damages to building or building contents, resulting from leaks or faults or defects of work.
- The Owner shall promptly notify Roofing Contractor of observed, known or suspected leaks, defect or deterioration. The Contractor shall guarantee to respond to all notifications within twenty-four (24) hours and to make all such repairs as deemed necessary to correct said leaks or defects to a

satisfactory condition to the Construction Manager. Repairs shall be made by workman in the current employment of the Contractor. Subcontracting of repair work is not permitted.

4. This Warranty is recognized to be the only warranty of Roofing Contractor on said work, and shall not operate to restrict or cut off Owner from other remedies and resources lawfully available to him in cases of roofing failures. Specifically, this Warranty shall not operate to relieve Roofing Contractor of responsibility for performance of original work in accordance with requirements of the Contract Documents, regardless of whether Contract was a contract directly with Owner or a subcontract with Owner's General Contractor.

IN WITNESS THEREOF, this instrument has been duly executed this

_____day of______, 20_____,

Roofing Contractor Firm

(SEAL)

Signature of Authorized Person

Title

Witness

SECTION 07 62 00 SHEET METAL FLASHING AND TRIM

PART 1 GENERAL

1.1 SUMMARY

- A. Section includes:
- B. Two-piece Counterflashing fabrications for curbs at roof mounted equipment.
- C. Weatherheads, goosenecks and other metal fabrications at various roof membrane penetrations for mechanical, plumbing and electrical devices and services.
- D. Materials specified in this section are for use in conjunction with roof repairs, and may be an extension of an existing detail. The intent of these specifications is to match the existing materials, configurations and finish being used. This section is intended to define the quality of materials and workmanship provided.

1.2 RELATED SECTIONS:

- A. Section 06 10 53 Rough Carpentry: Wood blocking and nailers.
- B. Section 07 92 00 Joint Sealers.
- 1.3 REFERENCES:
 - 1. ASTM International:
 - a. ASTM A 167 Standard Specification for Chromium and Chromium-Nickel Stainless Steel Plate, Sheet and Strip
 - b. ASTM A 480/A480M Standard Specification for General Requirements for Flat-Rolled Stainless and Heat-Resisting Steel Plate, Sheet and Strip
 - c. ASTM A 653/A 653M Standard Specification for Steel Sheet, Zinc-Coated (Galvanized) or Zinc-Iron Alloy-Coated (Galvannealed) by the Hot-Dip Process.
 - d. ASTM A 755/A 755M Standard Specification for Steel Sheet, Metallic Coated by the Hot-Dip Process and Prepainted by the Coil-Coating Process for Exterior Exposed Building Products
 - e. ASTM A 792/A 792M Standard Specification for Steel Sheet, 55% Aluminum-Zinc Alloy-Coated by the Hot-Dip Process
 - f. ASTM A 924/A 924M Standard Specification for General Requirements for Steel Sheet, Metallic-Coated by the Hot-Dip Process.
 - g. ASTM B 29 Standard Specification for Refined Lead.
 - h. ASTM B 32 Standard Specification for Solder Metal.
 - i. ASTM B 209 Standard Specification for Aluminum and Aluminum-Alloy Sheet and Plate.
 - j. ASTM B 306 Standard Specification for Copper Drainage Tube (DWV).
 - k. ASTM B 370 Standard Specification for Copper Sheet and Strip for Building Construction.
 - I. ASTM B 749 Standard Specification for Lead and Lead Alloy Strip, Sheet, and Plate Products.

- m. ASTM D 226 Standard Specification for Asphalt-Saturated Organic Felt Used in Roofing and Waterproofing.
- n. ASTM D 1187 Standard Specification for Asphalt-Base Emulsions for Use as Protective Coatings for Metal.
- o. ASTM D 4397 Standard Specification for Polyethylene Sheeting for Construction, Industrial, and Agricultural Applications
- p. ASTM D4586 Standard Specification for Asphalt Roof Cement, Asbestos-Free.
- 2. National Roofing Contractors' Association:
 - a. NRCA National Roofing Contractors' Association Manual.
- 3. Sheet Metal and Air Conditioning Contractors National Association (SMACNA):
 - a. SMACNA Architectural Sheet Metal Manual.

1.4 SUBMITTALS

- A. Section 01 33 00 Submittal Procedures: Submittal procedures.
- B. Shop Drawings: Submit shop drawings for any condition not shown on plans and details.
- C. Product Data: Submit data on manufactured components metal types, finishes, and characteristics.
- D. Samples:
 - 1. Submit two samples 12 x 12 inch in size illustrating a typical external corner, internal corner, material and finish.
 - 2. Submit two samples 12 x 12 inch in size illustrating metal finish color.

1.5 QUALITY ASSURANCE

- A. Perform work in accordance with SMACNA and standard details and requirements.
- B. Failure to install work in strict accordance with provisions of this Section is subject to total rejection of the work specified herein.
- C. Maintain copy of documents on site.

1.6 MOCK-UPS

- A. Construct "in-place" sheet metal mock-ups demonstrating the following conditions as applicable and detailed in the project documents:
 - 1. Perimeter edge metal, splice and termination conditions.
 - 2. Edge metal exterior and interior corner conditions
 - 3. Gutter conditions: Attachment; expansion joint; splice; termination; downspout connections, etc.
 - 4. Typical interior wall counterflashing conditions.
 - 5. Parapet coping conditions and splice, etc.
 - 6. Roof expansion joint coping conditions:
 - 7. Additional conditions as may be determined by the Architect.
- B. Mock-ups are to be constructed and located where designated. Upon approval mockups may remain as part of the work.

1.7 QUALIFICATIONS

A. Fabricator and Installer: Company specializing in sheet metal work with minimum three years documented experience.

1.8 PRE-INSTALLATION MEETINGS

- A. Section 01 30 00 Administrative Requirements: Pre-installation meeting.
- B. Convene minimum one week prior to commencing work of this section.

1.9 DELIVERY, STORAGE, AND HANDLING

- A. Section 01 60 00 Product Requirements: Product storage and handling requirements.
- B. Stack material to prevent twisting, bending, and abrasion, and to provide ventilation. Slope metal sheets to ensure drainage.
- C. Prevent contact with materials causing discoloration or staining.

1.10 COORDINATION

- A. Section 01 30 00 Administrative Requirements: Coordination and project conditions.
- B. Coordinate application of flashings with application of roofing, protruding material, and roof accessories to provide a complete weathertight installation according to the specified warranty requirements.

PART 2 PRODUCTS

2.1 SHEET MATERIALS

- A. Stainless Steel: ASTM A 240, ASTM A 480 and ASTM A 666; Type 304, soft temper (annealed), 22 ga. or 24 ga. thickness unless otherwise specified; smooth 2B finish.
- B. <u>Coated Aluminum Sheet Metal for Thermoplastic Roofs</u>: Twenty (20) mil UV resistant PVC (polyvinyl chloride with Elvaloy®* KEE (ketone ethylene ester) membrane laminated <u>0.040 thick 3003-H14 aluminum</u>,

2.2 ACCESSORIES

- A. Termination Bar: Aluminum ASTM B-209, Alloy 6061, Temper T-6, mill finish; sizes 1/8" thick by 1-1/2" with rounded edges.
- B. Sheet Metal Fasteners:
 - 1. Exposed fasteners are prohibited, and may only be used where specifically permitted by the project details or the Architect.
 - 2. Fasteners bearing on weather side of panels are to be a minimum #10 size "Scots" type screw with metal-backed neoprene washer integral with the head of the screw, or 3/16" diameter minimum stainless steel rivet.

- 3. Use stainless steel fasteners for exterior application and galvanized or cadmium plated fasteners for interior applications. Use painted fasteners where fastening into painted panel or trim.
- 4. Locate and space fastenings for true vertical and horizontal alignment. Use proper type fastening tools to obtain controlled uniform compression for positive seal without rupture of neoprene washer.
- C. Fasteners: Stainless steel: Fastener size and penetrations into various substrates should be as follows:
 - 1. Wood: $\frac{1}{4}$ inch screw x 2 inch penetration or 1 $\frac{1}{2}$ inch annular ring stainless steel roofing nail.
 - 2. Concrete: ¹/₄ inch "zamac" nail-in x 1 ¹/₂ inch penetration.
 - 3. Concrete Block: $\frac{1}{4}$ inch "zamac" nail-in x 1 $\frac{1}{2}$ inch penetration.
- D. Fastener Schedule: Anchorage for below assumed to be into wood blocking, See details for other specifics.
 - 1. Continuous Cleats: 1 ½ inch annular ring stainless steel roofing nails at 6 inches on center maximum.
 - 2. See Fastener Schedule sheets included as part of the project documents.
 - 3. For all conditions not covered, refer to fastener specifications above or consult with Architect.
- E. Dry-in Membrane: Forty (40) mils thick, polyester reinforced, SBS modified asphalt waterproofing and underlayment membrane sheet.
 - 1. Protecto-Wrap "Rainproof 40"
 - 2. Soprema "Sopralene Stick"
 - 3. Tamko "TW Metal and Tile" underlayment
 - 4. Architect approved (prior to bidding) equivalent product.
- F. Primer: Asphaltic based primer for flanges set in adhesive.
- G. Protective Backing Paint (bituminous coating): ASTM D1187, 'Standard Specification for Asphalt-Base Emulsions for Use as Protective Coatings for Metal.'; SSPC-Paint 12, FS-TT-C-494 Cold-Applied Asphalt Mastic (Extra Thick Film – 15 mil dft) [Society for Protective Coatings].
- H. Sealant: Sealant specified in Section 07 90 00.
- I. Plastic Cement: ASTM D 4586, Type I.
- J. Flashing Tape (concealed application): Double sided, gray extruded or preformed, 99% solids, cross linked polyisobutylene compound, non-sag, non-toxic, non-staining, permanently elastic self adhesive tape. One eighth (1/8) inch minimum thickness, 3/4" minimum width unless otherwise noted on the drawings.
 - 1. Pecora Corporation Extru-Seal Glazing Tape
 - 2. Tremco Construction Products 440 II Tape
 - 3. Equivalent products as approved by the Owner or Architect.
- K. Solder/Flux/Cleaner: ASTM B 32;
 - 1. Solder: <u>type suitable for application and material being soldered</u>. ASTM B-32; 50/50 lead/tin type or ASTM B-32: 90/10 tin/silver type
 - 2. Flux: Acid Chloride type

p. 765

- 3. Flux Cleaner: Washing Soda Solution 5% to 10%
- L. Metal Flashing Adhesive: Epoxy Adhesive may be used to assemble flashing fabrications using aluminum or pre-finished metals as noted by the project details Utilize a 2 component methacrylate adhesive system, approved products are:
 - 1. SciGrip SG300 series adhesive as manufactured by SCIGRIP Americas, 600 Ellis Road, Durham, NC 27703. Contact: (887) 477-4583, (<u>www.scigrip.com</u>).
 - 2. Weld-on SS300 series adhesive as manufactured by IPS Structural Adhesives, Inc., 600 Ellis Road, Durham, NC 27703. Contact: (887) 477-4583, (www.ipscorp.com).
 - 3. Partite 7300 or 7400 series adhesive as manufactured by Parson Adhesives, Inc., 3345 Auburn Road, Suite 107, Rochester Hills, MI 48309. Contact: (248) 299-5585, (www.parsonadhesives.com).
 - 4. The above products have been represented locally by North American Composites, 3715 North Frontage Road, Lakeland, FL 33810. Contact: (800) 241-5817. (www.nacomposites.com).
 - 5. Architect approved equal.

2.3 FABRICATION

- A. Form sections shape indicated on Drawings, accurate in size, square, and free from distortion or defects.
- B. Fabricate cleats of same material as sheet metal, interlocking with sheet.
- C. Form pieces in longest possible lengths.
- D. Hem exposed edges on underside 1/2 inch; miter and seam corners.
- E. Form material with flat lock seams, except where otherwise indicated. At moving joints, use sealed lapped, bayonet-type or interlocking hooked seams.
- F. Fabricate corners from one piece with minimum 18 inch long legs; solder for rigidity, seal with sealant.
- G. Pretin edges of stainless steel sheet. Solder shop formed metal joints. After soldering, remove flux. Wipe and wash solder joints clean. Weather seal joints. (Heliarc shop formed aluminum joints).
- H. Perform soldering work slowly, with properly heated irons to thoroughly heat seam material and sweat solder through full width of seam that shall show not less than 1 inch of evenly flowed solder.
 - 1. Start soldering immediately after application of flux.
 - 2. Solder flat locked seams.
- I. Fabricate vertical faces with bottom edge formed outward 1/4 inch and hemmed to form drip.
- J. Fabricate flashings to allow toe to extend 1 1/2" over wood nailers. Return and brake edges.
- K. Fabricate accessories in profile and size to suit gutters and downspouts.

- 1. Anchorage Devices: In accordance with SMACNA requirements.
- 2. Gutter Supports: Brackets. Straps.
- 3. Downspout Supports: Brackets.
- L. Seal metal joints.
- 2.4 FINISH (when painting is required)
 - A. Dissimilar Metal Isolation: Where applicable, back paint concealed metal surfaces with protective backing paint to a minimum dry film thickness of 15 mils when dissimilar metals are in contact.
 - B. Prepare stainless steel surfaces in accordance with Section 09 90 00 Painting and Coating.

PART 3 EXECUTION

3.1 EXAMINATION

- A. Section 01 30 00 Administrative Requirements: Coordination and project conditions.
- B. Verify roof openings, curbs, pipes, sleeves, ducts, and vents through roof are solidly set, reglets in place, and nailing strips located.
- C. Verify roofing termination and base flashings are in place, sealed, and secure.
- D. Do not proceed with work of this section until conditions detrimental to the proper and timely completion of the work have been corrected in an acceptable manner.

3.2 PREPARATION

- A. Install starter and edge strips, and cleats before starting installation.
- B. Install surface mounted counterflashing (reglets) to lines and levels indicated on Drawings. Seal top of counterflashing (reglets) with sealant.
- C. Paint concealed metal surfaces with protective backing paint to minimum dry film thickness of 15 mils where applicable.

3.3 INSTALLATION

- A. Where applicable, insert flashings into reglets to form tight fit. Secure in place with lead wedges. Seal flashings into reglets with sealant.
- B. Secure flashing in place using concealed fasteners. Use exposed fasteners only where permitted.
- C. Apply plastic cement compound between metal flashings and felt flashings.
- D. Fit flashings tight in place. Make corners square, surfaces true and straight in planes, and lines accurate to profiles.

- E. Solder / weld per metal type metal joints for full metal surface contact. After soldering, wash metal clean with neutralizing solution and rinse with water.
- F. Apply modified bitumen cement compound between metal flashing and bituminous underlayment and/or flashing membrane. At other locations utilize self-adhesive butyl flashing tape as specified above.
- G. Secure gutters and downspouts in place using specified fasteners.
- H. Connect downspouts to downspout boot system. Seal connection watertight.
- I. Set splash blocks under downspouts.
- J. Seal metal joints watertight.

3.4 FIELD QUALITY CONTROL

- A. Section 01 40 00 Quality Requirements: Field inspecting, testing, adjusting, and balancing.
- B. Inspection will involve surveillance of Work during installation to ascertain compliance with specified requirements.

3.5 SCHEDULE

Location

| 1. | Cleat/Blocking and Cants | Galvanized Steel | 16 gage | Mill |
|----|-----------------------------|------------------|---------|------|
| 2. | C.F. Receiver (At Mech) | Stainless Steel | 24 gage | Mill |
| 3. | C.F. Receiver (At Ductwork) | Aluminum | 0.040" | PVC |
| 4. | Counterflashing | Stainless Steel | 24 gage | Mill |
| 5. | Wind Cleats | Stainless Steel | 26 gage | Mill |
| 6. | Weatherhead Fabrications | Stainless Steel | 24 gage | Mill |
| 7. | Abandoned Curb Covers | Stainless Steel | 24 gage | Mill |

Miscellaneous metal flashing and transitions: Stainless steel, mill finish, 24 gage; or 0.040 Aluminum (mill finish or prefinished); or 16 ounce copper as required by Architect.

END OF SECTION

SECTION 07 65 00 ROOF PENETRATING FLASHING

PART 1 GENERAL

1.1 SECTION INCLUDES

- A. Prefabricated Metal Flashing Assembly at Vent Pipes.
- B. Section includes fabrication and installation of flashings for: pipes, conduits and other round items, and similar penetrations and similar items penetrating, resting on, or anchored to the roof.
- C. The specifications in this section are not project specific. Contractor shall review the actual project conditions to determine the roof system components most appropriate to provide a successful outcome.

1.2 SUMMARY

- A. The specifications in this section are not project specific. Contractor shall review the actual project conditions to determine the roof system components most appropriate to provide a successful outcome
- B. Metal roof penetration flashing assemblies are considered an integral part of the roofing system(s) and shall be covered under the roofing membrane manufacturer's and roofing installers guarantees and warranties.
- C. All roof penetrations shall be flashed using materials, methods and details appropriate for each condition encountered, as described in this section, or if not described in this section, as recommended by S.B.C. Industries and accepted by the Design Professional.
- 1.3 RELATED SECTIONS
 - A. Section 06 10 53 Rough Carpentry: Wood blocking
 - B. Section 07 01 50 Modified Bitumen Roofing Repairs.
 - C. Section 07 62 00 Sheet Metal Flashing and Trim.
 - D. Section 07 92 00 Joint Sealers.

1.4 REFERENCES

- A. AISI American Iron and Steel Institute Stainless Steel Uses in Architecture.
- B. ASTM A 167 Stainless and Heat-Resisting Chromium-Nickel Steel Plate, Sheet, and Strip.
- C. ASTM A 653 Steel Sheet, Zinc Coated (Galvanized), and Zinc-Iron (Galvanealed), by the Hot-Dip Process

- D. ASTM B 209 Aluminum and Alloy Sheet and Plate.
- E. ASTM B 32 Solder Metal.
- F. ASTM B 486 Paste Solder.
- G. ASTM D 226 Asphalt-Saturated Organic Felt Used in Roofing and Waterproofing.
- H. ASTM D 4586 Asphalt Roof Cement, Asbestos-Free.
- I. FS O-F-506 Flux, Soldering, Paste and Liquid.
- J. NRCA National Roofing Contractors Association Roofing Manual.
- K. SMACNA Architectural Sheet Metal Manual.

1.5 SUBMITTALS

- A. Submit under provisions of Section 01 33 00.
- B. Product Data: Provide membrane repair materials Product Data, have the Contractor submit material samples only when the Construction Manager requires such.
- C. Manufacturer's Installation Instructions: Indicate special precautions required for seaming the membrane.
- D. Manufacturer's Field Reports: Submit under provisions of Section 01 40 00.
- 1.6 QUALITY ASSURANCE
 - A. General: All flashings shall be designed to comply with or exceed the following:
 - 1. National Roofing Contractors Association (NCRA) "Roofing and Waterproofing Manual" (latest edition) except where other editions are specifically referenced.
 - 2. Sheet Metal and Air Conditioning Contractors Association (SMACNA), Architectural Sheet Metal Manual (latest edition).
 - 3. Manufacturer's standard details as accepted by the Design Professional.
 - 4. Project details as issued for bidding and construction.
 - B. Manufacturer Qualifications: All set-on penetration flashings shall be shop fabricated by a single manufacturer whose specialty is the fabrication of roof penetration flashings of the type specified in this section and who has been in business for a minimum of 5 years. More than 80% of the business shall be devoted to the fabrication of roof penetration flashing.

C. Installer Qualifications: Installers shall be qualified and approved by the roof penetration flashing manufacturer prior to commencement of the work.

1.7 REGULATORY REQUIREMENTS

- A. Provide materials complying with governing regulations and codes installed to comply with the following:
 - 1. UL Listing: Provide roofing system materials and component materials that have been tested for application and slopes indicated and are listed by Underwriters Laboratories, Inc. (UL) for Class A external fire exposure.
- 1.8 DELIVERY, STORAGE, AND HANDLING
 - A. Deliver to site, store, protect, and handle products under provisions of Section 01 60 00.
 - B. Deliver material in manufacturer's original, unopened containers with manufacturer's labels intact and legible.
 - C. Deliver material requiring fire resistance classification to the job with labels attached and packaged as required by labeling service.
 - D. Store and handle materials to protect them from.
 - 1. Moisture, whether due to precipitation, or condensation.
 - 2. Damage by construction traffic.
 - 3. Temperatures over 110 degrees F or below 40 degrees F.
 - 4. Direct sunlight.
 - 5. Mud, dust, sand, oil and grease.
 - E. Comply with fire, safety, and environmental protection regulations.
 - F. Take special precautions against traffic on roofing when ambient temperature is above 80 degree F. Avoid heavy traffic on the work during installation.

1.9 **PROJECT CONDITIONS**

- A. Existing Conditions
 - 1. The roofing repair applicator shall verify existing conditions prior to Bidding.
 - 2. Report conflicts and problems to the Design Professional for resolution prior to Bidding. Failure to report these conflicts and problems places the responsibility on the Prime Contractor to complete the work in accordance with the Documents at no additional cost to the Construction Manager.
 - 3. Replace or restore to original condition any materials or work damaged during construction.
 - 4. Surfaces not designated to receive the system shall be properly masked or otherwise protected against accidental spillage or application of the material to those areas.
 - 5. Failure to install the work in strict accordance with provisions of this Section, is subject to total rejection of work specified herein.

1.10 ENVIRONMENTAL REQUIREMENTS

- A. Do not apply roofing membrane during inclement weather ambient temperatures below 40 degrees F.
- B. Do not expose materials vulnerable to water or sun damage in quantities greater than can be weatherproofed during same day.
- C. Proceed with roofing work when existing and forecasted weather conditions permit work to be performed in accordance with requirements of this section and warranty compliance requirements.
- 1.11 COORDINATION
 - A. Coordinate work under provisions of this Section.
 - B. Coordinate application of flashings with application of roofing, protruding material, and roof accessories to provide a complete weathertight installation according to the specified warranty requirements.

PART 2 PRODUCTS

2.1 MANUFACTURERS

- A. Subject to compliance with requirements specified in this section, provide metal roof penetration flashing systems from one of the following manufacturers:
 - S.B.C. Industries

 1765 Opa Locka Blvd.
 Miami, FL 33054
 Phone: 1-800-228-2580 or (305) 685-6350
 FAX: (305) 685-6360
 - 2. Thaler Roofing Specialties Products, Inc. Ontario, Canada Phone: (905) 677-1520

2.2 MATERIALS

- A. Metal: Stainless steel, type 304, 2B, ASTM A-240
- B. Solder: ASTM B32, 50% tin 50% lead; if lead-free solder is required, tin-silver, ASTM 96.5TS.
- C. Foam Tape: Closed cell foam, PSA on one side, 1/4" or 3/8" x 1" wide, ASTM D-1056.
- D. Backer Rod: Open cell polyurethane.
- E. Sealant: Single part urethane, ASTM C920-79.
- F. Asphalt Primer: As recommended and approved by the roofing membrane manufacturer and conforming to ASTM D-41 requirements.

G. Modified Asphalt Roof Cement: As recommended and approved by the roofing membrane manufacturer.

2.3 FABRICATION

- A. General
 - 1. All deck flanges shall have full rounded corners.
 - 2. Collar or stack portions of flashing assemblies and sealant covers for square or round pipes larger than 3" in diameter shall be fabricated from 24 gauge stainless steel. Unless noted otherwise, all other metal flashing assemblies shall be fabricated from 26 gauge stainless steel.
 - 3. Gauges for custom fabrications not specifically described herein shall be as recommended by the roof penetration flashing manufacturer and accepted by the Design Professional.
 - 4. Pitch pans are not to be used in lieu of any other penetration flashing in these specifications. Exceptions require special written approval by the Design Professional and will only be granted where, in the judgment of the Design Professional, no other means of positive flashing is feasible. In such cases where pitch pans are specifically approved by the Design Professional, said pitch pans shall conform to the following:
 - a. Fabricate from 24 gauge stainless steel, using 7-3/4" stock x girth required, forming a hemmed 3" high side with a 1/4" 3/8" inside return at the top and a 4" deck flashing flange. Provide 2" clearance from protrusion. If pitch pan can be slipped over penetration, shop solder four corners 4-1/2" with radial corners in place. If pitch pan cannot be slipped over penetration, wrap pitch pan around penetration, and solder corners and vertical seam.
- B. Fabrication of flashings for pipes, conduits and other round items penetrating, resting on or anchored to roof which allows a tubular flashing to be slipped over.
 - 1. Form tubular flashing sleeve no less than 9" high and of proper diameter to provide 1/8" minimum 1/4" maximum clearance from pipe or conduit.
 - 2. Fabricate square flashing deck plate to a size 7-1/2" larger than protrusion. Punch hole of appropriate size in center and extrude surrounding material upward 1/4" providing a continuous vertical soldering flange and solder 9" high tubular flashing sleeve. Cut 1" minimum radius on flashing plate corners.
 - 3. Fabricate counterflashing 5" high with a diameter $\frac{1}{2}$ " greater than pipe or conduit.
 - 4. Provide a conical sealant cover, sloped outward and downward at 30 degrees to 45 degrees from the horizontal plane with an inside diameter equal to pipe or conduit size and an outside diameter 1" to 2" larger.
 - 5. Shop solder all seams watertight.

- 6. Provide Model P/S or C/S with standard accessory sealant cover as manufactured by S.B.C. Industries or Design Professional accepted equal product from one of the listed manufacturers.
- C. Fabrication of flashings for connected pipes, conduits and other round items not allowing a tubular flashing to be slipped over.
 - Form semi-cylindrical tubular flashing sleeves (180 degrees) not less than 9" high, tightly seam intersecting halves to mate snugly. Provide a split flashing deck plate with radial corners and being formed upward to provide a continuous soldering flange for semi-cylindrical sleeve engagement. Size each unit to allow for vibration and thermal movement of pipe or conduit with 1/8" minimum x 1/4" maximum.
 - 2. Form cylindrical counterflashing 5" high with seamed edge to a diameter 1/4" larger than 9" high sleeve.
 - 3. Provide conical sealant cover, sloped outward and downward at 30 degrees to 45 degrees from a horizontal plane, with an inside diameter equal to pipe or conduit size and an outside diameter 2" larger.
 - 4. Provide Model P/D or C/D with standard sealant cover as manufactured by S.B.C. Industries or Design Professional accepted equal product from one of the listed manufacturers.
- D. Fabrication of flashings for angle irons, "H" beams, channels and square tubing.
 - 1. Form a 6" high two piece angular configuration similar to penetration, but allowing 3/16" minimum to 3/8" maximum clearance in any direction. Fabricate flashing deck flanges in two pieces and shop solder to 6" angular stacks. Provide an umbrella type counterflashing conforming to protrusion which extends 3/4" at 45 degrees outward from angular stack flashing.
 - 2. Provide Model A/D, H/D, CH/D or SQT/D, with standard sealant cover as manufactured by S.B.C. Industries or Design Professional accepted equal product from one of the listed manufacturers.
- E. Fabrication of flashings for ribbon or coaxial cable for lightning protection, T.V. antennas, satellite dishes, telephone wire and similar penetrations:
 - 1. Consult S.B.C Industries for fabrication of gooseneck type cable flashing or provide Design Professional accepted equal product from one of the listed manufacturers.
- F. Fabrication of flashings for "Uni-strut" members and other irregular shaped roof membrane penetrations:
 - 1. Consult S.B.C. Industries for fabrication of "Uni-strut" and custom or irregular shaped metal flashing assemblies. Design Professional accepted equal products from one of the listed manufacturers will be acceptable.
- G. Fabrication of flashings for Sanitary vent-thru-roof (VTR) penetrations:

1. Provide stainless steel plumbing vent flashing with vandal proof cap. Provide stainless steel pipe extension where required to extend pipes to 9" above adjacent finished roof. Provide S.B.C. Industries VTR Kit or Design Professional accepted equal from listed manufacturer.

PART 3 EXECUTION

3.1 INSTALLATION

- A. General:
 - 1. All deck flanges shall be primed, set in a full fresh bed of flashing cement and stripped-in in accordance with membrane manufacturer's recommendations and related specifications and drawings.
 - 2. All flashings shall be shop fabricated from field measurements.
 - 3. Clearances between penetrations (including flashing sleeves) and between penetrations and the leading edge of cants at wall or equipment base flashings shall be a minimum of 18" in compliance with NRCA <u>Table 4 Guide for</u> <u>Clearance Between Pipes/Walls/Curbs</u>, as found in the NRCA Roofing and Waterproofing Manual (Fourth Edition).
- B. Installation of flashing for pipes, conduits and other round items penetrating, resting on, or anchored to roofing.
 - 1. Slide flashing unit over penetration and firmly embed flashing plate in full bed of mastic.
 - 2. Counterflashing and sealant cover: Using a solvent with a rapid evaporation rate and leaving no residue, clean area of pipe directly above flashing. Wrap a single layer of 1/4" to 3/8" x 1" wide closed cell tape around pipe, 1/4" above top of base sleeve. Wrap cap flashing around allowing top to extend 1/4" above top of tape. Apply sealant into channel at top and tool for positive runoff. Apply conical sealant cover directly above sealant.
- C. Installation of flashing for connected pipes, conduits and other round items penetrating roofing or resting on roof not allowing a tubular flashing to be slipped over.
 - 1. Base sleeves: Mate shop fabricated half sections together around pipe and solder vertical and horizontal seams watertight. Embed flashing flange in full bed of mastic.
 - 2. Counterflashing and conical sealant cover: Using a solvent with a rapid evaporation rate and leaving no residue, clean area of pipe directly above flashing. Wrap a single layer of 1/4" to 3/8" x 1" wide closed cell foam tape around pipe 1/4" above top of base sleeve. Install cap flashing. Solder vertical seam. Apply sealant into channel and tool for positive runoff. Apply conical sealant cover directly above sealant.
- D. Installation of flashing for angle, "H" beams, channels and square tubing.

- 1. Around the protrusion, snap or slide nesting flashing sections together, and embed flashing flange in full bed of mastic. Solder all seams and neutralize flux. At area of clearance between protrusion and top of stack flashing, insert backer rod 3/8" below top of stack flashing. Apply a liberal amount of sealant and tool for positive drainage. Install sealant cover directly above stack flashing in wet sealant.
- E. Installation of flashings for ribbon or coaxial cable for lightning protection, T.V. antennas, satellite dishes, telephone and similar penetrations:
 - 1. Follow manufacturer's instructions for installation of cable flashing.

3.2 FIELD QUALITY CONTROL

- A. Field inspection will be performed under provisions of Section 01 40 00.
- B. Inspection will involve surveillance of work during installation to ascertain compliance with specified requirements.

END OF SECTION



City of Fort Lauderdale • Procurement Services Division 100 N. Andrews Avenue, 619 • Fort Lauderdale, Florida 33301 954-828-5933 Fax 954-828-5576 purchase@fortlauderdale.gov

ITB NO. 12467-113

Public Works Administration Building Air Conditioning

ADDENDUM NO. 3

ISSUED: April 28, 2021

This Addendum is being issued to provide the following information. It is hereby made a part of the Plans and Specifications and shall be included with all contract documents.

Acknowledge receipt of this Addendum by inserting its number and date on the CITB Construction Bid Certification Page.

A) Opening Bid and Q&A will be extended:

New Opening Date May 6,2021

New Q&A Date May 3, 2021

All other terms, conditions, and specifications remain unchanged.

F*austo Fargas* Procurement Specialist

Company Name: _____

(please print)

Bidder's Signature:

Date: _____



City of Fort Lauderdale • Procurement Services Division 100 N. Andrews Avenue, 619 • Fort Lauderdale, Florida 33301 954-828-5933 Fax 954-828-5576 purchase@fortlauderdale.gov

ITB NO. 12467-113

Public Works Administration Building Air Conditioning

ADDENDUM NO. 4

ISSUED: April 29, 2021

This Addendum is being issued to provide the following information. It is hereby made a part of the Plans and Specifications and shall be included with all contract documents.

Acknowledge receipt of this Addendum by inserting its number and date on the CITB Construction Bid Certification Page.

A) Site Visits will be allowed:

Site visits are to be scheduled / arranged by appointment only. Contact Danica Grujicic at (954) 828-5055 email <u>dgrujicic@fortlauderdale.gov</u> any time during normal business hours, before the cut-off date and time, to schedule a specific date and time for your visit. Site visits will be conduct on: Monday, May 3rd, 9:00am-10:00am Tuesday, May 4th, 9:00am-10:00am

NOTE: You are encouraged to set up your appointment asap to assure availability before the site visit cut-off date and time.

B) Bid Propolsal Certication Page is not required for this project, it will be removed.

C) Opening Bid and Q&A will be extended:

New Opening Date May 13,2021

New Q&A Date May 7, 2021

All other terms, conditions, and specifications remain unchanged.

Fausto Fargas Procurement Specialist

Company Name: _________(please print)

Bidder's Signature:

Date: _____

| Vendors Viewed | and the standard and the |
|---|--------------------------|
| DRG NAME | PHONE |
| Apogee Mechanica LLC | |
| GreNerk Consultancy Inc. | 555-4413 |
| DH and Company | 533-447-23-48 |
| Constructionnect | 800-364-2059 |
| nia | 904-388-0236 |
| Northfen Florida LLC | |
| TRANE | 05 <u>1</u> -218-3858 |
| Garrison Mechanica | 953-411-7000 |
| Morales and son | |
| B&I Contractora, Inc. 🎄 (5/9) | 235-382-4646 |
| Weatherthol Maintenance Corp | 805-9081000 |
| Southern Comfort Solutions, Inc. | 232-3162 |
| Integ Mam LLC [4/9] | |
| Carr er | |
| Advanced Control Corporation | |
| ArmateControis Inc. & | 9548707282 |
| Advanced Control Corporation [1/9] | 914-191-6660 |
| Thermolikin | 954-927-9383 |
| Trane US Inc | 951-199-6900 |
| Advanced Ropfing, Inc. 🔬 | 954-522-6363 |
| IOLDARE INC & | 9547473690 |
| Dodge Data & Analycics | 877-903-1909 |
| Bizzaro Air Conditioning LLC | 308-699-6863 |
| Dig Grand | |
| Noa Arland Heat | 951-929 061 3 |
| PgAr Vechanica LLC | |
| RESPORE CONSTRUCTION MANAGEMENT | 954-802-1758 |
| inchor Mechanical Inc | |
| teal Power Electric Inc | |
| he Sue Book | 800-431-5652 |
| n # Construction & Development Inc | 9535242875 |
| ()R Associates | |
| lodge Data & Analysis | |
| emotro A.C.Inc. | 305-562-7777 |
| trut Vechanical | 107-818-3951 |
| terrational Ocone Technologies Group | |
| lorthern Baulament Suboly Int | |
| lorsp America Produrement Coungil, Inc. PSC | |
| remier Air Condisoning | |
| enstruction Bio Educte | 822-772-6845 |
| or da Property Supply, LLC | |
| remerar conditioning | 305-833-3826 |
| ors:uttConnett | 800-864-2099 |

| T. Knowles & Associates LLC & | 754-205-5558 |
|---|---------------|
| Arpor Becindal Sarvice Inc. doa MN Wreman Becchic | 954-792-4990 |
| WPR Construction Concoración & | 954-699-5495 |
| Boxett | |
| Air Mechanical & Service Coro, | |
| BlackDog Mechanica | |
| Dooge Data & Analysics | 800/293-6343 |
| CoCoMoConstruction | 727-443-214* |
| RJS Contruction | 725-112-5346 |
| Por da Ed Reporting | 888/922 |
| DATA DETAL SERVICES | |
| Summa Methanical Contractors LLC | |
| LaPorta Contracting LLC | .953-603-4502 |
| (F30), LLC | 765-1224 |
| 1746g (1 am LLC (3/9) | |
| -35°-940 | 305-769-3000 |
| Muma SALLC | |
| Engineered Comfort Solutions (1/9) | |
| Winsuppy of Port Stillup | |
| Green Allance Inc. | |
| H G Refrigeration Supply | |
| Hyvac.Inc. | 954427-5311 |
| Fiorica Faim Construction (no | |
| Simple Life Medical | |
| YRY Homes & | 7646663212 |
| Currand Bullders Cord | 786-253-2715 |
| Dity of Fort Lauderbale | 854-823-5085 |
| Energy Control Consultaints | 9517398200 |
| Al-Ways Mechanical Bervices | 954-330-7244 |
| Call the Construct on LLC | 305-282-7824 |
| | |

Question and Answers for Bid #12467-113 - Public Works Administration Building Air Conditioning

Overall Bid Questions

Question 1

What is the budget for this project? (Submitted: Mar 24, 2021 11:07:28 AM EDT)

Answer

- The estimated budget for this project is \$1,100,000.00 (Answered: Apr 8, 2021 9:53:14 AM EDT)

Question 2

Who can we contact to schedule a site visit? (Submitted: Mar 25, 2021 1:49:04 PM EDT)

Answer

- Please review Addendum 1 (Answered: Mar 29, 2021 5:25:14 PM EDT)

Question 3

Who is the fire alarm provider for the building? (Submitted: Apr 6, 2021 9:10:47 AM EDT)

Answer

- The fire alarm and monitoring vendor is City Fire Incorporated. (Answered: Apr 7, 2021 11:50:13 AM EDT)

Question 4

Spec section 011200-1 subsection 1.2F and spec section 012900-2 subsection 1.4.b.7 reference allowances in the SOV. There is no allowance listed in bidsync. Please advise if the temporary cooling requirement shall be included as part of base bid or if an allowance will be provided. (Submitted: Apr 7, 2021 11:25:01 AM EDT)

Answer

- The temporary cooling is required and allowance is provided for this scope, in the amount of \$60,000. Payments will be made to the Contractor based on the actual cost of temporary cooling upon submission of paid receipts. (Answered: Apr 14, 2021 10:24:33 AM EDT)

Question 5

Is all electrical conduit back to breaker being replaced with new? (Submitted: Apr 7, 2021 11:37:17 AM EDT)

Answer

- All conduit shall be new. See specification section 26 05 33 â" RACEWAY AND BOXES FOR ELECTRICAL SYSTEMS. (Answered: Apr 14, 2021 10:24:33 AM EDT)

Question 6

Is panel 1EHM mislabeled? Should it be 1HEM? (Submitted: Apr 7, 2021 11:37:51 AM EDT)

Answer

- Panel schedules 1EHM on sheet E16 are mislabeled and should be 1HEM (Answered: Apr 14, 2021 10:24:33 AM EDT)

Question 7

Do you have a planholder's list available? (Submitted: Apr 7, 2021 3:53:44 PM EDT)

Answer

- You can find the list in the Bid Documents. (Answered: Apr 14, 2021 11:16:40 AM EDT)

Question 8

What is the budget for the base bid? (Submitted: Apr 8, 2021 9:20:50 AM EDT)

Answer

- The estimated budget for this project is \$1,100,000.00 (Answered: Apr 8, 2021 9:53:14 AM EDT)

Question 9

Is there a required Bid Bond Form? I do not see one in the Bid Package. (Submitted: Apr 15, 2021 2:06:28 PM EDT)

Answer

- We do not have specific form , you can find bid bond info on ITB-2 (Answered: Apr 16, 2021 8:52:53 AM EDT)

Question 10

Alternate 4 requests Relocation of FDC Connection.

Please provide the Fire Alarm/Fire Sprinkler Contractor who holds the Contract for the Bldg. (Submitted: Apr 15, 2021 2:58:29 PM EDT)

Answer

- Please review question # 3. (Answered: Apr 19, 2021 8:52:31 AM EDT)

Question 11

Please elaborate further on RFI response regarding total replacement of existing conduit. This requirement will greatly impact project cost, time to complete, and ability to maintain building cooling throughout project. What is rationale for replacing all conduit instead of replacing only damaged/unusable. (Submitted: Apr 16, 2021 4:16:14 PM EDT)

Answer

- Only existing conduit that is in the bad condition and not sized properly are to be replaced with new in accordance with code requirements. (Answered: Apr 22, 2021 2:59:49 PM EDT)

Question 12

On the Supplier Response Form: Can you clarify what information you are looking for here:

Delivery: Calendar: days after receipt of Purchase Order (section 1.02 of General Conditions):

Total Bid Discount (section 1.05 of General Conditions):

CAM 21-0549 Exhibit 1F Page 76 of 78 I can not locate these sections in the Bid Document. (Submitted: Apr 28, 2021 2:01:15 PM EDT)

Answer

- Bid Propolsal Certication Page is not required for this project. (Answered: Apr 28, 2021 4:17:04 PM EDT)

Question 13

Post award will there be access to the site for a 12-16 hour work day with advanced notice to owner? (Submitted: Apr 30, 2021 1:29:35 PM EDT)

Answer

- The regular working hours are preferred. However, if longer shifts are required, will be approved with advanced notice to the owner. Refer to the Bid Documents for additional requirements. (Answered: Apr 30, 2021 4:10:59 PM EDT)

Question 14

Please verify the intent of the 5" chilled water lines running from the chillers to the building? It seems to show these lines being demoed on drawing M04 and new lines being installed below ground per drawing M08. But on drawings S102 and S-103 it shows what seems to be pipe supports/piers installed above grade. See detail #8 for the pipe support detail. Please clarify as changing this piping out is a substantial amount of work either way? (Submitted: May 3, 2021 4:48:59 PM EDT)

Answer

- The point of connection for new chiller water (CHW) piping begins above ground at the chiller yard. All underground piping shall remain and be used as part of the CHW system.

Please see key note 7 on sheet M12. For reference, typically dashed ductwork and piping are used to show existing systems, and hatched ductwork and piping are used to show to-be-demolished systems. (Answered: May 5, 2021 10:55:12 AM EDT)

Question 15

Is there a phasing plan for this project? (Submitted: May 3, 2021 4:49:27 PM EDT)

Answer

- Construction phasing to be proposed by the Contractor and with close coordination with the Cityâ[™]s project manager. The facility is an occupied facility and temporary cooling shall be provided to ensure utilities are maintained with no interruptions (Answered: May 5, 2021 10:55:12 AM EDT)

Question 16

1. Housekeeping pads:

a. Details on S-103 seem to indicate chill water pumps, expansion tank, and air separators to go mounted directly to existing concrete. Please confirm if the intent is to mount on existing pad or to provide 4â-6â housekeeping pads.

b. Confirm that housekeeping pads are existing to remain and to enlarge if required by new chiller footprint.

2. Bid specifies allowances to be included in contractor bid price for temporary HVAC during replacement. As far as individual AHUâTMs, what will be the time windows given to the contractor for replacement and re-starting? Will these individual unit changeovers have to be done over compressed times like a weekend or will City relocate employees from affected spaces temporarily? Please provide as much detail on CityâTMs requirements so that we can propose suitable phasing plan.

3. E-03 indicates relocation of lights for new piping run. Confirm that any light relocation & replacement or ceiling

removal is only as needed if required for new piping runs. In this specific area, mechanical drawings indicate the main CHWR piping is to remain. We will use this reply as typical for any other areas shown the same on the drawings.

4. M08, note 2 calls for new housekeeping pads for AHU. Existing AHU do not have any pads; please confirm we should include all costs for new pads.

5. Confirm that any asbestos survey or removal are outside the scope of contract.

6. Roof mounted equipment mostly non-compliant with present codes in that they are located less than 10â[™] from building edge. Confirm that any safety railings that may be required by building officials is not part of the scope. **(Submitted: May 6, 2021 12:03:30 PM EDT)**

Answer

- 1a. There are currently no existing pads. The intent is to provide housekeeping pad for expansion tank, and for the chilled water pumps provide inertia pad.

1b. Chiller pads are existing to remain and new chiller footprint must fit the existing pad dimensions. A portion of the existing concrete pads will need to be demolished to allow room for chilled water pumps and inertia pad. See key note 9 on M12.

2. It is the responsibility of the contractor to coordinate with the City PM to ensure no occupied spaces will be impacted during the renovation. It is required that all spaces be maintained with temporary cooling to ensure no disruption to the occupied facility.

3. Any light relocation & replacement or ceiling removal is only as needed if required for new piping runs. The specific area shown on E03 will not have new CHW piping.

4. There is no existing pad, please include all cost for new pads.

5. To our knowledge there is no asbestos-containing material within the building. However, the asbestos removal is not part of this contract.

6. Architectural drawings R01 specific note 10 calls out for aluminum wall mounted guard rails along roof perimeter nearby large HVAC units. See detail B04.2 on sheet R04. This safety railing system is to be included in scope of work. (Answered: May 11, 2021 1:57:40 PM EDT)